

CITY OF BALTIMORE

BERNARD C. "JACK" YOUNG,
Mayor



DEPARTMENT OF RECREATION AND
PARKS

CAPITAL DEVELOPMENT AND PLANNING
2600 Madison Avenue
Baltimore, Maryland 21217

ADDENDUM NO. 2

DATE: January 28, 2020

For
DRAWINGS, SPECIFICATIONS, PROPOSAL, CONTRACT AND BOND

For
**MIDDLE BRANCH WELLNESS AND FITNESS
CONTRACT NO. RP 19808**

FOR THE MAYOR AND CITY COUNCIL OF BALTIMORE


TO BIDDERS: THIS ADDENDUM IS HEREBY MADE A PART OF THE CONTRACT DOCUMENTS ON WHICH THE CONTRACT WILL BE BASED, AND IS ISSUED TO MODIFY, EXPLAIN AND/OR CORRECT THE ORIGINAL DRAWINGS AND SPECIFICATIONS. PLEASE ATTACH THIS ADDENDUM TO YOUR CONTRACT DOCUMENTS AND ACKNOWLEDGE IT ON THE BID OR PROPOSAL PAGE WHERE INDICATED.

**ALL BIDS DUE BY FEB 5, 2020 AT 11 AM.
SEE ATTACHED FOR CHANGES TO THE SPECIFICATIONS**

APPROVED:



Adam Boarman, RLA
CHIEF OF CAPITAL DEVELOPMENT
DEPARTMENT OF RECREATION AND PARKS

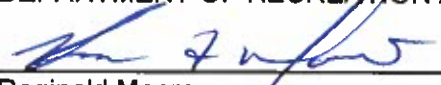

Reginald Moore
DIRECTOR OF RECREATION AND PARKS

01. The following specification documents have been issued as part of this Addendum

#2. (If a document sharing the title and/or page number was in the original advertised package, these documents will supersede those within the proposed contract.)

- a. Pages 8-14 - Wage Rates
- b. Pages 344-352g - 05 1200 Structural Steel (inspection table attach added)
- c. Pages 360-367 - 05 3100 Steel Decking
- d. Pages 441-450 - 07 5423 Thermoplastic-Polyolefin Roofing
- e. Pages 503-509 - 08 4413 Glazed Aluminum Curtain Walls
- f. Pages 647-652 - 11 6623 Gymnasium Equipment
- g. Pages 660-664 - 12 6613 Telescoping Bleachers
- h. Pages 1352-1358 - 26 0010 Electrical General Provisions
- i. Pages 1530, 1533, 1534, 1535 - 31 2300 Excavating, Filling, & Grading
- j. Pages 1607-1611 - 32 1400 Unit Paving

02. The following drawings have been issued as part of this Addendum #2.

Civil:

- a) Sheet C3.00
- b) Sheet C4.04
- c) Sheet C4.05
- d) Sheet C5.01
- e) Sheet C6.00
- f) Sheet C7.00
- g) Sheet C8.00
- h) Sheet C8.03
- i) Sheet C8.04
- j) Sheet C8.05
- k) Sheet C9.00
- l) Sheet C9.02
- m) Sheet C9.03
- n) Sheet C9.04
- o) Sheet C9.06 *Note: this sheet was included as a blank sheet in the bid set, now it is called Sediment Basin #1 Phased Construction*

Landscape:

- p) Sheet L1.00
- q) Sheet L1.01
- r) Sheet L1.02
- s) Sheet L2.00
- t) Sheet L3.00
- u) Sheet L4.00

Architectural:

- v) Sheet CS.1
- w) Sheet AC.1
- x) Sheet AC.2
- y) Sheet AS.1
- z) Sheet A1.2
- aa) Sheet A1.3
- bb) Sheet A3.2
- cc) Sheet A4.3
- dd) Sheet A4.4
- ee) Sheet A5.2
- ff) Sheet A6.4

gg) Sheet A6.5

hh) Sheet A6.7

ii) Sheet A7.5

Structural:

jj) Sheet S1.0

kk) Sheet S1.2

ll) Sheet S1.4

mm) Sheet S1.5

nn) Sheet S3.1

oo) Sheet S4.2

Plumbing:

pp) Sheet P1.1

qq) Sheet P1.2

rr) Sheet E1.3

ss) Sheet E1.6

Electrical:

tt) Sheet E101

uu) Sheet E202

vv) Sheet E501

ww) Sheet E602

03. The following should be noted:

- a. Specifications 027000, 027200, 027300 require the contractor or their subcontractor to have minimum experience. Proof of this experience is not required to be submitted as part of the bid. However, when the city approves subcontractors, it will require this experience; and the contractor or subcontractor should be able to demonstrate previous successful experience as outlined in these sections.

04. Answers to Bidder Questions:

1. *Please confirm the MBE contractors/suppliers we utilize on this project are required to be a first tier contractor/supplier to the general contractor and contracted directly to the GC.* YES
2. *Please confirm the "Green Book" is part of the Contract Documents.* YES, See Page 3, Item 4.
3. *Please advise how many days the GC's bid needs to remain valid for.* There is no specified expiration on bids.
4. *Will the Owner hire a Construction Manager for the project? If so, does the Owner know who this will be?* Engineer (Owner) provides on-site construction inspection.
5. *If there is a CM on the jobsite, will they be supplying a trailer, internet, and temp toilets for their usage at their own cost? Please refer to specifications section 01 5000, as well as 13 2200 in the "Book of Standards". A trailer with restroom "of a size acceptable to the Engineer" will be supplied and installed by the Contractor. A unit similar to "Trailer 3" [13 2200 Part 4 (page 396)] in size will be acceptable to the Engineer. Note that a conference room (table) should substitute for the 2nd office space. See 13 2200 Section 3.5 for "Construction Requirements for all Offices". Provisions within this section include, but are not limited to, electrical service, heating and cooling, bulletin board, internet access, and hard-wired telephone with answering machine. Certain requirements such*

as the cassette recorder/player will be waived due to obsolescence. Section 3.6 requires provision of a “microcomputer system” (desktop and monitor, et. Al.) for the office including one-touch copier, printer and fax machine. Substitution of laptop with minimum 14” screen, i7 processor, and built-in front and rear camera (similar to a Microsoft Surface Pro 7) and printer with scanning capability, is acceptable. A consistent wireless connection is acceptable as a substitute for hard-wired internet.

6. *Page 2 of the Notice of Letting states that the B ATP is excluded from this contract however, page 5 and 6 of the Special Provisions says that the B ATP forms must be submitted with our bid. Please clarify. B ATP is excluded however you must still complete the forms*
7. *Please confirm all the other programs such as Employ Baltimore, Youthworks Program and Local Hiring apply to this project. YES*
8. *In the event we lose time in our schedule due to weather during the Monday-Friday work week, are Saturday’s permitted? The contract is for consecutive calendar days. Saturdays are permitted, however special procedures must be followed per the contract which includes informing the Engineer. If so, would we be required to pay for the CM’s time? The contractor will have to pay for overtime, including for the Engineer’s Construction Inspection staff.*
9. *Please confirm that the GC is to procure the TAB consultant to perform the work specified in 230593. CONFIRMED*
10. *It was mentioned that GTA will be onsite during earthwork operations. Does the GC also need to have a 3rd Party T&I Agency for the soils? Please clearly delineate the roles of GTA and the 3rd party T&I agency hired by the GC. Please see answers from Addendum #1. Please read pages 1536-1540 which clearly spell out each party’s role. Paraphrasing this document, in general it is the Engineer’s responsibility to administer and test, while it is the Contractor’s role to dig, move, fill, etc., and of course inform the Engineer of unforeseen conditions (like any other part of the contract).*
11. *How are the contaminated soils to be handled? We will not know what is “hot” and what is good dirt until we start digging and the 3rd party T&I agency does the testing as we work. Instead of creating a “hot” pile and a good dirt pile and running the risk of cross contamination, it may be easier just to haul all materials (and utility trench materials) off and import soils as needed. Provide pricing per the contract. Answers to these questions were given in Addendum #1. Export of soils off-site is NOT anticipated.*
12. *Please provide a Hazmat allowance. We do not know how to bid this job as nobody knows what is there until work starts and the material is tested. What is meant by “Hazmat allowance”? If by this it is meant the cost for treating or removing impacted soils, this is not anticipated, and therefore not requested for bid.*
13. *It appears a 2’ buffer cap of clean fill and fabric is required in all landscape areas. Is the 2’ buffer cap required under all utility trenches? This is very difficult to do with narrow trenches. There does not need to be a cap under or within utility trenches. The cap will be place over the utility trench per the specifications in the EMP.*
14. *The environmental management plan issued with the documents doesn’t have any analytical data. The document did mention Phase I and Phase II site investigations were completed. Please provide these documents and any lab data available. These investigations were used by the engineer’s to craft the contract. Those documents are*

unnecessary to properly bid the contract, however they may be made available to the awarded bidder upon ratification of the contract.

18. *Regarding the EMP What are the contaminants of concern? It mentions metals contamination but I don't see mention of them testing for petroleum contamination. Do they suspect petroleum contamination? NO*
19. *The EMP does not have any specific values of any of the contaminants. There are hits on PCB's and metals and we need to see that data to know how to bid. Please provide pricing per the contract. Treatments specific to PCBs and Metals are not anticipated, and therefore not requested for bid. A bid requiring simple reappportioning of impacted, as well as non-impacted, soils is requested.*
20. **Reference section 329300 Planting. Section 1.2.B references section 329113 Soil Preparation for planting soils. Please provide this specification as the detail 1/L4.00 requires an extensive amount of soil preparation. Reference to section 329113 has been removed and the soil preparation details has been altered to reflect what is documented in the Environmental Management Plan and geotechnical report, see revised sheet L4.00.*
21. **Reference L1.0 Key note C-1 Lawn Areas. The keynote refers to 1/L4.00 Soil placement Detail "d-bedprep-dwg". Please verify if this detail is intended to be used in lawn areas. Some lawn areas have very little grade change however this detail creates a substantial amount of work in these lawn areas. Lawn areas and placement of soils will be prepared and amended as identified in the Environmental Management Plan and geotechnical report. See revised detail 1/L4.00.*
22. *Please confirm that the intent is for the areas in red on the attached drawing to receive P-1 Pavers, and the areas in blue to receive P-2 Pavers. There are several different areas with differing keynotes but all are drawn the same. Please see revised sheet L1.01 to clarify the paver locations.*
23. *Dwg L1.00 Hardscape Plan shows a Sundeck (on the north-east side of the Fitness Cen) as P-5 (Patio Add Alternate). There are only 5 Alternate Bid Items on the Bid Form, and none of them would include this Sundeck/Patio. Please clarify if this is part of the Base Bid, or if you need to add another Alternate to the Bid Form. We feel it is clearly spelled out as #2 in the alternates.*
24. *Drawing C-6.00 shows a "concrete sidewalk with SUNDEK (add ALT.#2). We are unable to find this detail, but specs Sec. 012300/1 indicates ALT #2 "hydraulic Overhead door ". Please clarify. Alternate 2 includes the Sundeck as indicated on C-6.00. See specification section 01 2300 paragraph 1.3.B.2.*
25. *We are unable to locate a detail for item C-5 Bollards on L1.01. Please provide a detail. Please see revised sheet L1.01 and revised sheet L3.00 with added detail #7.*
26. *Detail 2/C-5.00 shows a 5" concrete sidewalk and detail 1/ L-3.00 shows a 4" sidewalk. Please indicate the detail to be followed. Detail 1/L-3.00 has been revised to match 2/C-5.00. See revised sheet L-3.00.*
27. *Please confirm there are only 3 seat walls as indicated on L-drawings. C-4.06 & C-6.00 show one more seat wall at NW of the building but drawing AS. 1 shows another seat wall at West of Drop-Off. There are six (6) total seat walls. Four (4) as indicated on 1/L1.00 and two (2) as indicated on 2/L1.00. Sheets C-4.06, C-6.00, and AS.1 have been revised to clarify.*

28. *Drawing C6.00 – confirm “No Parking/No Stopping” markings can be regular traffic paint.*
CONFIRMED
29. *Specified section 01 2300 Alternates. Paragraph 1.3 section C. line 2 calls for sunshades on type (L.2) on drawings page A8.5. There isn't sunshade configuration for frame type L.2 shown on that page. Please provide sunshade configuration for frame type L.2* Line 2 is not meant to call for sunshades to be included for type L.2. **There are no sunshades associated with L.2 for either the base bid OR the alternate.** Sun shade blades are associated with window types H, J, K, and L.1 as indicated on A8.3A. Window L.2 does not receive shades. Window L.2 shall receive glazing types in Alternate No. 3 as indicated on A8.5.
30. *Reference 9/A5.2 Elevator Mezzanine Floor Plan. Please verify if a door is required in the back of the shaft. Only the floor plans and 9/A5.2 indicate proposed door.*
CONFIRMED, Door is required for equipment access per the Drawings.
31. *The basis of design for the curtainwall is EFCO Series 5500X system. It calls for 1” glass, which will not work with that system. The basis of design for the curtain wall should be EFCO series 5600 XTherm which does take 1” glass, please see revised specification section 08 4413.*
32. *See page A2.2 reflective ceiling plan. Also Reference soffit type 1.01. There is a large ceiling above the main lobby 1st fl / over the south track are identified as ceiling type 5.01. Regarding Ceiling type 5.01:*
- 055000-R suspended metal sub frame – spec says this is a “Slotted Channel framing, fabricated from structural steel...”) What is this exactly? Is it 4'-0” oc? What supports it?* Per specification 05 5000 paragraph 1.3.B, subframe and supports are part of the contractor's delegated design.
 - 062000-C : Wood furring ¾” thick. Is this attached to the 055000-R material? Is it 16” oc? Attach wood furring to metal subframe. Include furring spacing as part of the contractor's delegated design of ceiling 5.01.*
 - 062000-B: Tongue and Groove Wood Paneling, ¾” thick (NIC). Please confirm the Owner is furnishing and installing this. See specification 06 2000 paragraph 2.1.C.2. Material will be furnished by Engineer and Installed by Contractor.*
 - 099000-A: Water Based Fire Retardant. I guess whoever is doing the 062000-B has this on the material? 099000-A shall be applied to 062000-B by Contractor.*
33. *Can it be confirmed that all HVAC and lights will be mounted above or even with the bottom of the truss chord to avoid interference with the ceiling mounted basketball hoops and divider curtain?* CONFIRMED
34. *Section 116623 specifies the basketball hoop electric winches and height adjusters and the divider curtain are to be operated by a group control touch pad but one is not specified. Can a specification be provided for a touch pad (NOTE: A TSC1500 total control system by Performance Sports Systems would be recommended)? See revised specification 11 6623 paragraphs 2.3.A.3.b and 2.5.B.5.b.*
35. *Section 116623 , paragraph 2.5.B.4 specifies that the height adjuster in paragraph 2.5.B.3 is to be electric; however, drawing E101 does not indicate power for the height adjuster but does show power for the electric winch. Can you please confirm that the height adjusters for basketball backstops are to be electric?* CONFIRMED
36. *Section 116623, paragraph 2.7.A.2. and 2.7.A.3. specify two different types of foam. What type of foam should be used, as each carrier is a different price point (NOTE: paragraph 2.7.A.3 would provide a wall pad assembly that is a Class A rated)?* Open

cell polychloroprene should be used. Specification section 11 6623 paragraph 2.7.A.2 is removed. See revised specification.

37. *Section 116623, paragraph 2.8. does not specify an operation of the scoreboards and shot clocks, either hardwired or wireless. What operation of these is required (NOTE: Wireless would be recommended, as this would delete control wiring from each scoreboard/shot clock to a scorer's table location)? Scoreboards and shot clocks operation to be wireless, infrastructure for hardwiring to remain as indicated in the contract documents. See revised specification 11 6623.*
38. *Drawing E101, drawing note #3 states, "to motorize basketball backboard. Provide all the required receptacles, plug, and audible alarm kit per manufacturer's requirement." Section 116623, paragraph 2.5 does not specify an audible alarm. Will audible alarms be required for the motorized basketball backstops in the gymnasium? **Audible alarm is not required.***
39. *Can it be confirmed the bleacher in Section 126613 should be wall attached and include an extended rear filler to notch around the columns on the wall, which will provide a continuous top row of seating? Confirmed. See specification 12 6613 paragraph 2.5.A.2.*
40. *Section 126613 does not specify the type of ADA spaces to be used, permanent or recoverable. What type of ADA spaces should be provided with the bleachers, permanent or recoverable? ADA spaces to be recoverable. See revised specification 12 6613 paragraph 2.2.A.5.*
41. *Reference A6.4 and A6.5 top of wall flashing and coping. Majority of wall section refer to section details 4/6.4 and 8/6.4. Please advise how flashings are to attach to the structure as no wood blocking is identified in particular the cavity space where cavity insulation is flush with top of exterior gypsum sheathing. Please see revised details 4/A6.4 and 8/A6.4 on sheet A6.4 to include blocking*
42. **The specs call for mechanically fastening the insulation which will pierce the vapor barrier. Would it be preferable to adhere the insulation to the vapor barrier? Roof at natatorium shall be adhered, elsewhere mechanically fastened will remain. Please refer to revised sheet AC.1 and revise specification section 07 5423.*
43. *The majority of the feeders for the gear shown on the one line diagram (drawing E501) do not match the feeders listed on the panel schedules on drawings E602, E603, E604. Please indicate which is correct. Follow the feeder sizes shown on E501*
44. *Reference E100 and E200. Are the handholds precast concrete or polymer concrete? Handholds are polymer concrete.*
45. *General Electrical Note #41 (on E001) references the T-series drawings for information on requirements on telecom/security, but the T-series drawings do not appear to be included in the bid documents. Will they be made available or is the work by the owner. There are no T-series drawings refer to specification 27 4100 for audio visual requirements.*
46. *Spec 260010-1.15-B references "TE" drawings however none were issued with the documents. If these drawings are part of the project, please issue them. There are no TE drawings as part of the project. Refer to specification 27 4100 for audio visual requirements. Specification section 26 0010 -1.15B has been revised.*


47. *Can low voltage lighting control cable be installed open (no conduit) when in a concealed ceiling?* YES

2020
-1-
CLASSIFICATION NO. 1

The following minimum hourly wage rates shall apply to all contracts in excess of One Hundred Thousand Dollars (\$100,000) in connection with new building construction, major remodeling and rehabilitation of buildings and for construction, reconstruction, erection, conversion installation, alteration, renovation, razing, demolition, moving or removing on any airport, pier wharf, sewer, drain, main, conduit, machinery or mechanical, electrical or other equipment or any other operation, or work to be done or performed in, on, upon or in connection with any building, bridge over water, tunnel, tower, stack, filtration plant, waste water or sewage treatment works, pumping stations, and other such structures.

<u>JOURNEYMEN</u>	<u>HOURLY RATE</u>	<u>FRINGE BENEFITS</u>	<u>TOTAL</u>
Asbestos Workers/Insulation Mechanics	\$36.53	\$16.00	\$52.53
Boilermakers	17.62	6.96	24.58
Bricklayers	32.00	11.56	43.56
Carpenters/Resilient & Soft Floor Layers	26.66	15.00	41.66
Millwright	32.11	16.75	48.86
Piledriver	31.13	15.65	46.78
Cement Mason/Plasterers'	28.45	11.47	39.92
Electricians	38.00	18.19	56.19
Elevator Construction Mechanic	46.88	39.37	86.25
Firestop Mechanic	23.33	7.95	31.28
Glaziers	30.13	22.00	52.13
Ironworkers			
Ornamental	30.13	22.00	52.13
Structural	30.13	22.00	52.13
Reinforcing Rodmen	30.13	22.00	52.13
Fence Erectors	28.70	20.66	49.36
Laborers			
General Laborers: Flaggers, Tool and Material Handlers (Except Tenders), Clean-Up, Janitors, Truck Checkers, Dumpmen, Spotter, Landscape Laborer, Mulcher, Watchmen (Including Fire Watchmen)	18.25	6.29	24.54
Construction Laborers: All Laborers not Otherwise Classified.	19.10	6.29	25.39
Semi-Skilled Laborers: Potmen, Power or Air Tool Operators, Pipelayers, Drillers Concrete Laborers, Signalmen, Small Machine Operators, Laser Beam Operators, Scaffold Builders, Caisson Laborer, Jack Hammer Operator(80 lbs and over).	19.41	6.29	25.70

APPROVED BY BOARD OF ESTIMATES

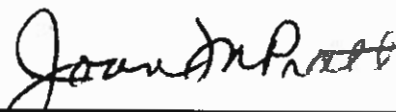

Clerk to the Board of Estimates

DEC 11 2019

2020
-2-


<u>JOURNEYMEN</u>	<u>HOURLY RATE</u>	<u>FRINGE BENEFITS</u>	<u>TOTAL</u>
Painters			
Brush and Trim	\$25.06	\$9.86	\$34.92
Spackling, Taping, Wall Covering.	25.06	9.86	34.92
Spray, Structural Steel, Steam Cleaning, Sandblasting	33.73	9.90	43.63
Plumbers/Steamfitters/Pipefitter	40.10	20.31	60.41
Roofers			
Slate and Tile	26.44	12.24	38.68
Wood Block	26.44	12.24	38.68
Composition – Water proofer	26.44	12.24	38.68
Sheet Metal Worker (Inc. Air Balance, Metal Roofing)	40.77	21.38	62.15
Sprinkler Fitter	34.40	19.14	53.54
Stonemason	38.81	18.29	57.10
Tile, Terrazzo, Marble Workers	29.10	12.27	41.37
Tile, Terrazzo, Marble Finisher	24.10	11.24	35.34

POWER EQUIPMENT OPERATORS

GROUP I: Certified Crane Operators (CCO). 35.70 15.90 51.60

GROUP II: Backfiller, backhoe, batching plants, boat captain, cableway, loader hoe, (with a front end bucket over 1 ¼ yds)., concrete mixing plant, concrete paver, derrick boat, double concrete pump, dragline, Eimco type overhead loader, elevating grader, scraper or pan type excavator (25 yds and over), front end loader (1 ¾ yds and over), gradall, grader, hoist (2 active drums or more), multiple conveyor, pile driving machine, power shovel, repair mechanic, shield, standard gauge locomotive, trenching machine, tunnel mucking machine, twin engine scraper, welder, whirley rig. 30.23 13.17 43.40

APPROVED BY BOARD OF ESTIMATES

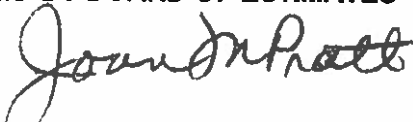

Clerk to the Board of Estimates

DEC 11 2019


2020

-3-

<u>JOURNEYMEN</u>	<u>HOURLY</u>	<u>FRINGE</u>	<u>TOTAL</u>
	<u>RATE</u>	<u>BENEFITS</u>	
GROUP III: Asphalt spreader bulldozer, bull float, loader, hoe, (with a front end bucket 1 ¼ yds. and under), concrete mixer (with skip), concrete pump, concrete spreader, scraper or pan type excavator (under 25 yds.) finishing machine, front end tractor loader (under 1 ¾ yds), hi-lift fork lift, longitudinal float, narrow gauge locomotive, one drum hoist, power roller, screeding machine, snooper/vac truck, stone crusher, stone spreader, sub-grader tractor with attachments (2 or more provided both attachments are being used).	\$28.28	\$13.17	\$41.45
GROUP IV: Crawler or rubber tire tractor (no attachments), compressors, elevator operator, firemen, fuel truck, grease truck, grout pump, light plant, mighty midget with compressor, single conveyor, space heaters, welding machines, welldriller, wellpoint system, deck hands, oilers (all types).	24.65	13.17	37.82
Truck Drivers			
Goose Neck Drop Frame	15.82	3.75	19.57
Trailer Driver	15.50	3.75	19.25
Flat Bed and Pickup	13.89	3.75	17.64
Dump Truck Driver (Site Only)	12.85	4.60	17.45

Welder Receives Rate For Craft Involved

APPROVED BY BOARD OF ESTIMATES

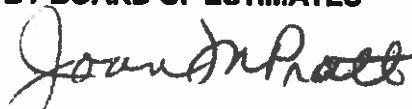

Clerk to the Board of Estimates

DEC 11 2019

2020

-4-

APPRENTICESHIP RATES
PERCENTAGE OF JOURNEYMAN'S HOURLY RATE
PLUS FULL JOURNEYMAN'S FRINGE BENEFITS (UNLESS PARTIAL FRINGE BENEFITS ARE
APPROVED BY THE MARYLAND APPRENTICESHIP AND TRAINING COUNCIL)

ASBESTOS WORKERS

First year	45
Second year	55
Third year	65
Fourth year	75
Fifth year	85

BOILERMAKERS

First 6 month	50
Second 6 months	60
Third 6 month	65
Fourth 6 month	70
Fifth 6 months	75
Sixth 6 months	80
Seventh 6 months	85
Ninth 6 month	90

BRICKLAYERS & STONE MASONS

First 6 months	50
Second 6 months	55
Third 6 months	60
Fourth 6 months	70
Fifth 6 months	80
Sixth 6 months	90

CARPENTERS

First year	60
Second year	70
Third year	80
Fourth year	90

CEMENT FINISHERS

First 500 hours	50
Second 500 hours	55
Third 500 hours	60
Fourth 500 hours	65
Fifth 500 hours	70
Sixth 500 hours	75
Seventh 500 hours	80
Eighth 500 hours	90

APPROVED BY BOARD OF ESTIMATES



 Clerk to the Board of Estimates

DEC 11 2019

2020

-5-

**APPRENTICESHIP RATES
PERCENTAGE OF JOURNEYMAN'S HOURLY RATE
PLUS FULL JOURNEYMAN'S FRINGE BENEFITS (UNLESS PARTIAL FRINGE BENEFITS ARE
APPROVED BY THE MARYLAND APPRENTICESHIP AND TRAINING COUNCIL)**

ELECTRICIANS

First 6 months	40
Second 6 months	40
Second year	55
Third year	65
Fourth year	70
Fifth year	75

ELEVATORS

First year	55
Second year	65
Third year	70
Fourth year	80

IRONWORKERS

First period 0 hours	60
Second 1,000 hours	65
Third 1,000 hours	70
Fourth 1,000 hours	75
Fifth 1,000 hours	80
Sixth 1,000 hours	85
Seventh 1,000 hours	90
Eighth 1,000 hours	95

MILLWRIGHTS

First year	60
Second year	70
Third year	80
Fourth year	90

PAINTERS

First 1,000 hours	55
Second 1,000 hours	70
Third 1,000 hours	85

PLASTERERS

First 1,000 hours	50
Second 1,000 hours	55
Third 1,000 hours	60
Fourth 1,000 hours	65
Fifth 1,000 hours	70
Sixth 1,000 hours	75
Seventh 1,000 hours	80
Eighth 1,000 hours	85

APPROVED BY BOARD OF ESTIMATES



Clerk to the Board of Estimates

DEC 11 2019

2020

-6-

APPRENTICESHIP RATES
PERCENTAGE OF JOURNEYMAN'S HOURLY RATE
PLUS FULL JOURNEYMAN'S FRINGE BENEFITS (UNLESS PARTIAL FRINGE BENEFITS ARE
APPROVED BY THE MARYLAND APPRENTICESHIP AND TRAINING COUNCIL)

PLUMBERS/STEAMFITTERS/PIPEFITTERS

First year	40
Second year	50
Third year	60
Fourth year	70
Fifth year	80

POWER EQUIPMENT OPERATORS

First period	55
Second period	60
Third period	65
Fourth period	70
Fifth period	75
Sixth period	80

ROOFERS

First year	55
Second year	65
Third year	75

SHEET METAL WORKERS

First 6 months	40
Second 6 months	45
Third 6 months	50
Fourth 6 months	55
Fifth 6 months	60
Sixth 6 months	65
Seventh 6 months	70
Eighth 6 months	75
Ninth 6 months	80
Tenth 6 months	85

SPRINKLER FITTERS

First 6 months	45
Second 6 months	50
Third 6 months	55
Fourth 6 months	60
Fifth 6 months	65
Sixth 6 months	70
Seventh 6 months	75
Eighth 6 months	80
Ninth 6 months	85
Tenth 6 months	90

APPROVED BY BOARD OF ESTIMATES

John Pratt

Clerk to the Board of Estimates

DEC 11 2019

2020

-7-

APPRENTICESHIP RATES
PERCENTAGE OF JOURNEYMAN'S HOURLY RATE
PLUS FULL JOURNEYMAN'S FRINGE BENEFITS (UNLESS PARTIAL FRINGE BENEFITS ARE
APPROVED BY THE MARYLAND APPRENTICESHIP AND TRAINING COUNCIL)

LABORERS

First year	70
Second year	90


LABORER'S WORK

Laborers may not assist mechanics in the performance of mechanic's work, nor use tools peculiar to established trades. Their work should be confined to the following manual tasks:

1. Digging and filling holes and trenches.
2. Loading, unloading and stockpiling materials.
3. Cleaning and sweeping.
4. Driving stakes.
5. Placing concrete and asphalt (not finishing)
6. Stripping forms.
7. Ripping out material which is to be discarded, including asbestos.
8. Clearing and grubbing.

The above definition is to preclude inadvertent misclassification of laborers.

APPROVED BY BOARD OF ESTIMATES

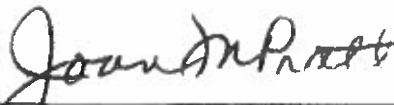

 Clerk to the Board of Estimates

DEC 11 2019

SECTION 05 1200 - STRUCTURAL STEEL

PART 1 - GENERAL

1.1 SUMMARY

- A. This Section includes the following:
 1. Structural steel.
 2. Architecturally exposed structural steel.
 3. Grout.

1.2 DEFINITIONS

- A. Structural Steel: Elements of structural-steel frame, as classified by AISC's "Code of Standard Practice for Steel Buildings and Bridges," that support design loads.
- B. Architecturally Exposed Structural Steel (AESS): Structural steel designated as architecturally exposed structural steel in the Contract Documents.

1.3 PERFORMANCE REQUIREMENTS

- A. Connections: Provide details of simple shear connections required by the Contract Documents to be selected or completed by structural-steel fabricator to withstand ASD-service loads indicated and comply with other information and restrictions indicated.
 1. Select and complete connections using schematic details indicated and AISC's "Manual of Steel Construction, Allowable Stress Design," Part 4.
 2. Engineering Responsibility: Fabricator's responsibilities include using a qualified **Maryland licensed** professional engineer, **with a minimum five-year experience with a similar or larger project size** to prepare structural analysis data for structural-steel connections. **ADDENDUM #2**

1.4 SUBMITTALS

- A. Product Data: For each type of product indicated.
- B. Shop Drawings: Show fabrication of structural-steel components.
 1. Include details of cuts, connections, splices, camber, holes, and other pertinent data.
 2. Include embedment drawings.
 3. Indicate welds by standard AWS symbols, distinguishing between shop and field welds, and show size, length, and type of each weld.
 4. Indicate type, size, and length of bolts, distinguishing between shop and field bolts. Identify pretensioned and slip-critical high-strength bolted connections.
 5. For structural-steel connections indicated to comply with design loads, include structural analysis data prepared by the qualified professional engineer responsible for their preparation. **Submit structural analysis data signed and sealed by licensed professional engineer. ADDENDUM #2**

**STRUCTURAL STEEL
05 1200-1**

6. Indicate Architecturally Exposed Structural Steel designations of all AESS elements and ensure details comply with AESS Category requirements.
- C. Welding certificates.
- D. Qualification Data: For Installer, fabricator, professional engineer and, **testing and inspection agency. Submit qualification data indicating a minimum five years of experience with similar or larger project. ADDENDUM #2**
- E. Mill Test Reports: Signed by manufacturers certifying that the following products comply with requirements:
 1. Structural steel including chemical and physical properties.
 2. Bolts, nuts, and washers including mechanical properties and chemical analysis.
 3. Direct-tension indicators.
 4. Tension-control, high-strength bolt-nut-washer assemblies.
 5. Shear stud connectors.
 6. Shop primers.
 7. Nonshrink grout.
- F. Source quality-control test reports.

1.5 QUALITY ASSURANCE

- A. Installer Qualifications: A qualified installer who participates in the AISC Quality Certification Program and is designated an AISC-Certified Erector, Category CSE.
- B. Fabricator Qualifications: A qualified fabricator who participates in the AISC Quality Certification Program and is designated an AISC-Certified Plant, Category STD.
- C. **Testing and Inspection Agency: Testing and Inspection agency to follow International building code and AISC 360 requirement. ADDENDUM #2**
- D. Shop-Painting Applicators: Qualified according to AISC's Sophisticated Paint Endorsement P1 or SSPC-QP 3, "Standard Procedure for Evaluating Qualifications of Shop Painting Applicators."
- E. Welding: Qualify procedures and personnel according to AWS D1.1, "Structural Welding Code-Steel."
- F. Comply with applicable provisions of the following specifications and documents:
 1. AISC's "Code of Standard Practice for Steel Buildings and Bridges."
 2. AISC's "Seismic Provisions for Structural Steel Buildings" and "Supplement No. 2."
 3. AISC's "Specification for Structural Steel Buildings--Allowable Stress Design and Plastic Design."
 4. AISC's "Specification for the Design of Steel Hollow Structural Sections."
 5. AISC's "Specification for Allowable Stress Design of Single-Angle Members."
- G. Mockups: Build mockups of architecturally exposed structural steel to set quality standards for fabrication and installation.
 1. Coordinate finish painting and coating requirements with Division 9 sections.
 2. Approved mockups may become part of the completed Work if undisturbed at time of Substantial Completion.

STRUCTURAL STEEL 05 1200-2

- H. Preinstallation Conference: Conduct conference at Project site to comply with requirements in Division 1 Section "Project Management and Coordination."

1.6 DELIVERY, STORAGE, AND HANDLING

- A. Store materials to permit easy access for inspection and identification. Keep steel members off ground and spaced by using pallets, dunnage, or other supports and spacers. Protect steel members and packaged materials from erosion and deterioration.
 - 1. Store fasteners in a protected place. Clean and relubricate bolts and nuts that become dry or rusty before use.
 - 2. Do not store materials on structure in a manner that might cause distortion, damage, or overload to members or supporting structures. Repair or replace damaged materials or structures as directed.

1.7 COORDINATION

- A. Furnish anchorage items to be embedded in or attached to other construction without delaying the Work. Provide setting diagrams, sheet metal templates, instructions, and directions for installation.

PART 2 - PRODUCTS

2.1 STRUCTURAL-STEEL MATERIALS

- A. Recycled Content of Steel Products: Provide products with an average recycled content of steel products so postconsumer recycled content plus one-half of preconsumer recycled content is as great as possible but not less than a minimum of 50 percent.
- B. W-Shapes: ASTM A 992, Grade 50.
- C. Channels and Angles Shapes: ASTM A 36.
- D. Plate and Bar: ASTM A 36.
- E. Cold-Formed Hollow Structural Sections: ASTM A 500, Grade B, structural tubing.
- F. Steel Pipe: ASTM A 53, Type E or S, Grade B.
 - 1. Weight Class: as indicated.
 - 2. Finish: Black, except where indicated to be galvanized.
- G. Welding Electrodes: Comply with AWS requirements.

2.2 BOLTS, CONNECTORS, AND ANCHORS

- A. High-Strength Bolts, Nuts, and Washers: ASTM A 325, Type 1, heavy hex steel structural bolts; ASTM A 563 heavy hex carbon-steel nuts; and ASTM F 436 hardened carbon-steel washers.
 - 1. Finish: Plain or where exposed to weather Hot-dip zinc coating, ASTM A 153, Class C.
 - 2. Direct-Tension Indicators: ASTM F 959, Type 325 compressible-washer type.

**STRUCTURAL STEEL
05 1200-3**

- a. Finish: Plain
 - B. Shear Connectors: ASTM A 108, Grades 1015 through 1020, headed-stud type, cold-finished carbon steel; AWS D1.1, Type B.
 - C. Anchor Rods: ASTM F 1554, Grade 36.
 - 1. Configuration: as indicated on drawings.
 - 2. Nuts: ASTM A 563 heavy hex carbon steel.
 - 3. Washers: ASTM F 436 hardened carbon steel.
 - 4. Finish: Plain.
 - D. Threaded Rods: ASTM A 307, Grade A.
 - 1. Nuts: ASTM A 563 heavy hex carbon steel.
 - 2. Washers: ASTM A 36 carbon steel.
 - 3. Finish: Plain.
- 2.3 PRIMER
- A. Primer: Fabricator's standard lead- and chromate-free, nonasphaltic, rust-inhibiting primer and compatible with specified paintings and coatings.
 - B. Galvanizing Repair Paint: MPI#18, MPI#19, or SSPC-Paint 20.
- 2.4 GROUT
- A. Nonmetallic, Shrinkage-Resistant Grout: ASTM C 1107, factory-packaged, nonmetallic aggregate grout, noncorrosive, nonstaining, mixed with water to consistency suitable for application and a 30-minute working time.
- 2.5 FABRICATION
- A. Structural Steel: Fabricate and assemble in shop to greatest extent possible. Fabricate according to AISC's "Code of Standard Practice for Steel Buildings and Bridges" and AISC's "Specification for Structural Steel Buildings--Allowable Stress Design and Plastic Design."
 - 1. Camber structural-steel members where indicated.
 - 2. Identify high-strength structural steel according to ASTM A 6 and maintain markings until structural steel has been erected.
 - 3. Mark and match-mark materials for field assembly.
 - 4. Complete structural-steel assemblies, including welding of units, before starting shop-priming operations.
 - B. Architecturally Exposed Structural Steel: Comply with fabrication requirements, including tolerance limits, of AISC's "Code of Standard Practice for Steel Buildings and Bridges" (ANSI 303-16) for structural steel identified as architecturally exposed structural steel.
 - 1. All exposed structural steel is to comply with AESS Category 1: Basic Elements, as a minimum. Exposed columns, connections to columns, and cross bracing elements between columns are to comply with AESS Category 2: Feature Elements not in Close View.
 - C. Thermal Cutting: Perform thermal cutting by machine to greatest extent possible.

STRUCTURAL STEEL
05 1200-4

1. Plane thermally cut edges to be welded to comply with requirements in AWS D1.1.
- D. Bolt Holes: Cut, drill or punch standard bolt holes perpendicular to metal surfaces.
- E. Finishing: Accurately finish ends of columns and other members transmitting bearing loads.
- F. Cleaning: Clean and prepare steel surfaces that are to remain unpainted according to SSPC-SP 1, "Solvent Cleaning, SSPC-SP 2, "Hand Tool Cleaning or SSPC-SP 3, "Power Tool Cleaning."
- G. Shear Connectors: Prepare steel surfaces as recommended by manufacturer of shear connectors. Use automatic end welding of headed-stud shear connectors according to AWS D1.1 and manufacturer's written instructions.
- H. Steel Wall-Opening Framing: Select true and straight members for fabricating steel wall-opening framing to be attached to structural steel. Straighten as required to provide uniform, square, and true members in completed wall framing.
- I. Welded Door Frames: Build up welded door frames attached to structural steel. Weld exposed joints continuously and grind smooth. Plug-weld fixed steel bar stops to frames. Secure removable stops to frames with countersunk, cross-recessed head machine screws, uniformly spaced not more than 10 inches o.c., unless otherwise indicated.
- J. Holes: Provide holes required for securing other work to structural steel and for passage of other work through steel framing members.
 1. Cut, drill, or punch holes perpendicular to steel surfaces.
 2. Base-Plate Holes: Cut, drill, mechanically thermal cut, or punch holes perpendicular to steel surfaces.
 3. Weld threaded nuts to framing and other specialty items indicated to receive other work.

2.6 SHOP CONNECTIONS

- A. High-Strength Bolts: Shop install high-strength bolts according to RCSC's "Specification for Structural Joints Using ASTM A 325 or A 490 Bolts" for type of bolt and type of joint specified.
 1. Joint Type: Slip critical.
- B. Weld Connections: Comply with AWS D1.1 for welding procedure specifications, tolerances, appearance, and quality of welds and for methods used in correcting welding work.
 1. Remove backing bars or runoff tabs, back gouge, and grind steel smooth.
 2. Assemble and weld built-up sections by methods that will maintain true alignment of axes without exceeding tolerances of AISC's "Code of Standard Practice for Steel Buildings and Bridges" for mill material.
 3. Verify that weld sizes, fabrication sequence, and equipment used for architecturally exposed structural steel will limit distortions to allowable tolerances. Prevent weld show-through on exposed steel surfaces.
 - a. Grind butt welds flush.
 - b. Grind or fill exposed fillet welds to smooth profile. Dress exposed welds.

2.7 SHOP PRIMING

- A. Shop prime steel surfaces except the following:

**STRUCTURAL STEEL
05 1200-5**

1. Surfaces embedded in concrete or mortar. Extend priming of partially embedded members to a depth of 2 inches.
 2. Surfaces to be field welded.
 3. Surfaces to be high-strength bolted with slip-critical connections.
 4. Surfaces to receive sprayed fire-resistive materials.
 5. Galvanized surfaces.
- B. Surface Preparation: Clean surfaces to be painted. Remove loose rust and mill scale and spatter, slag, or flux deposits. Prepare surfaces according to the following specifications and standards:
1. SSPC-SP 2, "Hand Tool Cleaning."
 2. SSPC-SP 3, "Power Tool Cleaning."
 3. SSPC-SP 5/NACE No. 1, "White Metal Blast Cleaning."
 4. SSPC-SP 6/NACE No. 3, "Commercial Blast Cleaning." This is required by ANSI 303-16 for AESS elements.
 5. SSPC-SP 7/NACE No. 4, "Brush-Off Blast Cleaning."
 6. At natatorium and within anti-corrosive envelope, as indicated on the drawings; refer to 099600 "High Performance Coatings" for surface preparation.
- C. Priming: Immediately after surface preparation, apply primer according to manufacturer's written instructions and at rate recommended by SSPC to provide a dry film thickness of not less than 1.5 mils. Use priming methods that result in full coverage of joints, corners, edges, and exposed surfaces.
1. Stripe paint corners, crevices, bolts, welds, and sharp edges.
 2. Apply two coats of shop paint to inaccessible surfaces after assembly or erection. Change color of second coat to distinguish it from first. Primer color should be approved by the Engineer and the Architect.
 3. At natatorium and within anti-corrosive envelope, as indicated on the drawings; refer to 099600 "High Performance Coatings" for shop primers.
- D. Paintings and coatings of structural steel is specified in Division 9 Sections "Painting and Coating" and "High Performance Coatings." Shop priming to be compatible with finish coats specified in these sections.

2.8 GALVANIZING

- A. Hot-Dip Galvanized Finish: Apply zinc coating by the hot-dip process to structural steel according to ASTM A 123/ A 123M.
1. Fill vent holes and grind smooth after galvanizing.
 2. Galvanize lintels, shelf angles at the exterior wall and structural steel exposed to weather.

2.9 SOURCE QUALITY CONTROL

- A. The Contractor will engage an independent qualified testing and inspecting agency to perform shop tests and inspections and submit prepare inspection and test reports to the Engineer for approval.
1. Provide testing agency with access to places where structural-steel work is being fabricated or produced to perform tests and inspections.
 2. Structural tests and special inspections to be in accordance with International building code, chapter 17.

STRUCTURAL STEEL 05 1200-6

- B. All material before being incorporated in the work shall be inspected, tested by the contractor's independent agency and approved by the Engineer, Any work in which such materials are used without prior test and approval or written permission of the Engineer shall be considered defective and unauthorized and will not be paid for. Unless otherwise designated, when a reference is made in these specifications, to a specification, or test designation of ASTM, ACI or any other recognized non proprietary national organization, it shall mean the specification or test method which is current on the date of advertisement for bids. All materials used are subject to inspection, test or rejection at any time during the preparation and use.
- C. Correct deficiencies in Work that test reports and inspections indicate does not comply with the Contract Documents.
- D. Bolted Connections: Shop-bolted connections will be tested and inspected according to RCSC's "Specification for Structural Joints Using ASTM A 325 or A 490 Bolts."
- E. Welded Connections: In addition to visual inspection, shop-welded penetration connections will be tested and inspected according to AWS D1.1 and the following inspection procedures, at testing agency's option:
 - 1. Liquid Penetrant Inspection: ASTM E 165.
 - 2. Magnetic Particle Inspection: ASTM E 709; performed on root pass and on finished weld. Cracks or zones of incomplete fusion or penetration will not be accepted.
 - 3. Ultrasonic Inspection: ASTM E 164.
 - 4. Radiographic Inspection: ASTM E 94.

PART 3 - EXECUTION

3.1 EXAMINATION

- A. Verify elevations of concrete- and masonry-bearing surfaces and locations of anchor rods, bearing plates, and other embedments, with steel erector present, for compliance with requirements.
- B. Proceed with installation only after unsatisfactory conditions have been corrected.

3.2 PREPARATION

- A. Provide temporary shores, guys, braces, and other supports during erection to keep structural steel secure, plumb, and in alignment against temporary construction loads and loads equal in intensity to design loads. Remove temporary supports when permanent structural steel, connections, and bracing are in place, unless otherwise indicated.
 - 1. Do not remove temporary shoring supporting composite deck construction until cast-in-place concrete has attained its design compressive strength.

3.3 ERECTION

- A. Set structural steel accurately in locations and to elevations indicated and according to AISC's "Code of Standard Practice for Steel Buildings and Bridges" and "Specification for Structural Steel Buildings--Allowable Stress Design and Plastic Design."

STRUCTURAL STEEL 05 1200-7

- B. Base and Bearing Plates: Clean concrete- and masonry-bearing surfaces of bond-reducing materials and roughen surfaces prior to setting base and bearing plates. Clean bottom surface of base and bearing plates.
 - 1. Set base and bearing plates for structural members on wedges, shims, or setting nuts as required.
 - 2. Weld plate washers to top of base plate.
 - 3. Pretension anchor rods after supported members have been positioned and plumbed. Do not remove wedges or shims but, if protruding, cut off flush with edge of base or bearing plate before packing with grout.
 - 4. Promptly pack grout solidly between bearing surfaces and base or bearing plates so no voids remain. Neatly finish exposed surfaces; protect grout and allow to cure. Comply with manufacturer's written installation instructions for shrinkage-resistant grouts.
 - C. Maintain erection tolerances of structural steel and architecturally exposed structural steel within AISC's "Code of Standard Practice for Steel Buildings and Bridges."
 - D. Align and adjust various members forming part of complete frame or structure before permanently fastening. Before assembly, clean bearing surfaces and other surfaces that will be in permanent contact with members. Perform necessary adjustments to compensate for discrepancies in elevations and alignment.
 - 1. Level and plumb individual members of structure.
 - 2. Make allowances for difference between temperature at time of erection and mean temperature when structure is completed and in service.
 - E. Splice members only where indicated.
 - F. Remove erection bolts on welded, architecturally exposed structural steel; fill holes with plug welds; and grind smooth at exposed surfaces.
 - G. Do not use thermal cutting during erection unless approved by Engineer. If approved, finish thermally cut sections within smoothness limits in AWS D1.1.
 - H. Do not enlarge unfair holes in members by burning or using drift pins. Ream holes that must be enlarged to admit bolts.
 - I. Shear Connectors: Prepare steel surfaces as recommended by manufacturer of shear connectors. Use automatic end welding of headed-stud shear connectors according to AWS D1.1 and manufacturer's written instructions.
- 3.4 FIELD CONNECTIONS
- A. High-Strength Bolts: Install high-strength bolts according to RCSC's "Specification for Structural Joints Using ASTM A 325 or A 490 Bolts" for type of bolt and type of joint specified.
 - 1. Joint Type: Slip critical.
 - B. Weld Connections: Comply with AWS D1.1 for welding procedure specifications, tolerances, appearance, and quality of welds and for methods used in correcting welding work.
 - 1. Comply with AISC's "Code of Standard Practice for Steel Buildings and Bridges" and "Specification for Structural Steel Buildings--Allowable Stress Design and Plastic Design" for bearing, adequacy of temporary connections, alignment, and removal of paint on surfaces adjacent to field welds.
 - 2. Remove backing bars or runoff tabs, back gouge, and grind steel smooth.

**STRUCTURAL STEEL
05 1200-8**

3. Assemble and weld built-up sections by methods that will maintain true alignment of axes without exceeding tolerances of AISC's "Code of Standard Practice for Steel Buildings and Bridges" for mill material.
4. Verify that weld sizes, fabrication sequence, and equipment used for architecturally exposed structural steel will limit distortions to allowable tolerances. Prevent weld show-through on exposed steel surfaces.
 - a. Grind butt welds flush.
 - b. Grind or fill exposed fillet welds to smooth profile. Dress exposed welds.

3.5 FIELD QUALITY CONTROL

- A. Testing Agency: The Contractor will engage a qualified independent testing and inspecting agency to inspect field welds and high-strength bolted connections and submit test reports to the Engineer for review and approval.
 1. Structural tests and special inspections to be in accordance with International building code, chapter 17.
- B. All material before being incorporated in the work shall be inspected, tested and approved by the Contractor's independent inspection and testing agency. Any work in which such materials are used without prior test and approval or written permission of the Engineer shall be considered defective and unauthorized and will not be paid for. Unless otherwise designated, when a reference is made in these specifications, to a specification, or test designation of ASTM, ACI or any other recognized non proprietary national organization, it shall mean the specification or test method which is current on the date of advertisement for bids. All materials used are subject to inspection, test or rejection at any time during the preparation and use.
- C. Bolted Connections: Shop-bolted connections will be tested and inspected according to RCSC's "Specification for Structural Joints Using ASTM A 325 or A 490 Bolts."
- D. Welded Connections: Field welds will be visually inspected according to AWS D1.1.
 1. In addition to visual inspection, penetration field welds will be tested according to AWS D1.1 and the following inspection procedures, at testing agency's option:
 - a. Liquid Penetrant Inspection: ASTM E 165.
 - b. Magnetic Particle Inspection: ASTM E 709; performed on root pass and on finished weld. Cracks or zones of incomplete fusion or penetration will not be accepted.
 - c. Ultrasonic Inspection: ASTM E 164.
 - d. Radiographic Inspection: ASTM E 94.
- E. Correct deficiencies in Work that test reports and inspections indicate does not comply with the Contract Documents.

3.6 REPAIRS AND PROTECTION

- A. Repair damaged galvanized coatings on galvanized items with galvanized repair paint according to ASTM A 780 and manufacturer's written instructions.
- B. Touchup Painting: After installation, promptly clean, prepare, and prime or reprime field connections, rust spots, and abraded surfaces of prime-painted joists and accessories, bearing plates, and abutting structural steel.
 1. Clean and prepare surfaces by SSPC-SP 2 hand-tool cleaning or SSPC-SP 3 power-tool cleaning.

**STRUCTURAL STEEL
05 1200-9**

2. Apply a compatible primer of same type as shop primer used on adjacent surfaces.
- C. Touchup Painting: Cleaning and touchup painting for high performance coating are specified in Division 9 painting Sections.

END OF SECTION

**STRUCTURAL STEEL
05 1200-10**

TABLE 1704.3
 REQUIRED VERIFICATION AND INSPECTION OF STEEL CONSTRUCTION
 (REF. STANDARDS: AISC 360, AWS D1.1 & D1.3, APPLICABLE ASTM STANDARDS)

VERIFICATION AND INSPECTION	CONTINUOUS	PERIODIC
1. Material verification of high-strength bolts, nuts and washers:		
a. Identification markings to conform to ASTM standards specified in the approved construction documents.	–	X
b. Manufacturer's certificate of compliance required.	–	X
2. Inspection of high-strength bolting:		
a. Snug-tight joints.	–	X
b. Pretensioned and slip-critical joints using turn-of-nut with matchmarking, twist-off bolt or direct tension indicator methods of installation.	–	X
c. Pretensioned and slip-critical joints using turn-of-nut without matchmarking or calibrated wrench methods of installation.	X	–
3. Material verification of structural steel and cold-formed steel deck:		
a. For structural steel, identification markings to conform to AISC 360.	–	X
b. For other steel, identification markings to conform to ASTM standards specified in the approved construction documents.	–	X
c. Manufacturer's certified test reports.	–	X
4. Material verification of weld filler materials:		
a. Identification markings to conform to AWS specification in the approved construction documents.	–	X

TABLE 1704.3 - continued
 REQUIRED VERIFICATION AND INSPECTION OF STEEL CONSTRUCTION
 (REF. STANDARDS: AISC 360, AWS D1.1 & D1.3, APPLICABLE ASTM STANDARDS)

5. Inspection of Welding:		
a. Structural steel, steel deck and cold formed metal framing:		
1) Complete and partial joint penetration groove welds.	X	-
2) Multi-pass fillet welds.	X	-
3) Single-pass fillet welds > 5/16"	X	-
4) Plug and slot welds.	X	-
5) Single-pass fillet welds ≤ 5/16"	-	X
6) Floor and roof deck welds.	-	X
b. Reinforcing steel:		
1) Verification of weldability of reinforcing steel other than ASTM A 706.	-	X
2) Reinforcing steel resisting flexural and axial forces in intermediate and special moment frames, and boundary elements of special structural walls of concrete and shear reinforcement.	X	-
3) Shear reinforcement.	X	-
4) Other reinforcing steel.	-	X
6. Inspection of steel frame joint details for compliance:		
a. Details such as bracing and stiffening.	-	X
b. Member locations.	-	X
c. Application of joint details at each connection.	-	X

TABLE 1705.3
 REQUIRED VERIFICATION AND INSPECTION OF CONCRETE CONSTRUCTION
 (REF. ACI 318)

VERIFICATION AND INSPECTION	CONTINUOUS	PERIODIC
1. Inspection of reinforcing steel and placement.	–	X
2. Inspection of reinforcing steel welding in accordance with Table 1704.3, Item 5b.	–	–
3. Inspection of anchors cast in concrete where allowable loads have been increased or where strength design is used.	–	X
4. Inspection of anchors post-installed in hardened concrete members(b).	–	X
5. Verifying use of required design mix.	–	X
6. At the time fresh concrete is sampled to fabricate specimens for strength tests, perform slump and air content tests, and determine the temperature of the concrete.	X	–
7. Inspection of concrete and shotcrete placement for proper application techniques.	X	–
8. Inspection for maintenance of specified curing temperature and techniques.	–	X
9. Inspect formwork for shape, location and dimensions of the concrete member being formed.	–	X

TABLE 1705.6
 REQUIRED VERIFICATION AND INSPECTION OF SOILS

VERIFICATION AND INSPECTION TASK	CONTINUOUS	PERIODICALLY
1. Verify materials below shallow foundations are adequate to achieve the design bearing capacity.	–	X
2. Verify excavations are extended to proper depth and have reached proper material.	–	X
3. Perform classification and testing of compacted fill materials.	–	X
4. Verify use of proper materials, densities and lift thicknesses during placement and compaction of compacted fill.	X	–
5. Prior to placement of compacted fill, observe subgrade and verify that site has been prepared properly.	–	X
6.		

TABLE 1704.5.1
 LEVEL 1 REQUIRED VERIFICATION AND INSPECTION OF MASONRY CONSTRUCTION
 (REF. ACI 530)

VERIFICATION AND INSPECTION	CONTINUOUS	PERIODIC
1. Compliance with required inspection provisions of the construction documents and the approved submittals shall be verified.	-	X
2. Verification of f and f_{mC} prior to construction except where specifically exempted by this code.	-	X
3. Verification of slump flow and VSI as delivered to the site for self-consolidating grout.	X	-
4. As masonry construction begins, the following shall be verified to ensure compliance:		
a. Proportions of site-prepared mortar.	-	X
b. Construction of mortar joints.	-	X
c. Location of reinforcement, connectors, prestressing tendons and anchorages.	-	X
d. Prestressing technique.	-	X
e. Grade and size of prestressing tendons and anchorages.	-	X
5. During construction the inspection program shall verify:		
a. Size and location of structural elements.	-	X
b. Type, size and location of anchors, including other details of anchorage of masonry to structural members, frames or other construction.	-	X
b. Specified size, grade and type of reinforcement, anchor bolts, prestressing tendons and anchorages.	-	X
d. Welding of reinforcing bars.	X	-
e. Preparation, construction and protection of masonry during cold weather (temperature below 40°F) or hot weather (temperature above 90°F).	-	X
f. Application and measurement of prestressing force.	X	-

TABLE 1704.5.1 – continued
 LEVEL 1 REQUIRED VERIFICATION AND INSPECTION OF MASONRY CONSTRUCTION
 (REF. ACI 530)

VERIFICATION AND INSPECTION	CONTINUOUS	PERIODIC
6. Prior to grouting, the following shall be verified to ensure compliance:		
a. Grout space is clean.	–	X
b. Placement of reinforcement and connectors, and prestressing tendons and anchorages.	–	X
c. Proportions of site-prepared grout and prestressing grout for bonded tendons.	–	X
d. Construction of mortar joints.	–	X
7. Grout placement shall be verified to ensure compliance:	X	–
a. Grouting of prestressing bonded tendons.	X	–
8. Preparation of any required grout specimens, mortar specimens and/or prisms shall be observed.	–	X

SECTION 05 3100 - STEEL DECKING

PART 1 - GENERAL

1.1 SUMMARY

- A. This Section includes the following:
 - 1. Roof deck.
 - 2. Composite Floor Deck.

1.2 SUBMITTALS

- A. Product Data: For each type of deck, accessory, and product indicated.
- B. Shop Drawings: Show layout and types of deck panels, anchorage details, reinforcing channels, pans, deck openings, special jointing, accessories, and attachments to other construction.
- C. Product Certificates: Signed by steel deck manufacturers certifying that products furnished comply with requirements.
- D. Welding Certificates: Copies of certificates for welding procedures and personnel.
- E. Product Test Reports: From a qualified testing agency indicating that each of the following complies with requirements, based on comprehensive testing of current products:
 - 1. Mechanical fasteners.
 - 2. Acoustical roof deck.
- F. Research/Evaluation Reports: Evidence of steel deck's compliance with building code in effect for Project, from a model code organization acceptable to authorities having jurisdiction.

1.3 QUALITY ASSURANCE

- A. Manufacturer Qualifications: A firm experienced in manufacturing joists similar to those indicated for this Project and with a record of successful in-service performance.
 - 1. Manufacturer must be a member of a Steel Deck Institute.
 - 2. Assumes responsibility for engineering special decks to comply with performance requirements. This responsibility includes preparation of Shop Drawings and comprehensive engineering analysis by a qualified professional engineer.
 - 3. Professional Engineer Qualifications: A professional engineer who is legally authorized to practice in jurisdiction where Project is located and who is experienced in providing engineering services of the kind indicated. Engineering services are defined as those performed for installations of decks that are similar to those indicated for this Project in material, design, and extent.

**STEEL DECKING
05 3100-1**

- B. Installer Qualifications: An experienced installer who has completed steel deck similar in material, design, and extent to that indicated for this Project and whose work has resulted in construction with a record of successful in-service performance.
- C. Testing Agency Qualifications: An independent testing agency, acceptable to authorities having jurisdiction, qualified according to ASTM E 329 to conduct the testing indicated, as documented according to ASTM E 548.
- D. Welding: Qualify procedures and personnel according to AWS D1.1, "Structural Welding Code--Steel," and AWS D1.3, "Structural Welding Code--Sheet Steel."
- E. AISI Specifications: Calculate structural characteristics of steel deck according to AISI's "Specification for the Design of Cold-Formed Steel Structural Members."
- F. FM Listing: Provide steel roof deck evaluated by FM and listed in FM's "Approval Guide, Building Materials" for Class 1 fire rating and Class 1-90 windstorm ratings.
- G. Noise reduction coefficients shall be verified by the result of sound absorption tests conducted in accordance with ASTM C423 and E795.

1.4 DELIVERY, STORAGE, AND HANDLING

- A. Protect steel deck from corrosion, deformation, and other damage during delivery, storage, and handling.
- B. Stack steel deck on platforms or pallets and slope to provide drainage. Protect with a waterproof covering and ventilate to avoid condensation.

PART 2 - PRODUCTS

2.1 MANUFACTURERS

- A. Available Manufacturers: Subject to compliance with requirements, manufacturers offering products that may be incorporated into the Work include, but are not limited to, the following:
 - 1. Steel Deck:
 - a. BHP Steel Building Products USA Inc.
 - b. Consolidated Systems, Inc.
 - c. Epic Metals Corp.
 - d. Marlyn Steel Products, Inc.
 - e. Nucor Corp.; Vulcraft Div.
 - f. Roof Deck, Inc.
 - g. United Steel Deck, Inc.
 - h. Vercor Manufacturing Co.
 - i. Wheeling Corrugating Co.; Div. of Wheeling-Pittsburgh Steel Corp.
 - j. New Millennium Building Systems **ADDENDUM #2**

STEEL DECKING
05 3100-2

2.2 ROOF DECK

- A. Roof deck at the locations indicated on drawings.
- B. Roof Deck: Fabricate panels, without top-flange stiffening grooves, to comply with "SDI Specifications and Commentary for Steel Roof Deck," in SDI Publication No. 31, and with the following:
 - 1. Galvanized-Steel Sheet: ASTM A 653, Structural Steel (SS), Grade 33, G90 zinc coating.
 - 2. Deck Profile, depth and thickness: As indicated
 - 3. Side Laps: Overlapped or interlocking seam at Contractor's option.
- C. At natatorium and within anti-corrosive envelope, as indicated on the drawings; refer to 099600 "High Performance Coatings" for surface preparation and shop primer.

2.3 ACOUSTICAL ROOF DECK **ADDENDUM #2**

- A. Acoustical Roof Deck Manufacturer:
 - 1. Epic Metals Corporation; EpicDeck WP450A:
 - a. 18/18 gauge at Natatorium
 - b. 16/18 gauge at Gymnasium
 - 2. New Millennium Building Systems; DeepDek 4.5 Cellular Acoustical Roof:
 - a. 18/18 gauge at Natatorium
 - b. 18/16 gauge at Gymnasium
- B. Acoustic roof deck shall serve as a structural roof deck and a finished ceiling as indicated on the Drawings. Acoustical roof deck shall be cold-formed by the continuous roll forming process and resistance-welded together to form an integral cellular unit.
 - 1. Acoustical roof deck shall have interlocking and vertically self-aligning sidelaps that present a flush appearance with tight fitting joints from the underside.
 - 2. Acoustical roof deck shall have roll-formed embossments located between the longitudinal stiffening ribs in the top flanges and horizontal stiffening ribs along the vertical webs to enhance the structural performance.
 - 3. Shallow stiffening ribs shall be roll-formed into the bottom plates the acoustical roof deck. The ribs shall be located in the area between the webs to enhance flatness of the bottom plate.
- C. Acoustical Roof Deck: Fabricate panels, without top-flange stiffening grooves, to comply with "SDI Specifications and Commentary for Steel Roof Deck," in SDI Publication No. 31, and with the following:
 - 1. Galvanized and Shop-Primed Steel Sheet: ASTM A 653, Structural Steel (SS), G60 zinc coating; cleaned, pretreated, and primed with manufacturer's standard baked-on, rust-inhibitive primer.
 - a. Color: Gray top surface with white underside.
 - 2. Epoxy Intermediate Coat at Natatorium ceiling surface: Factory-applied, oven-baked polyamide epoxy, equal to Epic Metals Corporation "Natacoat."
 - 3. At natatorium and within anti-corrosive envelope, as indicated on the drawings; refer to 099600 "High Performance Coatings" for surface preparation and shop primer.
 - 4. Deck Profile: as indicated above. Perforated horizontal ceiling surface.
 - 5. Profile Depth: 4-1/2 inches.

STEEL DECKING
05 3100-3

6. Design Uncoated-Steel Thickness: 18 gauge. (Minimum)
7. Span Condition: Simple span.
8. Deck shall be fastened to all supporting members with 3/4" diameter puddle welds as indicated on the manufacturer's erection drawings, but not less than indicated on drawing.
9. Side Laps: Overlapped. Side laps shall be fastened together as indicated on manufacturer's erection drawings, but not less than indicated on drawing.
10. Acoustical Perforations: Deck units with manufacturer's standard perforated bottom ceiling surface.
11. Sound-Absorbing Insulation: The bottom plates in the area located between the webs shall be perforated for enhanced acoustic performance with uniform rows of holes. Acoustic elements shall be provided for the cells of the panels.
 - a. These shall be factory installed.
 - b. The acoustic elements shall be supported above the bottom plate by either individual push pins or continuous mesh to avoid plugging the perforations when field painting.
 - c. A minimum NRC value of .90 shall be provided. The value shall be established by sound absorption tests without the use of fiberglass insulation above the panels.
 - d. Properly sized sound absorbing elements encapsulated in polyethylene bags shall be provided in cavities of the acoustical roof deck.
 - e. To facilitate field painting of the perforated surfaces, the sound absorbing elements shall be supported on corrosion resistance mesh spacers. Sound absorbing elements and mesh spacers shall be factory installed.

2.4 COMPOSITE FORM DECK

- A. Composite Steel Form Deck: Fabricate ribbed-steel sheet composite form deck panels to comply with "SDI Specifications and Commentary for composite Steel Form Deck," in SDI Publication No. 29, the minimum section properties indicated, and the following:
 1. Galvanized Steel Sheet: ASTM A 653, Structural Steel (SS), Grade 33, G60 zinc coating.
 2. Profile Depth and steel thickness: as noted.
 3. Span Condition: As indicated.
 4. Side Laps: Overlapped or interlocking seam at Contractor's option.
- B. At natatorium and within anti-corrosive envelope, as indicated on the drawings; refer to 099600 "High Performance Coatings" for surface preparation and shop primer.

2.5 ACCESSORIES

- A. General: Provide manufacturer's standard accessory materials for deck that comply with requirements indicated.
- B. Mechanical Fasteners: Corrosion-resistant, low-velocity, power-actuated or pneumatically driven carbon-steel fasteners; or self-drilling, self-threading screws.
- C. Side-Lap Fasteners: Corrosion-resistant, hexagonal washer head; self-drilling, carbon-steel screws, No. 10 minimum diameter.
- D. Flexible Closure Strips: Vulcanized, closed-cell, synthetic rubber.
- E. Miscellaneous Sheet Metal Deck Accessories: Steel sheet, minimum yield strength of 33,000 psi, not less than 0.0359-inch design uncoated thickness, of same material and finish as deck; of profile indicated or required for application.

**STEEL DECKING
05 3100-4**

- F. Steel Sheet Accessories: Steel sheet, of same material, finish, and thickness as deck, unless otherwise indicated.
- G. Stops and Girder Fillers: Steel sheet, minimum yield strength of 33,000 psi, of same material and finish as deck, and of thickness and profile recommended by SDI Publication No. 29 for overhang and slab depth.
- H. Column Closures, End Closures, Z-Closures, and Cover Plates: Steel sheet, of same material, finish, and thickness as deck, unless otherwise indicated.
- I. Flat Sump Plates: Single-piece steel sheet, 0.0747 inch thick, of same material and finish as deck. For drains, cut holes in the field.
- J. Recessed Sump Pans: Single-piece steel sheet, 0.0747 inch thick, of same material and finish as deck, with 3-inch wide flanges and recessed pans of 1-1/2 minimum depth. For drains, cut holes in the field.
- K. Galvanizing Repair Paint: ASTM A 780 and SSPC-Paint 20 or DOD-P-21035, with dry film containing a minimum of 94 percent zinc dust by weight.

PART 3 - EXECUTION

3.1 EXAMINATION

- A. Examine supporting frame and field conditions for compliance with requirements for installation tolerances and other conditions affecting performance.

3.2 INSTALLATION, GENERAL

- A. Install deck panels and accessories according to applicable specifications and commentary in SDI Publication No. 29, manufacturer's written instructions, and requirements in this Section.
- B. Install temporary shoring before placing deck panels, if required to meet deflection limitations.
- C. Locate decking bundles to prevent overloading of supporting members.
- D. Place deck panels on supporting frame and adjust to final position with ends accurately aligned and bearing on supporting frame before being permanently fastened. Do not stretch or contract side-lap interlocks.
 - 1. Align deck panels for entire length of cell runs and align cells at ends of abutting panels.
- E. Place deck panels flat and square and fasten to supporting frame without warp or deflection.
- F. Cut and neatly fit deck panels and accessories around openings and other work projecting through or adjacent to decking.
- G. Provide additional reinforcement and closure pieces at openings as required for strength, continuity of decking, and support of other work.

**STEEL DECKING
05 3100-5**

- H. Comply with AWS requirements and procedures for manual shielded metal arc welding, appearance and quality of welds, and methods used for correcting welding work.
- I. Mechanical fasteners may be used in lieu of welding to fasten deck. Locate mechanical fasteners and install according to deck manufacturer's written instructions.

3.3 ROOF-DECK INSTALLATION

- A. Fasten roof-deck panels to steel supporting members and Side-Lap and Perimeter Edge Fastening. Refer to drawings for fastening requirement.
- B. End Bearing: Install deck ends over supporting frame with a minimum end bearing of 1-1/2 inches, with end joints as follows:
 - 1. End Joints: Lapped 2 inches minimum or butted at Contractor's option.
- C. Roof Sump Pans and Sump Plates: Install over openings provided in roof deck and weld flanges to top of deck. Space welds not more than 12 inches apart with at least one weld at each corner.
- D. Flexible Closure Strips: Install flexible closure strips over partitions, walls, and where indicated. Install with adhesive according to manufacturer's written instructions to ensure complete closure.
- E. Air Dams: Install air dams where acoustical roof deck transitions from interior to exterior. The acoustical perforations shall be omitted at exterior locations.
- F. Sound-Absorbing Insulation: Installation into topside ribs of acoustical roof deck over plastic mesh spacer according to manufacturer's written instructions.
- G. Acoustical Roof Deck: Refer to acoustical roof deck section 2.3 for fastening requirement.

3.4 FLOOR DECK INSTALLATION

- A. Fasten floor deck panels to steel supporting members by arc spot (puddle) welds of the surface diameter indicated and as follows:
 - 1. Weld Diameter: 5/8 inch, nominal.
 - 2. Weld Spacing: Weld edge ribs of panels at each support. Space additional welds an average of 18 inches apart, but not more than 20 inches apart.
 - 3. Weld Washers: Install weld washers at each weld location.
- B. Side-Lap and Perimeter Edge Fastening: Fasten side laps and perimeter edges of panels between supports, at intervals not exceeding the lesser of 1/2 of the span or 36 inches, and as one of the following method:
 - 1. Mechanically fasten with self-drilling No. 10 diameter or larger carbon-steel screws.
 - 2. Fasten with a minimum of 1-1/2-inch long welds.
- C. End Bearing: Install deck ends over supporting frame with a minimum end bearing of 1-1/2 inches, with end joints as follows:
 - 1. End Joints: Lapped or butted at Contractor's option.

**STEEL DECKING
05 3100-6**

- D. Pour Stops and Fillers: Weld steel sheet pour stops and fillers to supporting structure according to SDI recommendations, unless otherwise indicated.
- E. Floor Deck Closures: Weld steel sheet column closures, cell closures, and Z-closures to deck, according to SDI recommendations, to provide tight-fitting closures at open ends of ribs and sides of decking. Weld cover plates at changes in direction of floor deck panels, unless otherwise indicated.

3.5 FIELD QUALITY CONTROL

- A. Inspection and Testing: The Contractor will engage a qualified independent inspection and testing agency to perform field quality-control inspection and testing and submit reports to the Engineer for approval.
 - 1. Structural tests and special inspections to be in accordance with International building code, chapter 17.
- B. All material before being incorporated in the work shall be inspected, tested and approved by the Contractor's independent agency. Any work in which such materials are used without prior test and approval or written permission of the Engineer shall be considered defective and unauthorized and will not be paid for. Unless otherwise designated, when a reference is made in this specification, to a specification, or test designation of ASTM, ACI or any other recognized non proprietary national organization, it shall mean the specification or test method which is current on the date of advertisement for bids. All materials used are subject to inspection, test or rejection at any time during the preparation and use.
- C. Field welds will be subject to inspection.
- D. Testing agency will report test results promptly and in writing to the Engineer, Contractor, Architect and Structural Engineer.
- E. Remove and replace work that does not comply with specified requirements.
- F. Additional testing and inspecting, at Contractor's expense, will be performed to determine compliance of corrected work with specified requirements.

3.6 REPAIRS AND PROTECTION

- A. Galvanizing Repairs: Prepare and repair damaged galvanized coatings on both surfaces of deck with galvanized repair paint according to ASTM A 780 and manufacturer's written instructions.
- A. Repair Painting: Wire brush and clean rust spots, welds, and abraded areas on both surfaces of prime-painted deck immediately after installation, and apply repair paint.
 - 1. Apply repair paint, of same color as adjacent shop-primed deck, to bottom surfaces of deck exposed to view.
 - 2. Wire brushing, cleaning, and repair painting of bottom deck surfaces are included in Division 9 sections "High Performance Coatings" and "Painting and Coating."
 - 3. Clean and prepare bottom surface of acoustical roof deck for field painting as specified in Division 9 sections "High Performance Coatings" and "Painting and Coating."

**STEEL DECKING
05 3100-7**

- B. Provide final protection and maintain conditions to ensure that steel deck is without damage or deterioration at time of Substantial Completion.

END OF SECTION

**STEEL DECKING
05 3100-8**

SECTION 07 5423 - THERMOPLASTIC-POLYOLEFIN ROOFING (TPO)

PART 1 GENERAL

1.1 SECTION INCLUDES

- A. Adhered system with thermoplastic roofing membrane.
- B. Insulation, flat and tapered.
- C. Flashings.
- D. Commencement of work by General Contractor shall constitute acknowledgement by General Contractor that this specification can be satisfactorily executed, under the project conditions and with all necessary prerequisites for warranty acceptance by roofing membrane manufacturer. No modification of the Contract Sum will be made for failure to adequately examine the Contract Documents or the project conditions.

1.2 REFERENCE STANDARDS

- A. ASTM C177 - Standard Test Method for Steady-State Heat Flux Measurements and Thermal Transmission Properties by Means of the Guarded-Hot-Plate Apparatus.
- B. ASTM C209 - Standard Test Methods for Cellulosic Fiber Insulating Board.
- C. ASTM C473 - Standard Test Methods for Physical Testing of Gypsum Panel Products.
- D. ASTM C518 - Standard Test Method for Steady-State Thermal Transmission Properties by Means of the Heat Flow Meter Apparatus.
- E. ASTM C1177/C1177M - Standard Specification for Glass Mat Gypsum Substrate for Use as Sheathing.
- F. ASTM C1289 - Standard Specification for Faced Rigid Cellular Polyisocyanurate Thermal Insulation Board.
- G. ASTM C1549 - Standard Test Method for Determination of Solar Reflectance Near Ambient Temperature Using a Portable Solar Reflectometer.
- H. ASTM D638 - Standard Test Method for Tensile Properties of Plastics.
- I. ASTM D1004 - Standard Test Method for Tear Resistance (Graves Tear) of Plastic Film and Sheeting.
- J. ASTM D1621 - Standard Test Method for Compressive Properties Of Rigid Cellular Plastics.
- K. ASTM D1622/D1622M - Standard Test Method for Apparent Density of Rigid Cellular Plastics.
- L. ASTM D3273 - Standard Test Method for Resistance to Growth of Mold on the Surface of Interior Coatings in an Environmental Chamber.
- M. ASTM D6878/D6878M - Standard Specification for Thermoplastic Polyolefin Based Sheet Roofing.

**THERMOPLASTIC-POLYOLEFIN ROOFING (TPO)
07 5423-1**

- N. ASTM E84 - Standard Test Method for Surface Burning Characteristics of Building Materials.
- O. ASTM E136 - Standard Test Method for Behavior of Materials in a Vertical Tube Furnace At 750 Degrees C.
- P. FM 4470 - Approval Standard for Single-Ply, Polymer-Modified Bitumen Sheet, Built-Up Roof (BUR) and Liquid Applied Roof Assemblies for use in Class 1 and Noncombustible Roof Deck Construction.

1.3 SUBMITTALS

- A. Product Data:
 - 1. Provide membrane manufacturer's printed data sufficient to show that all components of roofing system, including insulation and fasteners, comply with the specified requirements and with the membrane manufacturer's requirements and recommendations for the system type specified; include data for each product used in conjunction with roofing membrane.
 - 2. Where UL or FM requirements are specified, provide documentation that shows that the roofing system to be installed is UL-Classified or FM-approved, as applicable; include data itemizing the components of the classified or approved system.
 - 3. Installation Instructions: Provide manufacturer's instructions to installer, marked up to show exactly how all components will be installed; where instructions allow installation options, clearly indicate which option will be used.
- B. Samples: Submit samples of at least the following:
 - 1. Sample of roof membrane.
 - 2. Sample of walkway pads.
- C. Shop Drawings: Provide:
 - 1. The roof membrane manufacturer's standard details customized for this project for all relevant conditions, including flashings, base tie-ins, roof edges, terminations, expansion joints, penetrations, and drains.
 - 2. For tapered insulation, provide project-specific layout and dimensions for each board.
- D. Specimen Warranty: Submit prior to starting work.
- E. Installer Qualifications: Letter from manufacturer attesting that the roofing installer meets the specified qualifications.
- F. Pre-Installation Notice: Copy to show that manufacturer's required Pre Installation Notice (PIN) has been accepted and approved by the manufacturer.
- G. Executed Warranty.

1.4 QUALITY ASSURANCE

- A. Installer Qualifications: Roofing installer shall have the following:
 - 1. Current approval, license, or authorization as applicator by the manufacturer.
 - 2. At least five years experience in installing specified system.
 - 3. Capability to provide payment and performance bond to Engineer.

THERMOPLASTIC-POLYOLEFIN ROOFING (TPO)
07 5423-2

1.5 DELIVERY, STORAGE AND HANDLING

- A. Deliver products in manufacturer's original containers, dry and undamaged, with seals and labels intact and legible.
- B. Store materials clear of ground and moisture with weather protective covering.
- C. Keep combustible materials away from ignition sources.

1.6 WARRANTY

- A. Comply with all warranty procedures required by manufacturer, including notifications, scheduling, and inspections.
- B. Warranty: Provide manufacturer's system warranty covering membrane, roof insulation, and other indicated components of the system, for the term indicated.
 - 1. Limit of Liability: No dollar limitation.
 - 2. Warranty Term: 20 years.
 - 3. Scope of Coverage: Repair leaks in the roofing system and damage caused by:
 - a. Ordinary wear and tear of the elements.
 - b. Manufacturing defect in Firestone brand materials.
 - c. Defective workmanship used to install these materials.
 - d. Damage due to winds up to 55 mph.

PART 2 PRODUCTS

2.1 MANUFACTURERS

- A. Acceptable Manufacturer - Roofing System: Firestone Building Products LLC, Carmel, IN: www.firestonebpc.com/#sle.
 - 1. Roofing systems manufactured by others are acceptable provided the roofing system is completely equivalent in materials and warranty conditions and the manufacturer meets the following qualifications:
 - a. Specializing in manufacturing the roofing system to be provided.
 - b. Minimum ten years of experience manufacturing the roofing system to be provided.
- B. Manufacturer of Insulation and Cover Boards: Same manufacturer as roof membrane.

2.2 ROOFING SYSTEM DESCRIPTION

- A. Roofing System: Thermoplastic polyolefin (TPO) single-ply membrane.
 - 1. Membrane Attachment: Fully adhered.
 - 2. Comply with applicable local building code requirements.
- B. Roofing System Components: Listed in order from the top of the roof down:
 - 1. Membrane: Thickness 0.072 inch, minimum. Factory fabricated into largest sheets possible.
 - 2. Base Sheet Over Insulation: fully adhered at roof type D5.1.3A, mechanically attached elsewhere. **ADDENDUM 2**
 - 3. Insulation Cover Board: High density polyisocyanurate; fully adhered at roof type D5.1.3A, mechanically attached elsewhere. **ADDENDUM 2**
 - 4. Insulation:

**THERMOPLASTIC-POLYOLEFIN ROOFING (TPO)
07 5423-3**

- a. Maximum Board Thickness: 3 inches; use as many layers as necessary; stagger joints in adjacent layers.
 - b. Tapered: Slope as indicated; provide minimum R-value at thinnest point; place tapered layer on bottom.
 - c. Total R-value of 30, minimum.
 - d. Top Layer: Polyisocyanurate foam board, non-composite; fully adhered at roof type D5.1.3A, mechanically attached elsewhere. **ADDENDUM 2**
 - e. Intermediate Layer(s), If Any: Polyisocyanurate foam board, non-composite; loose-laid, no attachment.
 - f. Bottom Layer: Polyisocyanurate foam board, non-composite; fully adhered at roof type D5.1.3A, mechanically attached elsewhere. **ADDENDUM 2**
 - g. Crickets: Tapered insulation of same type as specified for top layer; slope as indicated.
 - h. Vapor Barrier: As specified in 07 2500.
- 5. Deck Cover Board: Gypsum-based board, 1/2 inch thick; fully adhered at roof type D5.1.3A, mechanically attached elsewhere. **ADDENDUM 2**
 - 6. Base Sheet: Fire-rated coated glass fiber slip sheet, loose-laid.

2.3 MEMBRANE MATERIALS

- A. Membrane: Flexible, heat weldable sheet composed of thermoplastic polyolefin polymer and ethylene propylene rubber; complying with ASTM D6878/D6878M, with polyester weft inserted reinforcement and the following additional characteristics:
 - 1. Thickness: 0.060 inch plus/minus 10 percent, with coating thickness over reinforcement of 0.024 inch plus/minus 10 percent.
 - 2. Puncture Resistance: 265 lbf, minimum, when tested in accordance FTM 101C Method 2031.
 - 3. Solar Reflectance: 0.79, minimum, when tested in accordance with ASTM C1549.
 - 4. Color 1: White. Refer to drawings for locations. **ADDENDUM 1**
 - 5. Color 2: Gray. Refer to drawings for locations. Gray not required to meet solar reflectance minimum above. **ADDENDUM 1**
- B. Slip Sheet: Coated glass fiber mat; qualified as part of Class A assembly over combustible and non-combustible decks, complying with ASTM D828 tensile testing.
- C. Membrane Fasteners: Type and size as required by roof membrane manufacturer for roofing system and warranty to be provided; use only fasteners furnished by roof membrane manufacturer.
- D. Curb and Parapet Flashing: Same material as membrane, with encapsulated edge which eliminates need for seam sealing the flashing-to-roof splice; precut to 18 inches wide.
- E. Formable Flashing: Non-reinforced, flexible, heat weldable sheet, composed of thermoplastic polyolefin polymer and ethylene propylene rubber.
 - 1. Thickness: 0.060 inch plus/minus 10 percent.
 - 2. Tensile Strength: 1550 psi, minimum, when tested in accordance with ASTM D638 after heat aging.
 - 3. Elongation at Break: 650 percent, minimum, when tested in accordance with ASTM D638 after heat aging.
 - 4. Tearing Strength: 12 lbf, minimum, when tested in accordance with ASTM D1004 after heat aging.
 - 5. Color: White.
 - 6. Acceptable Product: UltraPly TPO Flashing by Firestone.

THERMOPLASTIC-POLYOLEFIN ROOFING (TPO)
07 5423-4

- F. Tape Flashing: 5-1/2 inch nominal wide TPO membrane laminated to cured rubber polymer seaming tape, overall thickness 0.065 inch nominal; TPO QuickSeam Flashing by Firestone.
- G. Bonding Adhesive: Neoprene and SBR rubber blend, formulated for compatibility with the membrane other substrate materials, including masonry, wood, and insulation facings; UltraPly Bonding Adhesive by Firestone.
- H. Pourable Sealer: Two-part polyurethane, two-color for reliable mixing; Pourable Sealer by Firestone.
- I. Seam Plates: Steel with barbs and Galvalume coating; corrosion-resistance complying with FM 4470.
- J. Termination Bars: Aluminum bars with integral caulk ledge; 1.3 inches wide by 0.10 inch thick; Firestone Termination Bar by Firestone.
- K. Cut Edge Sealant: Synthetic rubber-based, for use where membrane reinforcement is exposed; UltraPly TPO Cut Edge Sealant by Firestone.
- L. General Purpose Sealant: EPDM-based, one part, white general purpose sealant; UltraPly TPO General Purpose Sealant by Firestone.
- M. Molded Flashing Accessories: Unreinforced TPO membrane pre-molded to suit a variety of flashing details, including pipe boots, inside corners, outside corners, etc.; UltraPly TPO Small and Large Pipe Flashing by Firestone.
- N. Roof Walkway Pads: Non-reinforced TPO walkway pads, 0.130 inch by 30 inches by 40 feet long with patterned traffic bearing surface; UltraPly TPO Walkway Pads by Firestone.

2.4 ROOF INSULATION AND COVER BOARDS

- A. Polyisocyanurate Board Insulation: Closed cell polyisocyanurate foam with black glass reinforced mat laminated to faces, complying with ASTM C1289 Type II Class 1, with the following additional characteristics:
 - 1. Thickness: As indicated elsewhere.
 - 2. Size: 48 inches by 96 inches, nominal.
 - a. Exception: Insulation to be attached using adhesive or asphalt may be no larger than 48 inches by 48 inches, nominal.
 - 3. R-value (LTTR):
 - a. 1.0 inch Thickness: 6.0, minimum.
 - b. 1.25 inch Thickness: 7.5, minimum.
 - c. 1.5 inch Thickness: 9.0, minimum.
 - d. 1.75 inch Thickness: 10.5, minimum.
 - e. 2.0 inch Thickness: 12.1, minimum.
 - f. 3.0 inch Thickness: 18.5, minimum.
 - g. 4.0 inch Thickness: 25.0, minimum.
 - 4. Compressive Strength: 20 psi when tested in accordance with ASTM C1289.
 - 5. Ozone Depletion Potential: Zero; made without CFC or HCFC blowing agents.
 - 6. Recycled Content: 19 percent post-consumer and 15 percent pre-consumer (post-industrial), average.

THERMOPLASTIC-POLYOLEFIN ROOFING (TPO)
07 5423-5

- B. High Density Polyisocyanurate Cover Board: Non-combustible, water resistant, high density closed cell polyisocyanurate core with coated glass mat facers, with the following characteristics:
 - 1. Size: 48 inches by 96 inches, nominal.
 - 2. Thickness: 1/2 inch.
 - 3. Thermal Value: R-value of 2.5, when tested in accordance with ASTM C518 and ASTM C177.
 - 4. Surface Water Absorption: 3 percent, maximum, when tested in accordance with ASTM C209.
 - 5. Compressive Strength: 120 psi, when tested in accordance with ASTM D1621.
 - 6. Density: 5 pcf, when tested in accordance with ASTM D1622/D1622M.
 - 7. Factory Mutual approved for use with FM 1-60 and 1-90 rated roofing assemblies.
 - 8. Mold Growth Resistance: Passing ASTM D3273.

- C. Gypsum-Based Cover Board: Non-combustible, water resistant gypsum core with embedded glass mat facers, complying with ASTM C1177/C1177M, and with the following additional characteristics:
 - 1. Size: 48 inches by 96 inches, nominal.
 - a. Exception: Board to be attached using adhesive or asphalt may be no larger than 48 inches by 48 inches, nominal.
 - 2. Thickness: As indicated elsewhere.
 - 3. Surface Water Absorption: 2.5 g, maximum, when tested in accordance with ASTM C473.
 - 4. Spanning Capability: Recommended by manufacturer for following minimum flute spans:
 - 5. Surface Burning Characteristics: Flame spread index of 0 (zero), smoke developed index of 0 (zero), when tested in accordance with ASTM E84.
 - 6. Combustibility: Non-combustible, when tested in accordance with ASTM E136.
 - 7. Factory Mutual approved for use with FM 1-60 and 1-90 rated roofing assemblies.
 - 8. Mold Growth Resistance: Zero growth, when tested in accordance with ASTM D3273 for minimum of 4 weeks.

- D. Insulation Fasteners: Type and size as required by roof membrane manufacturer for roofing system and warranty to be provided; use only fasteners furnished by roof membrane manufacturer. **ADDENDUM 2**

- E. Adhesive for Insulation Attachment: Type as required by roof membrane manufacturer for roofing system and warranty to be provided; use only adhesives furnished by roof membrane manufacturer. **ADDENDUM 2**

PART 3 EXECUTION

3.1 GENERAL

- A. Install roofing, insulation, flashings, and accessories in accordance with roofing manufacturer's published instructions and recommendations for the specified roofing system. Where manufacturer provides no instructions or recommendations, follow good roofing practices and industry standards. Comply with federal, state, and local regulations.

- B. Obtain all relevant instructions and maintain copies at project site for duration of installation period.

- C. Do not start work until Pre-Installation Notice has been submitted to manufacturer as notification that this project requires a manufacturer's warranty.

**THERMOPLASTIC-POLYOLEFIN ROOFING (TPO)
07 5423-6**

- D. Perform work using competent and properly equipped personnel.
- E. Temporary closures, which ensure that moisture does not damage any completed section of the new roofing system, are the responsibility of the applicator. Completion of flashings, terminations, and temporary closures shall be completed as required to provide a watertight condition.
- F. Install roofing membrane only when surfaces are clean, dry, smooth and free of snow or ice; do not apply roofing membrane during inclement weather or when ambient conditions will not allow proper application; consult manufacturer for recommended procedures during cold weather. Do not work with sealants and adhesives when material temperature is outside the range of 60 to 80 degrees F.
- G. Protect adjacent construction, property, vehicles, and persons from damage related to roofing work; repair or restore damage caused by roofing work.
 - 1. Protect from spills and overspray from bitumen, adhesives, sealants and coatings.
 - 2. Particularly protect metal, glass, plastic, and painted surfaces from bitumen, adhesives, and sealants within the range of wind-borne overspray.
 - 3. Protect finished areas of the roofing system from roofing related work traffic and traffic by other trades.
- H. Until ready for use, keep materials in their original containers as labeled by the manufacturer.
- I. Consult membrane manufacturer's instructions, container labels, and Material Safety Data Sheets (MSDS) for specific safety instructions. Keep all adhesives, sealants, primers and cleaning materials away from all sources of ignition.

3.2 EXAMINATION

- A. Examine roof deck to determine that it is sufficiently rigid to support installers and their mechanical equipment and that deflection will not strain or rupture roof components or deform deck.
- B. Verify that surfaces and site conditions are ready to receive work. Correct defects in the substrate before commencing with roofing work.
- C. Examine roof substrate to verify that it is properly sloped to drains.
- D. Verify that the specifications and drawing details are workable and not in conflict with the roofing manufacturer's recommendations and instructions; start of work constitutes acceptable of project conditions and requirements.

3.3 PREPARATION

- A. Take appropriate measures to ensure that fumes from adhesive solvents are not drawn into the building through air intakes.
- B. Prior to proceeding, prepare roof surface so that it is clean, dry, and smooth, and free of sharp edges, fins, roughened surfaces, loose or foreign materials, oil, grease and other materials that may damage the membrane.
- C. Fill all surface voids in the immediate substrate that are greater than 1/4 inch wide with fill material acceptable insulation to membrane manufacturer.

THERMOPLASTIC-POLYOLEFIN ROOFING (TPO)
07 5423-7

- D. Seal, grout, or tape deck joints, where needed, to prevent bitumen seepage into building.

3.4 VAPOR RETARDER

- A. Before installing insulation install vapor retarder directly over the deck.
- B. Ensure that all penetrations and edge conditions are sealed to prevent moisture and air drive into the roofing system.

3.5 INSULATION AND COVER BOARD INSTALLATION

- A. Install insulation in configuration and with attachment method(s) specified in PART 2, under Roofing System.
- B. Install insulation in a manner that will not compromise the vapor retarder integrity.
- C. Install only as much insulation as can be covered with the completed roofing system before the end of the day's work or before the onset of inclement weather.
- D. Lay roof insulation in courses parallel to roof edges.
- E. Neatly and tightly fit insulation to all penetrations, projections, and nailers, with gaps not greater than 1/4 inch. Fill gaps greater than 1/4 inch with acceptable insulation. Do not leave the roofing membrane unsupported over a space greater than 1/4 inch.
- F. Mechanical Fastening: Using specified fasteners and insulation plates engage fasteners through insulation into deck to depth and in pattern required by membrane manufacturer.
- G. Cold Adhesive Attachment: Apply in accordance with membrane manufacturer's instructions and recommendations; "walk-in" individual roof insulation boards to obtain maximum adhesive contact. **ADDENDUM 2**

3.6 SINGLE-PLY MEMBRANE INSTALLATION

- A. Beginning at low point of roof, place membrane without stretching over substrate and allow to relax at least 30 minutes before attachment or splicing; in colder weather allow for longer relax time.
- B. Lay out the membrane pieces so that field and flashing splices are installed to shed water.
- C. Install membrane without wrinkles and without gaps or fishmouths in seams; bond and test seams and laps in accordance with membrane manufacturer's instructions and details.
- D. Install membrane adhered to the substrate, with edge securement as specified.
- E. Adhered Membrane: Bond membrane sheet to substrate using membrane manufacturer's recommended bonding material, application rate, and procedures.
- F. Edge Securement: Secure membrane at all locations where membrane terminates or goes through an angle change greater than 2 in 12 inches using mechanically fastened reinforced perimeter fastening strips, plates, or metal edging as indicated or as recommended by roofing manufacturer.
 - 1. Exceptions: Round pipe penetrations less than 18 inches in diameter and square penetrations less than 4 inches square.

THERMOPLASTIC-POLYOLEFIN ROOFING (TPO)
07 5423-8

2. Metal edging is not merely decorative; ensure anchorage of membrane as intended by roofing manufacturer.

3.7 FLASHING AND ACCESSORIES INSTALLATION

- A. Install flashings, including laps, splices, joints, bonding, adhesion, and attachment, as required by membrane manufacturer's recommendations and details.
- B. Metal Accessories: Install metal edgings, gravel stops, and copings in locations indicated on the drawings, with horizontal leg of edge member over membrane and flashing over metal onto membrane.
 1. Follow roofing manufacturer's instructions.
 2. Remove protective plastic surface film immediately before installation.
 3. Install water block sealant under the membrane anchorage leg.
 4. Flash with manufacturer's recommended flashing sheet unless otherwise indicated.
 5. Where single application of flashing will not completely cover the metal flange, install additional piece of flashing to cover the metal edge.
 6. If the roof edge includes a gravel stop and sealant is not applied between the laps in the metal edging, install an additional piece of self-adhesive flashing membrane over the metal lap to the top of the gravel stop; apply seam edge treatment at the intersections of the two flashing sections.
 7. When the roof slope is greater than 1:12, apply seam edge treatment along the back edge of the flashing.
- C. Scuppers: Set in sealant and secure to structure; flash as recommended by manufacturer.
- D. Roofing Expansion Joints: Install as shown on drawings and as recommended by roofing manufacturer.
- E. Flashing at Walls, Curbs, and Other Vertical and Sloped Surfaces: Install weathertight flashing at all walls, curbs, parapets, curbs, skylights, and other vertical and sloped surfaces that the roofing membrane abuts to; extend flashing at least 8 inches high above membrane surface.
 1. Use the longest practical flashing pieces.
 2. Evaluate the substrate and overlay and adjust installation procedure in accordance with membrane manufacturer's recommendations.
 3. Complete the splice between flashing and the main roof sheet with specified splice adhesive before adhering flashing to the vertical surface.
 4. Provide termination directly to the vertical substrate as shown on roof drawings.
- F. Roof Drains:
 1. Taper insulation around drain to provide smooth transition from roof surface to drain. Use specified pre-manufactured tapered insulation with facer or suitable bonding surface to achieve slope; slope not to exceed manufacturer's recommendations.
 2. Position membrane, then cut a hole for roof drain to allow 1/2 to 3/4 inch of membrane to extend inside clamping ring past drain bolts.
 3. Make round holes in membrane to align with clamping bolts; do not cut membrane back to bolt holes.
 4. Apply sealant on top of drain bowl where clamping ring seats below the membrane
 5. Install roof drain clamping ring and clamping bolts; tighten clamping bolts to achieve constant compression.
- G. Flashing at Penetrations: Flash all penetrations passing through the membrane; make flashing seals directly to the penetration.

1. Pipes, Round Supports, and Similar Items: Flash with specified pre-molded pipe flashings wherever practical; otherwise use specified self-curing elastomeric flashing.
2. Pipe Clusters and Unusual Shaped Penetrations: Provide penetration pocket at least 2 inches deep, with at least 1 inch clearance from penetration, sloped to shed water.
3. Structural Steel Tubing: If corner radii are greater than 1/4 inch and longest side of tube does not exceed 12 inches, flash as for pipes; otherwise, provide a standard curb with flashing.
4. Flexible and Moving Penetrations: Provide weathertight gooseneck set in sealant and secured to deck, flashed as recommended by manufacturer.
5. High Temperature Surfaces: Where the in-service temperature is, or is expected to be, in excess of 180 degrees F, protect the elastomeric components from direct contact with the hot surfaces using an intermediate insulated sleeve as flashing substrate as recommended by membrane manufacturer.

3.8 FINISHING AND WALKWAY INSTALLATION

- A. Install walkways at access points to the roof, around rooftop equipment that may require maintenance, and where indicated on the drawings.
- B. Walkway Pads: Adhere to the roofing membrane, spacing each pad at minimum of 1.0 inch and maximum of 3.0 inches from each other to allow for drainage.
 1. If installation of walkway pads over field fabricated splices or within 6 inches of a splice edge cannot be avoided, adhere another layer of flashing over the splice and extending beyond the walkway pad a minimum of 6 inches on either side.
 2. Prime the membrane, remove the release paper on the pad, press in place, and walk on pad to ensure proper adhesion.

3.9 FIELD QUALITY CONTROL

- A. Inspection by Manufacturer: Provide final inspection of the roofing system by a Technical Representative employed by roofing system manufacturer specifically to inspect installation for warranty purposes (i.e. not a sales person).
- B. Perform all corrections necessary for issuance of warranty.

3.10 CLEANING

- A. Clean all contaminants generated by roofing work from building and surrounding areas, including bitumen, adhesives, sealants, and coatings.
- B. Repair or replace building components and finished surfaces damaged or defaced due to the work of this section; comply with recommendations of manufacturers of components and surfaces.
- C. Remove leftover materials, trash, debris, equipment from project site and surrounding areas.

3.11 PROTECTION

- A. Where construction traffic must continue over finished roof membrane, provide durable protection and replace or repair damaged roofing to original condition.

END OF SECTION

THERMOPLASTIC-POLYOLEFIN ROOFING (TPO)
07 5423-10

SECTION 08 4413 - GLAZED ALUMINUM CURTAIN WALLS

PART 1 GENERAL

1.1 SECTION INCLUDES

- A. Aluminum-framed curtain wall, with vision glazing and glass infill panels.

1.2 REFERENCE STANDARDS

- A. AAMA CW-10 - Care and Handling of Architectural Aluminum From Shop to Site.
- B. AAMA 501.2 - Quality Assurance and Diagnostic Water Leakage Field Check of Installed Storefronts, Curtain Walls, and Sloped Glazing Systems.
- C. AAMA 503 - Voluntary Specification for Field Testing of Newly Installed Storefronts, Curtain Walls and Sloped Glazing Systems.
- D. AAMA 609 & 610 - Cleaning and Maintenance Guide for Architecturally Finished Aluminum (Combined Document).
- E. AAMA 1503 - Voluntary Test Method for Thermal Transmittance and Condensation Resistance of Windows, Doors and Glazed Wall Sections.
- F. AAMA 2605 - Voluntary Specification, Performance Requirements and Test Procedures for Superior Performing Organic Coatings on Aluminum Extrusions and Panels (with Coil Coating Appendix).
- G. ASTM A36/A36M - Standard Specification for Carbon Structural Steel.
- H. ASTM A123/A123M - Standard Specification for Zinc (Hot-Dip Galvanized) Coatings on Iron and Steel Products.
- I. ASTM B221 - Standard Specification for Aluminum and Aluminum-Alloy Extruded Bars, Rods, Wire, Profiles, and Tubes.
- J. ASTM B221M - Standard Specification for Aluminum and Aluminum-Alloy Extruded Bars, Rods, Wire, Profiles, and Tubes (Metric).
- K. ASTM C1401 - Standard Guide for Structural Sealant Glazing
- L. ASTM E283 - Standard Test Method for Determining the Rate of Air Leakage Through Exterior Windows, Curtain Walls, and Doors Under Specified Pressure Differences Across the Specimen.
- M. ASTM E783 - Standard Test Method for Field Measurement of Air Leakage Through Installed Exterior Windows and Doors.
- N. ASTM E783 - Standard Test Method for Field Measurement of Air Leakage Through Installed Exterior Windows and Doors
- O. ASTM E1105 - Standard Test Method for Field Determination of Water Penetration of Installed Exterior Windows, Skylights, Doors, and Curtain Walls, by Uniform or Cyclic Static Air Pressure Difference.

**GLAZED ALUMINUM CURTAIN WALLS
08 4413-1**

- P. SSPC-Paint 20 - Zinc-Rich Primers (Type I, "Inorganic," and Type II, "Organic").

1.3 ADMINISTRATIVE REQUIREMENTS

- A. Coordinate with installation of other components that comprise the exterior enclosure.
- B. Preinstallation Meeting: Conduct a preinstallation meeting one week before starting work of this section; require attendance by all affected installers.

1.4 SUBMITTALS

- A. Product Data: Provide component dimensions, describe components within assembly, anchorage and fasteners, internal drainage details, glazing, and infill.
- B. Shop Drawings: Indicate system dimensions, framed opening requirements and tolerances, affected related Work, expansion and contraction joint location and details, and field welding required. Submit signed and sealed shop drawings.
- C. Shop Drawings: Provide details of proposed structural sealant glazing (SSG) and weather sealant joints indicating dimensions, materials, bite, thicknesses, profile, and support framing.
- D. Samples: Submit two samples 2 by 6 inches in size illustrating finished aluminum surface, and.
- E. Manufacturer's Certificate: Certify that the products supplied meet or exceed the specified requirements.
- F. Design Data: Provide framing member structural and physical characteristics and engineering calculations, and identify dimensional limitations; include load calculations at points of attachment to building structure. Submit signed and sealed calculations.
- G. Field Quality Control Submittals: Report of field testing for water penetration and air leakage.
- H. Warranty: Submit manufacturer warranty and ensure forms have been completed in Engineer's name and registered with manufacturer.

1.5 QUALITY ASSURANCE

- A. Designer Qualifications: Design curtain wall and its structural support framing components under direct supervision of a Professional Structural Engineer experienced in design of this work and licensed at the State in which the Project is located.
- B. Manufacturer Qualifications: Company specializing in manufacturing products specified in this section with not less than three years of documented experience.
- C. Installer Qualifications: Company specializing in performing work of type specified and with at least three years of documented experience.
- D. Product Options: Information on Drawings and in Specifications establishes requirements for aesthetic effects and performance characteristics of assemblies. Aesthetic effects are indicated by dimensions, arrangements, alignment, and profiles of components and assemblies as they relate to sightlines, to one another, and to adjoining construction.

**GLAZED ALUMINUM CURTAIN WALLS
08 4413-2**

1.6 MOCK-UP

- A. Provide mock-up as indicated on the drawings, including each component being used on the project. Assemble to illustrate component assembly including glazing materials, weep drainage system, attachments, anchors, and perimeter sealant.

1.7 DELIVERY, STORAGE, AND HANDLING

- A. Handle products of this section in accordance with AAMA CW-10.
- B. Protect finished aluminum surfaces with wrapping. Do not use adhesive papers or sprayed coatings that bond to aluminum when exposed to sunlight or weather.

1.8 FIELD CONDITIONS

- A. Do not install sealants when ambient temperature is less than 40 degrees F. Maintain this minimum temperature during and 48 hours after installation.

1.9 WARRANTY

- A. Correct defective Work within a two year period after Date of Substantial Completion.
- B. Provide five year manufacturer warranty against failure of glass seal on insulating glass units, including interpane dusting or misting. Include provision for replacement of failed units.
- C. Provide five year manufacturer warranty against excessive degradation of exterior finish. Include provision for replacement of units with excessive fading, chalking, or flaking.

PART 2 PRODUCTS

2.1 MANUFACTURERS

- A. Glazed Aluminum Curtain Walls: EFCO, a Pella Company; 5600 XTherm: www.efcocorp.com/#sle. **ADDENDUM #2**
 - 1. Other Manufactures:
 - a. Kawneer North America: www.kawneer.com/#sle.
 - b. Oldcastle Building Envelope: www.oldcastlebe.com/#sle.

2.2 CURTAIN WALL

- A. Aluminum-Framed Curtain Wall: Factory fabricated, factory finished aluminum framing members with infill, and related flashings, anchorage and attachment devices.
 - 1. Outside glazed, with pressure plate and mullion cover, where indicated on drawings.
 - 2. Finish: Superior performing organic coatings.
 - a. Factory finish surfaces that will be exposed in completed assemblies.
 - b. Touch-up surfaces cut during fabrication so that no natural aluminum is visible in completed assemblies, including joint edges.
 - c. Coat concealed metal surfaces that will be in contact with cementitious materials or dissimilar metals with bituminous paint.
 - 3. Provide flush joints and corners, weathersealed, accurately fitted and secured; prepared to receive anchors; fasteners and attachments concealed from view; reinforced as required for imposed loads.

**GLAZED ALUMINUM CURTAIN WALLS
08 4413-3**

4. Construction: Eliminate noises caused by wind and thermal movement, prevent vibration harmonics, and prevent "stack effect" in internal spaces.
 5. System Internal Drainage: Drain to the exterior by means of a weep drainage network any water entering joints, condensation occurring in glazing channel, and migrating moisture occurring within system.
 6. Air and Vapor Seal: Maintain continuous air barrier and vapor retarder throughout assembly, primarily in line with inside pane of glazing and inner sheet of infill panel and heel bead of glazing compound.
- B. Structural Performance Requirements: Design and size components to withstand the following load requirements without damage or permanent set. Any steel reinforcing required inside the mullions based on the design, shall be included.
1. Design Wind Loads: Comply with loads as indicated on Structural Drawings.
 2. Seismic Loads: Design and size components to withstand seismic loads and sway displacement in accordance with loads as indicated on Structural Drawings.
 3. Movement: Accommodate the following movement without damage to components or deterioration of seals:
 - a. Expansion and contraction caused by 180 degrees F surface temperature.
 - b. Expansion and contraction caused by cycling temperature range of 170 degrees F over a 12 hour period.
 - c. Movement of curtain wall relative to perimeter framing.
 - d. Deflection of structural support framing, under permanent and dynamic loads.
- C. Water Penetration Resistance on Manufactured Assembly: No uncontrolled water on indoor face when tested as follows:
1. Test Pressure Differential: 15 psf.
- D. Air Leakage Laboratory Test: Maximum of 0.06 cu ft/min sq ft of wall area, when tested in accordance with ASTM E283 at 6.27 psf pressure differential across assembly.
- E. Thermal Performance Requirements:
1. Condensation Resistance Factor of Framing: 70, minimum, measured in accordance with AAMA 1503.
 2. Overall U-value Including Glazing: 0.34 Btu/(hr sq ft deg F), maximum.

2.3 COMPONENTS

- A. Aluminum Framing Members: Tubular aluminum sections, thermally broken with interior section insulated from exterior, drainage holes and internal weep drainage system.
1. Framing members for interior applications need not be thermally broken.
 2. Cross-Section: 2-1/2 inch width by 6 inch nominal dimension and 2-1/2 inch width by 7-1/2 inch, as indicated on the drawings.
 3. Structurally Reinforced Members: Extruded aluminum with internal reinforcement of structural steel member.
- B. Glazing: As specified in Section 08 8000.
- C. Pressure Plates: Fiberglass
- D. Sun Screens (Keynotes: 084413-I, 084413-J, 084413-K; Alternate No. 3): Shop fabricated, shop finished, extruded aluminum outriggers, louvers, and fascia, free of defects impairing strength, durability or appearance.
1. Sun Screen Configuration: As indicated on drawings.
 2. Louver Type: Airfoil.

GLAZED ALUMINUM CURTAIN WALLS 08 4413-4

3. Sun Screen Angle: 0 degrees from horizontal.
4. Outrigger Shape: Straight.
5. Design Criteria: Design and fabricate to resist the same loads as curtain wall system as indicated on the drawings.
6. Sizes: As indicated on drawings.
7. Shop fabricate to the greatest extent possible; disassemble if necessary for shipping.

2.4 MATERIALS

- A. Extruded Aluminum: ASTM B221 (ASTM B221M).
- B. Structural Steel Sections: ASTM A36/A36M; galvanized in accordance with requirements of ASTM A123/A123M.
- C. Structural Supporting Anchors Attached to Structural Steel: Design for bolted attachment.
- D. Fasteners: Stainless steel; type as required or recommended by curtain wall manufacturer.
- E. Fiberglass Pressure Plate
- F. Glazing Gaskets: Type to suit application to achieve weather, moisture, and air infiltration requirements.
- G. Glazing Accessories: As specified in Section 08 8000.
- H. Touch-Up Primer for Galvanized Steel Surfaces: SSPC-Paint 20, zinc rich.
- I. Fiberglass Pressure Plate:
 1. Material shall be a fiberglass composite with a Flexural strength of no less than 82 ksi (565 Mpa) along the lineal's major axis.
 2. Material thermal conductivity shall be no more than 2 BTU in/hr ft² degree F (0.289 W/m².K)

2.5 FINISHES

- A. Superior Performing Organic Coatings: AAMA 2605 multiple coat, thermally cured polyvinylidene fluoride system.
- B. Color: Color 1: PPG Cosmic Gray Mica, UC106686F; Color 2: Metallic Mist UC106703XL; Color 3: Drylac Bengal Red 049/33333. Locations as indicated on drawings..

PART 3 EXECUTION

3.1 EXAMINATION

- A. Verify dimensions, tolerances, and method of attachment with other related work.
- B. Verify that curtain wall openings and adjoining air and vapor seal materials are ready to receive work of this section.
- C. Verify that anchorage devices have been properly installed and located.

GLAZED ALUMINUM CURTAIN WALLS
08 4413-5

3.2 INSTALLATION

- A. Install curtain wall system in accordance with manufacturer's instructions.
- B. Attach to structure to permit sufficient adjustment to accommodate construction tolerances and other irregularities.
- C. Provide alignment attachments and shims to permanently fasten system to building structure.
- D. Align assembly plumb and level, free of warp or twist. Maintain assembly dimensional tolerances, aligning with adjacent work.
- E. Provide thermal isolation where components penetrate or disrupt building insulation.
- F. Install sill flashings. Turn up ends and edges; seal to adjacent work to form water tight dam.
- G. Coordinate attachment and seal of perimeter air and vapor barrier materials.
- H. Pack fibrous insulation in shim spaces at perimeter of assembly to maintain continuity of thermal barrier.
- I. Pressure Plate Framing: Install glazing and infill panels in accordance with Section 08 8000, using exterior dry glazing method.
- J. Touch-up minor damage to factory applied finish; replace components that cannot be satisfactorily repaired.

3.3 TOLERANCES

- A. Maximum Variation from Plumb: 0.06 inches every 3 ft non-cumulative or 0.5 inches per 100 ft, whichever is less.
- B. Maximum Misalignment of Two Adjoining Members Abutting in Plane: 1/32 inch.
- C. Sealant Space Between Curtain Wall Mullions and Adjacent Construction: Maximum of 3/4 inch and minimum of 1/4 inch.

3.4 FIELD QUALITY CONTROL

- A. Provide services of curtain wall manufacturer's field representative to observe for proper installation of system and submit report.
- B. See Section 01 4000 - Quality Requirements, for independent field testing and inspection requirements, and requirements for monitoring quality of specified product installations.
- C. Water-Spray Test: Provide water spray quality test of installed curtain wall components in accordance with AAMA 501.2 during construction process and before installation of interior finishes.
 - 1. Perform a minimum of two tests in each designated area as directed by Architect.
 - 2. Conduct tests in each area prior to 10 percent and 50 percent completion of this work.
- D. Provide field testing of installed curtain wall system by independent laboratory in accordance with AAMA 503 during construction process and before installation of interior finishes.
 - 1. Perform a minimum of two tests in each designated area as directed by Architect.

**GLAZED ALUMINUM CURTAIN WALLS
08 4413-6**

2. Conduct tests in each area prior to 10 percent and 50 percent completion of this work.
 3. Field test for water penetration in accordance with ASTM E1105 with uniform static air pressure difference (Procedure A) not less than 4.18 psf.
 - a. Maximum allowable rate of water penetration in 15-minute test is 0.5 ounce that is not contained in an area with provisions to drain to exterior, or collected on surface of interior horizontal framing member.
 4. Field test for air leakage in accordance with ASTM E783 with uniform static air pressure difference of 1.57 psf.
 - a. Maximum allowable rate of air leakage is 0.09 cfm/sq ft.
- E. Repair or replace curtain wall components that have failed designated field testing, and retest to verify performance conforms to specified requirements.
- F. Testing Agency: Engage a qualified testing agency to perform tests and inspections.
- G. Test Area: Perform tests on one bay at least 30 feet (9.1 m), by one story.
- H. Glazed aluminum curtain walls will be considered defective if they do not pass tests and inspections.
- I. Prepare test and inspection reports.

3.5 CLEANING

- A. Remove protective material from pre-finished aluminum surfaces.
- B. Wash down surfaces with a solution of mild detergent in warm water, applied with soft, clean wiping cloths, take care to remove dirt from corners, and wipe surfaces clean.
- C. Upon completion of installation, thoroughly clean aluminum surfaces in accordance with AAMA 609 & 610.

3.6 PROTECTION

- A. Protect installed products from damage until Date of Substantial Completion.

END OF SECTION

GLAZED ALUMINUM CURTAIN WALLS 08 4413-7

SECTION 11 6623 - GYMNASIUM EQUIPMENT

PART 1 GENERAL

1.1 SECTION INCLUDES

- A. Basketball backboards, goals, and support framing.
- B. Floor sleeves for net and goal posts.
- C. Wall mounted protection pads.
- D. Gym divider curtains.
- E. Volleyball nets, posts, and floor sleeves.
- F. Scoreboard and shot clocks.
- G. Wall mounted metal benches.

1.2 REFERENCE STANDARDS

- A. AWS D1.1/D1.1M - Structural Welding Code - Steel.
- B. NFPA 70 - National Electrical Code.
- C. NFPA 101 - Life Safety Code.

1.3 SUBMITTALS

- A. Product Data: Provide manufacturer's data showing configuration, sizes, materials, finishes, hardware, and accessories; include:
 - 1. Electrical characteristics and connection locations.
 - 2. Structural steel welder certifications.
 - 3. Manufacturer's installation instructions.
- B. Samples: Submit samples of wall pad coverings, metal bench cushions, and divider curtain in manufacturer's available range of colors.
- C. Warranty: Submit manufacturer warranty and ensure that forms have been completed in Engineer's name and registered with manufacturer.

1.4 WARRANTY

- A. Provide 5 year manufacturer warranty for materials and workmanship, including but not limited to: basketball backboard failures including glass breakage, and faulty operation of basketball backstops.

**GYMNASIUM EQUIPMENT
11 6623-1**

PART 2 PRODUCTS

2.1 MANUFACTURERS

- A. Gymnasium Equipment:
 - 1. Draper, Inc; : www.draperinc.com/#sle.
 - 2. IPI by Bison, Inc; : www.ipibybison.com/#sle.
 - 3. Performance Sports Systems; : www.perfsports.com/#sle.
 - 4. Porter Athletic Equipment Company; : www.porterathletic.com/#sle.
 - 5. Builtrite Bleachers: www.builtritebleachers.com
 - 6. Daktronics: www.daktronics.com

2.2 GENERAL REQUIREMENTS

- A. See drawings for sizes and locations, unless noted otherwise.
- B. Provide mounting plates, brackets, and anchors of sufficient size and strength to securely attach equipment to building structure; comply with requirements of contract documents.
- C. Hardware: Heavy duty steel hardware, as recommended by manufacturer.
- D. Electrical Wiring and Components: Comply with NFPA 70; provide UL-listed equipment.
- E. Structural Steel Fabrications: Welded in accordance with AWS D1.1/D1.1M, using certified welders.

2.3 DIVIDER CURTAINS

- A. Gymnasium Divider Curtains, Alternate No. 5:
 - 1. Curtain Material: Class A rated, self-extinguishing vinyl coated polyester meeting NFPA 101.
 - a. Upper Section: 9 oz/sq yd vinyl mesh fabric.
 - 1) Color: As selected from manufacturer's standard range.
 - b. Lower Section: 18 oz/sq yd solid vinyl coated polyester.
 - 1) Color: As selected from manufacturer's standard range.
 - 2. Operation: Vertical lift roll-up, curtain coils on bottom rail .
 - 3. Controls: Group control touch pad.
 - a. Touch pad to include all backstops and divider curtain.
 - b. Product: Performance Sports Systems Keypad group controller; TSC1500.

ADDENDUM 2

2.4 BENCHES

- A. Wall-mounted Metal Folding Bench: Hide-A-Bench. (Keynote: 116623-K)
 - 1. 2-Tier, clear anodized aluminum bench.
 - 2. Length: Provide in manufacturer's standard lengths.
 - 3. Provide integrated pads to match gymnasium wall pads.

2.5 BASKETBALL

- A. Basketball System: Backstop assembly, backboard, and goal.

GYMNASIUM EQUIPMENT 11 6623-2

- B. Ceiling-Suspended Backstop Assemblies: Capable of mounting both rectangular and fan-shaped backboards.
 - 1. Framing: Center strut; forward folding and side folding framing.
 - 2. Folding Control System: Electric hoist that folds backstop with 115 volt actuator, integral limit switches that provide automatic shut-off in both positions, and safety catch with automatic reset.
 - 3. Height Adjuster: Raises or lowers assembly by 2 feet to adjust goal height.
 - 4. Height Control System: Electric hoist that adjusts backstop with 115 volt actuator, and integral limit switches that provide automatic shut-off in both positions.
 - 5. Controls: Group control touch pad.
 - a. Touch pad to include all backstops and divider curtain.
 - b. Product: Performance Sports Systems Keypad group controller; TSC1500.
 - 6. Framing Color: Manufacturer's standard.
- C. Backboards: Tempered glass, rectangular shaped.
 - 1. Frame: Brushed aluminum edge, steel mounting.
 - 2. Provide conversion frame, mountable on both assemblies designed for fan shaped backboards and assemblies designed for rectangular backboards.
 - 3. Markings: Painted.
 - 4. Provide safety padding for bottom edge of backboard.
 - 5. Provide mounting kit.
 - 6. Color: Manufacturer's standard.
- D. Goals: Steel rim, mounted to backboard, with attached nylon anti-whip net; complete with mounting hardware.
 - 1. Net Attachment Device: Tube-tie.
 - 2. Breakaway mechanism, adjustable.
 - 3. Provide safety pad for goal mounting.
 - 4. Finish: Powder coat orange.

ADDENDUM 2

2.6 FLOOR-MOUNTED EQUIPMENT

- A. Volley Ball Nets and Posts: One court system of adjustable posts, net, and tensioning winch meeting requirements for FIVB, USA Volleyball, NCAA and NFHS competition requirements.
 - 1. Posts: 3-1/2 inch O.D. schedule 80 aluminum tube with 1 inch height adjustments between 42 and 96 inches.
 - 2. Net: 4 inch square #36 nylon cord with vinyl coated polyester hem, double stitched around the perimeter.
 - 3. Tensioning Winch: Manual crank heavy duty, self-locking worm gear mechanism.
- B. Floor Sleeves for Posts: Metal sleeve, with latch cover, cast into concrete subfloor to hold poles for nets and goals; installed flush with finish floor surface.
 - 1. Latch Cover: Brass, round; tamper resistant lock with key.
 - 2. Sleeve: Aluminum.
 - 3. Depth of Sleeve: 9 inches from floor surface to bottom, including latch cover.

2.7 WALL PADDING

- A. Safety Wall Padding: Foam filling bonded to backing board, wrapped in covering; each panel fabricated in one piece.
 - 1. Covering: Vinyl-coated polyester fabric, mildew and rot resistant; stapled to back of board.
 - a. Color: As selected from manufacturer's standard range.

**GYMNASIUM EQUIPMENT
11 6623-3**

- b. Texture: Embossed leather-look.
 - c. Fabric Weight: 14 oz/sq yd.
 - 2. **ADDENDUM #2**
 - 3. Foam: Open cell polychloroprene (Neoprene) 5.5 pcf nominal density.
 - 4. Foam Thickness: 1-1/2 inches.
 - 5. Backing Board: Plywood.
 - 6. Panel Dimensions: As indicated on drawings.
 - 7. Mounting: Permanent; using screws.
- B. Specially Shaped Padding: Same construction as standard padding; custom fabricate to fit irregularly shaped members, areas, and protrusions in gymnasium as indicated; provide padding for:
- 1. Structural Steel including columns and cross-bracing, as indicated on drawings.

2.8 ELECTRONIC SCOREBOARD AND CONTROL CONSOLE

- A. Main Electronic LED Scoreboard (Keynote: 116623-F): Daktronics BB-2103 single sided basketball scoreboard which can also score volleyball and wrestling.
- 1. Scoreboard displays period time to 99:59, HOME and GUEST scores to 199, PERIOD to nine, PLAYER number to 99, player FOUL to nine, team FOULS to 19, optional time outs left to nine and indicates possession, bonus. When period time is less than one minute, the scoreboard displays time to tenths-of-a-second.
 - 2. Include vibrating horn mounted behind the scoreboard face, which sounds automatically when period clock counts down to zero and can be sounded manually as controlled by the operator.
 - 3. Display digits to be LED, seven bar segments per digit.
 - 4. Wireless operation. **ADDENDUM 2**
- B. Main Electronic LED Scoreboard (Keynote: 116623-H): Daktronics BB-2121 single sided basketball scoreboard which can also score volleyball and wrestling.
- 1. Scoreboard displays period time to 99:59, HOME and GUEST scores to 199, PERIOD to nine, optional time outs left to nine and indicates possession, bonus. When period time is less than one minute, the scoreboard displays time to tenths-of-a-second.
 - 2. Include vibrating horn mounted behind the scoreboard face, which sounds automatically when period clock counts down to zero and can be sounded manually as controlled by the operator.
 - 3. Display digits to be LED, seven bar segments per digit.
 - 4. Wireless operation. **ADDENDUM 2**
- C. Scoreboard Control Console: Daktronics All Sport 5000 Control Console.
- 1. Capable of scoring basketball, volleyball, and wrestling through the use of keyboard inserts.
 - 2. Console shall recall clock, score and period information if power is lost.
 - 3. Has a practice timer mode.
 - 4. Can sound horn at the end of each segment.
 - 5. Has 99 programmable segments.
 - 6. Displays the segment number and length.
 - 7. Has a programmable interval time.
 - 8. Has a 2.4 GHz spread spectrum radio for scoreboard control.
 - 9. Durable carrying case.
 - 10. Console face is water resistant.
 - 11. Controls both main and secondary scoreboard together.

**GYMNASIUM EQUIPMENT
11 6623-4**

2.9 SHOT CLOCKS

- A. Shot Clock: Daktronics BB-2114 single sided basketball shot timer.
 - 1. Shot Timer displays shot times up to 59 seconds and counts down from any preset time between 0 and 59 seconds. Includes two displays.
 - 2. Display digits to be LED, seven bar segments per digit.
 - 3. Mount each shot clock to main court backstops in accordance with manufacturer's instructions. Untio to be plumb and level.
 - 4. Shot clock displays are controlled by basketball scoreboard control console. Provide hand held start/stop reset switch.
 - 5. Wireless operation. **ADDENDUM 2**
- B. Shot Clock Bracket: Arizona Courtliners, Inc. (ACI) Shot Clock Rack - Bank Extension Mounted.

PART 3 EXECUTION

3.1 EXAMINATION

- A. Take field measurements to ensure proper fitting of work. If taking field measurements before fabrication will delay work, allow for adjustments within recommended tolerances.
- B. Inspect areas and conditions before installation, and notify Architect in writing of unsatisfactory or detrimental conditions.
- C. Do not proceed with this work until conditions have been corrected; commencing installation constitutes acceptance of work site conditions.
- D. Verify that electrical services are correctly located and have proper characteristics.

3.2 INSTALLATION

- A. Install in accordance with contract documents and manufacturer's instructions.
- B. Coordinate installation of inserts and anchors that must be built in to flooring or subflooring.
- C. Install equipment rigid, straight, plumb, and level.
- D. Secure equipment with manufacturer's recommended anchoring devices.
- E. Install wall padding securely, with edges tight to wall and without wrinkles in fabric covering.
- F. Separate dissimilar metals to prevent electrolytic corrosion.

3.3 ADJUSTING

- A. Verify proper placement of equipment.
- B. Verify proper placement of equipment anchors and sleeves, and use actual movable equipment to be anchored if available.
- C. Adjust operating equipment for proper operation; remove and replace equipment causing noise or vibration; lubricate equipment as recommended by manufacturer.

**GYMNASIUM EQUIPMENT
11 6623-5**

3.4 CLEANING

- A. Remove masking or protective covering from finished surfaces.
- B. Clean equipment in accordance with manufacturer's recommendations.

3.5 PROTECTION

- A. Protect installed products until Date of Substantial Completion.
- B. Replace damaged products before Date of Substantial Completion.

END OF SECTION

SECTION 12 6613 - TELESCOPING BLEACHERS

PART 1 GENERAL

1.1 SECTION INCLUDES

- A. Telescoping bleachers.
- B. Electric motor operators, controls, and internal wiring.

1.2 REFERENCE STANDARDS

- A. ADA Standards - Americans with Disabilities Act (ADA) Standards for Accessible Design.
- B. NFPA 102 - Standard for Grandstands, Folding and Telescopic Seating, Tents, and Membrane Structures.
- C. PS 1 - Structural Plywood.
- D. AWS D1.1/D1.1M - Structural Welding Code - Steel.
- E. AWS D1.3/D1.3M - Structural Welding Code - Sheet Steel.

1.3 SUBMITTALS

- A. Product Data: Manufacturer's data sheets on each product to be used, including:
 - 1. Preparation instructions and recommendations.
 - 2. Storage handling and requirements.
 - 3. Installation methods.
- B. Shop Drawings: Complete layout with dimensions, seat heights, row spacing and rise, aisle widths and locations, points of connection to substrate, assembly dimensions, and material types and finishes.
 - 1. Provide drawings customized to this project.
 - 2. Include Professional Engineer certification.
- C. Selection Samples: For each material for which color selection is required, submit samples, 2 by 2 inches in size, illustrating colors and finishes available.
- D. Operation and Maintenance Data: Manufacturer's operation and maintenance instructions, including annual inspection and maintenance and bi-annual inspection by a Professional Engineer or manufacturer factory service personnel.
- E. Warranty: Submit manufacturer warranty and ensure that forms have been completed in Engineer's name and registered with manufacturer.

1.4 QUALITY ASSURANCE

- A. Manufacturer Qualifications: Company specializing in manufacturing products specified in this section, with not less than three years of documented experience.
- B. Installer Qualifications: Manufacturer's installation crew.

**TELESCOPING BLEACHERS
12 6613-1**

- C. Welder Qualifications: Certified by AWS for the process employed.

1.5 DELIVERY, STORAGE, AND HANDLING

- A. Store, in original packaging, under cover and elevated above grade.

1.6 WARRANTY

- A. Correct defective Work within a five year period after Date of Substantial Completion. Replace parts that fail under normal use at no extra charge to Engineer.

PART 2 PRODUCTS

2.1 MANUFACTURERS

- A. Telescoping Bleachers:
 1. Interkal LLC; : www.interkal.com/#sle.
 2. Irwin Telescopic Seating Company; : www.irwintelescopicseating.com/#sle.
 3. Hussey Seating Company; : www.husseyseating.com/#sle.

2.2 TELESCOPING BLEACHERS

- A. Telescoping Bleachers: Factory assembled tiered benches that retract horizontally into depth approximately the same as a single row depth, with fixed seats mounted on leading edge of platforms.
 1. Provide a design certified by a licensed Professional Engineer licensed in the State in which the Project is located.
 2. Design to comply with applicable requirements of NFPA 102 and requirements of code authorities having jurisdiction; where conflicts between requirements occur, comply with whichever is more stringent.
 3. Design with solid fascia (riser) or seat fronts that conceal interior mechanisms when fully retracted, fitting tightly enough to prevent climbing up face; at front row provide key locked, hinged fascia (skirt) to cover gap between seat riser/fascia and floor.
 4. Configurations: As indicated on drawings.
 5. Wheelchair Spaces: Comply with ADA Standards as required for project. Allow portions of first row to be manually retracted without affecting other rows as required; provide removable railings at row two behind wheelchair spaces. ADDENDUM #2
 6. Cutouts: Fit units to irregular wall surfaces, columns, pilasters, roof drain leaders, and other obstructions; take field measurements prior to fabrication.
 7. Operation:
 - a. Base Bid: Manual operated.
 - b. Alternate No. 4: Motor operated.
- B. Design Loads: Design to withstand the following loading conditions:
 1. Live Load on Structural Supports: 100 psf, minimum, of gross horizontal projection.
 2. Live Load on Seats and Walking Surfaces: 120 pounds per linear foot.
 3. Lateral Sway Stress on Structural Supports: 24 pounds per linear foot of seat plank.
 4. Perpendicular Sway Stress on Structural Supports: 10 pounds per linear foot of seat plank.
- C. Dimensions:
 1. See drawings for overall dimensions.

**TELESCOPING BLEACHERS
12 6613-2**

2. Rows: 5.
 3. Rise Per Row: 10 inches.
 4. Row Depth: 22 inches.
 5. Seat Height Above Tread: 6 inches.
- D. Structural Supports: Steel or aluminum; manufacturer's standard wheeled carriages supporting each tier separately, with moving parts permanently lubricated and metal parts cushioned to prevent metal-to-metal contact during operation.
1. Design so that each row carriage so that it will individually support the design loads and is self supporting when fully assembled without dependence on platform panels or boards, seats, or fascia.
 2. Welding: In accordance with AWS D1.1/D1.1M and AWS D1.3/D1.3M.
 3. Bolting: Use lock-washers or locknuts.
 4. Wheels: Minimum 5 inch diameter by 1-1/8 inch wide, with non-marring rubber tires; ball, roller, or oil-impregnated metal bearings; minimum of 2 wheels at each floor support.
 5. Finish: Manufacturer's standard enamel or powder coating.
 6. Row Locking: Automatically mechanically lock each carriage to adjacent carriages when fully extended.
 7. Unlocking: Provide single manual release mechanism to allow retraction of all carriages, concealed behind skirt board of first row.

2.3 SEAT AND PLATFORM COMPONENTS

- A. Seat/Fascia Assembly: Continuous, molded UV-stabilized high-density polyethylene plastic, seat minimum 1 inch thick, textured finish, homogeneous color throughout, color as selected from manufacturer's standard selection; approximately 18 inch long sections independently removable with tongue-and-groove or rabbeted interlock at end joints.
1. Shape: Ergonomically contoured, with internal ribs spaced for natural flexibility; rear edge cantilevered to provide toe room of not less than 3 inches; no openings to trap debris.
 2. Provide end caps of same material and finish on each exposed end.
 3. Supports: Internal steel reinforcement of each seat segment bolted to platform nose member; minimum two bolts per segment.
- B. Platform, Tread, and Step Structure: Plywood continuously supported on front and rear with side joints tongue-and-grooved.
1. Plywood: PS 1, 5-ply southern pine or polyethylene-overlaid douglas fir or southern pine, Grade A-C.
 2. Plywood Thickness: 5/8 inch, minimum.
 3. Front (Nose), Rear, and Intermediate Supports: Steel channel or tube, hot-dipped galvanized.
 4. Provide end caps of same material and finish on each exposed end.
 5. Finish: High gloss clear urethane, both sides, unless polyethylene finished.
 6. Nosings: Formed steel,, minimum, G60/Z275 hot-dipped galvanized.

2.4 HANDRAILS AND RAILINGS

- A. Provide the following railings:
1. End of Row Guardrails: Self-storing, at open ends of sections beginning at row 2.
 2. Height: 42 inches above adjacent platform or tread.
- B. Design handrails and railings to withstand the following loads:
1. Live Load on Guardrails:
 - a. Horizontal: 50 pounds per linear foot, applied at the guardrail height.
 - b. Vertical: 100 pounds per linear foot, applied vertically to top of guardrail.

TELESCOPING BLEACHERS 12 6613-3

- C. Railing Construction: Round steel or aluminum pipe or tube, with formed elbows at corners and caps at ends of straight runs.
 - 1. Steel: 1-1/2 inch minimum outside diameter, with 11 gage, 0.12 inch minimum wall thickness; textured powder coat epoxy finish.

2.5 ACCESSORIES

- A. Fillers and Closures:
 - 1. Ends of Retracted Units: Plywood panels, finished to match platforms.
 - 2. Top Row: Provide seat level rear filler panels to close openings between top row seat and wall; finish to match platforms.
- B. Fasteners: Provide hardware and fasteners in accordance with manufacturer's recommendations.

PART 3 EXECUTION

3.1 EXAMINATION

- A. Verify that field measurements are consistent with those on the shop drawings.
- B. Do not begin installation until substrates have been properly prepared and area has been cleared of obstructions.
- C. If substrate preparation is the responsibility of another installer, notify Architect of unsatisfactory preparation before proceeding.

3.2 PREPARATION

- A. Clean surfaces thoroughly prior to installation.
- B. Prepare surfaces using the methods recommended by the manufacturer for achieving the best result for the substrate under the project conditions.

3.3 INSTALLATION

- A. Install in accordance with manufacturer's instructions.
- B. Do not field cut or alter seats, fascia, or structural members without approval.
- C. Provide manufacturer's field representative to inspect completed installation.

3.4 ADJUSTING

- A. Lubricate, test, and adjust each moving assembly to ensure proper operation in compliance with manufacturer's recommendations.

3.5 CLEANING

- A. Clean exposed and semi-exposed assembly surfaces.
- B. Touch up finishes on damaged or soiled areas.

TELESCOPING BLEACHERS 12 6613-4

3.6 PROTECTION

- A. Protect installed products until completion of project.
- B. Touch-up, repair, or replace damaged products before Date of Substantial Completion.

END OF SECTION

**TELESCOPING BLEACHERS
12 6613-5**

SECTION 26 0010 - ELECTRICAL GENERAL PROVISIONS

PART 1 - GENERAL

1.1 RELATED DOCUMENTS

- A. Drawings and general provisions of the Contract, including General and Supplementary Conditions and Division 1 Specification Sections, apply to this Section.

1.2 SCOPE

- A. General: The provisions of this section are general and are intended to apply to all electrical sections, to govern the quality of design, fabrication, workmanship and operation of materials, equipment and appurtenances to be furnished and/or installed thereunder.
- B. Equipment: All electrical equipment, including but not limited to, wiring devices, wiring materials and electrical construction materials shall be new and of the highest quality and latest improved design.
- C. Workmanship: Workmanship shall be of the highest grade and all installation work shall be performed by thoroughly qualified mechanics of the appropriate trade. All equipment shall be installed and connected in accordance with the best engineering practice. Manufacturer's instructions and recommendations shall be followed and all electric connections shall be provided.
- D. Completeness: The Contractor shall furnish all labor, materials, tools, equipment and services necessary for the complete electrical system ready for continuous operation. Provide all required mounting hardware and accessories to install all equipment and devices. Make all equipment and devices fully operational.
- E. Drawings: The drawings showing the layout of the electrical system indicate approximate locations of outlets, apparatus and equipment. The runs of feeders and branches as shown, the drawings are schematic only and are not intended to show the exact routing and location of conduits and conduit terminations. The final determination as to routing, location and termination shall be governed by structural conditions, obstructions and job conditions. This shall not be construed to mean that the design of the system may be changed without the written approval of the Engineer; it merely refers to the exact run of raceways and the exact placement of outlets, etc. It shall be the Contractor's responsibility to obtain all shop drawings affecting conduit terminations to the equipment specified in this or other sections or furnished by others, and to verify conduit locations before installation. The Contractor shall consult all contract drawings and specifications which may affect the location of any outlet, equipment or conduit run, to avoid improper locations of such items and to avoid interference with other trades.
- F. Accessibility: Electrical equipment such as junction and pull boxes, panelboards, switches, controls and such other apparatus as may require maintenance or operation from time to time, is made easily accessible. Although the equipment may be shown on the drawings in certain locations, in the course of building construction, it may develop that such locations do not afford

**ELECTRICAL GENERAL PROVISIONS
26 0010 - 1**

proper accessibility, in which case the Contractor shall direct the Engineer's attention to the condition before advancing the construction.

- G. Site examinations: All bidders, prior to submitting a bid, shall thoroughly acquaint themselves with the conditions under which the work will be performed. No allowance shall be made subsequently in connection with this, for any error or negligence on the contractor's part.
- H. Unless noted as "existing" or "relocated", all construction is new and shall be furnished and installed by the contractor.

1.3 QUALITY ASSURANCE

- A. Requirements of Regulatory Agencies: Comply with electrical construction code requirements of State, City and such other local political subdivision specifications as may exceed the requirements of national codes, standards and approving bodies.
- B. All electrical equipment installed under this contract shall bear UL label. Equipment shall be installed in accordance with the requirements of UL and the manufacturer.
- C. Comply with the National Electrical Code.
- D. Certificates and Permits: Upon completion of work, and prior to final payment, furnish to the Engineer formal certification of final inspections from authorities having jurisdiction and secure required permits or certificates (if any) from such authorities. Additionally, prepare detailed diagrams and drawings which may be required by those authorities having jurisdiction. All the cost for obtaining certificates and permits will be paid by the Contractor.

1.4 REFERENCES AND DEFINITIONS

- A. Basic References: The following codes, standards, and approvals as referenced throughout the Sections of **Division 26**, shall serve as the minimum standards and quality requirements directly appropriate to the work and workmanship. References to catalogs, standards, codes, specifications and recommendations, etc., means latest edition of such publications in effect at the date of invitation to submit bid.
 - 1. American National Standards Institute (ANSI): ANSI C2; National Electrical Safety Code
 - 2. National Electric Manufacturer's Association (NEMA) Standards as apply to specified Products.
 - 3. National Fire Protection Association (NFPA): NFPA 70 (National Electrical Code), NFPA 72 (National Fire Alarm Code), NFPA 70E (Standard for Electrical Safety Requirements for Employee Workplaces), and other applicable NFPA codes
 - 4. Underwriters' Laboratories, Inc. (UL) Listings, Labels, and Approvals shall govern the quality and performance of specified Products.
 - 5. Americans with Disabilities Act (ADA)
 - 6. Institute of Electrical and Electronics Engineers, Inc (IEEE)
 - 7. National Electrical Contractor's Association (NECA)
 - 8. International Electrical Testing Association (NETA)
 - 9. Occupational Safety and Health Administration (OSHA)
- B. Definitions:

1. "Provide" - means "furnish and install"
2. "Indicated" - means "indicated in contract documents"
3. "Concealed" - means items referred to are hidden from normal sight, this includes items partly excavated or crawl spaces and in service tunnels used solely for repairs and maintenance
4. "Exposed" - means items are not "concealed"
5. "Feeder" - means "All circuit conductors between the service equipment, the source of a separately derived system, or other power supply source and the final branch-circuit overcurrent device"
6. "Feeder circuit breakers" - means circuit breakers protecting feeders.
7. NETA ATS - International Electrical Testing Association Acceptance Testing Specifications 2007 Edition
8. "Building" – A structure that stands alone or that is cut off from adjoining structures by fire walls with all openings therein protected by approved fire doors
9. "degrees C" – means "degrees Celsius"
10. "degrees F" – means "degrees Fahrenheit"

1.5 SUBMITTALS

- A. Product Data: Submit Product Data applicable to items listed under Submittals in each Section of **Division 26**; and such items as may be indicated on the Drawings.
- B. Coordination Drawings:
 1. Submit 3 sets of coordination drawings. Coordination drawing shall have reflected ceiling plans, structural plans, floor plans and other relevant drawings, drawn to scale on one drawing, on which the following items are shown and coordinated with each other, based on actual dimensions of the items, input from actual installer of the items involved, and existing conditions:
 - a. Routing of underground ducts or ductbanks.
 - b. Routing of conduit encased in concrete slab.
 - c. Routing of Electrical Feeders
 - d. Structural trusses and columns.
 - e. Motors and all other mechanical equipment.
 - f. Mechanical pipes and ducts
 - g. Electrical Distribution Equipment (switchgear, transformers, motor control centers, etc.)
- C. Shop Drawings
 1. General: The Contractor shall submit to the Engineer for approval, before fabrication, detailed shop drawings for all electrical equipment and materials.
 2. Shop drawings shall clearly indicate, using arrows and/or highlighting on all copies, which items are being submitted and that each item being submitted is in compliance with all requirements on the drawings and in these specifications. All pertinent specification and drawing requirements shall be indicated on the manufacturer's drawings. Complete model number of equipment shall be indicated.
 3. Shop drawings of related equipment shall be submitted together.
- D. "As-Built" Drawings:

ELECTRICAL GENERAL PROVISIONS
26 0010 - 3

1. Accurate project record drawings and specifications, showing in red ink on the working drawings and electrical drawings all changes from the original plans made during installation of the work. Upon completion of the work the contractor shall deliver to the Engineer one neat set of drawings with alterations and notations made in red ink.

E. Operating and Maintenance Manuals

1. General: Upon completion of the work, the Contractor shall furnish Operating and Maintenance Manuals for use by the Engineer. The manuals shall include operating and maintenance information on all systems and items of equipment. The data shall consist of catalogs, brochures, bulletins, charts, schedules and drawings describing location, operation, maintenance, lubrication, operating weight and other information necessary for the Engineer to establish an effective operating and maintenance program.
2. Shop Drawings: Copies of appropriate shop drawings shall be included in the Operating and Maintenance Manuals. The requirements for manuals is a separate contractual item and in no way supersedes the requirements for shop drawings and vice-versa.
3. Approval: Completed manuals shall be submitted to the Engineer for review and approval. Incomplete or inadequate manuals will be returned to the Contractor for correction and resubmission.
4. Provide 3 copies of each operating and maintenance manual unless a greater quantity is specified elsewhere in the specifications, in which case the higher quantity will apply.
5. Equipment keys and passwords shall be provided to the BCRP's authorized representative or representatives. A document shall be provided indicating who received the keys and what are the passwords. Document shall be neat and typewritten.
6. All factory and field test reports shall be included into the O&M Manuals.
7. Provide a separate section in the O&M Manuals for maintenance testing schedules of all equipment. A factory authorized representative of the equipment manufacturer shall certify the maintenance program. Include calendar schedule in table format to indicate all maintenance actions included during the warranty period with spaces for future testing.
8. Records of all factory and field tests by the contractor, manufacturer, or independent testing company shall be included in the O&M Manuals.
9. Wiring diagrams for all factory and field wiring shall be included in the O&M Manuals.

F. Spare Parts and Accessories List

1. A complete list of spare parts and Accessories for equipment shall be provided.

1.6 DELIVERY, STORAGE, AND HANDLING

- A. Deliver materials and equipment to the Project site in a clean condition with openings plugged or capped (or otherwise sealed by packaging) both during shipping and during temporary storage.
- B. Delivered electrical equipment crating and/or packaging shall clearly identify pick-points or lift-points. In the absence of crating or packaging, pick-points or lift-points must be identified on the equipment.
- C. When unloading materials and equipment provide special lifting harness or apparatus as may be required by manufacturers. Handle materials and equipment in accordance with manufacturer's written instructions.

ELECTRICAL GENERAL PROVISIONS

26 0010 - 4

- D. The Contractor shall determine the required equipment needed for unloading operations and have such equipment on site to perform unloading work on the date of equipment delivery.
- E. Store materials and equipment, both on and off site, in accordance with manufacturer's written instructions. Keep equipment in a dry location.
 - 1. Temporary Heating: Apply temporary heat to materials and equipment, according to manufacturer's written instructions, throughout periods when environment is not controlled for temperature and humidity within manufacturer's stipulated service conditions.

1.7 WARRANTY

- A. The Contractor shall guarantee that all work performed and all materials and equipment installed by him are free from defects. He shall repair or replace any defective equipment, materials or workmanship, free of cost to the BCRP for a period of two (2) years from date of acceptance. Where individual specification sections indicate a Special Warranty period longer than two (2) years, the longer warranty period shall apply.
- B. During this warranty period the Contractor shall:
 - 1. Correct and make good all electrical defects. Faulty equipment and materials shall be repaired or replaced as required to produce satisfactory results as directed by the engineer and without additional cost to the BCRP. Contractor shall provide service within 24 hours after the call has been made by the BCRP.

1.8 DAMAGE TO OTHER WORK

- A. Damage: Cutting or damage to existing structures, surfaces or installations shall be repaired at the expense of the Contractor. All such repairs or patching shall be done by mechanics of the appropriate trade and shall be neatly done by mechanics of the appropriate trade and shall be neatly done and in such a fashion as to leave no readily apparent joint or change in appearance, and to leave no structural or other weakness.

1.9 TEMPORARY POWER

- A. Contractor shall be entirely responsible for temporary power. All applications, fees, temporary connections, etc. shall be made by the contractor.

1.10 COORDINATION

- A. General: The Contractor shall coordinate the work performed and equipment furnished by the Electrical Contractor with work performed and equipment furnished by other trades to ensure a complete and satisfactory installation.
- B. In Maryland, contact "Miss Utility" prior to starting any site work.

1.11 INTERRUPTION OF ELECTRIC SERVICE

- A. Do not interrupt electric, telephone or cable tv service to facilities occupied by Engineer or others unless permitted under the following conditions and then only after arranging to provide temporary electric service according to requirements indicated:
 - 1. Notify Construction Manager no fewer than 10 days in advance of proposed interruption of electric service.
 - 2. Do not proceed with interruption of electric service without Construction Manager's written permission.

1.12 WIRING INDICATED IN THE MECHANICAL DRAWINGS AND SPECIFICATIONS

- A. Additional HVAC (Heating, Ventilation, and Air Conditioning) circuits/wiring are indicated in the mechanical drawings and specifications. The electrical contractor shall coordinate with the mechanical contractor to make sure that all the circuits/wiring required in order to make the HVAC system fully operational is included in the bid price. All HVAC circuits/wiring shall be provided in accordance with the NEC and the Contract Documents. Wiring shown on the mechanical drawings and specification include, but are not limited to, wiring for dampers, thermostats, heat tracing, and other HVAC controls.

1.13 CORROSIVE LOCATIONS

- A. Corrosive locations shall be defined as the following areas:
 - 1. Pool Equipment and Pump Rooms
 - 2. Chemical storages

1.14 WET LOCATIONS

- A. Wet location shall be defined as the following areas:
 - 1. Outdoor
 - 2. Pool
 - 3. Pool Storages
 - 4. Locker rooms
 - 5. Shower areas

1.15 ELECTRICAL WORK REQUIRED FOR THE ELEVATOR SYSTEM

- A. The electrical contractor shall coordinate with the elevator contractor to make sure that all circuits/wiring/raceway required in order to make the elevator system complete and fully operational are included in the bid price. All elevator circuits/wiring/raceway shall be provided in accordance with the requirements of the NEC, the elevator manufacturer, and the Contract Documents.
- B. Provide circuits, wiring, and raceway from the elevator controller and elevator machine room to the elevator shaft, elevator cab, elevator push buttons, elevator controls and other elevator system components.

- C. The electrical contractor and elevator contractor shall review the Contract Documents to determine the locations of the different elevator system components (elevator controller, machine room, shaft, cab, buttons, controls, etc.). Where the elevator system components are located remotely from each other, provide circuits, wiring, and raceway between all elevator system components, through all intermediate areas and spaces, in order to make the elevator system complete and fully operational. Field survey and verify exact locations of the elevator system components. All work shall be included in the Contractor's bid price.
1. Provide a 2-hour fire rated enclosure or chase to enclose all circuits, wiring, and raceway which are run through intermediate areas and spaces, between the elevator machine room and the elevator shaft. The 2-hour fire rated enclosure or chase shall be included in the Contractor's bid price, whether or not it is shown in the drawings.

END OF SECTION

and sumps, suction and discharge lines, and other dewatering system components necessary to convey water away from excavations.

- D. Provide adequate pumps, well points, and other equipment, appurtenances, power, drains, material, and labor necessary to do all pumping needed to keep the excavations, pits, trenches, and all spaces included in the area of the swimming pool and building dry during the casting of mats, footings, slabs, and walls, and at such other times as the progress of the work may demand.
- E. During excavation and placing of mats, footings, slabs, and walls, ground water shall be maintained a minimum of one foot below the levels of their bottoms. The dewatering system shall maintain such levels until the backfilling is completed and the removal of the dewatering equipment will not cause or endanger any construction, as determined by the Engineer.
- F. The dewatering system shall also be adequate to remove storm water from the excavations and prevent accumulation of surface water within the construction area.

3.3 BACKFILLING BELOW-GRADE AREAS

- A. Completely fill below-grade areas and void resulting from the demolition of the site improvements and pavements with compacted fill, as described below, to the grades as shown as existing grades on the drawings.
 - 1. Use satisfactory soil materials, as defined by ASTM D 2487, consisting of SM, SC, SP, GM, GC, and GP having a liquid limit less than 35 and a plasticity index less than 20; free of rock or gravel large than 4 inches in any dimension, debris, waste, frozen materials, vegetation and other deleterious matter. However, materials used as backfill behind below-grade walls or retaining walls should have classifications of Sandy SILT (ML), or more granular, in accordance with ASTM D 2487, and should have at least 30 percent by weight of soil particles retained on the No. 200 sieve.
 - 2. **ADDENDUM NO. 2:** Prior to placement of compacted structural fill, the fill subgrade should be stripped of organic layers and then proof rolled under the observation of the Engineers Testing Agency. A minimum 35 ~~20~~ ton dump truck should be used for proof rolling. Areas of subgrade that exhibit pumping or contain organic material should be removed down to firm, natural soils. Any additional loose or unsuitable soils found should be removed and replaced with compacted fill.
 - 3. **ADDENDUM NO. 2:** Place fill materials in horizontal layers not exceeding 8 inches in loose depth. Compact each layer to a density not less than 92% ~~95%~~ of the maximum dry density when tested in accordance with ASTM D-1557, Modified Proctor. In building and pavement areas, the top 12 inches of fill should be compacted to 98% ~~95%~~ of the maximum density when tested in accordance with ASTM D-1557, Modified Proctor. Fill materials should be placed at moisture contents within +2 points of the optimum moisture content. No compacted fill shall be placed unless a soils technician is present to monitor fill compaction.
- B. Testing Agency shall verify compliance of borrow material at both the in-situ location and after the material has been brought to the site.

3.4 EXCAVATION

- A. Explosives: Do not use explosives.
- B. Unclassified Excavation: Excavation is unclassified and includes excavation to required subgrade elevations regardless of the character of materials and obstructions encountered.

3.5 STABILITY OF EXCAVATIONS

- A. Comply with local codes, ordinances, and requirements of authorities having jurisdiction to maintain stable excavations.
- B. Slope sides of excavation to comply with local codes, ordinances, and requirements of authorities having jurisdiction. Shore and brace where sloping is not possible because of space

EXCAVATING, FILLING & GRADING

31 2300 - 8

1. **ADDENDUM NO. 2:** Provide minimum 4 inches of drainage fill below all slabs. Drainage fill shall be an evenly graded mixture of natural or crushed gravel or crushed stone and natural sand with 95-100 percent passing a 1 inch sieve and less than 12 percent passing a No. 200 sieve. Place in a single layer and compact to a minimum of 98-95 percent of the maximum dry density, as determined by the Modified Proctor compaction test method ASTM D 1557. Overlay fill with vapor barrier below all slabs.

3.15 SUBSURFACE DRAINAGE BACKFILL

- A. Subsurface Drain: Place a layer of filter fabric around perimeter of drainage trench or at footing, as indicated. Place a 6 inch compacted course of filtering material on filter fabric to support drainage pipe. After installing and testing, encase drainage pipe in a minimum of 6 inches of compacted filtering material and wrap in filter fabric, overlapping edges at least 6 inches.
- B. Impervious Fill: Place and compact impervious fill material for top 12" to final subgrade.

3.16 FILL

- A. Preparation: Remove vegetation, topsoil, debris, wet, and unsatisfactory soil materials, obstruction, and deleterious materials from ground surface prior to placing fills.
 1. Plow strip, or break up sloped surface steeper than 1 vertical 4 horizontal so fill material will bond with existing surface. Compact all surfaces with a minimum 10-ton smooth drum or sheepfoot roller.
- B. When subgrade or existing ground surface to receive fill has density less than required for fill, break up ground surface to depth required, pulverize, moisture-condition or aerate soil and re-compact to required density.
- C. Place fill material in layers to required elevations for each location listed below.
 1. Under grass, use satisfactory excavated or borrow soil material.
 2. Under walks, pavements, and footings use subbase or base material, or satisfactory excavated or borrow soil material.
 3. Under steps and ramps, use subbase material.
 4. Under piping and conduit and equipment, use subbase materials where required over rock bearing surface and for correction of unauthorized excavation. Shape excavation bottom to fit bottom 90 degrees of cylinder.

3.17 MOISTURE CONTROL

- A. **ADDENDUM NO. 2:** Uniformly moisten or aerate subgrade and each subsequent fill or backfill layer before compaction to within 2-3 percent of optimum moisture content.
 1. Do not place backfill or fill material on surfaces that are muddy, frozen, or contain frost or ice.
 2. Remove and replace, or scarify and air-dry satisfactory soil material that is too wet to compact to specified density.
 - a. Stockpile or spread and dry removed wet satisfactory soil material.

3.18 COMPACTION

- A. Place backfill and fill materials in layers not more than 8 inches in loose depth for material compacted by heavy compaction equipment, and not more than 4 inches in loose depth for material compacted by hand-operated tampers.
- B. Place backfill and fill materials evenly on all sides of structures to required elevations to prevent wedging action. Place backfill and fill uniformly along the full length of each structure.
- C. Control soil and fill compaction, providing minimum percentage of density specified for each area classification indicated below. Correct improperly compacted areas or lifts as directed by Engineer if soil density tests indicate inadequate compaction.
- D. Percentage of Maximum Density Requirements: Compact soil to not less than the following percentages of maximum dry density according to ASTM D-1557 (Modified Proctor):

EXCAVATING, FILLING & GRADING

31 2300 - 11

1. **ADDENDUM NO. 2** Under structures, building slabs, steps, compact the top 12 inches of fill materials below subgrade to 98 ~~95~~ percent maximum density. Each layer of backfill or fill material below the top 12 inches should be compacted to 92 ~~90~~ percent maximum dry density.
 2. **ADDENDUM NO. 2:** Under pavement, compact the top 12 inches of fill materials below subgrade to 98 ~~95~~ percent maximum density. Each layer of backfill or fill material below the top 12 inches should be compacted to 92 ~~90~~ percent maximum dry density.
 3. **ADDENDUM NO. 2:** Under walkways, compact the top 6 inches below subgrade and each layer of backfill or fill material at 92 ~~90~~ percent maximum density.
 4. Under lawn or unpaved areas, compact the top 6 inches below subgrade and each layer of backfill or fill material at 85 percent maximum density.
- E. **ADDENDUM NO. 2:** Proof roll all areas which are to receive pavements and slab-on-grade for the proposed building with vehicle having a minimum axle load of 35 ~~20~~ tons. Unsuitable materials shall be removed and replaced with new compacted fill.
- F. When existing ground surface has a density less than that specified under "Compaction" for particular area classification, break up ground surface, pulverize, moisture-condition to optimum moisture content, and compact to required depth and percentage of maximum density.

3.19 GRADING

- A. General: Uniformly grade areas to a smooth surface free from irregular surface changes. Comply with compaction requirements and grade to cross sections, lines, and elevations indicated.
1. Provide a smooth transition between existing adjacent grades and new grades.
 2. Cut out soft spots, fill low spots, and trim high spots to conform to required surface tolerances.
- B. Site Grading: Slope grades to direct water away from buildings and to prevent ponding. Finish subgrades to required elevations within the following tolerances:
1. Lawn or Unpaved Areas: Plus or minus 1 inch.
 2. Walks: Plus or minus 1 inch.
 3. Pavements: Plus or minus 1/2 inch.
- C. Grading Inside Building Lines: Finish subgrade to a tolerance of 1/2 inch when tested with a 10-foot straightedge.

3.20 SUBBASE AND BASE COURSES

- A. Under pavements and walks, place subbase course material on prepared subgrades. Place base course material over subbases to pavements.
1. **ADDENDUM NO. 2:** Compact subbase course within 2 percent of ~~at~~ optimum moisture content to required grades, lines, cross sections, and thickness to not less than 98 ~~95~~ percent of ASTM D 1557 maximum dry ~~4254~~ relative density.
 2. Shape subbase and base to required crown elevations and cross-slope grades.
 3. When thickness of compacted subbase or base course is 6 inches or less, place materials in a single layer.
 4. When thickness of compacted subbase or base course exceed 6 inches, place materials in equal layers, with no layer more than 6 inches thick or less than 3 inches thick when compacted.
- B. Pavement Shoulders: Place shoulder along edges of subbase and base course to prevent lateral movement. Construct shoulders at least 12 inches wide of acceptable soil materials and compact simultaneously with each subbase and base layer.

3.21 DRAINAGE FILL

- A. Under slabs-on-grade, place drainage fill course on prepared subgrade.
1. Compact drainage fill to required cross sections and thickness,

EXCAVATING, FILLING & GRADING

31 2300 - 12

2. When compacted thickness of drainage fill is 6 inches or less, place materials in a single layer.
3. When compacted thickness of drainage exceeds 6 inches thick place materials in equal layers, with no layer more than 6 inches thick nor less than 3 inches thick when compacted.

3.22 FIELD QUALITY CONTROL

- A. Testing Agency Service: Engage qualified independent testing agency to inspect and test each subgrade and each fill or backfill layer. Do not proceed until test results for previously completed work verify compliance with requirements that shall be reviewed and approved by the Engineer.
 1. Perform field-in-place density tests according to ASTM D 1556 (sand cone method).
 - a. Field-in-place density tests may also be performed by the nuclear method according to ASTM D 2922, provided that calibration curves are periodically checked and adjusted to correlate to tests performed using ASTM D 1556. With each density calibration check, check the calibration curves furnished with the moisture gages according to ASTM D 3017.
 - b. When field-in-place density tests are performed using nuclear methods, make calibration checks of both density and moisture gages at beginning of work, on each difference type of material encountered, and at intervals as directed by the Engineer.
 2. Footing Subgrade: Inspect bearing state at each column footing and at twenty foot intervals in wall footings, at the footing subgrade, to verify required bearing capacity.
 3. Paved and Building Slab Areas: At subgrade and at each compacted fill and backfill layer, perform at least one field in-place density test for every 2000 sq. ft. or less of paved areas or building slab, but in no case fewer than three tests.
 4. Foundation Wall Backfill: In each compacted backfill layer, perform at least one field in-place density test for each 50 feet or less of wall length, but no fewer than two tests along a wall face.
 5. Trench Backfill: In each compacted backfill layer, perform at least one field in-place density test for each 50 feet or less of trench, but no fewer than two tests.
- B. When qualified independent testing agency reports that subgrades, fills, or backfills are below specified density, scarify and moisten or aerate, or remove and replace soil to the depth required, recompact and retest until required density is obtained. Testing will be paid by the Contractor at no additional cost to the Engineer.

3.23 PROTECTION

- A. Protecting Graded Areas: Protect newly graded areas from traffic, freezing, and erosion. Keep free of trash and debris.
- B. Repair and re-establish grades to specified tolerances where completed or partially completed surfaces become eroded, rutted, settled, or lose compaction due to subsequent construction operations or weather conditions.
 1. Scarify or remove and replace material to depth directed by the Engineer; reshape and recompact at optimum moisture content to the required density.
- C. Settling: Where settling occurs during the Project correction period, remove finished surfacing, backfill with additional approved material, compact, and reconstruct surfacing.
 1. Restore appearance, quality, and condition of finished surfacing to match adjacent work, and eliminate evidence of restoration to the greatest extent possible.

3.24 DISPOSAL OF SURPLUS AND WASTE MATERIALS

- A. Contractor shall remove and dispose of offsite all excess topsoil and/or borrow remaining after final grading has been completed.
 1. Remove waste material, including unsatisfactory soil trash, debris, and legally dispose of off the Engineer's property.

END OF SECTION

EXCAVATING, FILLING & GRADING

31 2300 - 13

SECTION 321400 - UNIT PAVING

PART 1 - GENERAL

1.1 RELATED DOCUMENTS

- A. Drawings and general provisions of the Contract, including General and Supplementary Conditions and Division 01 Specification Sections, apply to this Section.

1.2 SUMMARY

- A. Section Includes:
 - 1. Concrete Pavers.

1.3 ACTION SUBMITTALS

- A. Product Data: For the following:
 - 1. Pavers.
 - 2. Bituminous setting materials.
- B. Samples for Initial Selection: For the following:
 - 3. Each type of unit paver indicated.
 - 4. Joint materials involving color selection.
- C. Samples for Verification:
 - 5. Full-size units of each type of unit paver indicated.

1.4 QUALITY ASSURANCE

- A. Source Limitations: Obtain each type of unit paver, and pedestal from single source with resources to provide materials and products of consistent quality in appearance and physical properties.
- B. Mockups: Build mockups to verify selections made under Sample submittals and to demonstrate aesthetic effects and set quality standards for materials and execution.
 - 1. Approved mockups may become part of the completed Work if undisturbed at time of Substantial Completion.
 - 2. Mockups shall be a minimum of 10' X 10' and include adjacent accent bands. Accent bands should include full width; minimum of 10 pavers.
 - 3. Pavers installed on radii shall show full range of curvature. Mockup will be reviewed for tightness of paver curve. Smooth, clean edges and elimination of gaps between pavers will be required.
 - 4. No paver shall be installed at less than 1/3 of original size.
 - 5. Provide a minimum 3 day notice to Landscape Architect for mockup approval.

- C. Pre-installation Conference: Conduct conference at Project site.

1.5 DELIVERY, STORAGE, AND HANDLING

- A. Store pavers on elevated platforms in a dry location. If units are not stored in an enclosed location, cover tops and sides of stacks with waterproof sheeting, securely tied.
- B. Store asphalt cement and other bituminous materials in tightly closed containers.

1.6 PROJECT CONDITIONS

- A. Cold-Weather Protection: Do not use frozen materials or materials mixed or coated with ice or frost. Do not build on frozen subgrade or setting beds. Retain first paragraph below if bituminous setting bed is used.
- B. Weather Limitations for Bituminous Setting Bed:
 - 1. Install bituminous setting bed only when ambient temperature is above 40 deg F and when base is dry.
 - 2. Apply asphalt adhesive only when ambient temperature is above 50 deg F and when temperature has not been below 35 deg F for 12 hours immediately before application. Do not apply when setting bed is wet or contains excess moisture.
- C. Weather Limitations for Mortar and Grout:
 - 1. Cold-Weather Requirements: Comply with cold-weather construction requirements contained in TMS 602/ACI 530.1/ASCE 6.
 - 2. Hot-Weather Requirements: Comply with hot-weather construction requirements contained in TMS 602/ACI 530.1/ASCE 6. Provide artificial shade and windbreaks and use cooled materials as required. Do not apply mortar to substrates with temperatures of 100 deg F and higher.
 - a. When ambient temperature exceeds 100 deg F or when wind velocity exceeds 8 mph and ambient temperature exceeds 90 deg F set pavers within 1 minute of spreading setting-bed mortar.

PART 2 - PRODUCTS

2.1 PAVERS

- A. Basis-of-Design Product:
 - 1. Paver A (P-1) – Hanover Prest Paver; Hanover Architectural Products 5000 Hanover Road, Hanover, PA 17331. 717-637-7145 www.hanoverpavers.com
 - a. Series: Plankstone Paver.
 - b. Face Size: 6" x 24".
 - c. Thickness: 3".
 - d. Color: 60% Charcoal, 40% Limestone Gray mix.
 - e. Set on bituminous setting bed; see details. See plans for pattern.
 - 2. Paver A (P-1.1) – Hanover Prest Paver; Hanover Architectural Products 5000 Hanover Road, Hanover, PA 17331. 717-637-7145 www.hanoverpavers.com
 - a. Series: Plankstone Paver.

ADDENDUM 2

- b. Face Size: 6" x 24".
 - c. Thickness: 3".
 - d. Color: 60% Charcoal, 40% Limestone Gray mix.
 - e. Set on bituminous setting bed; see details. Install on vehicular grade concrete section. Refer to Civil Drawings for details. See landscape plans for pattern.
3. Paver B – Vehicular (P-2) – Hanover Prest Brick; Hanover Architectural Products 5000 Hanover Road, Hanover, PA 17331. 717-637-7145 www.hanoverpavers.com
- a. Series: Prest Brick; Traditional.
 - b. Face Size: Nominal 4"X8" (3 7/8" X 7 7/8")
 - c. Thickness: 3".
 - d. Color: Charcoal; Natural.
 - e. Set on bituminous setting bed; see civil details.
 - f. Patterns: 45° Herringbone for vehicular use. See landscape plans for pattern.
4. Exterior Fitness Tile – ECOmax (P-3) – Ecore International; 715 Fountain Avenue, Lancaster, PA 17601. 877.258.0843 www.ecorecommercial.com
- a. Product: ECOmax, beveled tile.
 - b. Face Size: 24" x 24".
 - c. Thickness: 2-1/2".
 - d. Color: Silver Lake.
 - e. Set per manufacturers recommendations using Quad Blocks and full-spread adhesion; E-Grip III.
 - f. To be installed with top elevation flush to adjacent hardscape.
 - g. Follow ecore recommendations for 'Initial Cleaning' on outdoor maintenance after installation.

2.2 ACCESSORIES

- A. Cork Joint Filler: Preformed strips complying with ASTM D1752, Type II.
- B. Compressible Foam Filler: Preformed strips complying with ASTM D1056, Grade 2A1.

2.3 BITUMINOUS SETTING-BED MATERIALS

- A. Primer for Base: ASTM D2028/D2028M, cutback asphalt, grade as recommended by unit paver manufacturer.
 - B. Fine Aggregate for Setting Bed: ASTM D1073, No. 2 or No. 3.
 - C. Asphalt Cement: ASTM D3381/D3381M, Viscosity Grade AC-10 or Grade AC-20.
 - D. Neoprene-Modified Asphalt Adhesive: Paving manufacturer's standard adhesive consisting of oxidized asphalt combined with 2 percent neoprene and 10 percent long-fibered mineral fibers containing no asbestos.
 - E. Sand for Joints: Fine, sharp, washed, natural sand or crushed stone with 100 percent passing No. 16 sieve and no more than 10 percent passing No. 200 sieve.
1. Provide sand of color needed to produce required joint color.

PART 3 - EXECUTION

3.1 EXAMINATION

- A. Examine areas indicated to receive paving, with Installer present, for compliance with requirements for installation tolerances and other conditions affecting performance.
- B. Where pavers are to be installed over waterproofing, examine waterproofing installation, with waterproofing Installer present, for protection from paving operations, including areas where waterproofing system is turned up or flashed against vertical surfaces.
- C. Proceed with installation only after unsatisfactory conditions have been corrected.

3.2 PREPARATION

- A. Remove substances from substrates that could impair pedestal installation.
- B. Sweep concrete substrates to remove dirt, dust, debris, and loose particles.

3.3 INSTALLATION, GENERAL

- A. Do not use pavers or tiles with chips, cracks, voids, discolorations, or other visible defects.
- B. Mix pavers from several pallets or cubes, as they are placed, to produce uniform blend of colors and textures.
 - 1. Paver A to be installed with a consistent 60% Charcoal, 40% Limestone Gray mix throughout field.
- C. Cut pavers as manufacturer identifies to provide clean, sharp, unchipped edges. Cut units to provide pattern indicated and to fit adjoining work neatly. Use full units without cutting where possible. Do not use less than 1/3 full paver size. Hammer cutting is not acceptable.
- D. Pattern: As indicated on plans.
 - 1. Vehicular pavers at 45° Herringbone.

3.4 BITUMINOUS SETTING-BED APPLICATIONS

- A. Apply primer to concrete slab or binder course immediately before placing setting bed.
- B. Prepare for setting-bed placement by locating 3/4-inch deep control bars approximately 11 feet apart and parallel to one another, to serve as guides for striking board. Adjust bars to subgrades required for accurate setting of paving units to finished grades indicated.
- C. Place bituminous setting bed where indicated, in panels, by spreading bituminous material between control bars. Spread mix at a minimum temperature of 250 deg F. Strike setting bed smooth, firm, even, and not less than 3/4 inch thick. Add fresh bituminous material to low, porous spots after each pass of striking board. After each panel is completed, advance first control bar to next position in readiness for striking adjacent panels. Carefully fill depressions that remain after removing depth-control bars.

1. Roll setting bed with power roller to a nominal depth of 3/4 inch. Adjust thickness as necessary to allow accurate setting of unit pavers to finished grades indicated. Complete rolling before mix temperature cools to 185 deg F.
- D. Apply neoprene-modified asphalt adhesive to cold setting bed by squeegeeing or troweling to a uniform thickness of 1/16 inch. Proceed with setting of paving units only after adhesive is tacky and surface is dry to touch.
- E. Place pavers carefully by hand in straight courses, maintaining accurate alignment and uniform top surface. Protect newly laid pavers with plywood panels on which workers can stand. Advance protective panels as work progresses, but maintain protection in areas subject to continued movement of materials and equipment to avoid creating depressions or disrupting alignment of pavers. If additional leveling of paving is required, and before treating joints, roll paving with power roller after sufficient heat has built up in the surface from several days of hot weather.

3.5 REPAIRING, POINTING, AND CLEANING

- A. Remove and replace unit pavers that are loose, chipped, broken, stained, or otherwise damaged or that do not match adjoining units. Provide new units to match adjoining units and install in same manner as original units, with same joint treatment and with no evidence of replacement.

END OF SECTION 321400

CITY OF BALTIMORE
 DEPARTMENT OF PUBLIC WORKS
 DEPARTMENT OF RECREATION AND PARKS

FOR
 THE MAYOR AND CITY COUNCIL OF BALTIMORE
 BERNARD C. "JACK" YOUNG, MAYOR



CONTRACT NO. RP19808
 GWWO PROJECT NO. 18010

MIDDLE BRANCH
 FITNESS & WELLNESS
 CENTER AT CHERRY
 HILL

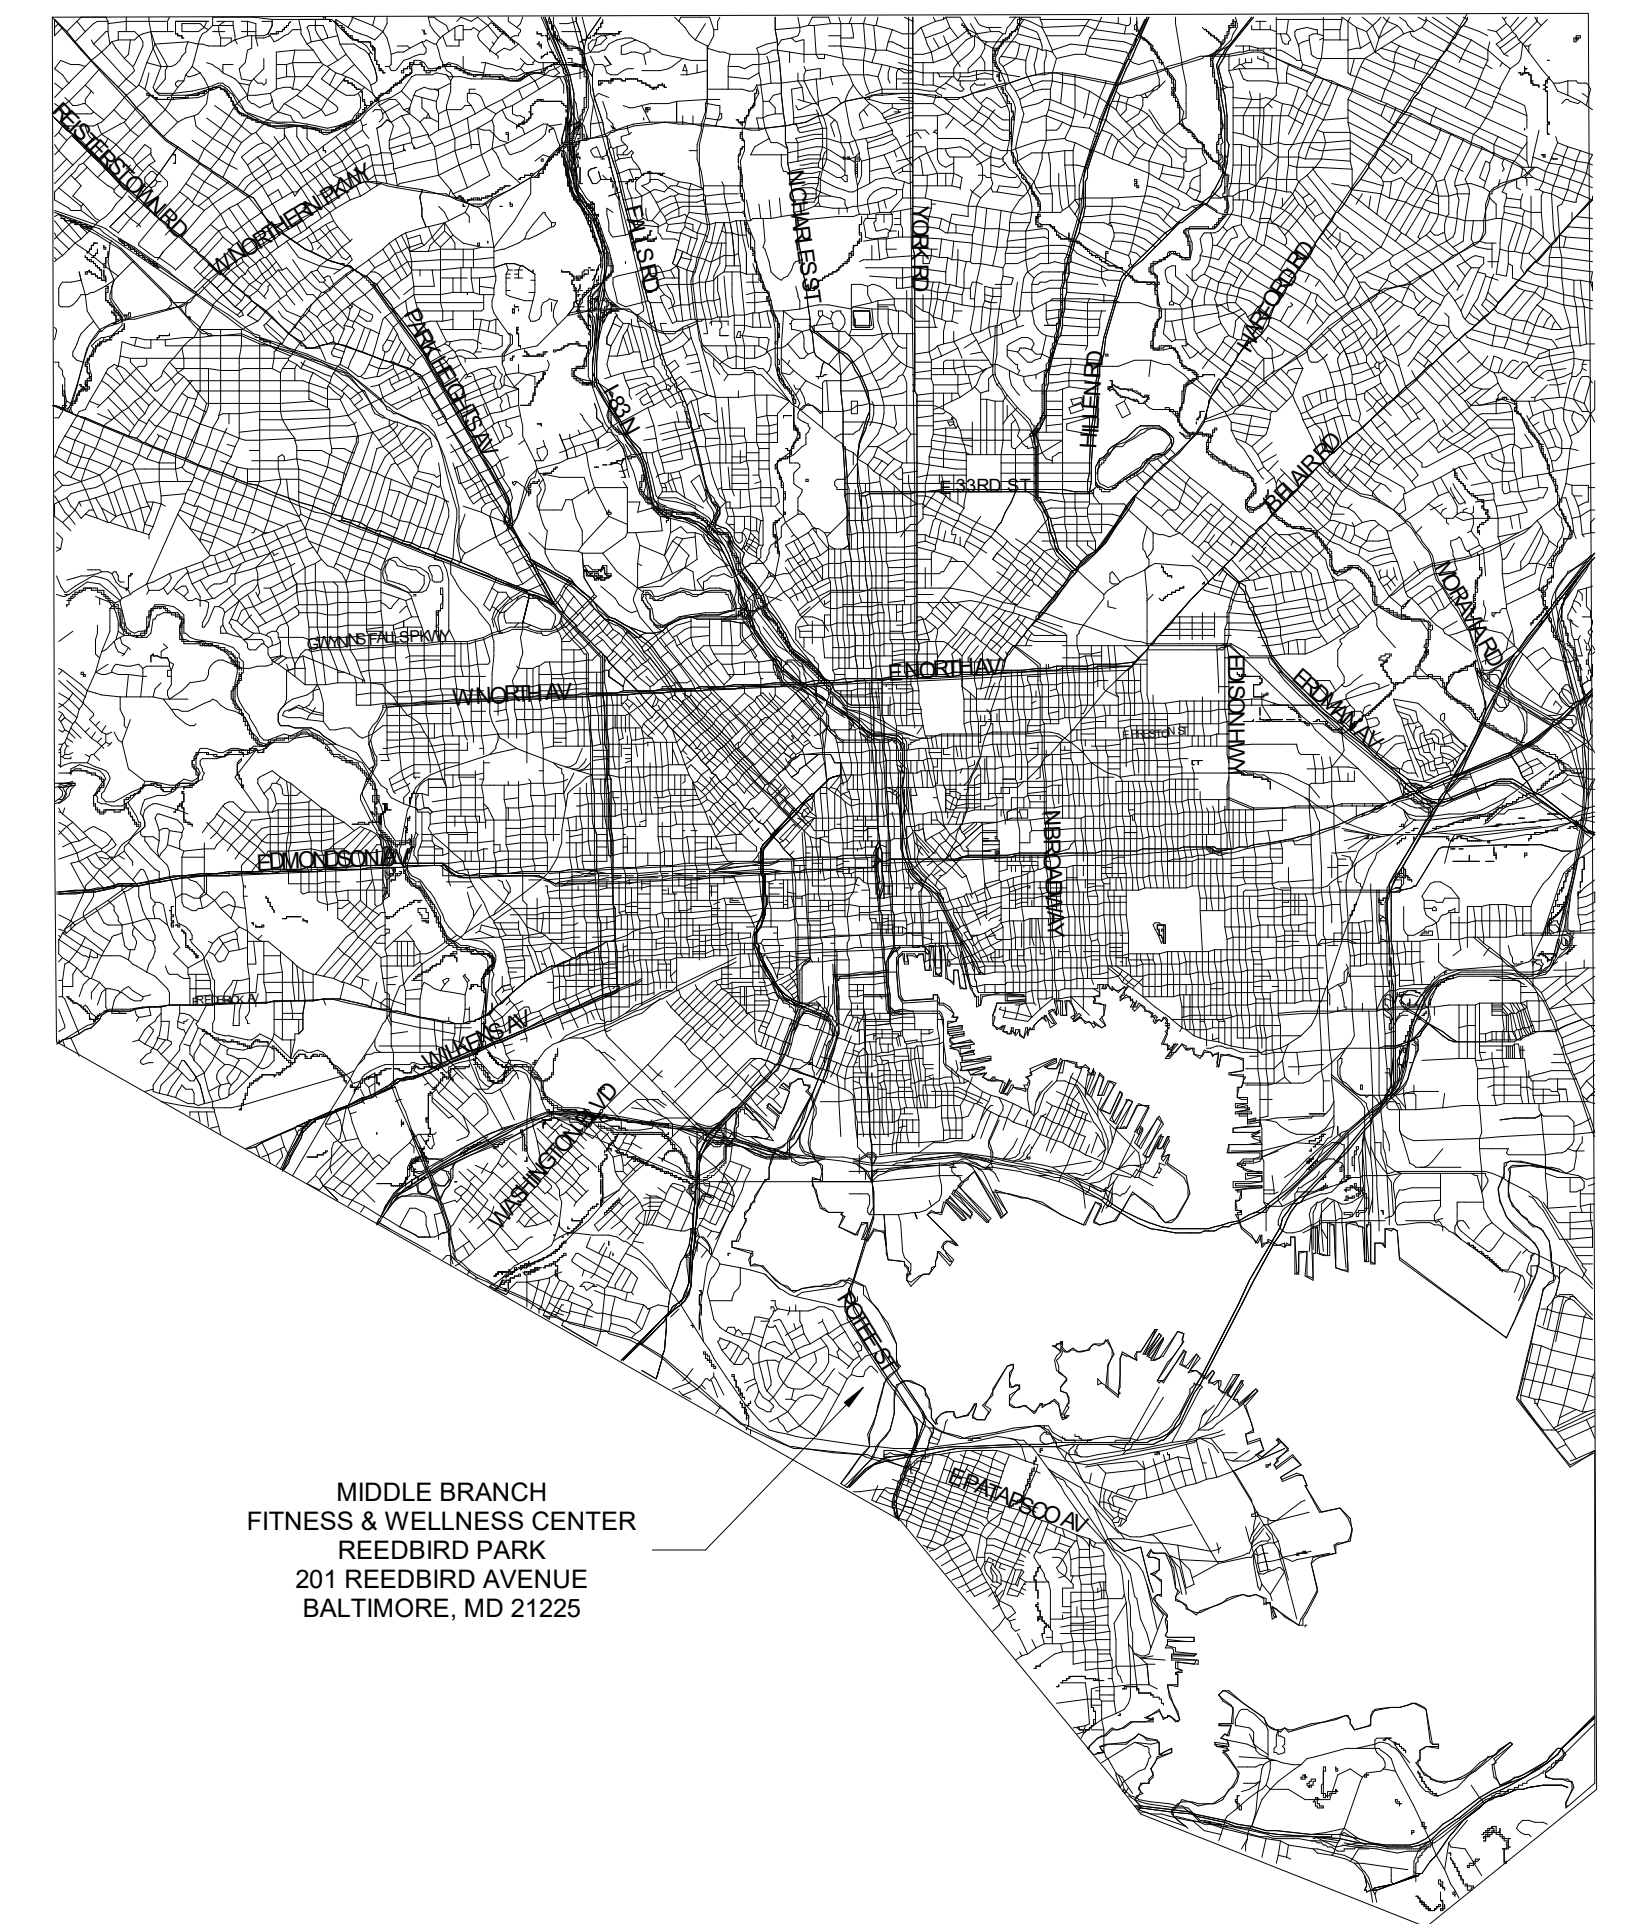


TABLE OF CONTENTS

COVER SHEETS			
CS.1 COVER SHEET	A6.1	PLAN DETAILS	
CS.2 ABBREVIATIONS, KEYNOTES, & SYMBOLS	A6.2	PLAN DETAILS	
CS.3 CODE STUDY	A6.3	PLAN DETAILS	
CS.4 EGRESS PLANS	A6.4	SECTION DETAILS	
	A6.5	SECTION DETAILS	
CIVIL	A6.6	SECTION DETAILS	
C1.00 PLOT PLAN	A6.7	SECTION DETAILS	
	A6.8	SECTION DETAILS	
C2.00 EXISTING CONDITIONS PLAN			
C3.00 DEMOLITION PLAN	A7.0	ACCESSORY SCHEDULE	
	A7.1	FURNISHING PLANS	
C4.00 OVERALL SITE & GRADING PLAN	A7.2	STRIPING PLAN - GYMNASIUM	
C4.01 SITE EARTHWORK PLAN	A7.3	ENLARGED PLANS & INTERIOR ELEVATIONS	
C4.02 OVERALL STAGE 1 SITE & GRADING PLAN	A7.4	ENLARGED PLANS & INTERIOR ELEVATIONS	
C4.03 STAGE 1 SITE & GRADING PLAN	A7.5	INTERIOR ELEVATIONS	
C4.04 STAGE 1 SITE & GRADING PLAN	A7.6	INTERIOR ELEVATIONS	
C4.05 STAGE 2 GRADING PLAN	A7.7	INTERIOR ELEVATIONS	
C4.06 STAGE 2 SITE PLAN	A7.8	INTERIOR ELEVATIONS	
	A7.9	INTERIOR ELEVATIONS	
C5.00 SITE DETAILS	A7.10	CASEWORK DETAILS	
C5.01 SITE DETAILS	A7.11	CASEWORK DETAILS	
C6.00 PAVING, SIGNAGE, & STRIPING PLAN			
C7.00 GEOMETRY PLAN			
C8.00 UTILITY PLAN	A8.1	DOOR SCHEDULE AND DETAILS	
C8.01 UTILITY PLAN	A8.2	WINDOW SCHEDULE - EXTERIOR	
C8.02 STORM DRAIN DRAINAGE AREA MAP	A8.3	WINDOW SCHEDULE - EXTERIOR	
C8.03 STORM DRAIN PROFILES	A8.3A	WINDOW SCHEDULE - EXTERIOR	
C8.04 STORM DRAIN PROFILES	A8.4	WINDOW SCHEDULE - EXTERIOR	
C8.05 UTILITY PROFILES	A8.5	WINDOW SCHEDULE - INTERIOR	
	A8.6	TYPICAL WINDOW DETAILS	
	A8.7	ADD ALTERNATE - HYDRAULIC DOOR	
C9.00 STAGE 1 - EROSION & SEDIMENT CONTROL PLAN	A9.1	FINISH PLAN - FIRST FLOOR	
C9.01 STAGE 2 - EROSION & SEDIMENT CONTROL PLAN	A9.2	FINISH PLAN - MEZZANINE	
C9.02 EROSION & SEDIMENT CONTROL PLAN EX DA			
C9.03 EROSION & SEDIMENT CONTROL PLAN PROP DA			
C9.04 EROSION & SEDIMENT CONTROL BASIN #1			
C9.05 EROSION & SEDIMENT CONTROL BASIN DETAILS			
C9.06 ESC CONTROL DETAILS			
C9.08 EROSION & SEDIMENT CONTROL DETAILS	S1.0	GENERAL NOTES, ABBREVIATIONS, AND SYMBOLS	
C9.09 EROSION & SEDIMENT CONTROL DETAILS	S1.1	FIRST FLOOR AND FOUNDATION PLAN	
C9.10 EROSION & SEDIMENT CONTROL NOTES	S1.2	MEZZANINE FLOOR & LOW ROOF FRAMING PLANS	
C9.11 STABILIZATION NOTES	S1.3	TRACK ROOF FRAMING PLAN	
	S1.4	ROOF FRAMING PLAN	
	S1.5	ADD ALTERNATE - HYDRAULIC DOOR	
C10.00 NATURAL RESOURCES PLAN			
C11.00 EXISTING IMPERVIOUS AREA MAP	S4.1	WALL SECTIONS	
C11.01 PROPOSED IMPERVIOUS AREA MAP	S4.2	WALL SECTIONS	
C11.02 ENVIRONMENTAL SITE DESIGN PLAN	S4.3	WALL SECTIONS	
C11.03 EX. CONDITION QUANTITY DA MAP	S4.4	WALL SECTIONS	
C11.04 PROP. CONDITION QUANTITY DA MAP	S4.5	WALL SECTIONS	
C11.05 SAND FILTER #3	S4.6	WALL SECTIONS	
C11.06 SAND FILTER #4	S5.1	TYPICAL DETAILS	
C11.07 DRY SWALE FACILITY	S5.2	TYPICAL DETAILS	
C11.08 STORMWATER MANAGEMENT DETAILS	S5.3	TYPICAL DETAILS	
C11.09 STORMWATER MANAGEMENT NOTES & DETAIL	S5.4	TYPICAL DETAILS	
C12.00 STORMWATER MANAGEMENT DETAILS	S6.1	SCHEDULES	
C13.00 WATER METER PLAN			
LANDSCAPE			
L1.00 OVERALL HARDSCAPE PLAN	M0.1	MECHANICAL ABBREVIATIONS, LEGENDS & GENERAL NOTES	
L1.01 HARDSCAPE ENLARGEMENT - COMMUNITY PLAZA	M0.2	VENTILATION CALCULATION	
L1.02 HARDSCAPE ENLARGEMENTS - PARK PLAZA AND FIELD DROP OFF	M1.1	FIRST FLOOR PLAN - HVAC	
L2.00 OVERALL PLANTING PLAN	M1.2	MEZZANINE FLOOR PLAN - HVAC	
L2.01 PLANTING ENLARGEMENT - COMMUNITY PLAZA	M1.3	FIRST FLOOR PLAN - HVAC PIPING	
L3.00 HARDSCAPE DETAILS	M1.4	MEZZANINE FLOOR PLAN - HVAC PIPING	
L4.00 PLANTING DETAILS	M1.5	ROOF PLAN - HVAC	
ARCHITECTURAL			
AS.1 ARCHITECTURAL SITE PLAN	M3.1	SECTIONS	
AC.1 CONSTRUCTION TYPES, TYPICAL DETAILS, AND DIAGRAMS	M4.1	PART PLANS - HVAC	
AC.2 CONSTRUCTION TYPES, TYPICAL DETAILS, AND DIAGRAMS	M5.1	DETAILS	
AC.3 CONSTRUCTION TYPES, TYPICAL DETAILS, AND DIAGRAMS	M5.2	DETAILS	
	M5.3	DETAILS	
	M5.4	DETAILS	
	M5.5	RISER DIAGRAMS HVAC	
A1.1 FIRST FLOOR PLAN	M6.1	MECHANICAL SCHEDULES	
A1.1A FIRST FLOOR DIMENSION PLAN	M6.2	MECHANICAL SCHEDULES	
A1.2 MEZZANINE FLOOR PLAN	M7.1	SEQUENCE OF OPERATION	
A1.2A MEZZANINE DIMENSION PLAN	M7.2	SEQUENCE OF OPERATION	
A1.3 ROOF PLAN	M7.3	SEQUENCE OF OPERATION	
	M7.4	SEQUENCE OF OPERATION	
	M7.5	SEQUENCE OF OPERATION	
A2.1 REFLECTED CEILING PLAN - FIRST FLOOR			
A2.2 REFLECTED CEILING PLAN - MEZZANINE			
A2.3 CEILING DETAILS			
A3.1 EXTERIOR ELEVATIONS	P0.1	PLUMBING ABBREVIATIONS, LEGENDS & GENERAL NOTES	
A3.2 EXTERIOR ELEVATIONS	P1.1	UNDER SLAB PLAN - SANITARY	
A3.3 EXTERIOR PATTERNS	P1.2	FIRST FLOOR PLAN - SANITARY AND VENT	
	P1.3	MEZZANINE FLOOR PLAN - SANITARY AND VENT	
A4.1 BUILDING SECTIONS	P1.4	FIRST FLOOR PLAN - DOMESTIC WATER	
A4.2 BUILDING SECTIONS	P1.5	MEZZANINE FLOOR PLAN - DOMESTIC WATER	
A4.3 BUILDING SECTIONS	P1.6	ROOF PLAN - PLUMBING	
A4.4 WALL SECTIONS			
A4.5 WALL SECTIONS	P4.1	PART PLAN - PLUMBING	
A4.6 WALL SECTIONS			
A5.1 STAIR PLANS & SECTIONS	P5.1	DETAILS	
A5.2 STAIR AND ELEVATOR PLANS & SECTIONS	P5.2	SCHEDULES	
A5.3 STAIR & RAILING DETAILS	P6.1	RISERS	
A5.4 RAILING DETAILS	P6.2	RISERS	
A5.5 TRACK RAILING ELEVATIONS			

ELECTRICAL			
E001	GENERAL NOTES, SYMBOL LISTS, AND ABBREVIATIONS	SP2.1	DEEP WELL PLAN
		SP2.2	DEEP WELL SECTION MARKER PLAN
		SP2.3	DEEP WELL SECTIONS
		SP2.4	DEEP WELL DETAILS
E100	ELECTRICAL SITE PLAN	SP2.5	DEEP WELL FEATURE SCHEDULE
E101	FIRST FLOOR PLAN - POWER	SP2.6	DEEP WELL FEATURE DETAILS
E101A	FIRST FLOOR PLAN - HVAC POWER	SP2.7	DEEP WELL PLUMBING PLAN
E102	SECOND FLOOR PLAN - POWER	SP2.8	EQUIPMENT ROOM DEEP WELL PLUMBING PLAN
E103	ROOF PLAN - POWER	SP2.9	EQUIPMENT ROOM DEEP WELL PLUMBING SECTIONS
		SP2.10	EQUIPMENT ROOM DEEP WELL PLUMBING SECTIONS
E200	ELECTRICAL SITE PLAN - LIGHTING	SP2.11	DEEP WELL PLUMBING DETAILS
E201	FIRST FLOOR PLAN - LIGHTING		
E202	SECOND FLOOR PLAN - LIGHTING		
E301	FIRST FLOOR PLAN - FIRE ALARM	SP3.0	LAP POOL LOCATION PLAN
E302	SECOND FLOOR PLAN - FIRE ALARM	SP3.1	LAP POOL DIMENSIONAL PLAN
		SP3.2	LAP POOL SECTION MARKER PLAN
		SP3.3	LAP POOL FOUNDATION PLAN
E401	FIRST AND SECOND FLOOR PLAN - SECURITY SYSTEM PLAN	SP3.4	LAP POOL SECTION VIEWS
		SP3.5	LAP POOL SECTION VIEWS
E501	POWER ONE-LINE DIAGRAM AND COMMUNICATION RISER DIAGRAM	SP3.6	LAP POOL DETAIL VIEWS
E502	DETAILS	SP3.7	LAP POOL DETAIL VIEWS
E503	FIRE ALARM RISER DIAGRAM AND DETAILS	SP3.8	LAP POOL FEATURE SCHEDULE
		SP3.9	LAP POOL FEATURE DETAILS
E601	LIGHTING FIXTURE SCHEDULE AND LIGHTING CONTROL DETAIL	SP3.10	LAP POOL PLUMBING PLAN
E602	PANEL SCHEDULES	SP3.11	LAP POOL EQUIPMENT ROOM PLUMBING PLAN
E603	PANEL SCHEDULES	SP3.12	EQUIPMENT ROOM WADING POOL PLUMBING SECTIONS
E604	PANEL SCHEDULES	SP3.13	EQUIPMENT ROOM LAP POOL PLUMBING SECTIONS
		SP3.14	LAP POOL PLUMBING DETAILS
FIRE PROTECTION			
FP0.1	FIRE PROTECTION LEGEND & GENERAL NOTES	SP4.0	WADING POOL LOCATION PLAN
		SP4.1	WADING POOL PLAN
FP1.1	FIRST FLOOR PLAN - FIRE PROTECTION	SP4.2	WADING POOL SECTION PLAN
FP1.2	MEZZANINE FLOOR PLAN - FIRE PROTECTION	SP4.3	WADING POOL FOOTING PLAN
		SP4.4	WADING POOL SECTION VIEWS
FP5.1	FIRE PROTECTION DETAILS AND RISER	SP4.5	WADING POOL DETAIL VIEWS
		SP4.6	WADING POOL FEATURE SCHEDULE
AQUATICS		SP4.7	WADING POOL FEATURE DETAILS
SP1.0	POOLS PLAN	SP4.8	WADING POOL PLUMBING PLAN
SP1.1	POOLS LOCATION PLAN	SP4.9	WADING POOL EQUIPMENT ROOM PLUMBING PLAN
		SP4.10	EQUIPMENT ROOM WADING POOL PLUMBING SECTIONS
SP2.0	DEEP WELL LOCATION PLAN	SP4.11	EQUIPMENT ROOM LAP POOL PLUMBING SECTIONS
		SP4.12	WADING POOL PLUMBING DETAILS



GWWO INC.
 ARCHITECT
 800 WYMAN PARK DR., STE. 300
 BALTIMORE, MD 21211
 (410) 332-1009
 FAX (410) 332-0038

CHIEF OF CAPITAL DEVELOPMENT	DIRECTOR OF RECREATION AND PARKS	DATE: 12/13/2019
		231 SHEETS IN SET
		SHEET 1 OF 231
		DRAWING NO. CS.1r2

RP 19808 - MIDDLE BRANCH FITNESS & WELLNESS CENTER

DEMOLITION NOTES

- THE CONTRACTOR SHALL NOTIFY "MISS UTILITY" 1-800-251-TITI AT LEAST FIVE (5) WORKING DAYS PRIOR TO STARTING ANY WORK.
- TOPOGRAPHIC INFORMATION SHOWN HEREON IS BASED ON AVAILABLE AS-BUILT PLANS PROVIDED BY BALTIMORE CITY RECREATION & PARKS, BALTIMORE CITY DPW, BALTIMORE CITY GIS, AND A SUPPLEMENTAL SURVEY CONDUCTED BY NAVARRO & WRIGHT CONSULTING ENGINEERS, LLC, DURING JUNE 2018.
- EXISTING UTILITY INFORMATION SHOWN HEREON IS BASED ON THE BEST AVAILABLE INFORMATION WHICH INCLUDES A FIELD SURVEY CONDUCTED BY AI DATA LLC, DURING JUNE 2018. AS-BUILT WATER WASTEWATER AND STORM DRAIN PLANS FROM BALTIMORE COUNTY DEPARTMENT OF PUBLIC WORKS AND BALTIMORE GAS AND ELECTRIC COMPANY PLANS.
- OBSTRUCTIONS SHOWN ON THIS DRAWING ARE FOR THE CONVENIENCE OF THE CONTRACTOR ONLY. MK CONSULTING ENGINEERS, LLC, DOES NOT WARRANT OR GUARANTEE THE CORRECTNESS OR THE COMPLETENESS OF THE INFORMATION GIVEN. THE CONTRACTOR MUST VERIFY ALL SUCH INFORMATION TO HIS OWN SATISFACTION. IN THE EVENT THAT INFORMATION IS IN CONFLICT WITH INFORMATION OUTLINED, THE CONTRACTOR SHALL IMMEDIATELY BRING IT TO THE ATTENTION OF THE ARCHITECT PRIOR TO STARTING ANY WORK.
- CONTRACTOR SHALL VERIFY LOCATION AND ELEVATION OF EXISTING UTILITIES SHOWN HEREON BEFORE STARTING ANY WORK ON THESE PLANS. CONTRACTOR AGREES TO BE FULLY RESPONSIBLE FOR THE COST OF ANY AND ALL DAMAGES WHICH OCCUR AS A RESULT OF FAILURE TO EXACTLY LOCATE AND PRESERVE ANY AND ALL EXISTING UTILITIES INDICATED TO REMAIN.
- ALL WORK SHALL BE ACCOMPLISHED IN ACCORDANCE WITH THE CONTRACT DOCUMENTS.
- CONTRACTOR SHALL ADJUST ALL FRAMES, GRATES AND COVERS OF ALL EXISTING UTILITIES WITHIN THE LIMITS OF THE CONTRACT TO THE PROPOSED GRADES AS REQUIRED.
- THE CONTRACTOR SHALL MAINTAIN POSITIVE DRAINAGE AWAY FROM STRUCTURES AT ALL TIMES.
- CONTRACTOR SHALL COORDINATE ALL DISCONNECTIONS AND REMOVAL OF EXISTING GAS, ELECTRIC AND TELEPHONE SERVICES AND EQUIPMENT WITH BALTIMORE GAS & ELECTRIC, VERIZON AND BALTIMORE CITY.
- CONTRACTOR SHALL REMOVE AND DISPOSE OF ALL EXISTING MECHANICAL AND ELECTRICAL EQUIPMENT AND ACCESSORIES NOT REMOVED BY LOCAL UTILITY COMPANIES, OR SPECIFIED TO BE REMOVED BY OWNER.
- ALL EXCAVATION SHALL BE BACKFILLED IN ACCORDANCE WITH THE PROJECT SPECIFICATIONS. IN THE EVENT THAT A PORTION OF A UTILITY IS TO BE REMOVED THE CONTRACTOR SHALL TERMINATE AND CAP TO THE LIMITS INDICATED IN ACCORDANCE WITH ALL STATE AND LOCAL REQUIREMENTS.
- IT SHALL BE DISTINGUISHINGLY UNDERSTOOD THAT FAILURE TO MENTION SPECIFICALLY ANY WORK WHICH WOULD NORMALLY BE REQUIRED TO COMPLETE THIS PROJECT DOES NOT RELIEVE THE CONTRACTOR OF HIS RESPONSIBILITY TO COMPLETE SUCH WORK.
- IT SHALL BE THE RESPONSIBILITY OF THE CONTRACTOR TO NOTIFY THE ENGINEER OF ANY DEVIATION FROM THIS PLAN PRIOR TO ANY CHANGE BEING MADE. ANY DEVIATION FROM THIS PLAN WITHOUT WRITTEN AUTHORIZATION FROM THE ENGINEER WILL BE THE RESPONSIBILITY OF THE CONTRACTOR.
- SHOULD THE CONTRACTOR DISCOVER DISCREPANCIES BETWEEN THE PLANS AND FIELD CONDITIONS, THE ENGINEER IS TO BE NOTIFIED IMMEDIATELY TO RESOLVE THE SITUATION. SHOULD THE CONTRACTOR MAKE FIELD CONDITIONS OR ADJUSTMENTS WITHOUT NOTIFYING THE ENGINEER, THEN THE CONTRACTOR ASSUMES ALL RESPONSIBILITY FOR THOSE CHANGES.
- SOIL BORINGS WERE COMPLETED BY RUMMEL, KLEPPER & KAHL, LLP, DECEMBER 2019.
- CONTRACTOR SHALL SECURE THE CONSTRUCTION AREA AT THE END OF EACH WORKING DAY AND WILL INSPECT THE SECURITY FENCING TO INSURE ITS INTEGRITY.
- ALL CONSTRUCTION DEBRIS WILL BE REMOVED FROM THE SITE AND TAKEN TO AN APPROVED, PERMITTED DISPOSAL FACILITY. NO RUBBLE IS TO BE LEFT ON SITE.
- CONTRACTOR SHALL INSPECT AND TAKE PICTURES OF ADJACENT BUILDING WALLS PRIOR TO THE COMMENCEMENT OF ANY DEMOLITION ON THE SITE. EXISTING WALL CRACKS (IF ANY) WILL BE NOTED.
- CONTRACTOR SHALL CONTINUALLY MONITOR THE WALLS OF THE ADJACENT BUILDINGS FOR ANY SIGNS OF STRUCTURAL DISTRESS. IF ANY DISTRESS IS NOTED, CONTRACTOR SHALL STOP WORK IMMEDIATELY AND NOTIFY OWNER.
- CONTRACTOR SHALL NOT EXPOSE, UNDERMINE OR IMPACT THE ZONE OF INFLUENCE FOR FOOTINGS AND FOUNDATIONS OF ADJACENT BUILDINGS. CONTRACTOR WILL BE RESPONSIBLE FOR THE COST TO REPAIR ADJACENT BUILDINGS THAT ARE DAMAGED DUE TO HIS OPERATION.
- CONTRACTOR SHALL PROVIDE THE NECESSARY MEANS TO CONTROL DUST AND MAINTAIN BALTIMORE CITY AIR QUALITY STANDARDS DURING THE DEMOLITION AND REMOVAL OF SITE DEBRIS AND THE NEW CONSTRUCTION.
- CONTRACTOR SHALL SANGUT EXISTING PAVING TO MINIMIZE DAMAGE TO EXISTING PAVING REMAINING.
- CONTRACTOR SHALL REMOVE EXISTING CURBS & CONCRETE WALKS TO THE NEAREST JOINT. NO PATCHING WILL BE PERMITTED.
- THE DEMOLITION INFORMATION SHOWN ON THIS DRAWING IS FOR THE CONVENIENCE OF THE CONTRACTOR ONLY. IT IS THE CONTRACTOR'S RESPONSIBILITY TO DETERMINE THE EXACT LIMITS OF DEMOLITION AND REMOVAL OF AFFECTED SITE ITEMS.
- CONTRACTOR SHALL PROVIDE 2' HIGH TEMPORARY CONSTRUCTION FENCE AROUND THE LIMITS OF DISTURBANCE AS REQUIRED. REFER TO THE EROSION AND SEDIMENT CONTROL PLANS FOR LOCATIONS OF LOD DURING PHASES.
- THE CONTRACTOR SHALL PROVIDE A PRIVATE UTILITY LOCATOR TO LOCATE ALL EXISTING UNDERGROUND UTILITIES PRIOR TO BEGINNING ANY CONSTRUCTION.
- THE CONTRACTOR SHALL REMOVE ALL UNDERGROUND UTILITY PIPING, NOTHING SHALL BE ABANDONED IN PLACE.

LEGEND


- 20 --- EX. INDEX CONTOUR
- 21 --- EX. INTERMEDIATE CONTOUR
- --- PROPERTY LINE
- CAB --- CRITICAL AREA 100' BUFFER
- EX. 12" --- EX. CURB AND GUTTER
- EX. 12" --- EX. STORM DRAIN
- EX. 8" SAN --- EX. SANITARY SEWER
- EX. 6" W --- EX. WATER
- EX. GAS --- EX. GAS
- EX. UNDERGROUND ELEC. --- EX. UNDERGROUND ELECTRIC
- EX. OVERHEAD LINE --- EX. OVERHEAD ELECTRIC
- --- EX. FENCE
- --- EX. MANHOLE
- --- EX. INLET
- --- EX. TREE
- --- EX. WOODS LINE
- ⊗ --- EX. TREE TO BE REMOVED
- --- EX. UTILITIES, FENCE CURB AND GUTTER TO BE REMOVED
- --- APPROXIMATE LIMIT OF PAVING TO BE REMOVED
- --- APPROXIMATE LIMITS OF PAVING TO REMAIN



DEMOLITION PLAN
SCALE: 1"=60'

DEMOLITION KEY

- | | | |
|--|--|---|
| 1 EX. ASPHALT DRIVEWAY TO BE REMOVED | 7 EX. FENCE TO BE REMOVED | 13 EX. OVERHEAD WIRES TO RELOCATED |
| 2 EX. SIDEWALKS TO BE REMOVED | 8 EX. LIGHT & BASE TO BE REMOVED | 14 EX. WHEEL STOPPERS TO BE REMOVED |
| 3 EX. TENNIS COURT CONCRETE/FOUNDATION TO BE REMOVED | 9 EX. TIMBER WALL TO BE REMOVED | 15 EX. CONCRETE SLAB TO BE REMOVED |
| 4 EX. BASKETBALL COURT CONCRETE/FOUNDATION TO BE REMOVED | 10 EX. BOLLARD TO BE REMOVED | 16 EX. TREES TO BE REMOVED TO LIMIT OF DISTURBANCE |
| 5 EX. SPLASH POOL CONCRETE/FOUNDATION TO BE REMOVED | 11 EX. BENCHES & TABLES TO BE REMOVED | 17 EX. PLAYGROUND EQUIPMENT & FOUNDATIONS TO BE REMOVED |
| 6 EX. STORM DRAIN INLET/MANHOLE TO BE REMOVED | 12 EX. PAVILION FOUNDATION TO BE REMOVED | 18 EX. PAVERS TO BE REMOVED |

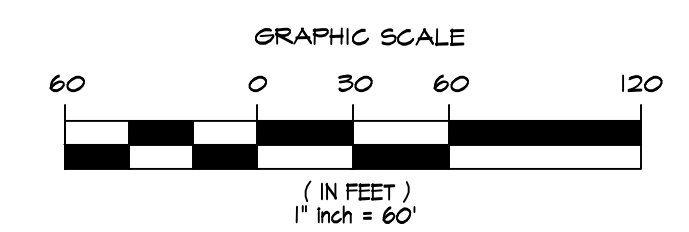

KEY PLAN

KEYNOTES LISTED ON THIS SHEET ARE FOR CONVENIENCE ONLY. REFER TO SHEET CS.3 FOR COMPLETE LIST

ISSUED FOR BID

mk
Consulting Engineers, LLC
Whitell Hill
3300 Clippert Mill Road, Suite 201
Baltimore, MD 21211
667-308-6183

G|W|O
GWVO INC.
800 WYMAN PARK DRIVE, SUITE 300
BALTIMORE, MARYLAND 21211, 410-332-0209

CERTIFY THAT THESE DOCUMENTS WERE PREPARED OR APPROVED BY ME, AND THAT I AM A DAILY LICENSED ENGINEER UNDER THE LAWS OF THE STATE OF MARYLAND. LICENSE NUMBER: 25058, EXPIRATION DATE: 11/17/20

Revisions	No.	Date	Description
	2	1/28/20	Addendum #2


MIDDLE BRANCH FITNESS & WELLNESS CENTER AT CHERRY HILL
BALTIMORE CITY RECREATION & PARKS

Jcb No.	18010	Author	SG
Scale	1"=60'	Checker	AP
Date	1/28/2019	Approver	SM
Drawing Title	DEMOLITION PLAN		
Drawing Number	C3.00r2		

Sheet **C3.00r2** of

KEY PLAN

KEYNOTES LISTED ON THIS SHEET ARE FOR CONVENIENCE ONLY. REFER TO SHEET CS.3 FOR COMPLETE LIST

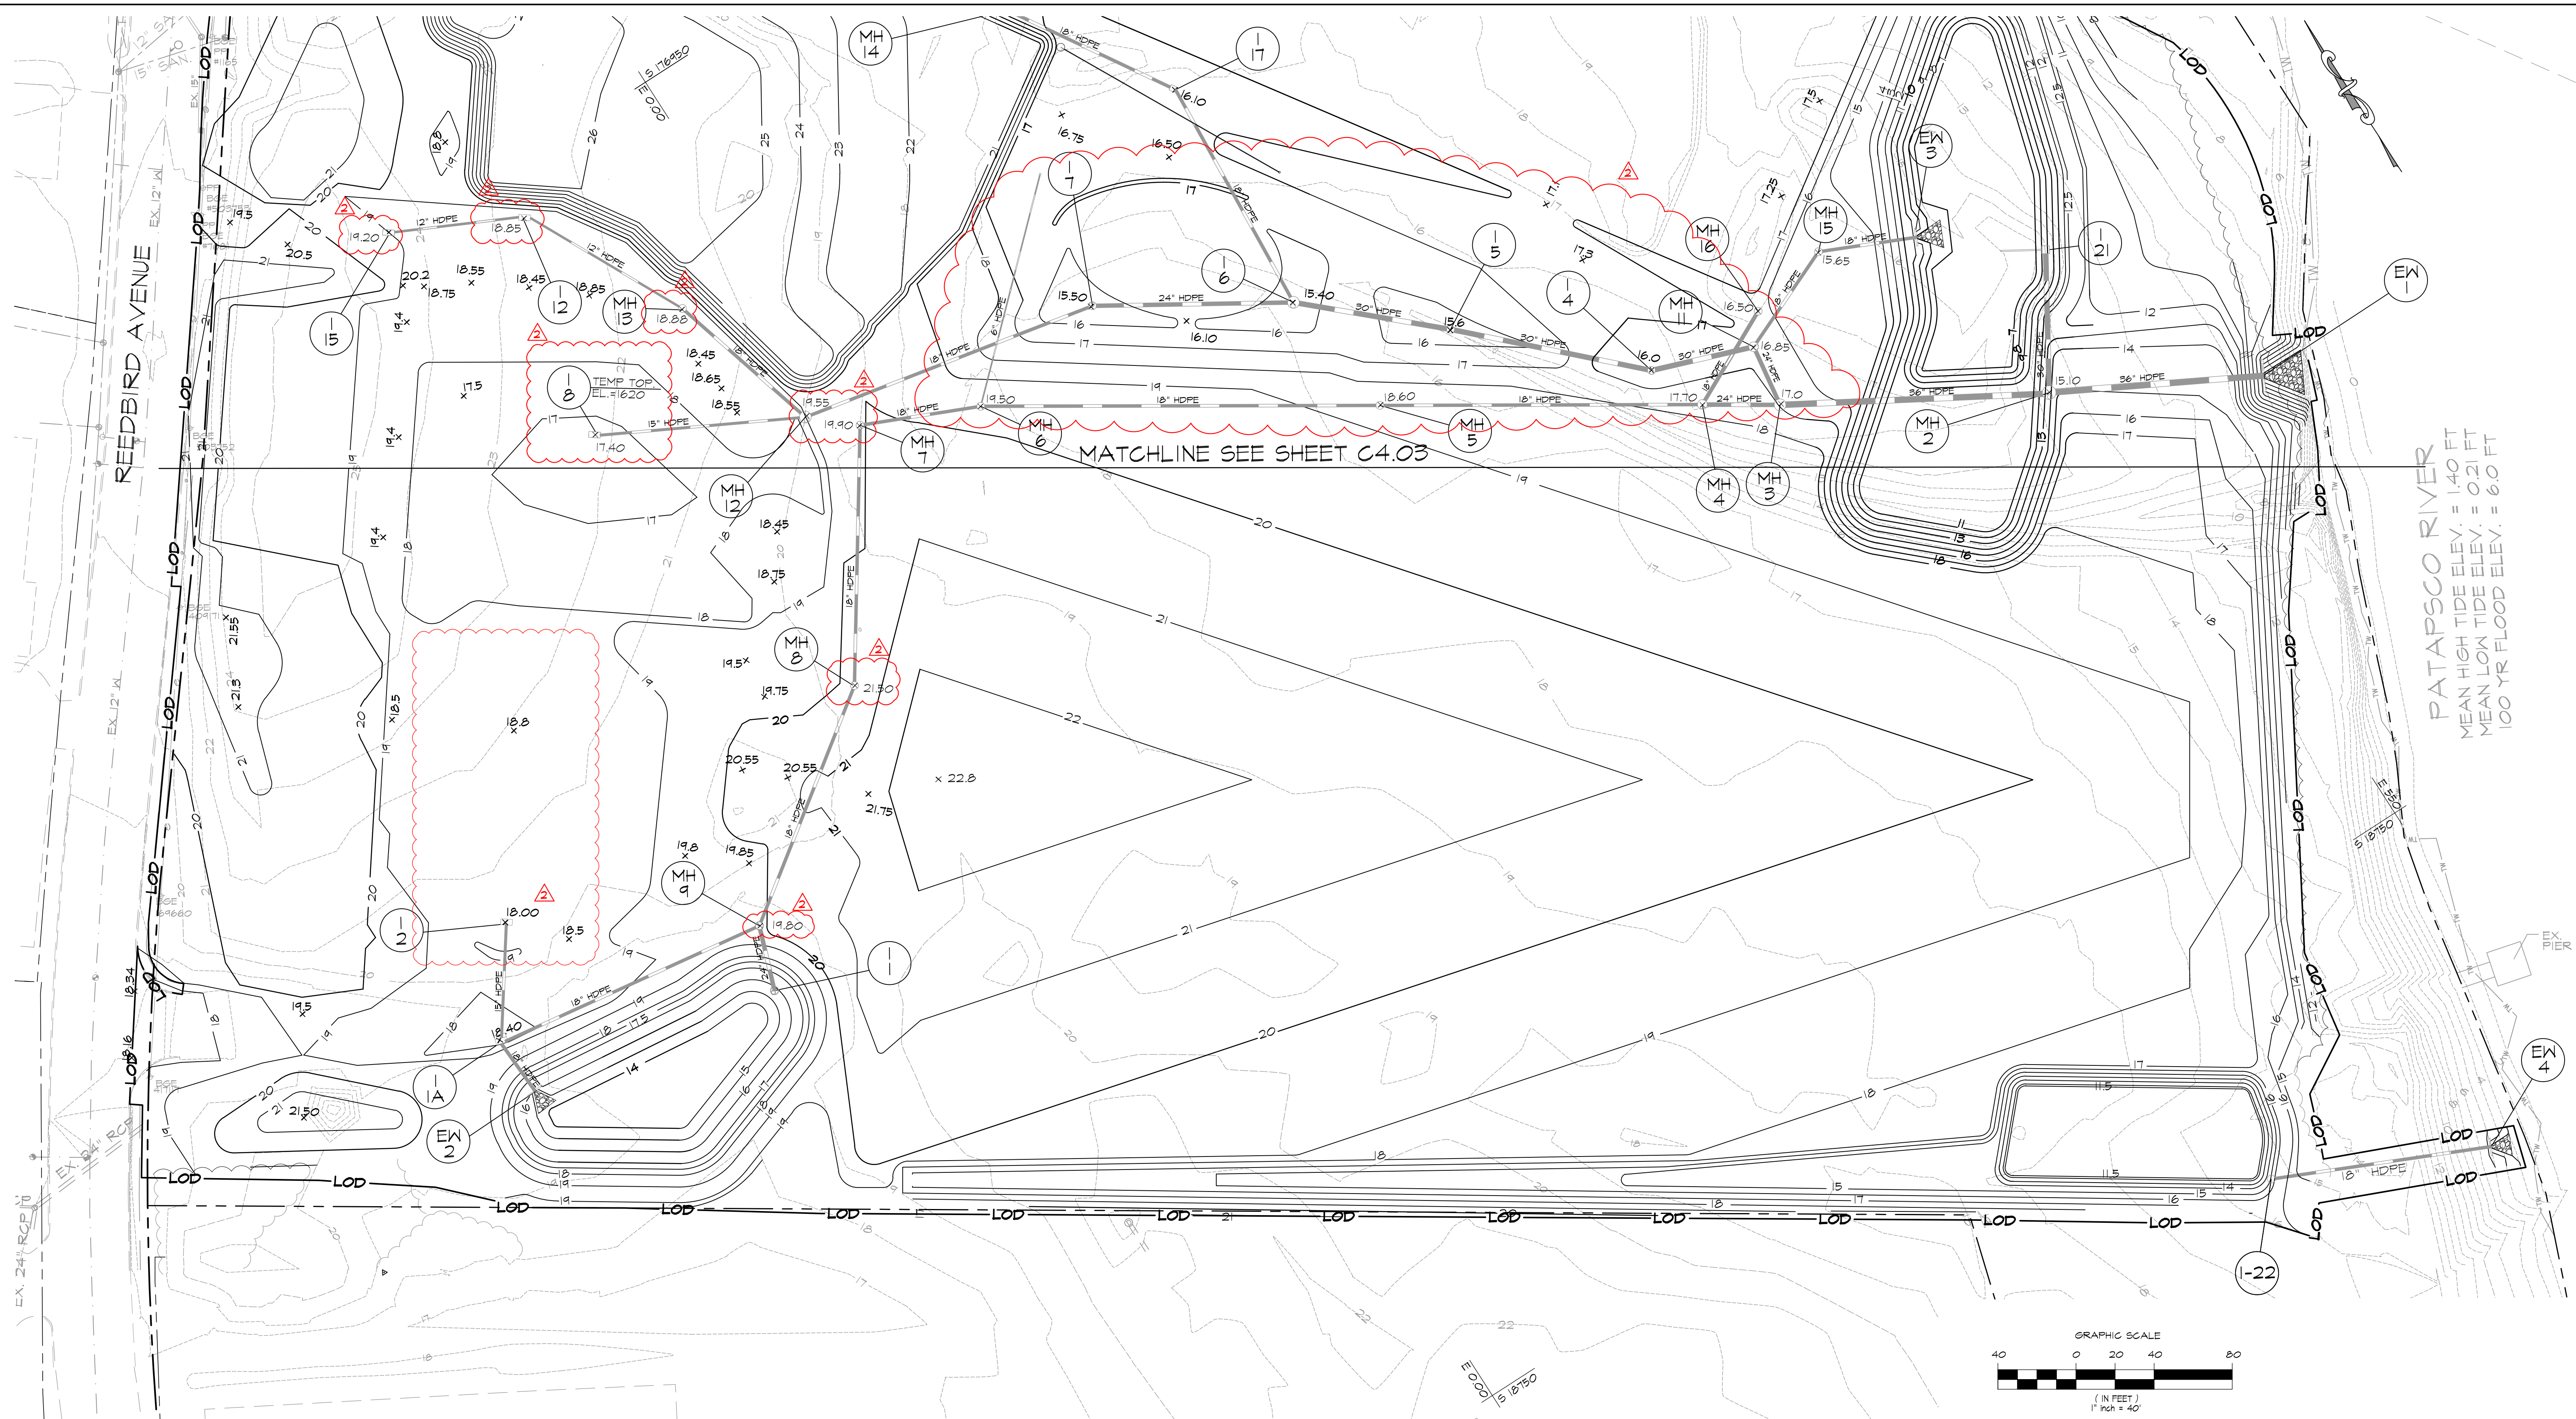


PATAPSCO RIVER
 MEAN HIGH TIDE ELEV. = 1.40 FT
 MEAN LOW TIDE ELEV. = 0.21 FT
 100 YR FLOOD ELEV. = 6.0 FT

STAGE 1 - SITE & GRADING PLAN
 SCALE: 1"=40'

LEGEND

- | | | | |
|------------|--------------------------|----------------------------|-----------------------------|
| --- 20 --- | EX. INDEX CONTOUR | --- EX. OVERHEAD ELEC. --- | EX. OVERHEAD ELECTRIC |
| --- 21 --- | EX. INTERMEDIATE CONTOUR | --- EX. FENCE --- | EX. FENCE |
| --- | PROPERTY LINE | ○ | EX. MANHOLE |
| --- | EX. CURB AND GUTTER | □ | EX. INLET |
| --- | EX. 12" SD | ○ | EX. TREE |
| --- | EX. STORM DRAIN | ○ | EX. WOODS LINE |
| --- | EX. 8" SAN | --- | LOD |
| --- | EX. SANITARY SEWER | --- | 20 |
| --- | EX. 6" W | --- | PROG. INDEX CONTOURS |
| --- | EX. WATER | --- | 21 |
| --- | EX. GAS | --- | PROG. INTERMEDIATE CONTOURS |
| --- | EX. UNDERGROUND ELEC. | --- | |
| --- | EX. UNDERGROUND ELECTRIC | | |

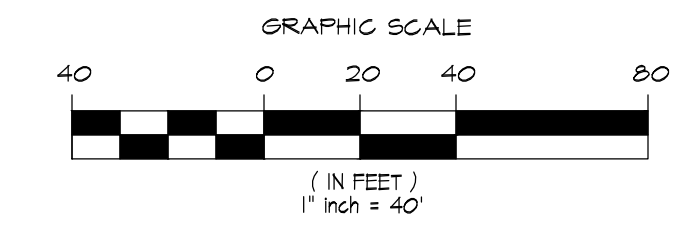

ISSUED FOR BID

mk
 Consulting Engineers, LLC
 Wheatall Hill
 3300 Clipper Mill Road, Suite 201
 Baltimore, MD 21211
 667-308-6163

G|W
W|O
 GWWO INC.
 800 WYMAN PARK DRIVE, SUITE 300
 BALTIMORE, MARYLAND 21211, 410-332-0099

© 2019 GWWO INC.
 I CERTIFY THAT THESE DOCUMENTS WERE PREPARED OR APPROVED BY ME, AND THAT I AM A FULLY LICENSED ENGINEER UNDER THE LAWS OF THE STATE OF MARYLAND. LICENSE NUMBER: 25058, EXPIRATION DATE: 11/17/20


Revisions	No.	Date	Description
	2	1/28/20	Addendum #2

MIDDLE BRANCH FITNESS & WELLNESS CENTER AT CHERRY HILL
 BALTIMORE CITY RECREATION & PARKS

Job No.	18010	Author	SG
Scale	1"=40'	Checker	AP
Date	1/28/2019	Approver	SM

Drawing Title	STAGE 1 - SITE & GRADING PLAN	Drawing Number	C4.04r2
Sheet			OF

KEYNOTES LISTED ON THIS SHEET ARE FOR CONVENIENCE ONLY. REFER TO SHEET CS.3 FOR COMPLETE LIST

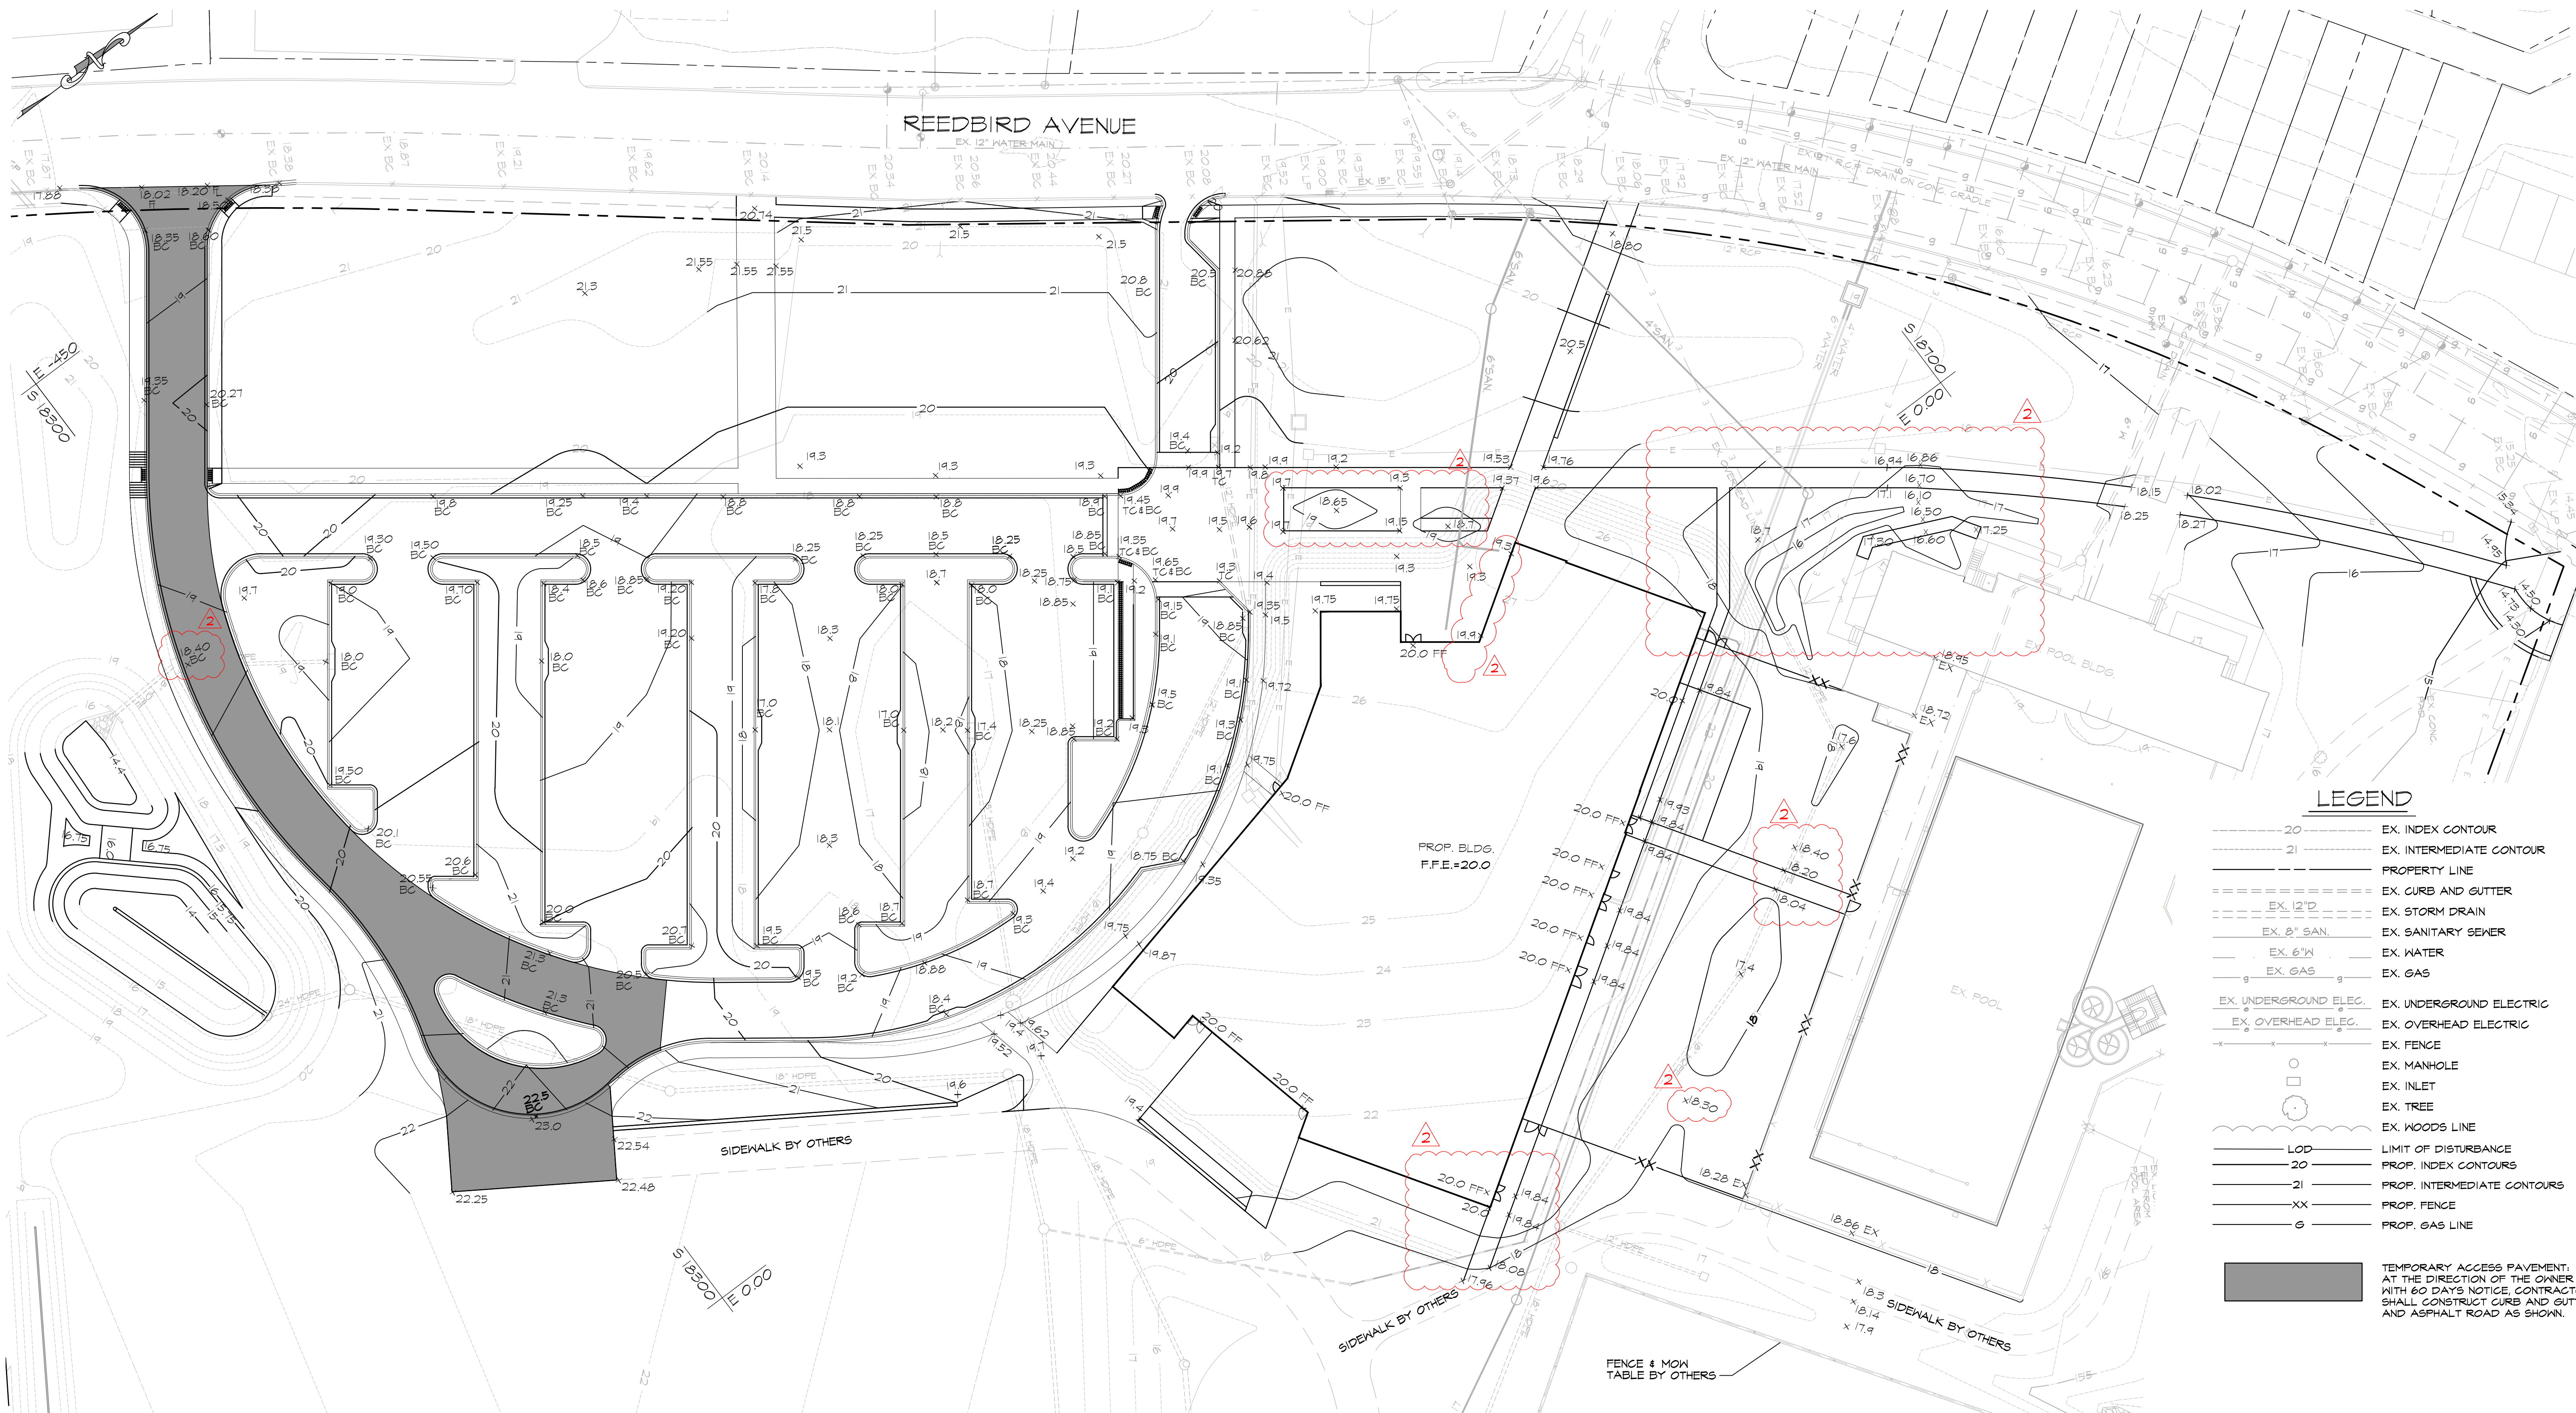


LEGEND

- 20 --- EX. INDEX CONTOUR
- 21 --- EX. INTERMEDIATE CONTOUR
- --- PROPERTY LINE
- --- EX. CURB AND GUTTER
- EX. 12" D --- EX. STORM DRAIN
- EX. 8" SAN. --- EX. SANITARY SEWER
- EX. 6" W --- EX. WATER
- EX. GAS --- EX. GAS
- --- EX. UNDERGROUND ELEC.
- --- EX. OVERHEAD ELEC.
- --- EX. FENCE
- --- EX. MANHOLE
- --- EX. INLET
- --- EX. TREE
- --- EX. WOODS LINE
- LOD --- LIMIT OF DISTURBANCE
- 20 --- PROP. INDEX CONTOURS
- 21 --- PROP. INTERMEDIATE CONTOURS
- XX --- PROP. FENCE
- G --- PROP. GAS LINE

TEMPORARY ACCESS PAVEMENT:
 AT THE DIRECTION OF THE OWNER AND
 WITH 60 DAYS NOTICE, CONTRACTOR
 SHALL CONSTRUCT CURB AND GUTTER
 AND ASPHALT ROAD AS SHOWN.

STAGE 2 - GRADING PLAN

SCALE: 1"=30'

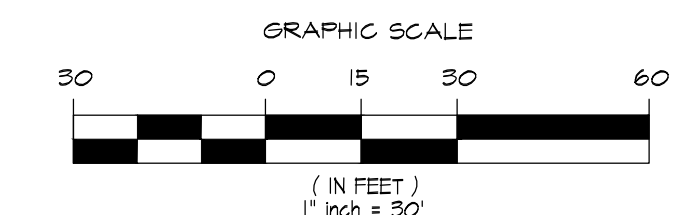

NOTE:
 SEE DWG. C4.00 FOR FINAL GRADING
 IN AREAS NOT SHOWN ON THIS PLAN

ISSUED FOR BID

mk
 Consulting Engineers, LLC
 Whetzel Hill
 3300 Clippert Mill Road, Suite 201
 Baltimore, MD 21211
 667-308-6163

G | W
W | O
 GWWO INC.
 800 WYMAN PARK DRIVE, SUITE 300
 BALTIMORE, MARYLAND 21211, 410-332-0209


© 2019 GWWO INC.
 I CERTIFY THAT THESE DOCUMENTS WERE PREPARED OR APPROVED BY ME, AND THAT I AM A FULLY LICENSED ENGINEER UNDER THE LAWS OF THE STATE OF MARYLAND.
 LICENSE NUMBER: 25058, EXPIRATION DATE: 11/17/20

Revisions	No.	Date	Description
	2	1/28/20	Addendum #2

MIDDLE BRANCH FITNESS & WELLNESS CENTER AT CHERRY HILL
 BALTIMORE CITY RECREATION & PARKS


Job No.	18010	Author	SG
Scale	1"=30'	Checker	AP
Date	1/28/2019	Approver	SM
Drawing Title	STAGE 2 GRADING PLAN		
Sheet	C4.05r2		

KEYNOTES LISTED ON THIS SHEET ARE FOR CONVENIENCE ONLY. REFER TO SHEET C5.3 FOR COMPLETE LIST


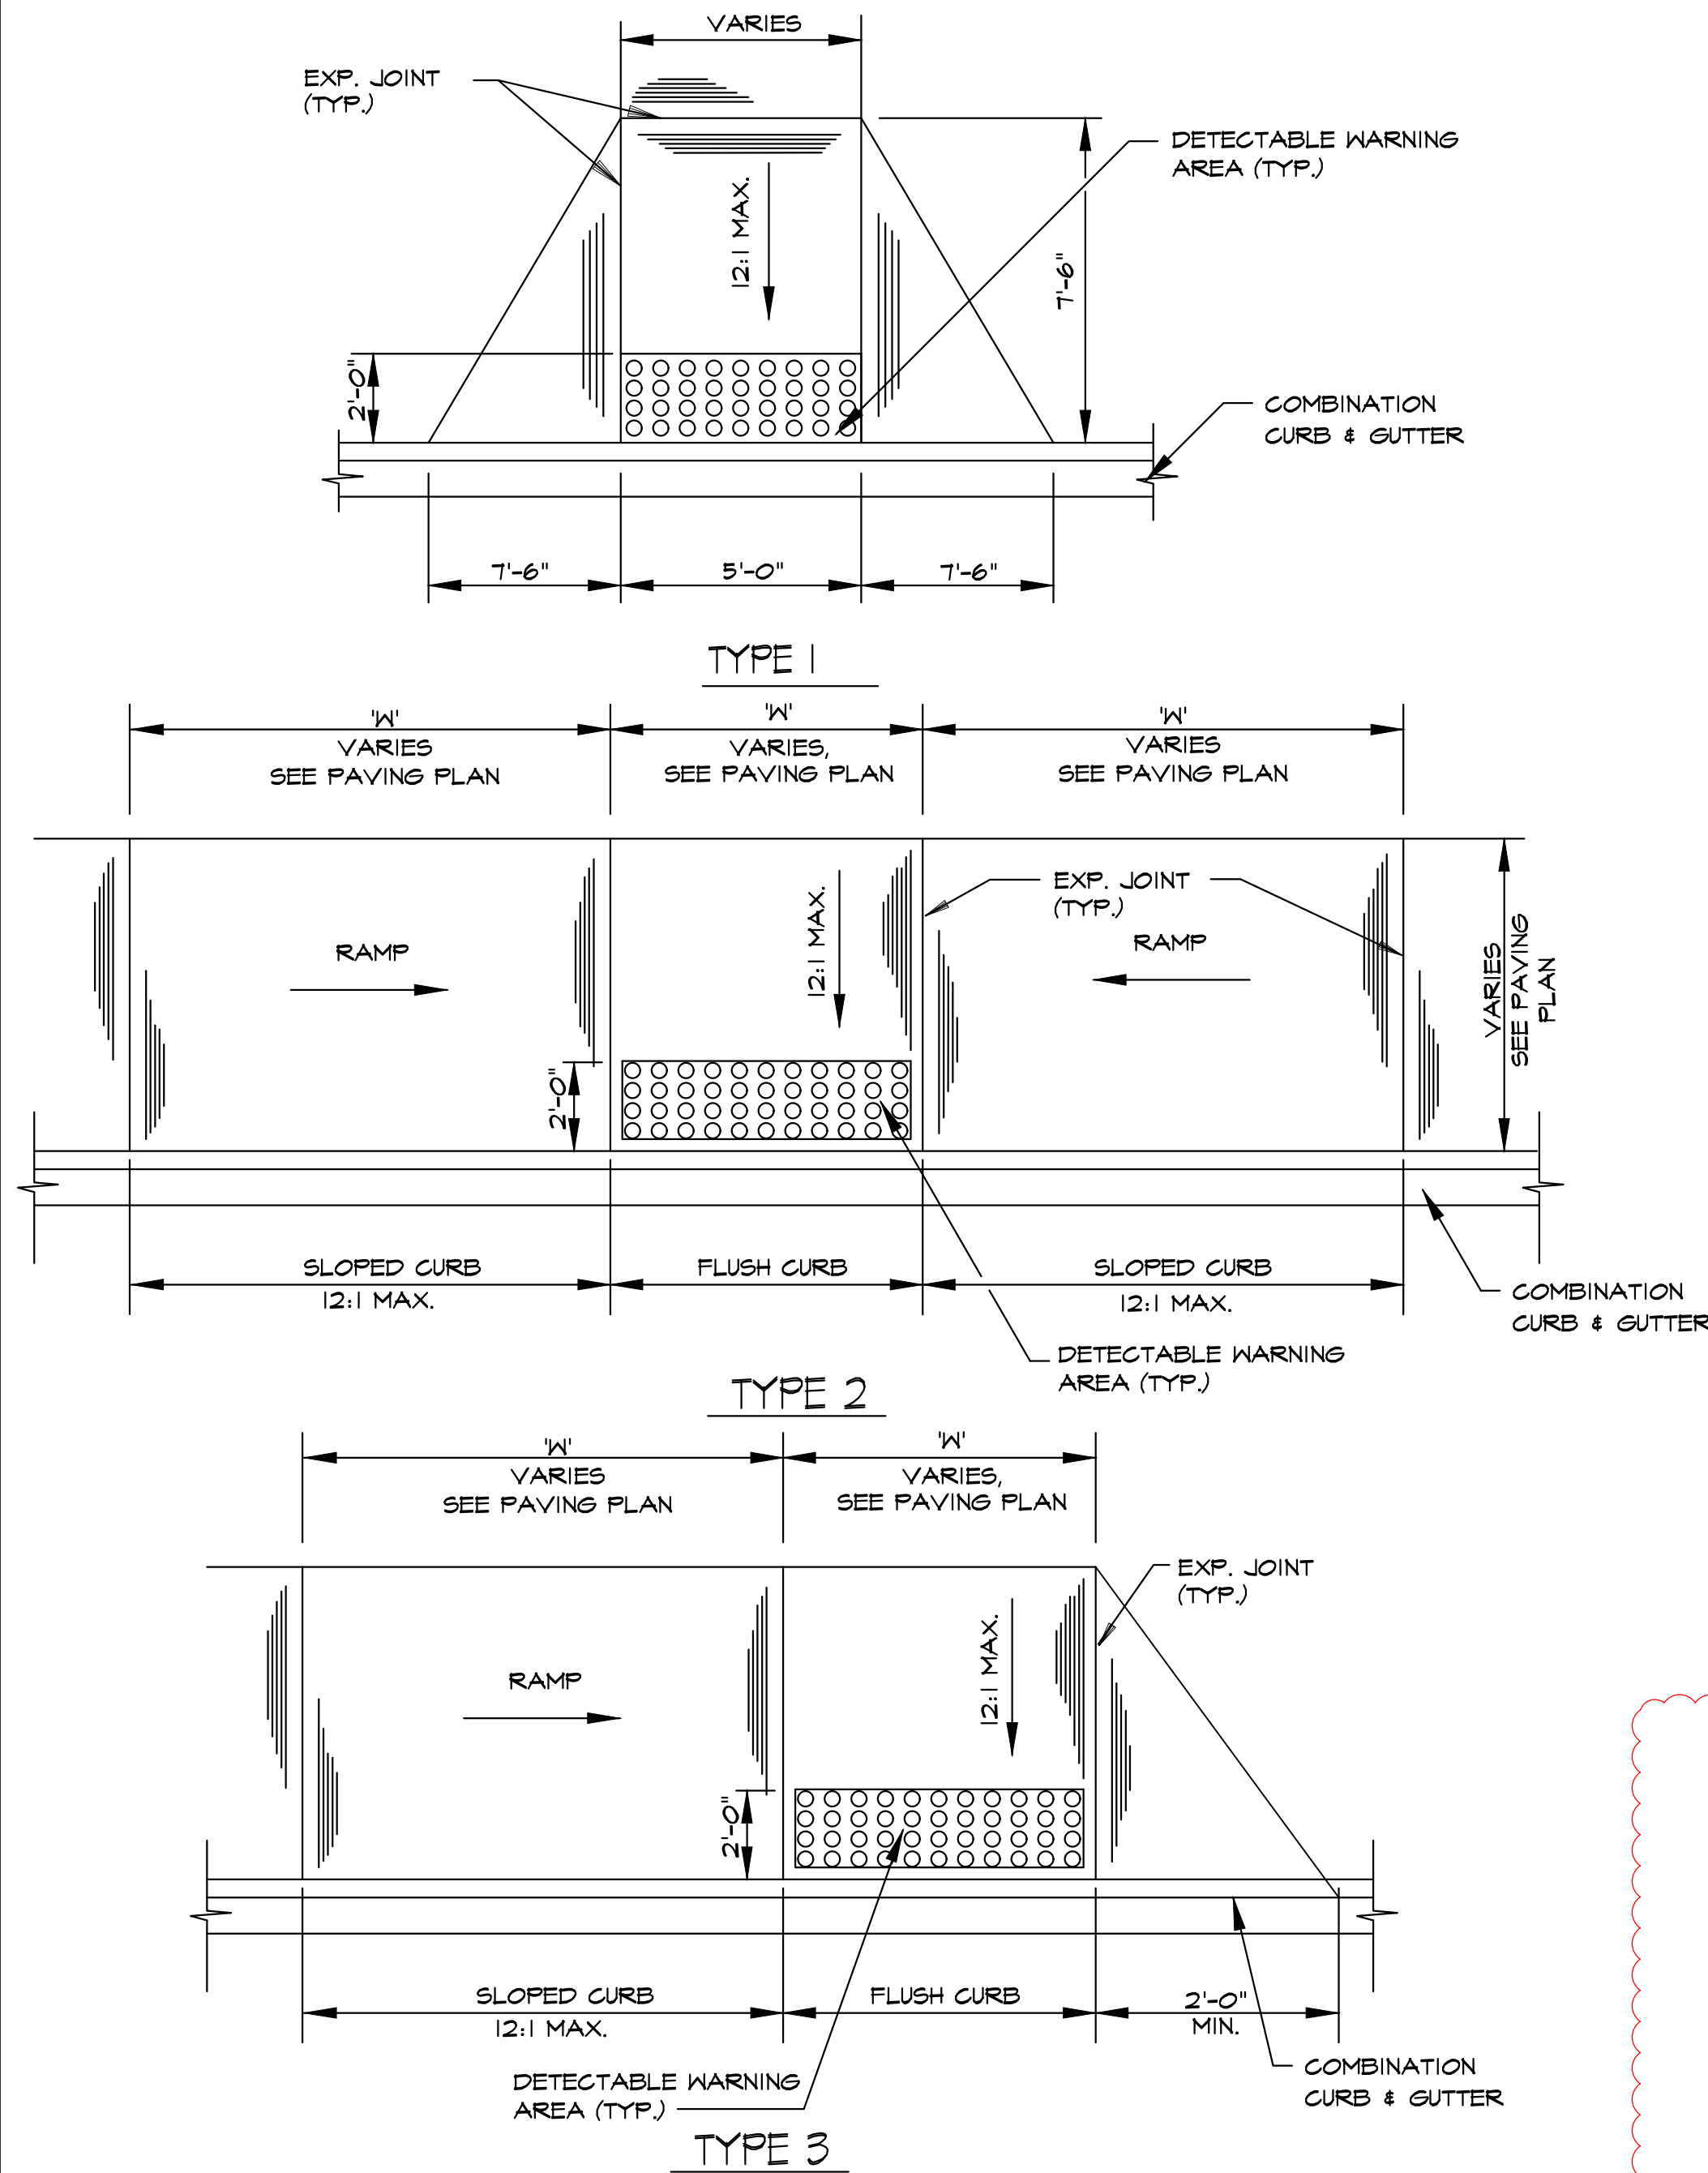


- NOTES:
1. SURFACE TEXTURE OF RAMPS SHALL BE COARSE BROOMING OR NON SKID SURFACE.
 2. SEE BALT. CITY STD DETAILS 655.1-13 FOR ADDITIONAL INFORMATION.
 3. DETECTABLE WARNING AREAS SHALL BE SQUARE PATTERN RED MASONRY UNITS. PARALLEL ALIGNMENT. SEE BALT. CITY STD. BC 655.40 FOR ADDITIONAL INFORMATION OR ONE PIECE REPLACEABLE ADA SOLUTIONS PLASTIC TOPS.
 4. SEE DEPRESSED CURB AND GUTTER AT PEDESTRIAN RAMP DETAIL, THIS SHEET.



1 PEDESTRIAN RAMP
C5.01 NOT TO SCALE

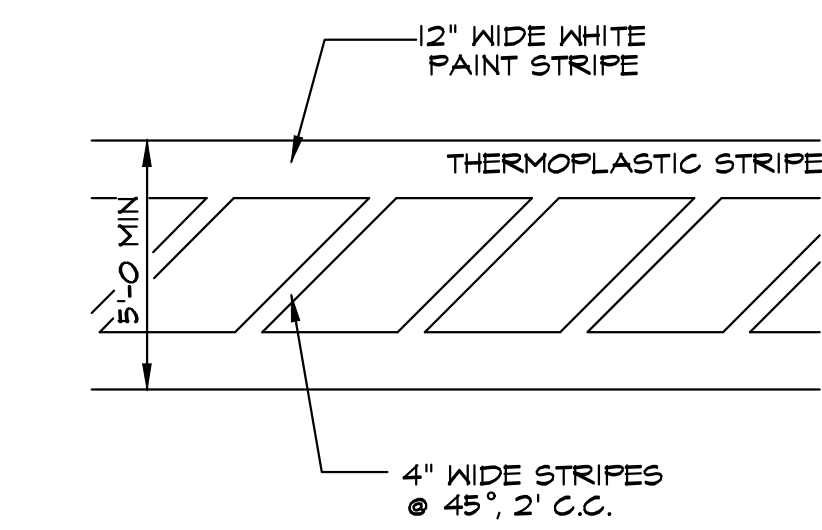

2 CROSSWALK STRIPING
C5.01 NOT TO SCALE

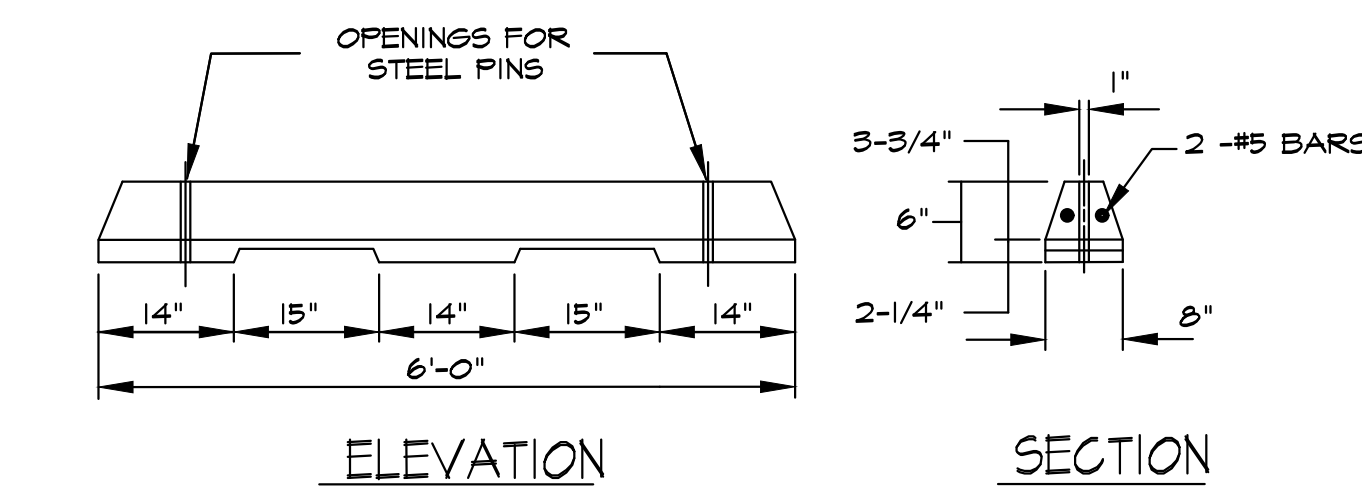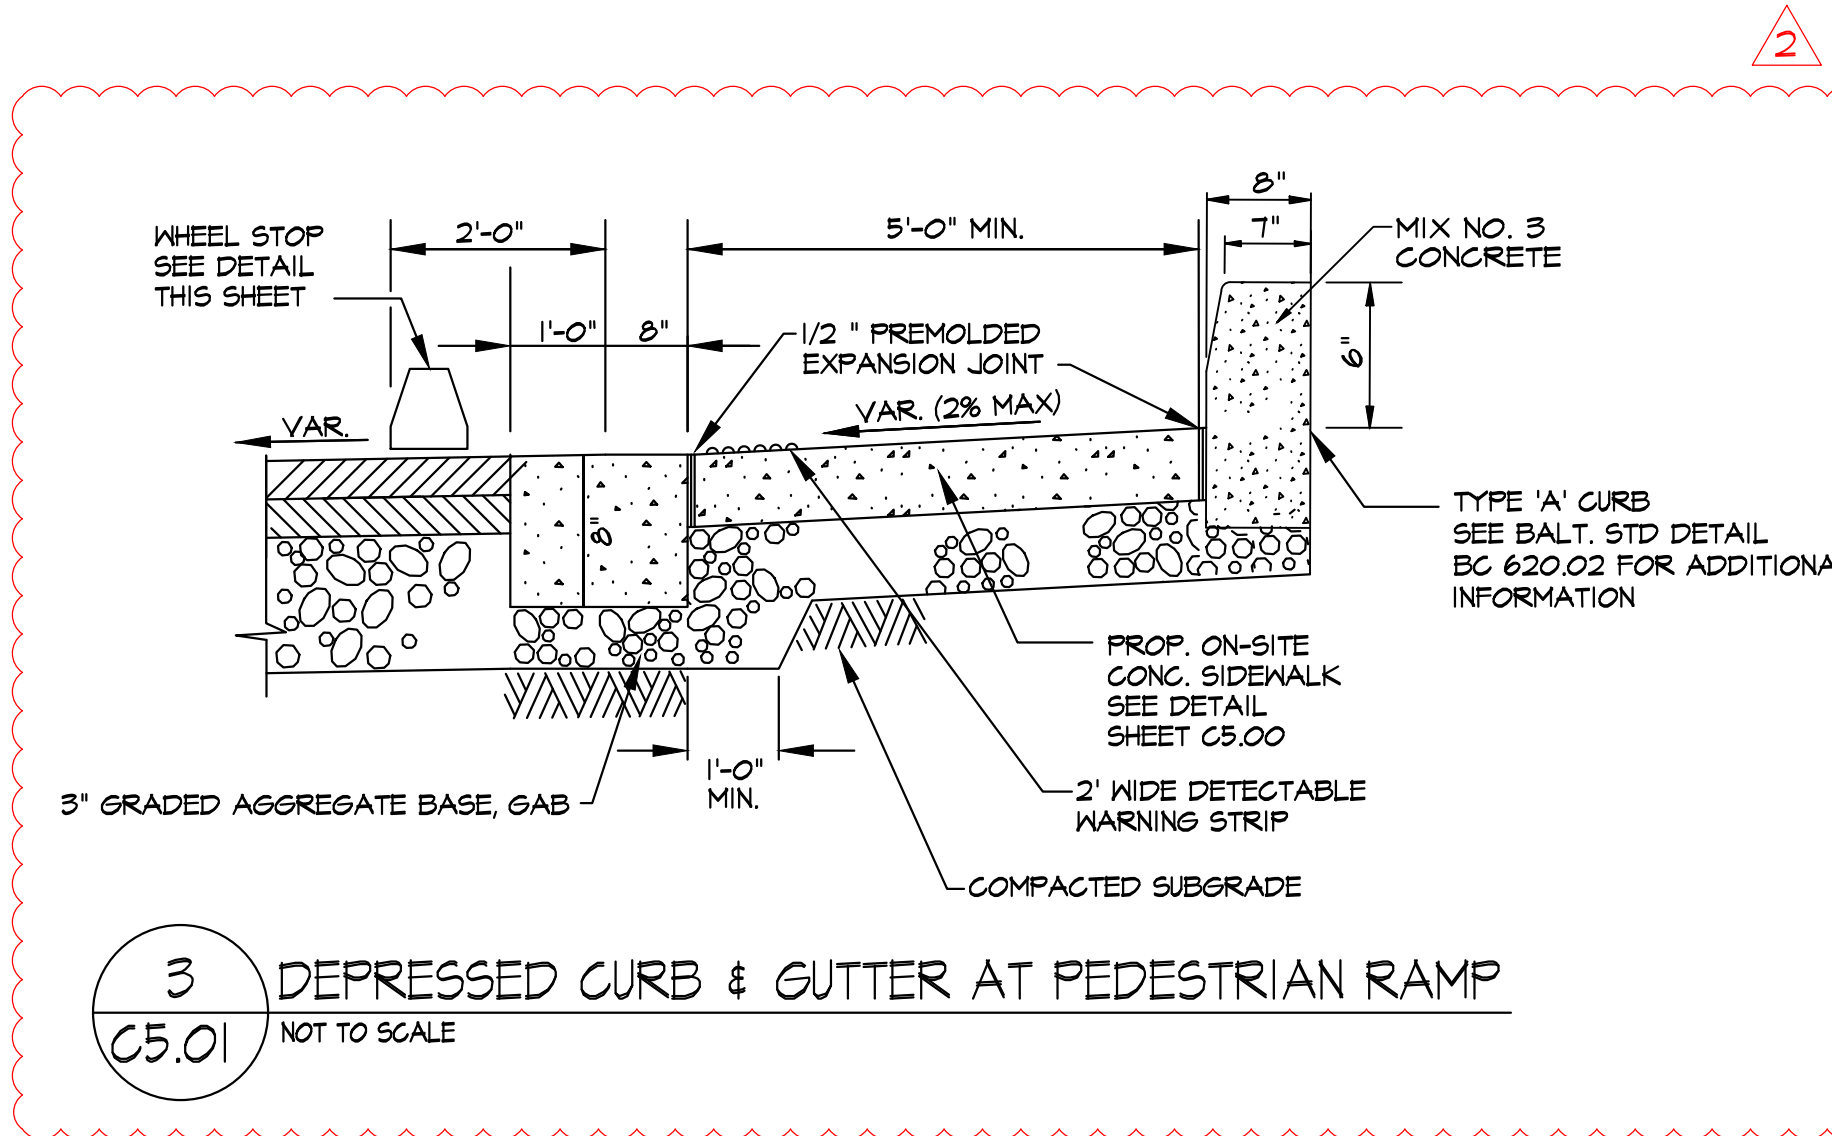


NOTE:
1. CONTRACTOR TO PROVIDE TWO (2) NO. 5 REBARS, 16" LONG FOR EACH WHEEL STOP.

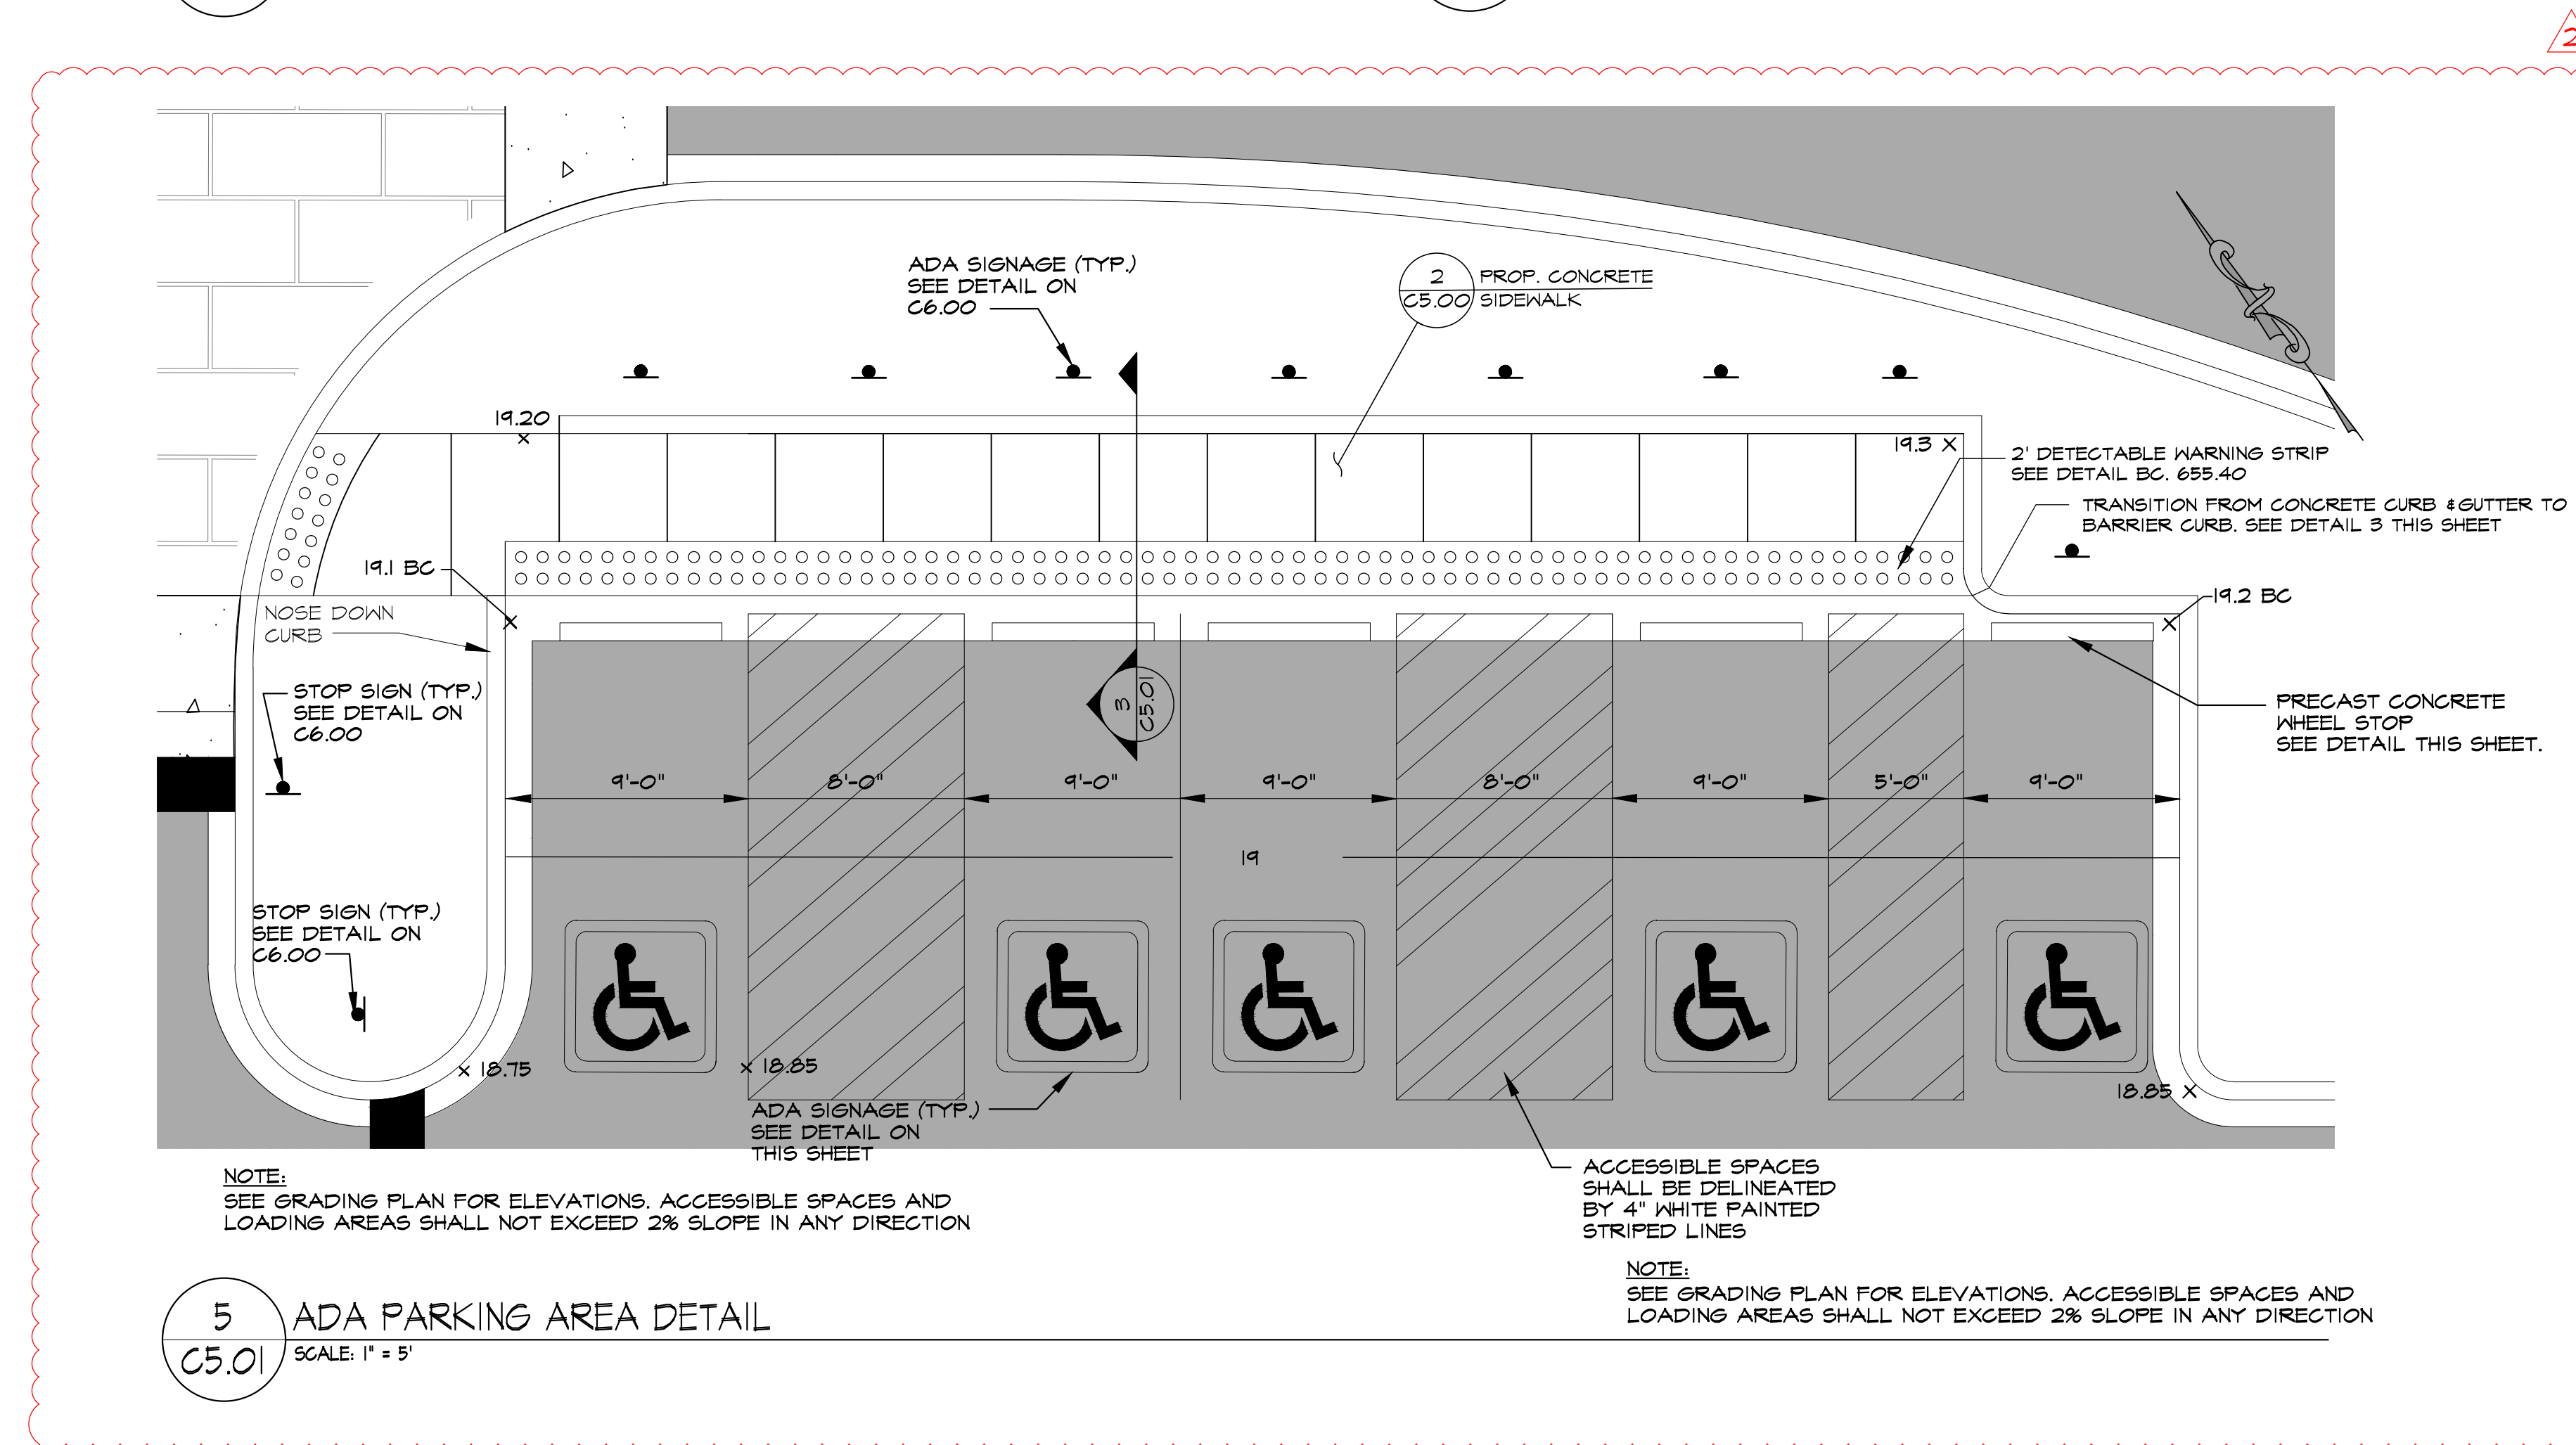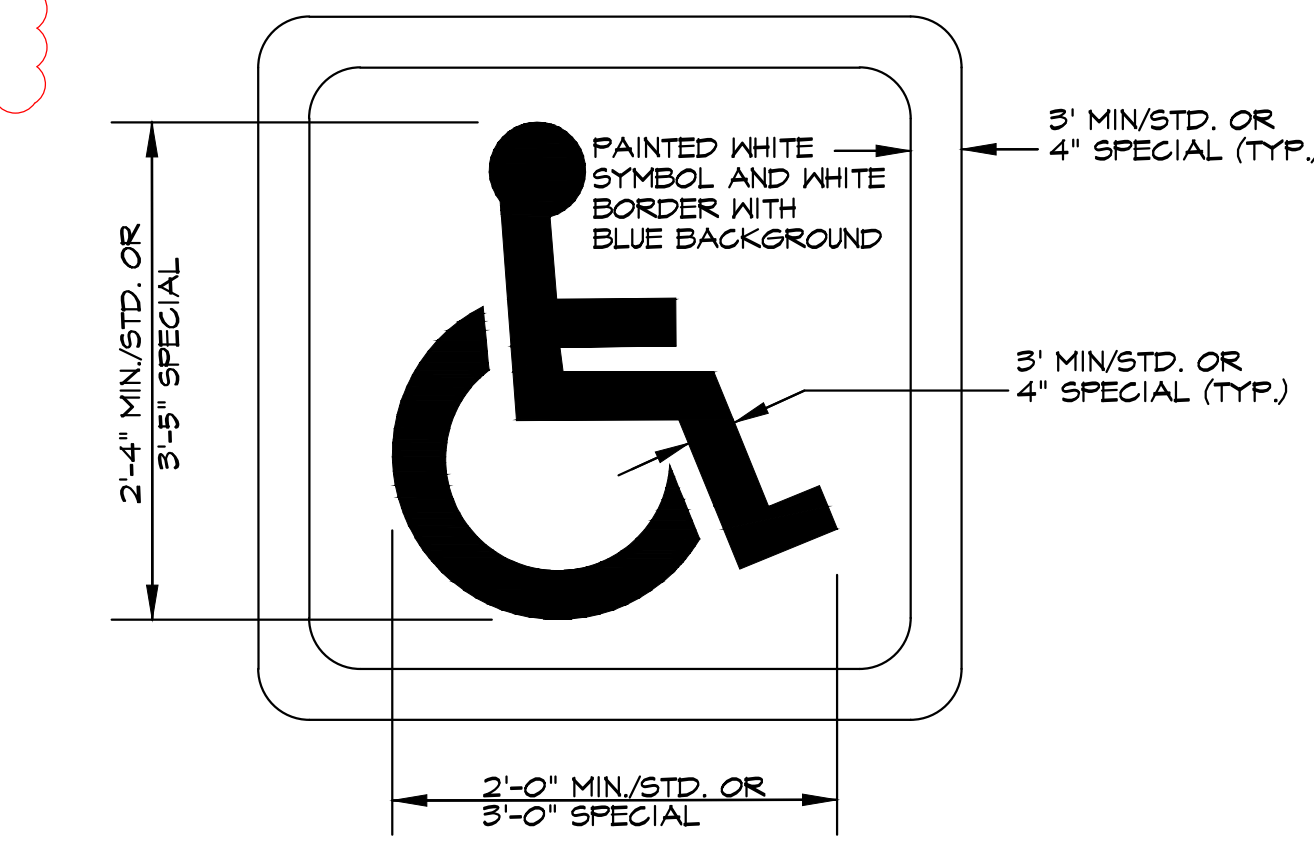

NOTE:
SEE GRADING PLAN FOR ELEVATIONS, ACCESSIBLE SPACES AND LOADING AREAS SHALL NOT EXCEED 2% SLOPE IN ANY DIRECTION

NOTE:
SEE GRADING PLAN FOR ELEVATIONS, ACCESSIBLE SPACES AND LOADING AREAS SHALL NOT EXCEED 2% SLOPE IN ANY DIRECTION

ISSUED FOR BID

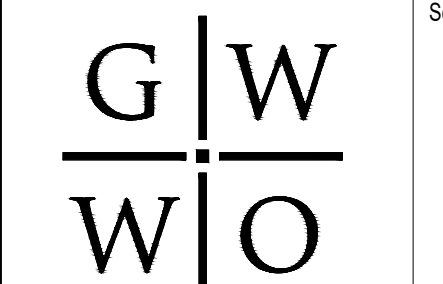

G|W|O INC.
800 WYMAN PARK DRIVE, SUITE 300
BALTIMORE, MARYLAND 21211, 410-332-0209

© 2019 G|W|O INC.
I CERTIFY THAT THESE DOCUMENTS WERE PREPARED OR APPROVED BY ME, AND THAT I AM A DULY LICENSED ENGINEER UNDER THE LAWS OF THE STATE OF MARYLAND.
LICENSE NUMBER: 25598, EXPIRATION DATE: 11/17/20


Revisions	No.	Date	Description
	2	1/28/20	Addendum #2

MIDDLE BRANCH FITNESS & WELLNESS CENTER AT CHERRY HILL
BALTIMORE CITY RECREATION & PARKS

Job No.	18010	Author	SG
Scale	AS SHOWN	Checker	AP
Date	1/28/2019	Approver	SM

Drawing Title	Drawing Number
SITE DETAILS	C5.01r2
Sheet	Of

KEYNOTES LISTED ON THIS SHEET ARE FOR CONVENIENCE ONLY. REFER TO SHEET C6.3 FOR COMPLETE LIST

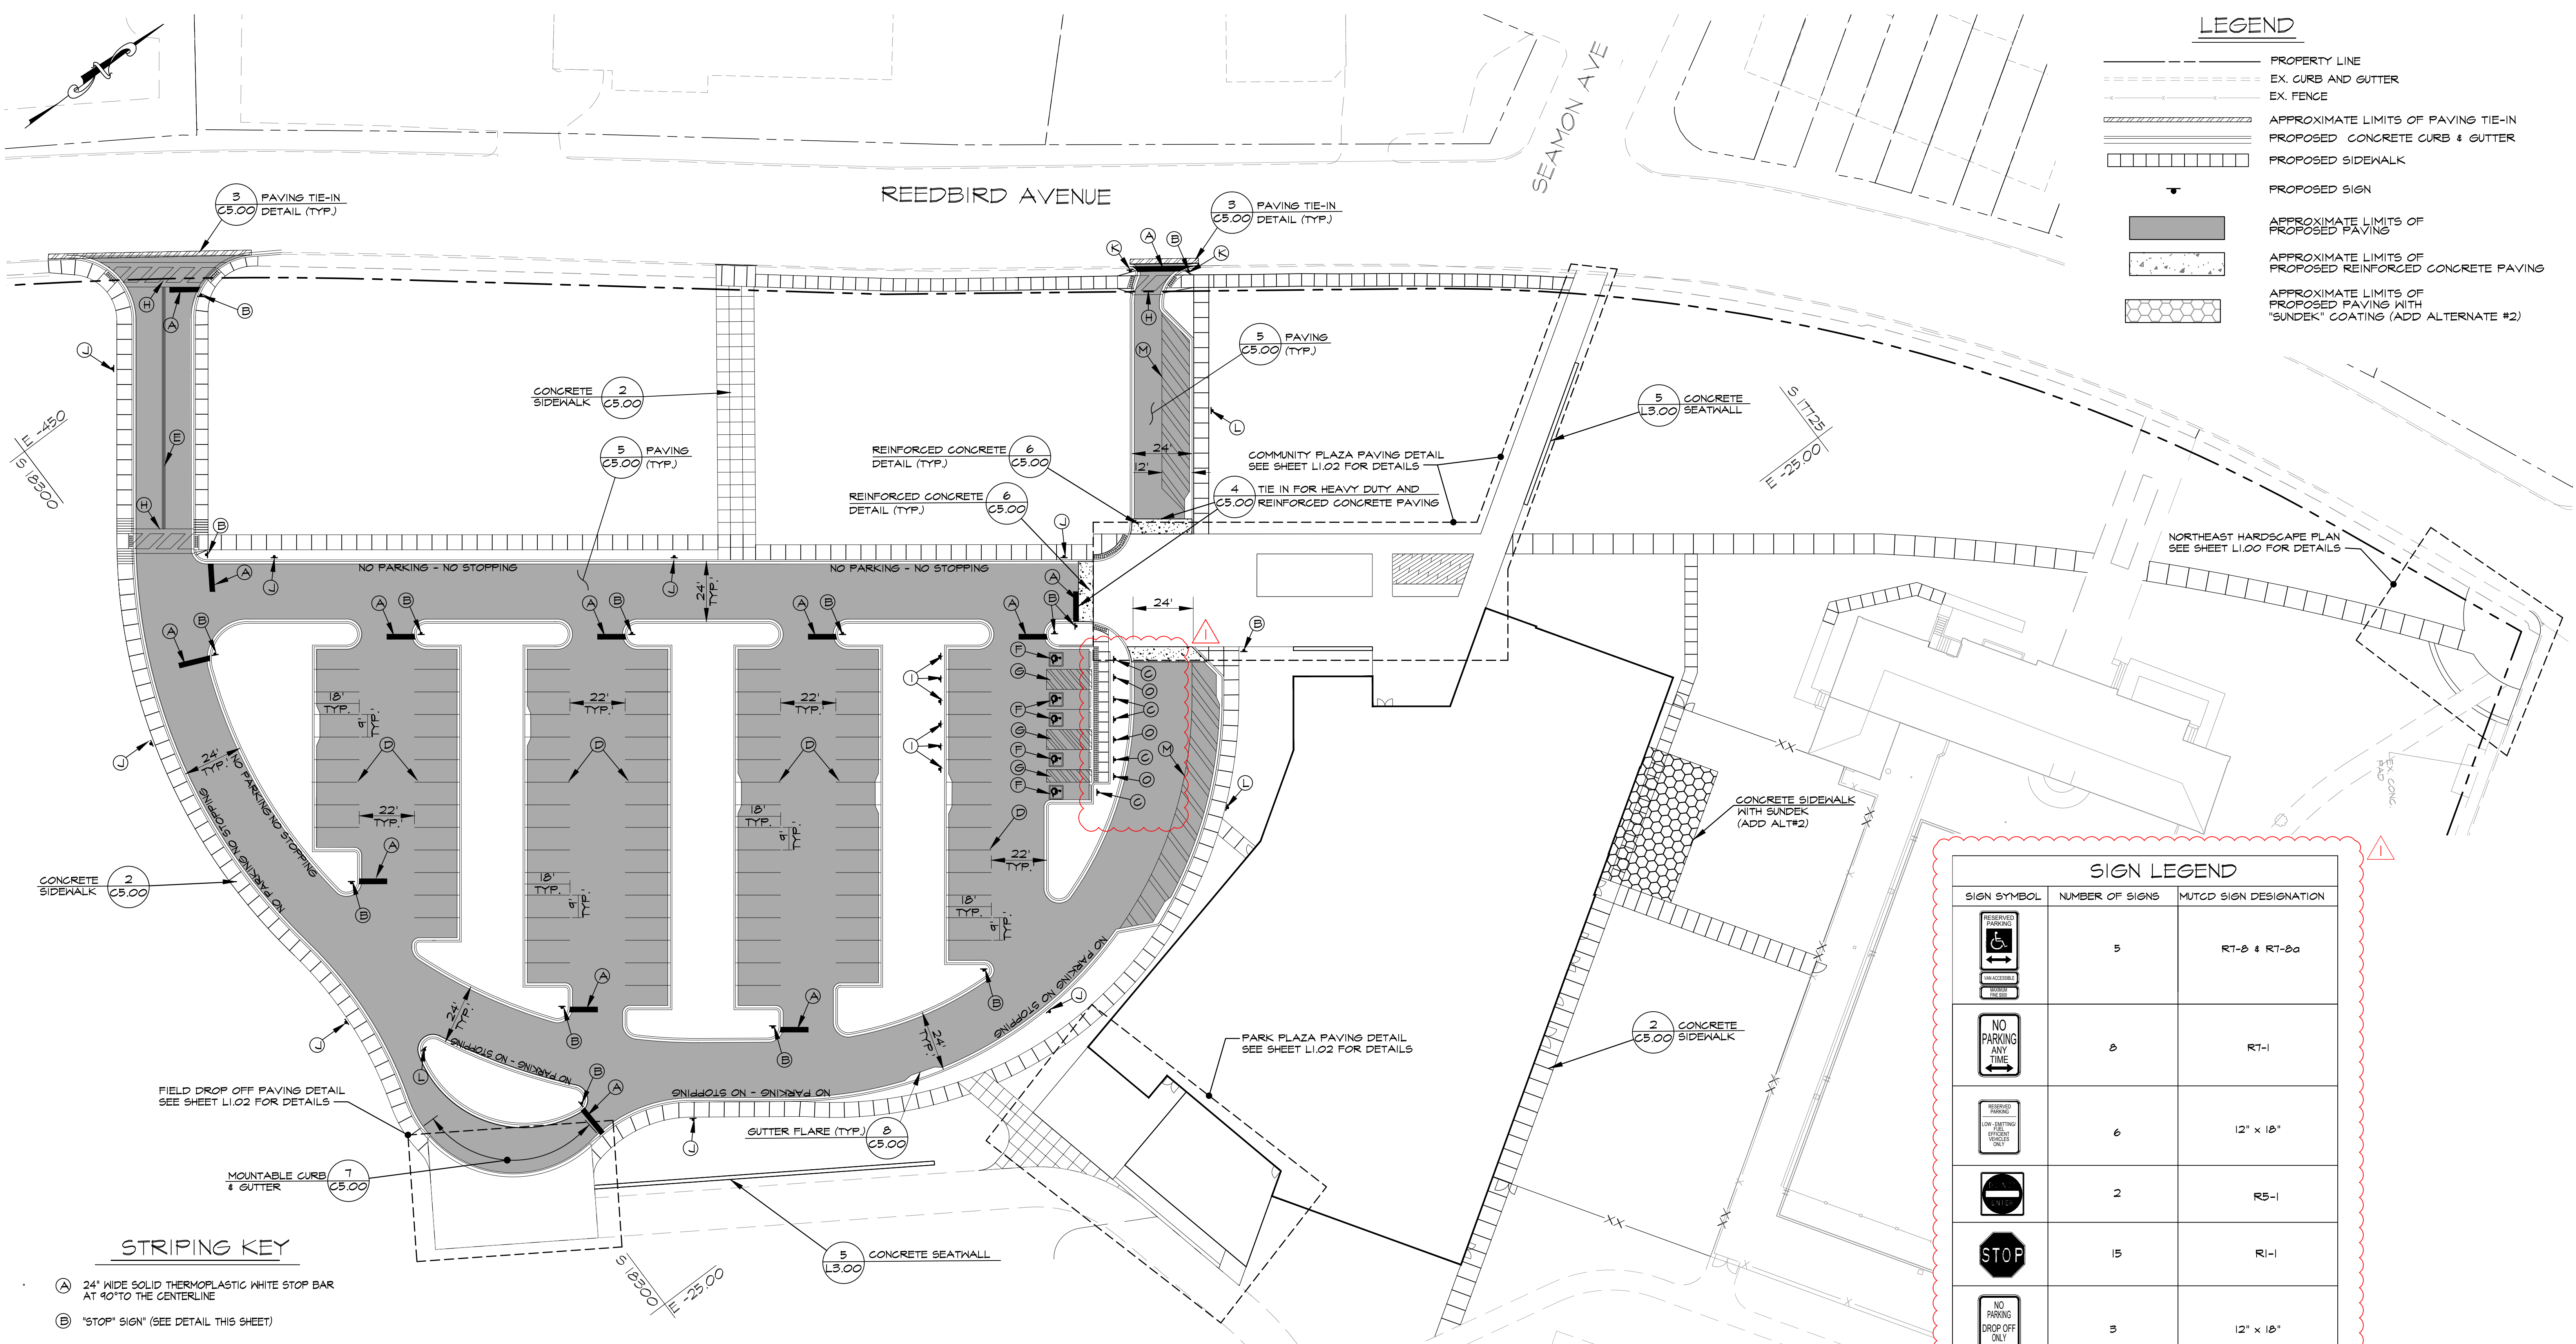

LEGEND

- PROPERTY LINE
- - - EX. CURB AND GUTTER
- - - EX. FENCE
- APPROXIMATE LIMITS OF PAVING TIE-IN
- PROPOSED CONCRETE CURB & GUTTER
- PROPOSED SIDEWALK
- PROPOSED SIGN
- APPROXIMATE LIMITS OF PROPOSED PAVING
- APPROXIMATE LIMITS OF PROPOSED REINFORCED CONCRETE PAVING
- APPROXIMATE LIMITS OF PROPOSED PAVING WITH "SUNDEK" COATING (ADD ALTERNATE #2)

SIGN LEGEND		
SIGN SYMBOL	NUMBER OF SIGNS	MUTCD SIGN DESIGNATION
	5	RT-8 & RT-8a
	8	RT-1
	6	12' x 18"
	2	RS-1
	15	RI-1
	5	12' x 18"
	5	12' x 18"

STRIPING KEY

- (A) 24" WIDE SOLID THERMOPLASTIC WHITE STOP BAR AT 90° TO THE CENTERLINE
- (B) "STOP" SIGN (SEE DETAIL THIS SHEET)
- (C) "RESERVE PARKING" FOR HANDICAP SIGNAGE (SEE DETAIL THIS SHEET)
- (D) 5" WIDE SOLID THERMOPLASTIC WHITE LINE
- (E) 5" SOLID DOUBLE YELLOW THERMOPLASTIC CENTERLINE WITH 4" SPACE BETWEEN
- (F) ADA PARKING SYMBOL. SEE DETAIL SHEET C6.01
- (G) 4" SOLID THERMOPLASTIC WHITE LINES WITH 30" SPACING AT 45° FROM PARKING SPACES / CURB
- (H) 12" WIDE WHITE THERMOPLASTIC CROSSWALK LINES SPACED 5' APART WITH 4" WIDE SOLID WHITE LINES AT 24" SPACING @ 45°. SEE DETAIL SHEET C6.01
- (I) LOW EMISSION & FUEL EFFICIENT VEHICLE PARKING ONLY SIGN (SEE DETAIL THIS SHEET)
- (J) "NO PARKING" SIGN SPACED 150' APART. (SEE DETAIL THIS SHEET)
- (K) "DO NOT ENTER" SIGN (SEE DETAIL THIS SHEET)
- (L) VEHICLE DROP OFF SIGN (SEE DETAIL THIS SHEET)
- (M) 24" SOLID THERMOPLASTIC WHITE LINES WITH 72" SPACING AT 45° FROM CURB.
- (N) "NO PARKING IN ACCESS AISLE" SIGN (SEE DETAIL THIS SHEET)

PAVING / STRIPING / SIGNAGE PLAN


SCALE: 1"=30'



- 1. CURB TO BE PAINTED YELLOW
- 2. LETTERING TO BE BLACK PAINTED, 6" TALL CENTERED ON TOP OF CURB.

CURB MARKING DETAIL

SCALE: NOT TO SCALE

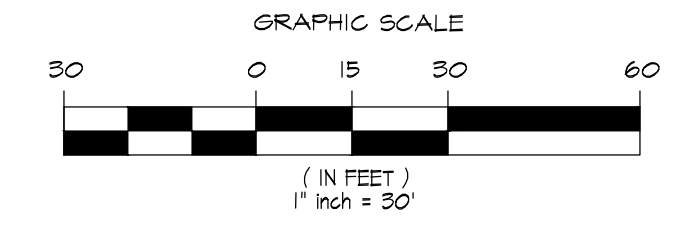

ISSUED FOR BID

mk
 Consulting Engineers, LLC
 Whittell Hill
 3300 Clippert Mill Road, Suite 201
 Baltimore, MD 21211
 667-308-6163

G|W
W|O
 GWVO INC.
 800 WYMAN PARK DRIVE, SUITE 300
 BALTIMORE, MARYLAND 21211, 410-332-0209

CERTIFY THAT THESE DOCUMENTS WERE PREPARED OR APPROVED BY ME, AND THAT I AM A FULLY LICENSED ENGINEER UNDER THE LAWS OF THE STATE OF MARYLAND. LICENSE NUMBER: 25058, EXPIRATION DATE: 11/17/20

Revisions	No.	Date	Description
	2	1/28/20	Addendum #2

MIDDLE BRANCH FITNESS & WELLNESS CENTER AT CHERRY HILL
 BALTIMORE CITY RECREATION & PARKS

Job No.	18010	Author	SG
Scale	1"=30'	Checker	AP
Date	1/28/2019	Approver	SM
Drawing Title	PAVING / STRIPING & SIGNAGE PLAN		
Sheet	C6.00r2		Of

BENCHMARK DATA

ALL HORIZONTAL AND VERTICAL SURVEY DATA CONTAINED HEREIN ARE REFERENCED TO THE CITY OF BALTIMORE COORDINATE SYSTEM, AS DERIVED FROM THE FOLLOWING BENCHMARKS FROM THE PLAN ENTITLED "REEDBIRD TOPO" DATED APRIL 2018, BY NAVARRO & WRIGHT

POINT#	NORTHING	EASTING	DESCRIPTION
1	-17,900.95	-54.48	REBAR AND CAP
2	-18,007.42	150.90	REBAR AND CAP

BASELINE DATA					
STA.	NORTHING	EASTING	BEARING / RADIUS	DISTANCE / ARC LENGTH	CHORD
0+00	-18,208.32	-479.62	S53°5'25.06"E	113.34'	
1+13.34	-18,276.42	-388.96	212'	334.14'	N81°44'57.98"E 300.65'
4+47.58	-18,233.27	-91.42			
4+85.17	-18,203.04	-69.01	N36°35'21.01"E	37.54'	
7+16.83	-17,996.54	-98.96	148'	231.64'	N8°14'57.74"W 208.71'
7+47.40	-17,979.17	-123.41			
100+00	-18,225.23	-309.00			
101+39.43	-18,308.98	-197.52	N53°5'16.20"W	139.43'	
200+00	-18,263.28	-118.44			
201+75.17	-18,158.07	-258.55	N53°5'16.20"W	175.17'	
300+00	-18,198.06	-65.44			
301+78.42	-18,090.91	-208.10	N53°5'16.20"W	178.42'	
400+00	-18,112.21	-39.87			
401+47.31	-18,023.74	-157.65	N53°5'16.20"W	147.31'	
500+00	-17,968.55	-146.21			
501+03	-17,906.75	-228.47	N53°5'16.20"W	103.00'	
501+35.12	-17,871.56	-232.80	21'	32.72'	N8°26'46.68"W 29.51'

POINT DATA BASELINE 'A'		
POINT NO.	STATION / NORTH	OFFSET / EAST
1	0+0.42	35.00 LT.
2	0+01.64	38.41 RT.
3	0+25.34	12.00 RT.
4	0+26.20	12.00 RT.
5	1+13.34	12.00 RT.
6	1+13.34	12.00 LT.
7	1+23.34	16.78 LT.
8	1+52.53	31.19 LT.
9	1+70.27	12.00 LT.
10	2+78.08	12.00 LT.
11	2+84.06	12.00 RT.
12	3+23.18	12.00 LT.
13	3+42.16	20.75 RT.
14	3+45.64	34.70 RT.
15	3+45.80	12.00 RT.
16	3+55.71	12.00 LT.
17	4+20.72	12.00 RT.
18	4+03.77	20.74 RT.
19	4+10.90	31.86 RT.
20	4+21.27	12.00 LT.
21	4+44.60	12.00 RT.
21A	4+47.68	12.00 LT.
22	4+75.43	12.00 LT.
23	4+85.17	12.00 RT.
24	5+10.46	12.00 LT.
25	5+75.78	12.00 LT.
26	6+25.11	12.00 RT.
27	6+25.80	12.00 LT.
28	6+35.24	24.00 RT.
29	7+16.81	12.00 LT.
30	7+16.81	24.00 RT.
31	7+25.34	24.00 RT.
32	7+24.40	12.00 LT.
33	7+37.40	12.00 RT.
34	7+47.40	30.00 LT.

POINT DATA BASELINE 'D'		
POINT NO.	STATION / NORTH	OFFSET / EAST
300	300+16.78	11.00 LT.
301	300+18.87	11.00 RT.
302	300+22.42	11.00 LT.
303	300+24.42	24.00 LT.
304	300+24.42	13.00 LT.
305	300+31.43	11.00 RT.
306	300+33.43	24.00 RT.
307	300+33.43	13.00 RT.
308	301+68.42	24.00 RT.
309	301+68.42	24.00 LT.
310	301+68.42	16.00 LT.
311	301+68.42	16.00 RT.
312	301+78.42	16.00 RT.
313	301+78.42	16.00 LT.

NOTE: ALL STATION OFFSETS SHOWN ARE FROM FACE OF CURB

POINT DATA BASELINE 'E'		
POINT NO.	STATION / NORTH	OFFSET / EAST
400	400+11.31	14.00 LT.
401	400+11.31	24.00 LT.
402	400+41.14	11.00 RT.
403	400+73.31	11.00 RT.
404	400+73.31	13.00 RT.
405	400+73.31	24.00 RT.
406	400+83.31	35.67 RT.
407	400+83.31	50.00 RT.
408	400+83.31	35.67 RT.
409	401+37.31	24.67 RT.
410	401+37.31	24.00 LT.
411	401+37.31	16.00 LT.
412	401+37.31	16.00 RT.
413	401+37.48	35.67 RT.
414	401+47.31	16.00 LT.
415	401+47.31	16.00 RT.

NOTE: ALL STATION OFFSETS SHOWN ARE FROM FACE OF CURB

POINT DATA BASELINE 'F'		
POINT NO.	STATION / NORTH	OFFSET / EAST
500	500+00	21.33 LT.
501	500+11	18.00 RT.
502	500+15	6.00 LT.
503	500+88.85	18.00 RT.
504	500+47.72	6.43 RT.
505	501+01.58	6.06 RT.
506	501+02.84	6.00 LT.
507	501+13.38	6.00 LT.
508	501+13.22	10.32 LT.
509	501+35.12	6.00 RT.

NOTE: ALL STATION OFFSETS SHOWN ARE FROM FACE OF CURB

POINT DATA BASELINE 'B'		
POINT NO.	STATION / NORTH	OFFSET / EAST
100	100+04.64	11.00 RT.
101	100+10.43	11.00 RT.
102	100+12.43	24.00 RT.
103	100+12.43	13.00 RT.
104	100+35.42	11.00 LT.
105	100+46.44	11.00 LT.
106	100+48.44	24.00 LT.
107	100+48.44	13.00 LT.
108	101+24.43	24.00 RT.
109	101+24.43	24.00 LT.
110	101+24.43	16.00 RT.
111	101+24.43	16.00 RT.
112	101+34.43	16.00 RT.
113	101+34.43	16.00 LT.




NOTE: ALL STATION OFFSETS SHOWN ARE FROM FACE OF CURB

POINT DATA BASELINE 'C'		
POINT NO.	STATION / NORTH	OFFSET / EAST
200	200+14.74	11.00 RT.
201	200+19.18	11.00 RT.
202	200+21.18	24.00 RT.
203	200+21.18	13.00 RT.
204	200+21.30	11.00 LT.
205	200+28.17	11.00 LT.
206	200+30.17	24.00 LT.
207	200+30.17	13.00 RT.
208	201+65.17	24.00 RT.
209	201+65.17	24.00 LT.
210	201+65.17	16.00 LT.
211	201+65.17	16.00 RT.
212	201+75.17	16.00 RT.
213	201+75.17	16.00 LT.

NOTE: ALL STATION OFFSETS SHOWN ARE FROM FACE OF CURB

POINT DATA 'BUILDING'		
POINT NO.	STATION / NORTH	OFFSET / EAST
600	-18,103.48	-5.62
601	-17,944.32	-14.50

NOTE: ALL POINTS SHOWN ARE FROM FINISH FACE OF BUILDING

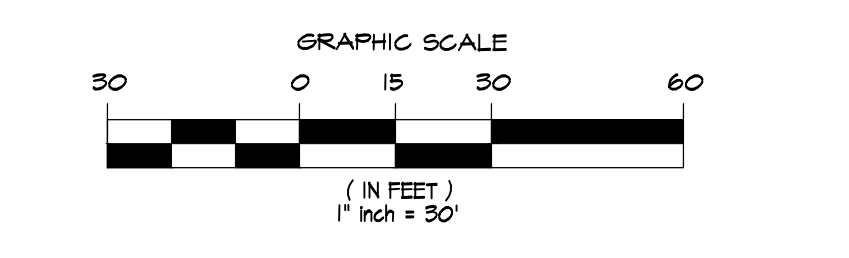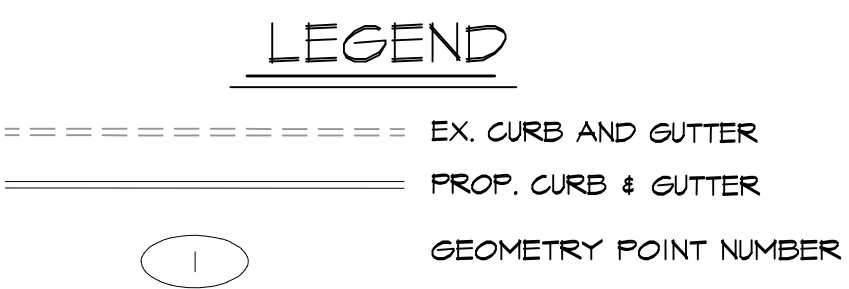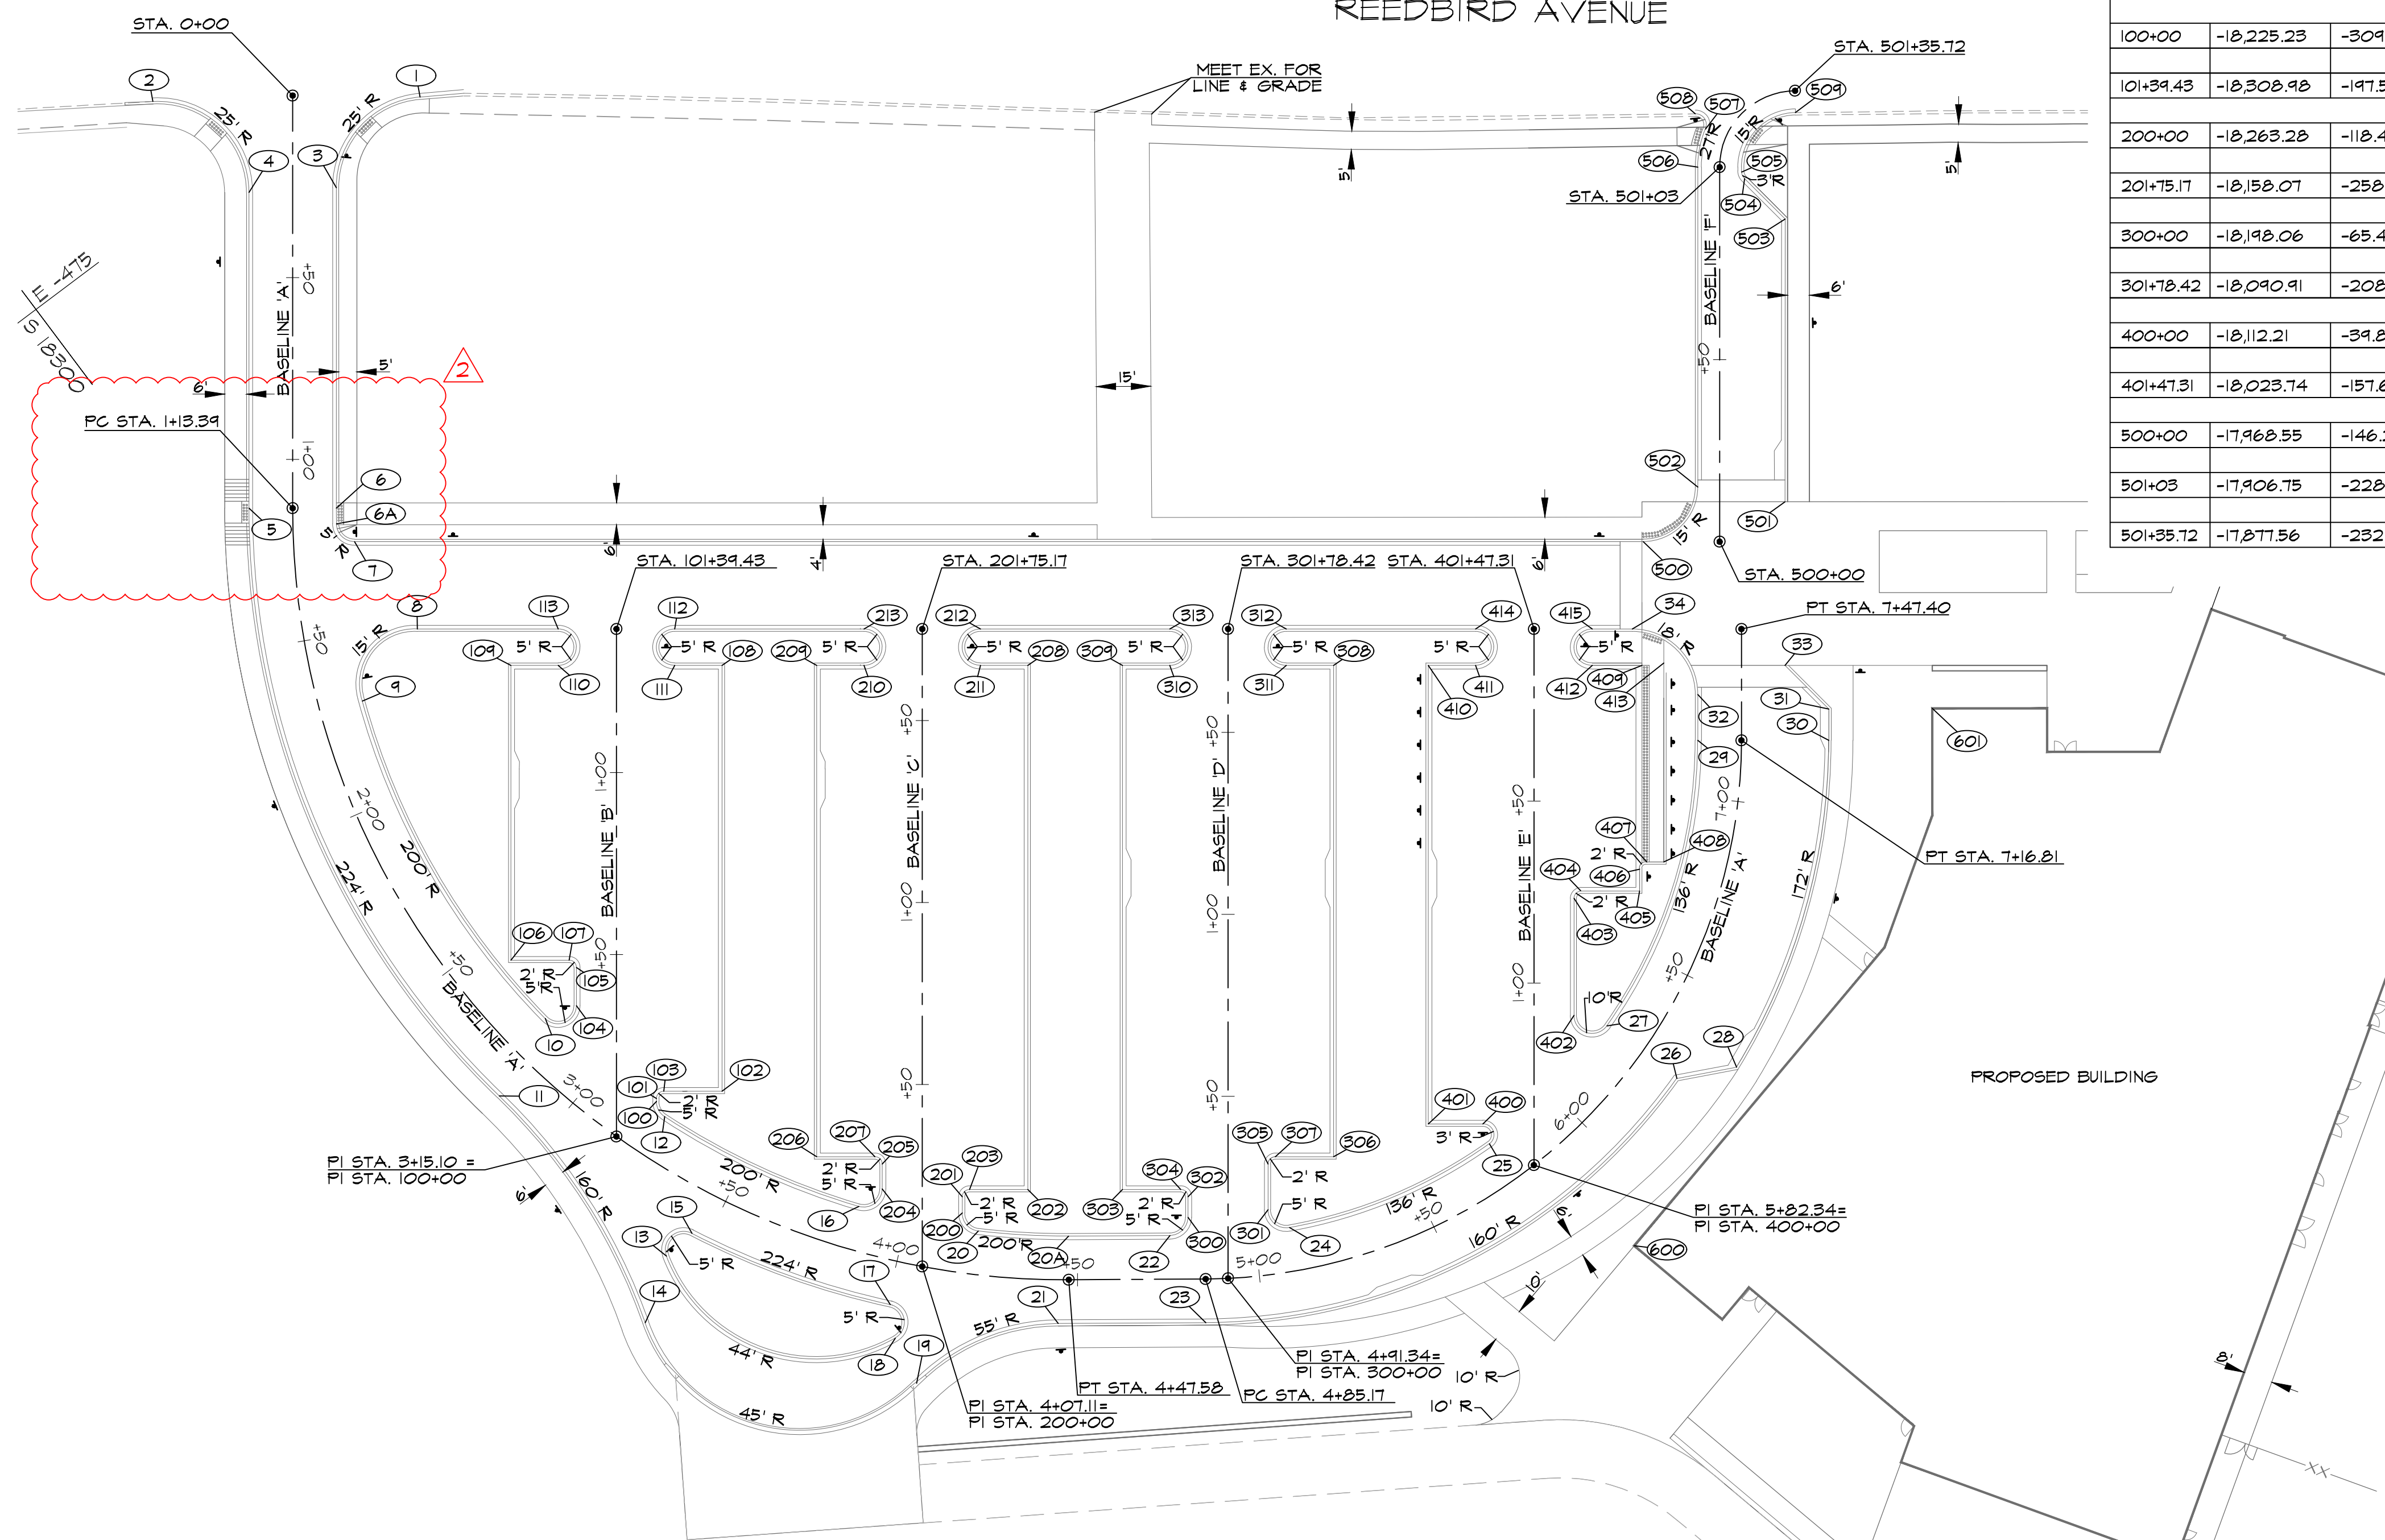

LAYOUT (STAKEOUT) GENERAL NOTES


- THE CONTRACTOR SHALL IMMEDIATELY NOTIFY THE ENGINEER IF THERE ARE ANY DIMENSIONAL DISCREPANCY BETWEEN THE PLANS AND ACTUAL FIELD CONDITIONS. ALSO, SEE CONSTRUCTION DETAILS AND GRADING PLAN FOR EACH INDIVIDUAL PLAZA, PARKING LOT, ATHLETIC COURT, STEP, ENTRY WALK, AND RAMP FOR FURTHER DIMENSIONAL LAYOUT INFORMATION.
- NEW WORK SHALL MEET AND MATCH EXISTING ALIGNMENTS OF FEATURES AND FINISHED GRADES AT LIMITS OF WORK. ADJUST HEIGHTS OF EXISTING MANHOLES AND SURFACE UTILITY COVERS TO MEET FLUSH WITH PROPOSED WALKS. THE CONTRACTOR SHALL FIELD VERIFY EXISTING DIMENSIONS AND IMMEDIATELY REPORT DISCREPANCIES TO ENGINEER TO MAKE NECESSARY ADJUSTMENTS BEFORE COMMENCING WITH WORK.
- FOR LAYOUT, ALL ANGLES ARE 90 DEGREES UNLESS OTHERWISE NOTED.
- THE CONTRACTOR SHALL STAKE THE LAYOUT AND ELEVATIONS OF ALL SITE FEATURES INCLUDING WALLS, WALKS, GATES, SIGNS, SWINGS AND OUTDOOR FITNESS EQUIPMENT.
- DIMENSIONS ARE SHOWN FROM THE FRONT FACE OF CURBS, WALLS AND STEPS UNLESS OTHERWISE SPECIFIED ON THE LAYOUT (STAKE OUT) PLAN OR CONSTRUCTION DETAILS. PAVEMENTS ARE DIMENSIONED FROM EDGE TO EDGE OF PAVEMENT.
- PAVEMENT RADII ARE 5 FEET UNLESS OTHERWISE DIMENSIONED ON THE LAYOUT PLAN.
- FOR ADDITIONAL LAYOUT INFORMATION, DIMENSIONAL SIZES AND MATERIALS, SEE THE GRADING PLAN ON SHEET C4.00-C4.06 AND CONSTRUCTION DETAILS ON SHEET C3.00-C3.01.

GEOMETRY PLAN
SCALE: 1"=30'

KEY PLAN

KEYNOTES LISTED ON THIS SHEET ARE FOR CONVENIENCE ONLY. REFER TO SHEET C3.3 FOR COMPLETE LIST

ISSUED FOR BID

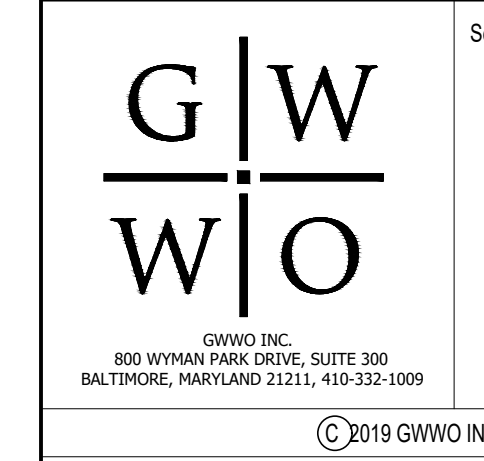

CERTIFY THAT THESE DOCUMENTS WERE PREPARED OR APPROVED BY ME, AND THAT I AM A DULY LICENSED ENGINEER UNDER THE LAWS OF THE STATE OF MARYLAND. LICENSE NUMBER: 25058, EXPIRATION DATE: 11/17/20

Revisions	No.	Date	Description
	2	1/28/20	Addendum #2

MIDDLE BRANCH FITNESS & WELLNESS CENTER AT CHERRY HILL
BALTIMORE CITY RECREATION & PARKS

Jcb No.	18010	Author	SG
Scale	1"=30'	Checker	AP
Date	1/28/2019	Approver	SM
Drawing Title	Drawing Number		

GEOMETRY PLAN **C7.00r2**

BENCHMARK DATA

ALL HORIZONTAL AND VERTICAL SURVEY DATA CONTAINED HEREIN ARE REFERENCED TO THE CITY OF BALTIMORE COORDINATE SYSTEM, AS DERIVED FROM THE FOLLOWING BENCHMARKS FROM THE PLAN ENTITLED 'REEDBIRD TOPO' DATED APRIL 2018, BY NAVARRO & WRIGHT

POINT#	NORTHING	EASTING	DESCRIPTION
1	-17900.95	-34.48	REBAR AND CAP
2	18007.42	150.90	REBAR AND CAP

STORM DRAIN STRUCTURE SCHEDULE

NO.	DESCRIPTION	REMARKS	COORDINATES	
			NORTHING	EASTING
MH-1	NOT USED			
MH-2	24" PRECAST MANHOLE	BC STD BC 383.07	-18478.25	517.95
MH-3	60" PRECAST MANHOLE	BC STD BC 383.05	-18405.82	598.75
MH-4	60" PRECAST MANHOLE	BC STD BC 383.05	-18392.08	585.41
MH-5	48" PRECAST MANHOLE	BC STD BC 383.04	-18342.47	226.94
MH-6	48" PRECAST MANHOLE	BC STD BC 383.04	-18322.47	54.40
MH-7	48" PRECAST MANHOLE	BC STD BC 383.04	-18311.12	-27.16
MH-8	48" PRECAST MANHOLE	BC STD BC 383.04	-18261.75	-11.45
MH-9	48" PRECAST MANHOLE	BC STD BC 383.04	-18344.66	-185.04
MH-10	60" PRECAST MANHOLE	BC STD BC 383.05	-18371.47	403.52
MH-11	72" PRECAST MANHOLE	BC STD BC 383.06	-18358.47	-34.04
MH-12	48" PRECAST MANHOLE	BC STD BC 383.04	-18051.63	-46.82
MH-13	48" PRECAST MANHOLE	BC STD BC 383.04	-18014.43	175.14
MH-14	48" PRECAST MANHOLE	BC STD BC 383.04	-18248.58	457.74
MH-15	48" PRECAST MANHOLE	BC STD BC 383.04	-18354.58	414.94
MH-16	48" PRECAST MANHOLE	BC STD BC 383.04	-18376.35	-146.81
I-1A	TYPE I COMB. INLET W/ DIVERSION	SEE DETAIL SHEET C11.08	-18300.43	-321.70
I-2	TYPE E COMB. INLET	BC STD BC 376.24	-18271.81	-241.97
I-3	TYPE E COMB. INLET	BC STD BC 376.24	-18205.63	-242.33
I-4	48" DIA. MH W/ BEEHIVE GRATE	SEE DETAIL SHEET C11.08	-18393.28	352.49
I-5	48" DIA. MH W/ BEEHIVE GRATE	SEE DETAIL SHEET C11.08	-18219.83	217.92
I-6	72" DIA. MH W/ BEEHIVE GRATE	SEE DETAIL SHEET C11.08	-18224.81	217.92
I-7	48" DIA. MH W/ BEEHIVE GRATE	SEE DETAIL SHEET C11.08	-18170.21	150.36
I-8	TYPE E COMB. INLET	BC STD BC 376.24	-18001.58	-118.53
I-9	TYPE E COMB. INLET	BC STD BC 376.24	-18024.47	-156.12
I-10	TYPE E COMB. INLET	BC STD BC 376.24	-18034.46	-170.68
I-11	TYPE E COMB. INLET	BC STD BC 376.24	-18048.29	-201.14
I-12	TYPE E COMB. INLET	BC STD BC 376.24	-17975.20	-84.42
I-13	STANDARD YARD INLET	SHA STD MD 381.01	-17920.24	-102.74
I-14	STANDARD YARD INLET	SHA STD MD 381.01	-17884.15	-71.24
I-15	TYPE E COMB. INLET	BC STD BC 376.24	-17934.31	-144.84
I-16	TYPE E COMB. INLET	BC STD BC 376.24	-18064.46	-36.25
I-17	STANDARD YARD INLET	SHA STD MD 381.01	-18000.38	226.07
I-18	STANDARD YARD INLET	SHA STD MD 381.01	-17902.44	134.16
I-19	STANDARD YARD INLET	SHA STD MD 381.01	-17871.42	41.46
I-20	STANDARD YARD INLET	SHA STD MD 381.01	-17855.35	235.50
I-21	48" DIA. MH W/ BEEHIVE GRATE	DETAIL SHEET C11.08	-18407.8	556.04
I-22	48" DIA. MH W/ BEEHIVE GRATE	DETAIL SHEET C11.08	-18387.00	381.74
I-23	48" DIA. MH W/ BEEHIVE GRATE	DETAIL SHEET C11.08	-18474.08	15.33
EX-1	TYPE 'C' ENDWALL	BC STD BC 384.02	-18524.78	614.26
EX-2	TYPE 'C' ENDWALL	BC STD BC 384.02	-18555.30	-327.45
EX-3	TYPE 'C' ENDWALL	BC STD BC 384.02	-18570.31	525.17
EX-4	TYPE 'C' ENDWALL	BC STD BC 384.02	-18621.28	446.24
EX-5	TYPE 'C' ENDWALL	BC STD BC 384.02	-17806.77	30.52
TD-1	POLYDRAIN PDX	SEE DETAIL SHEET C11.08	-18042.62	276.32


SANITARY SEWER STRUCTURE SCHEDULE

NO.	DESCRIPTION	REMARKS	COORDINATES	
			NORTHING	EASTING
SMH-1	TYPE-B DROP CONNECTION	BC STD BC 381.04	-17824.00	-124.31
SMH-2	PRECAST 48" MANHOLE	BC STD BC 381.04	-17767.92	5.54
SMH-3	PRECAST 48" MANHOLE	BC STD BC 381.04	-18050.32	188.52


LEGEND

- 20 --- EX. INDEX CONTOUR
- 21 --- EX. INTERMEDIATE CONTOUR
- PROPERTY LINE
- EX. CURB AND GUTTER
- EX. 12" S.D. --- EX. STORM DRAIN
- EX. 8" SAN. --- EX. SANITARY SEWER
- EX. 6" W --- EX. WATER
- EX. GAS --- EX. GAS
- EX. UNDERGROUND ELEC. --- EX. UNDERGROUND ELECTRIC
- EX. OVERHEAD ELEC. --- EX. OVERHEAD ELECTRIC
- EX. FENCE
- EX. MANHOLE
- EX. INLET
- EX. TREE
- EX. WOODS LINE
- LOD --- LIMIT OF DISTURBANCE
- PROP. ELECTRICAL CONDUIT
- 20 --- PROP. INDEX CONTOURS
- 21 --- PROP. INTERMEDIATE CONTOURS
- PROP. 18" DRAIN --- PROP. STORM DRAIN
- PROP. MANHOLE
- PROP. INLET

NOTE:
SEE SHEET C8.01 FOR UTILITY NOTES

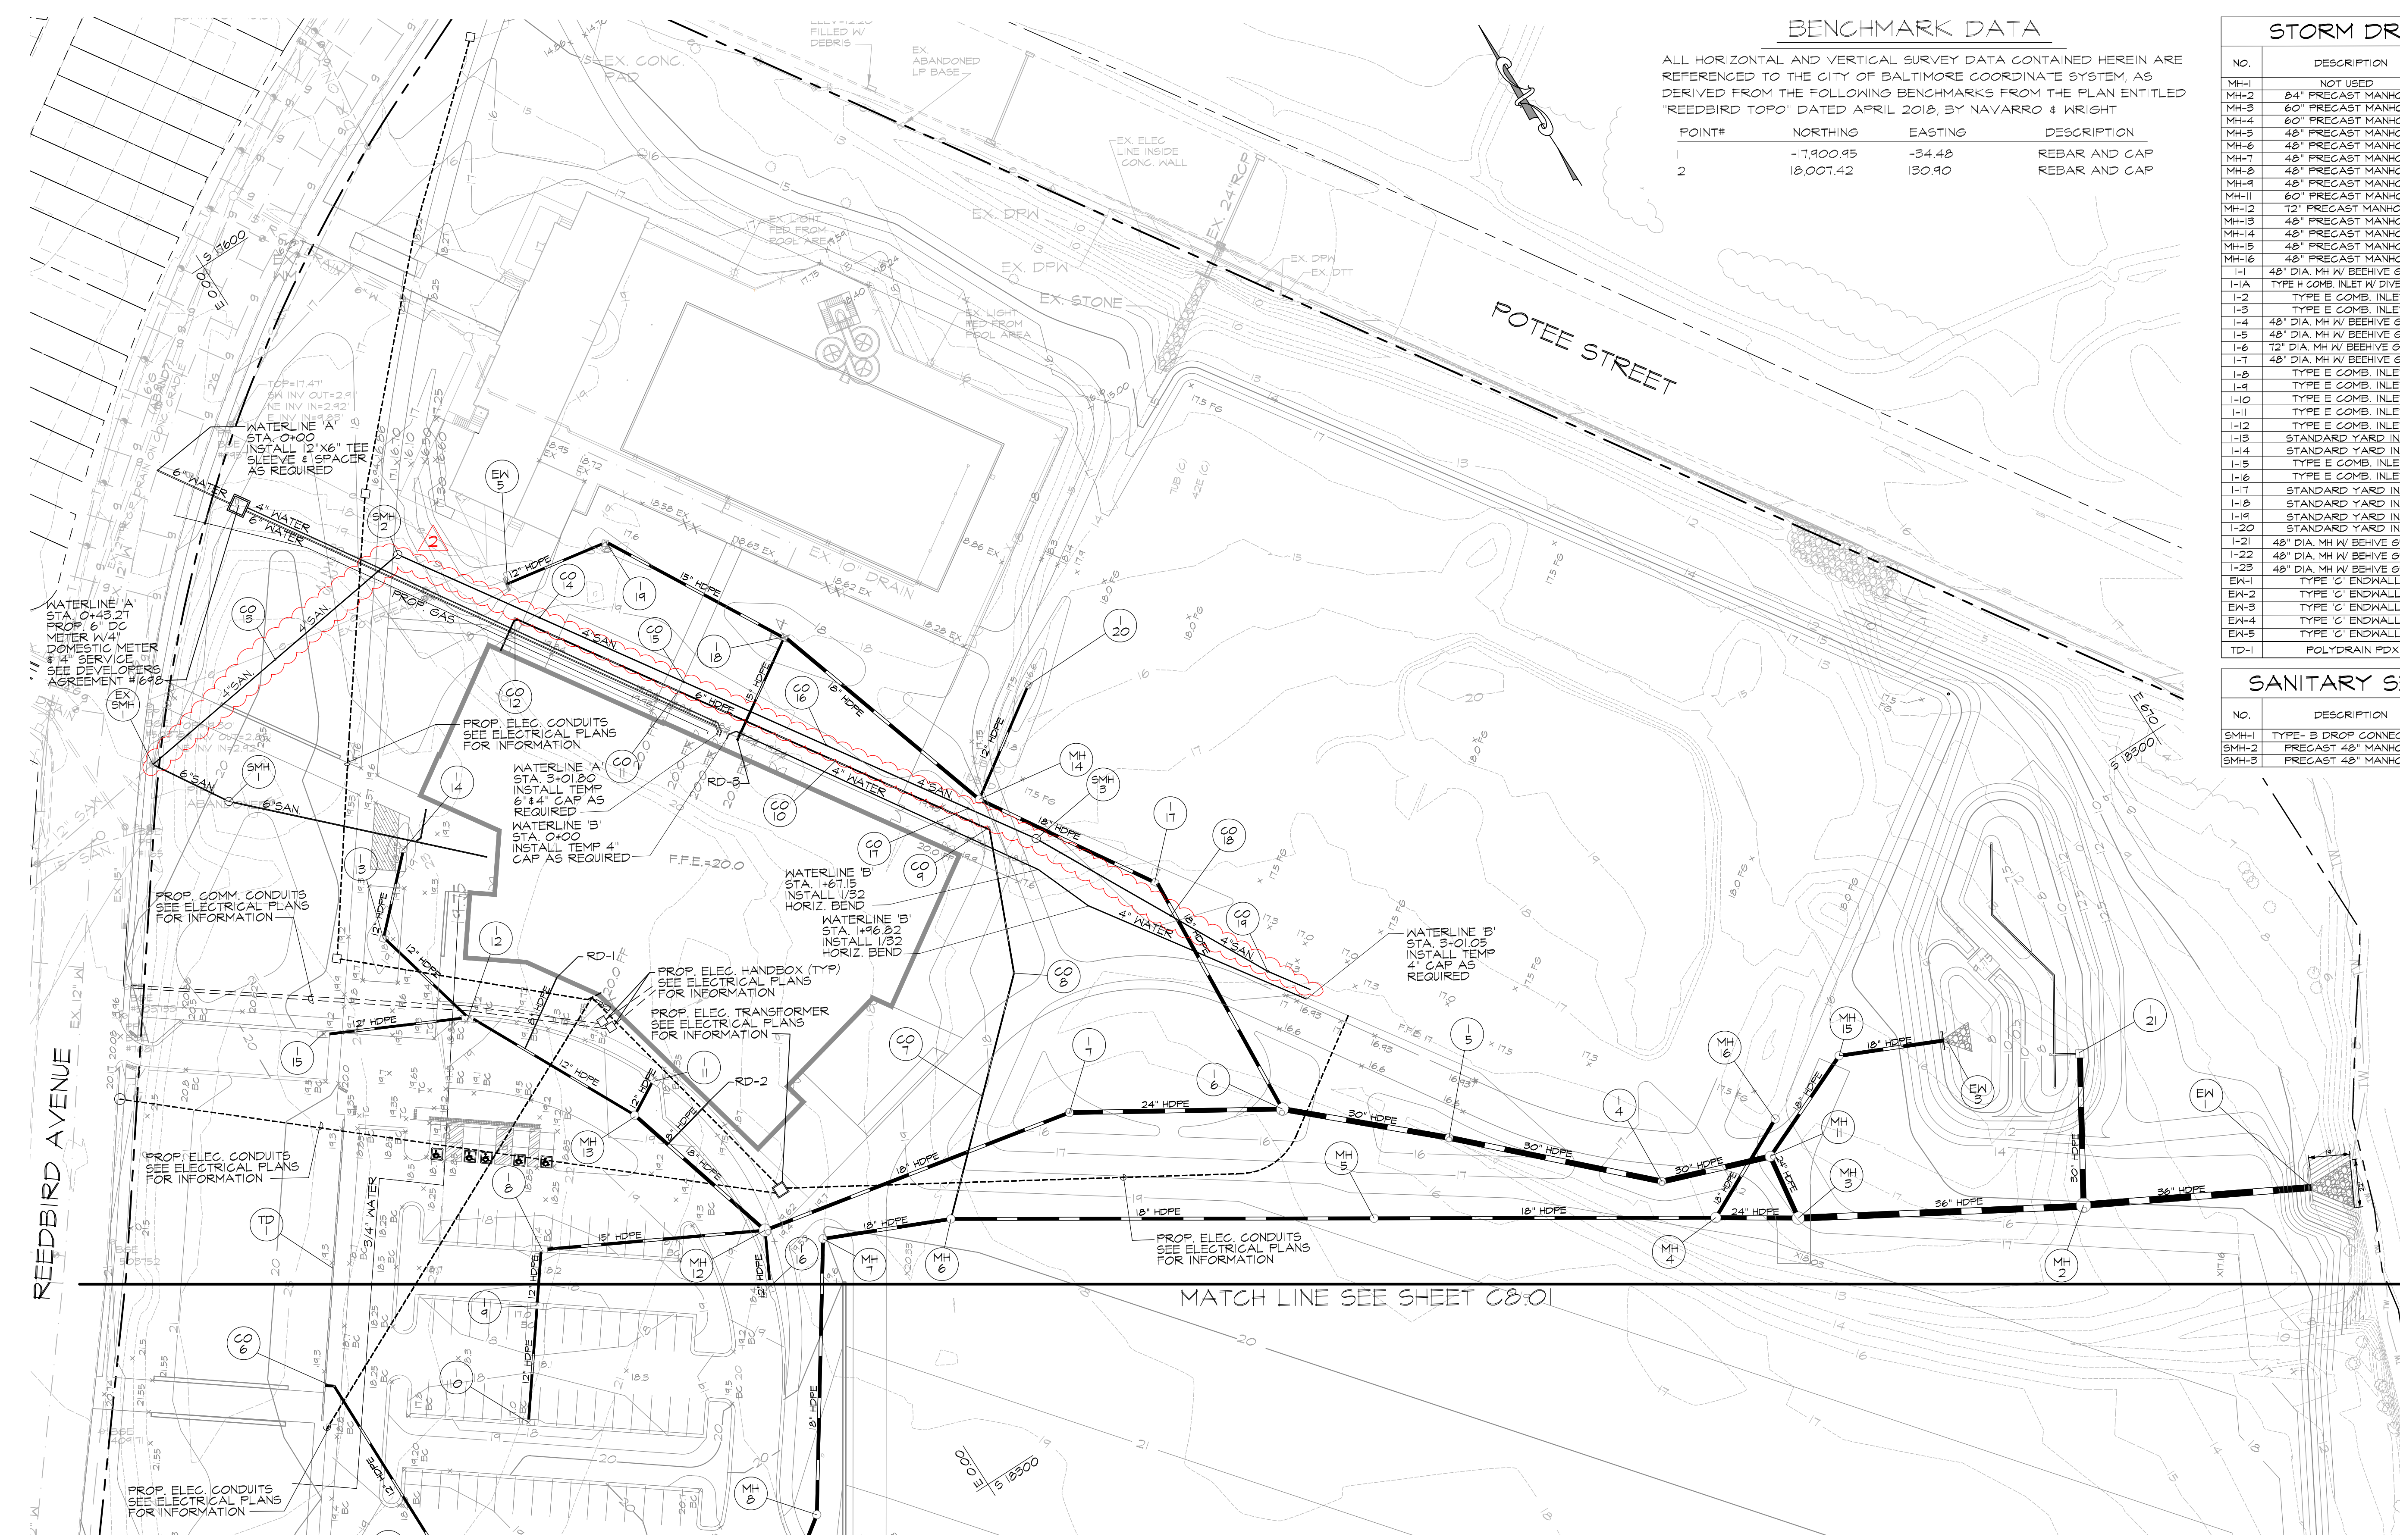

UTILITY PLAN
SCALE: 1"=40'

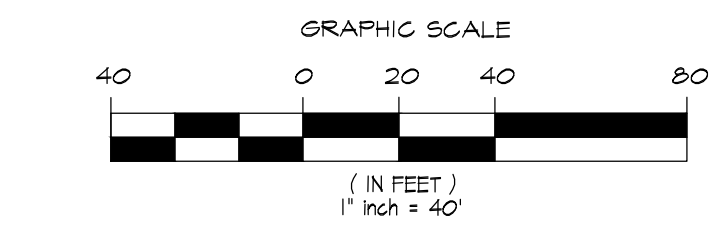

KEY PLAN

KEYNOTES LISTED ON THIS SHEET ARE FOR CONVENIENCE ONLY. REFER TO SHEET CS.3 FOR COMPLETE LIST

ISSUED FOR BID

mk
Consulting Engineers, LLC
Whitell Hill
3300 Clipper Mill Road, Suite 201
Baltimore, MD 21211
667-308-6183

G|W|O
GWVO INC.
800 WYMAN PARK DRIVE, SUITE 300
BALTIMORE, MARYLAND 21211, 410-332-0209
© 2019 GWVO INC.


CERTIFY THAT THESE DOCUMENTS WERE PREPARED OR APPROVED BY ME, AND THAT I AM A DULY LICENSED ENGINEER UNDER THE LAWS OF THE STATE OF MARYLAND.
LICENSE NUMBER: 26598, EXPIRATION DATE: 11/17/20

Revisions	No.	Date	Description
	2	1/28/20	Addendum #2

MIDDLE BRANCH FITNESS & WELLNESS CENTER AT CHERRY HILL
BALTIMORE CITY RECREATION & PARKS


Job No.	18010	Author	SG
Scale	1"=40'	Checker	AP
Date	1/28/2019	Approver	SM
Drawing Title	UTILITY PLAN		
Sheet	C8.00r2		

KEYNOTES LISTED ON THIS SHEET ARE FOR CONVENIENCE ONLY. REFER TO SHEET CS.3 FOR COMPLETE LIST

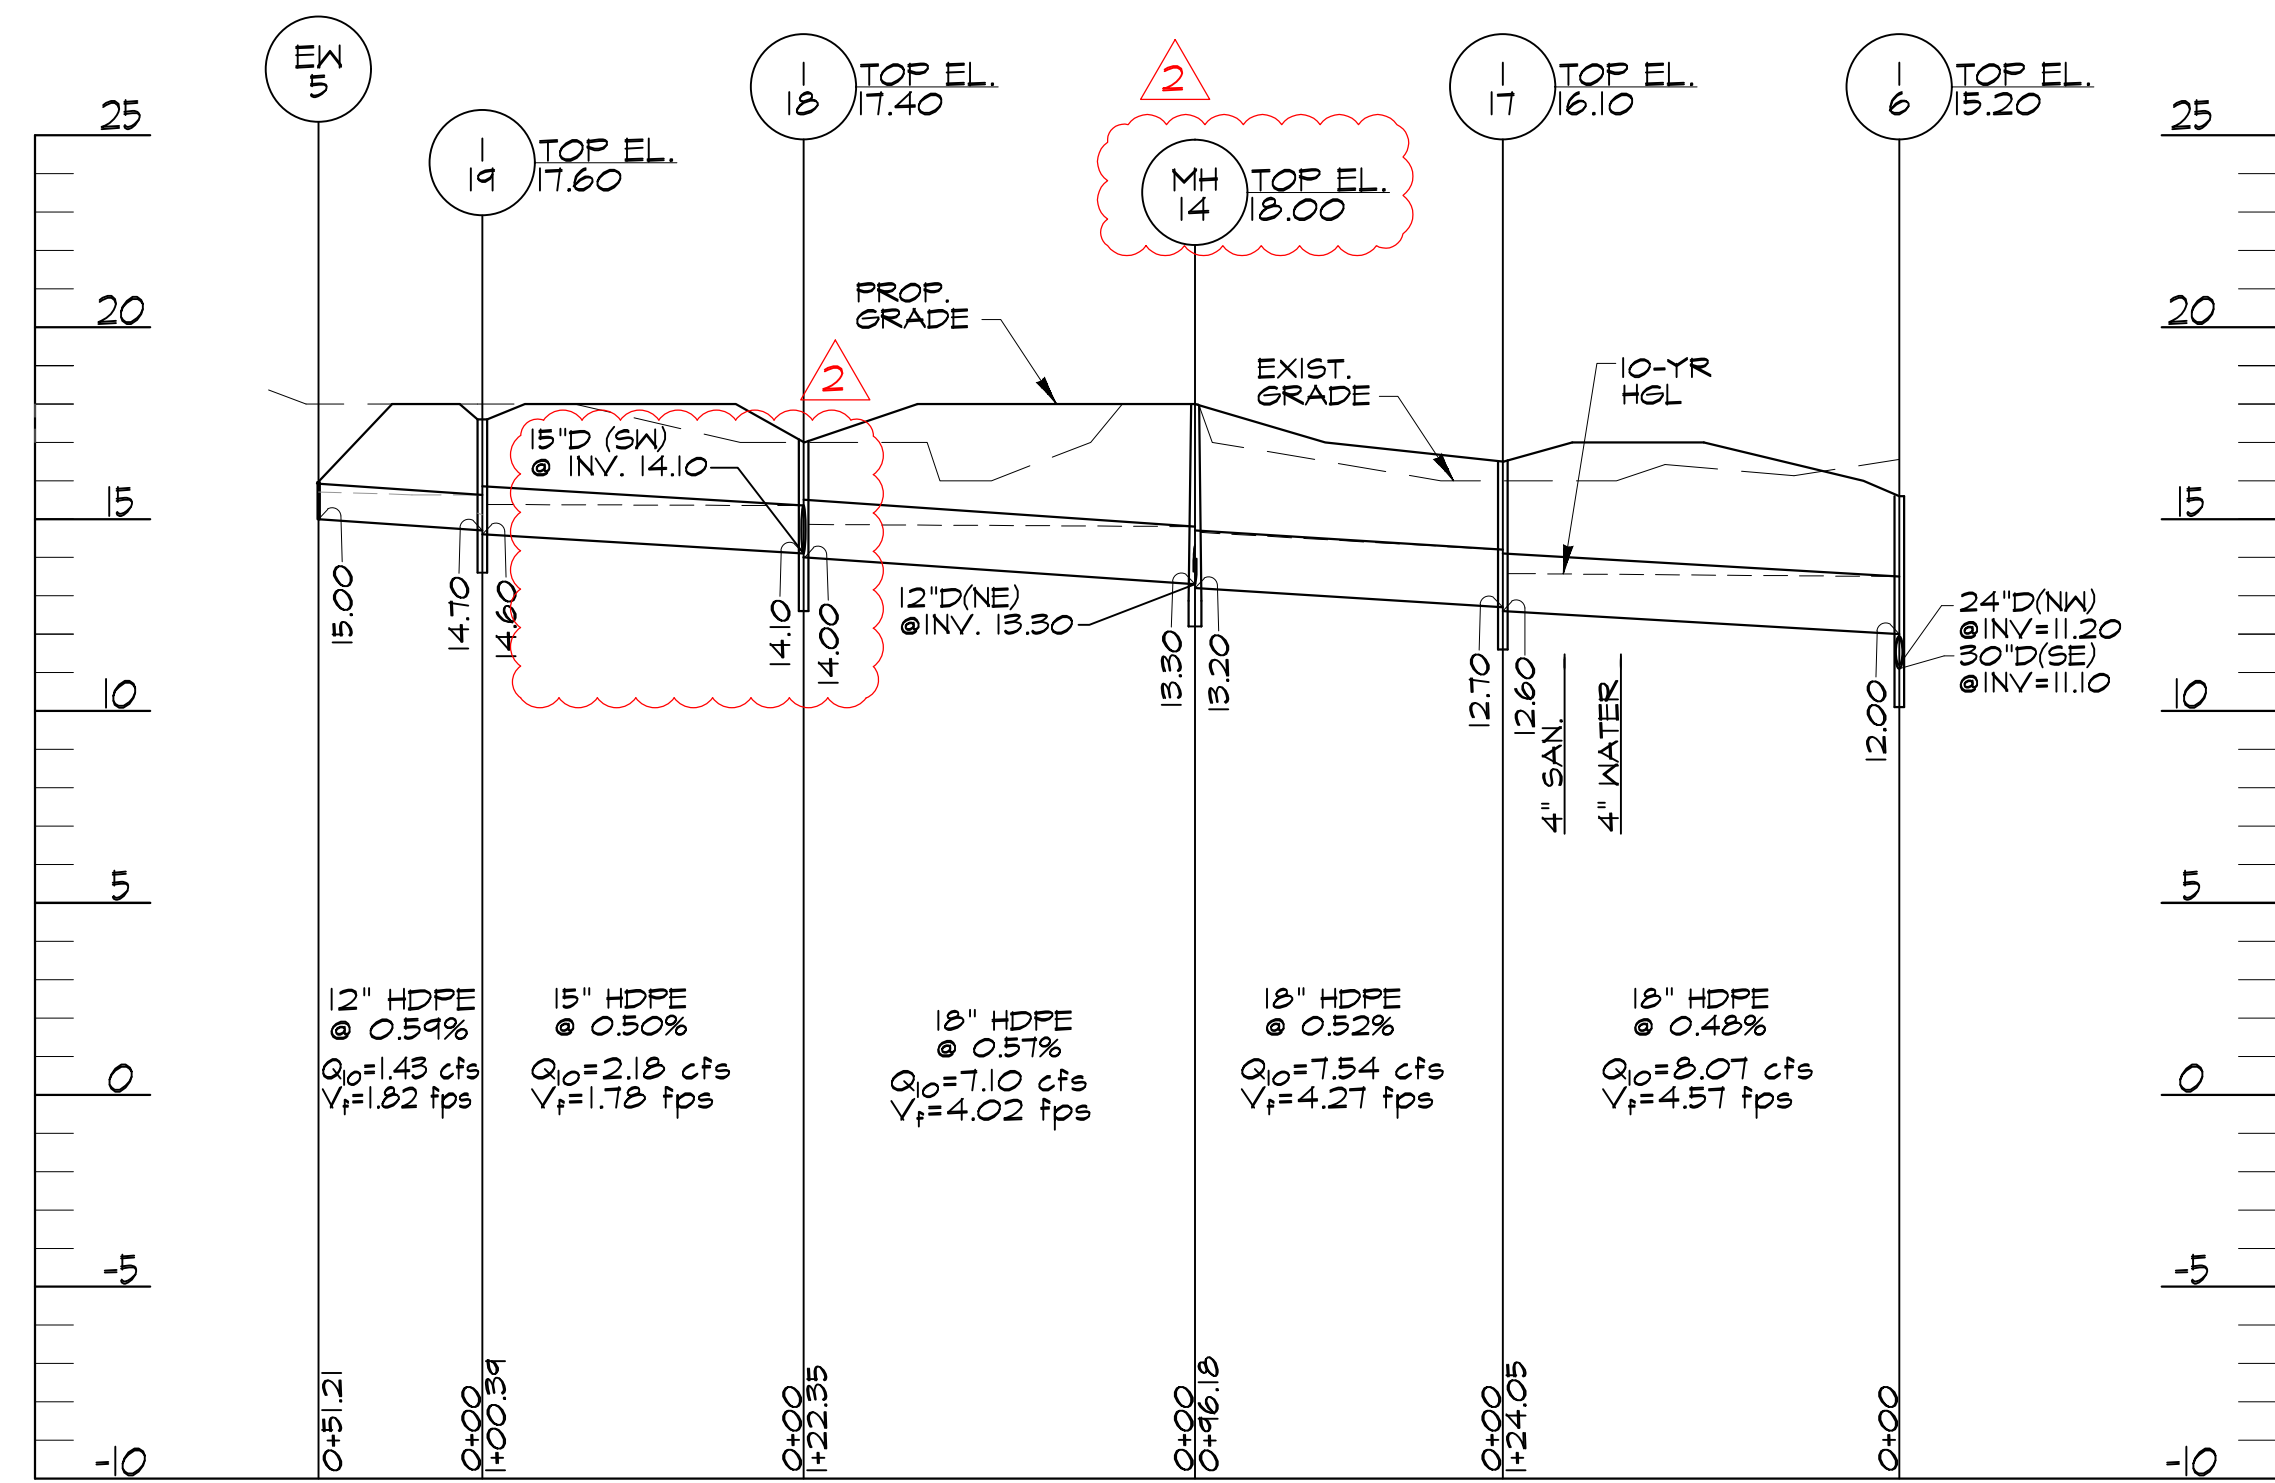


STORM DRAIN PROFILE (EW-5 TO I-6)

SCALE: HORIZ. 1"=60'
VERT. 1"=5'

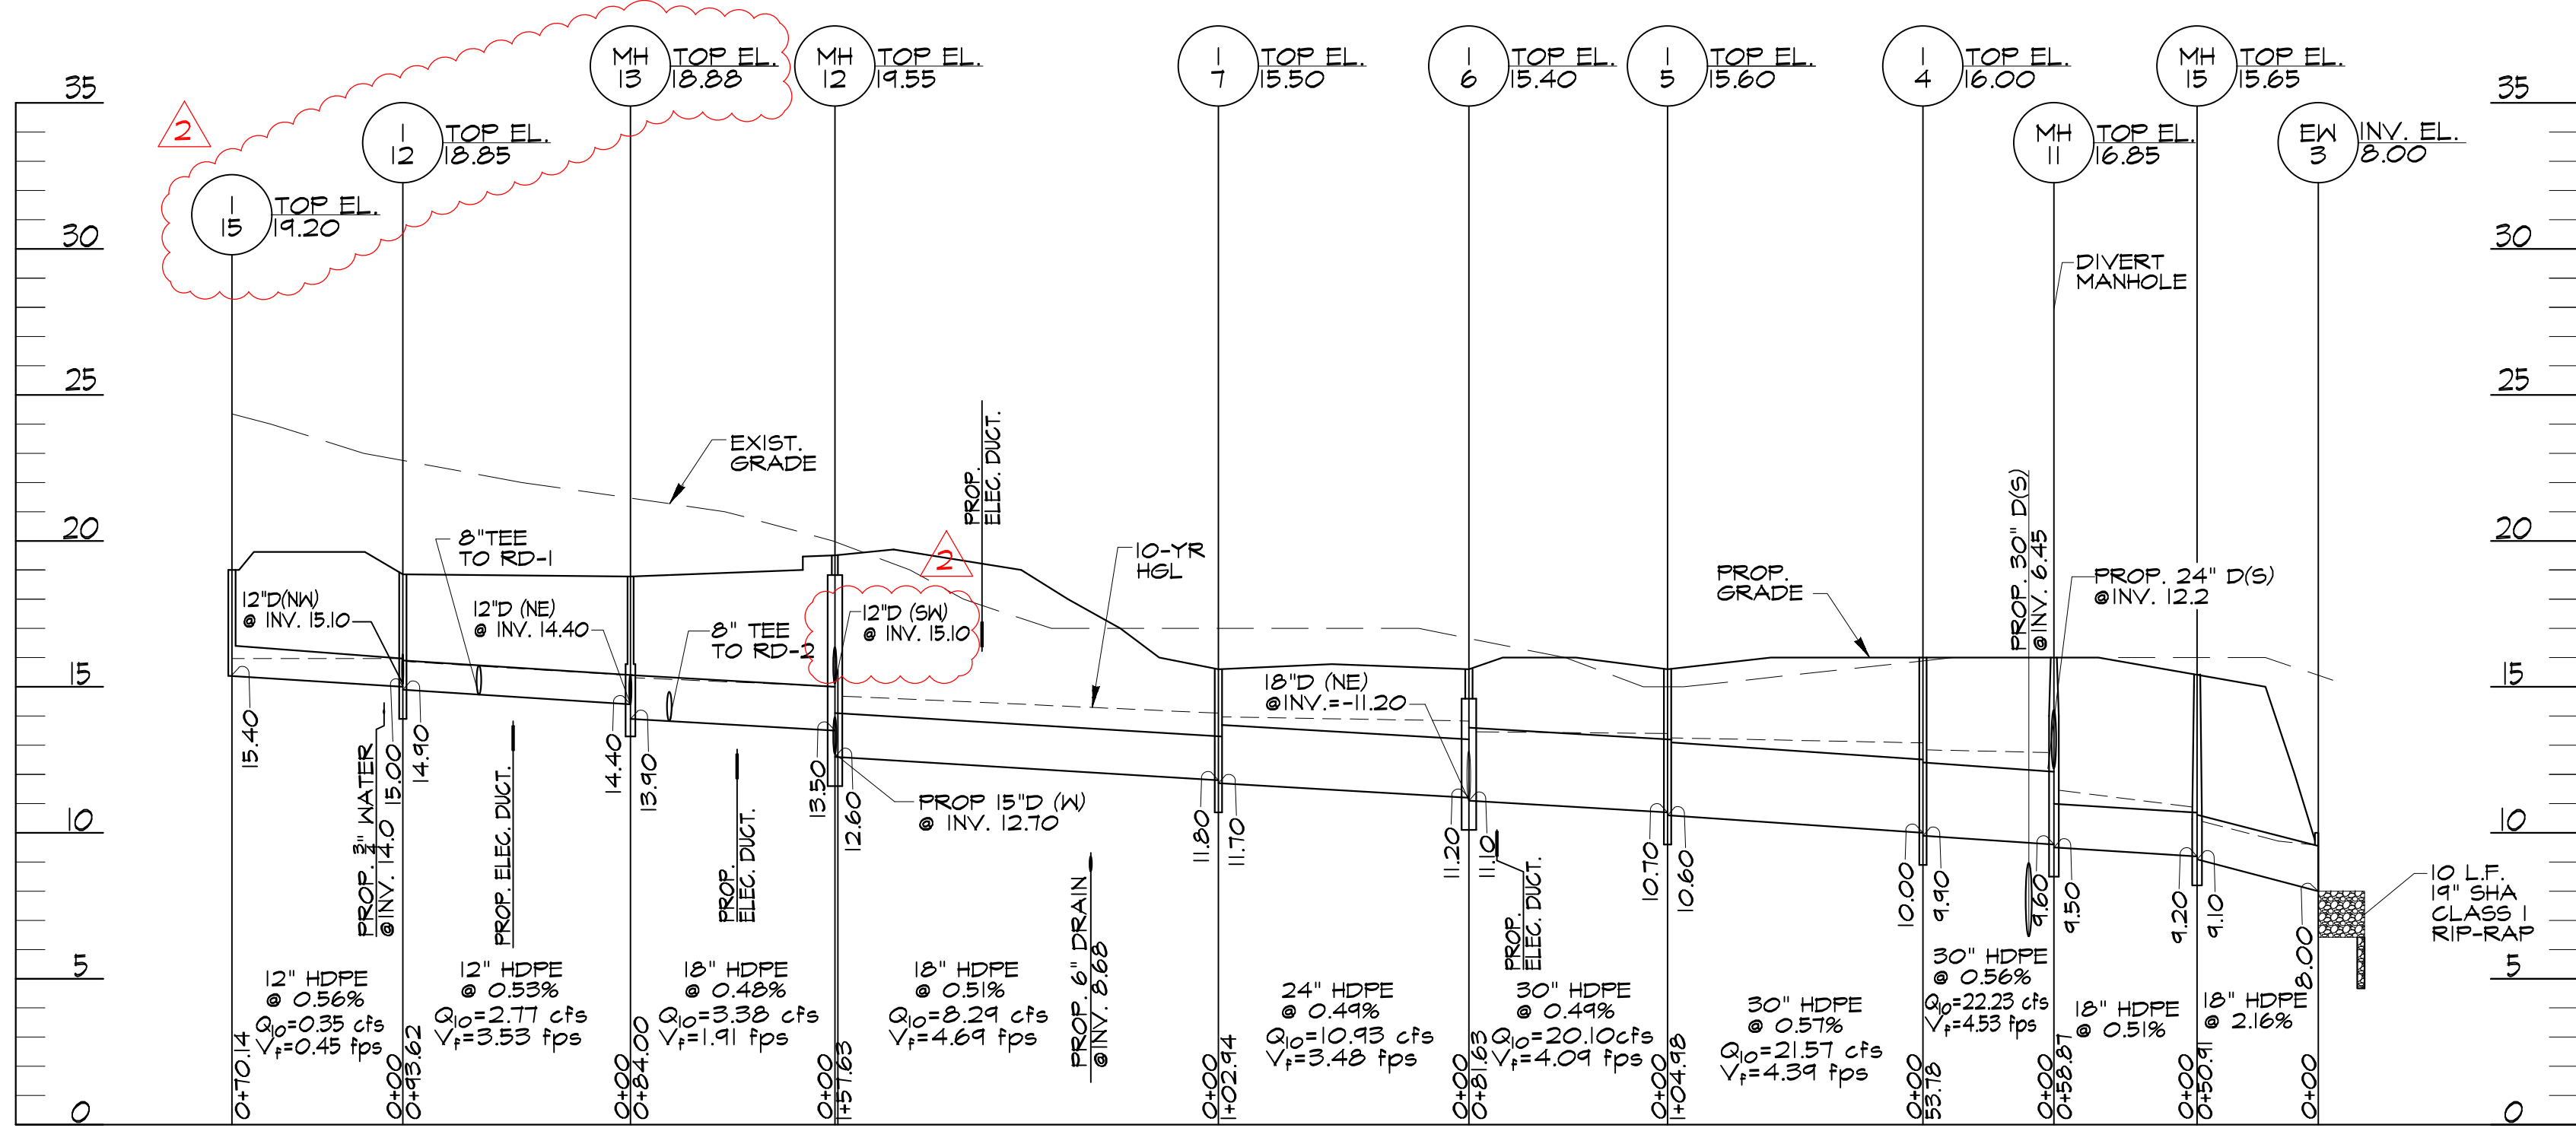


STORM DRAIN PROFILE (I-15 TO EW-3)

SCALE: HORIZ. 1"=60'
VERT. 1"=5'

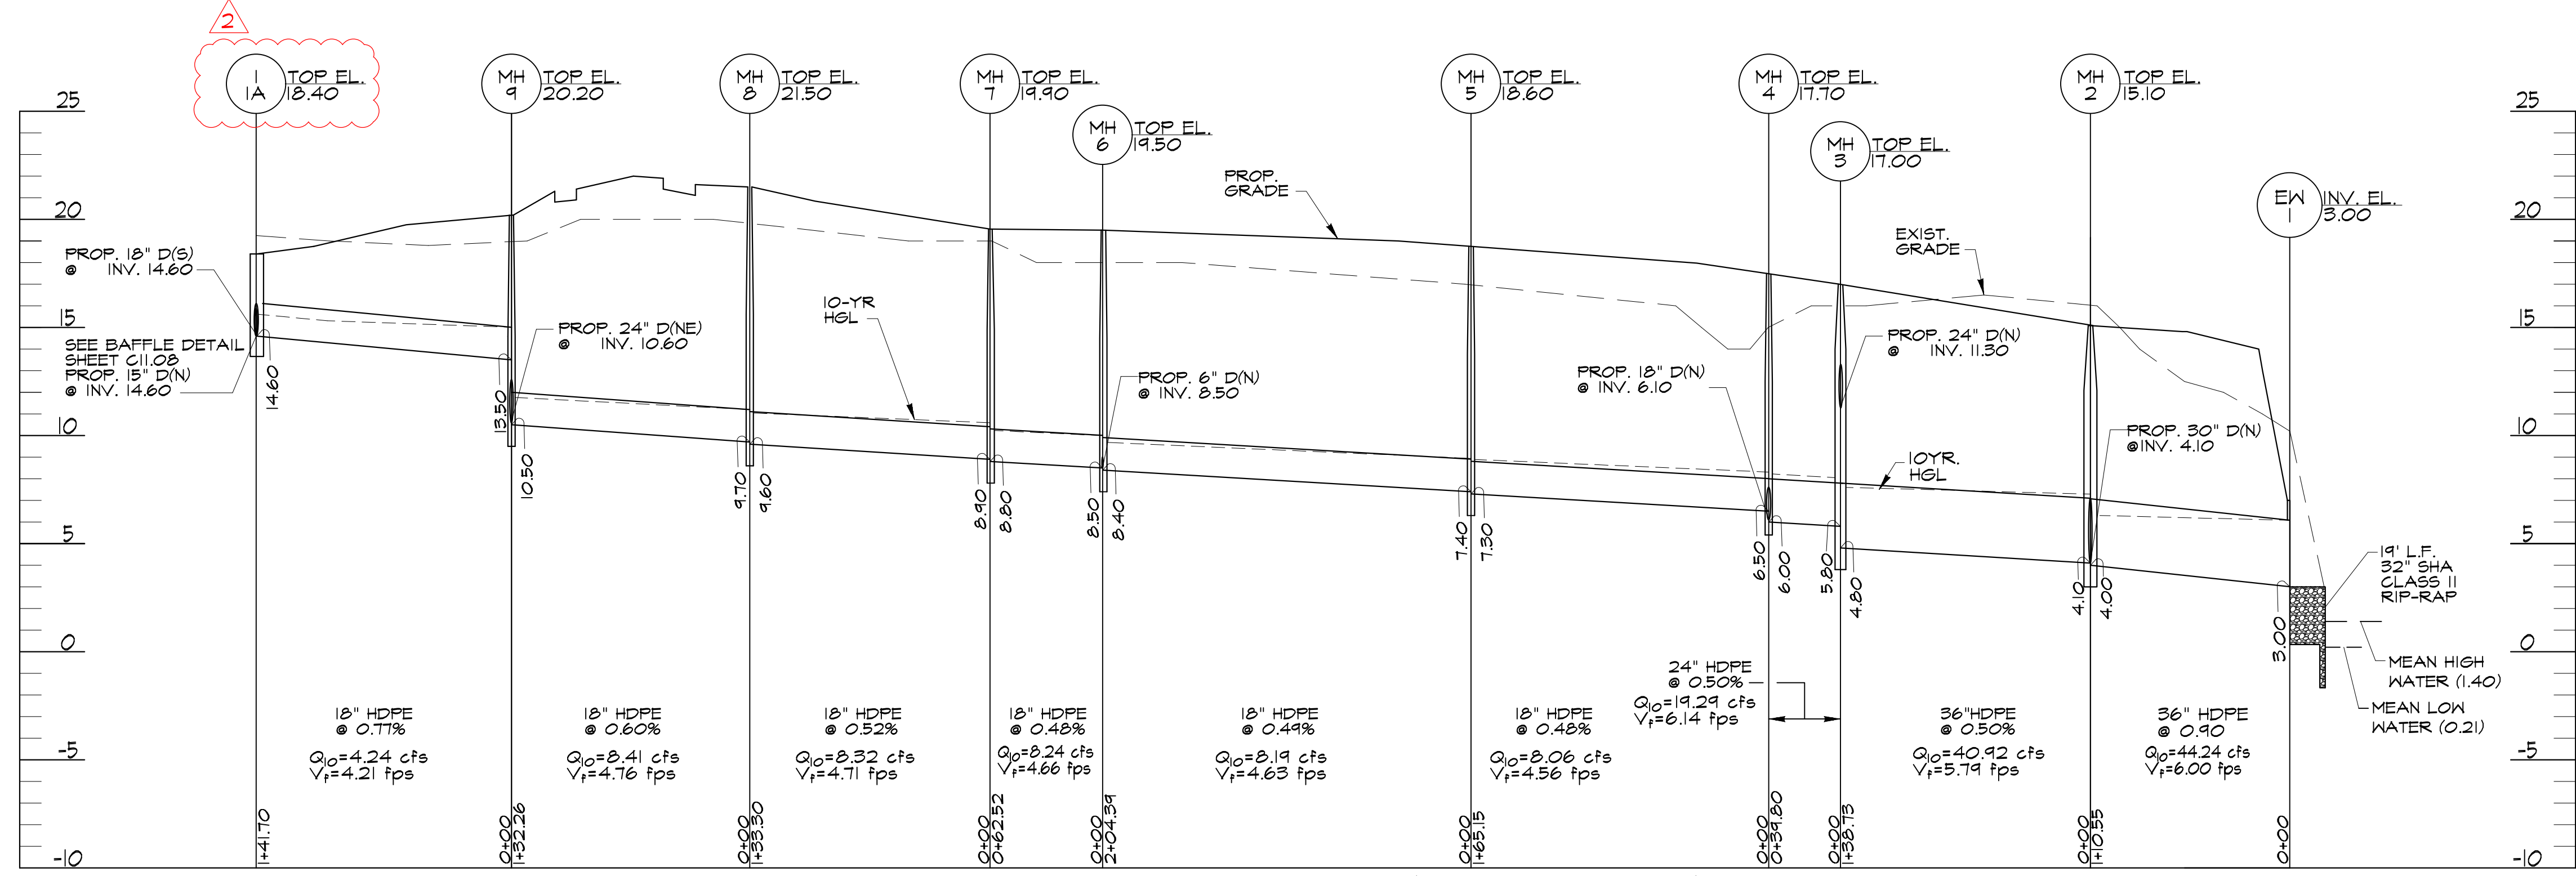

STORM DRAIN PROFILE (I-1A TO EW-1)

SCALE: HORIZ. 1"=60'
VERT. 1"=5'

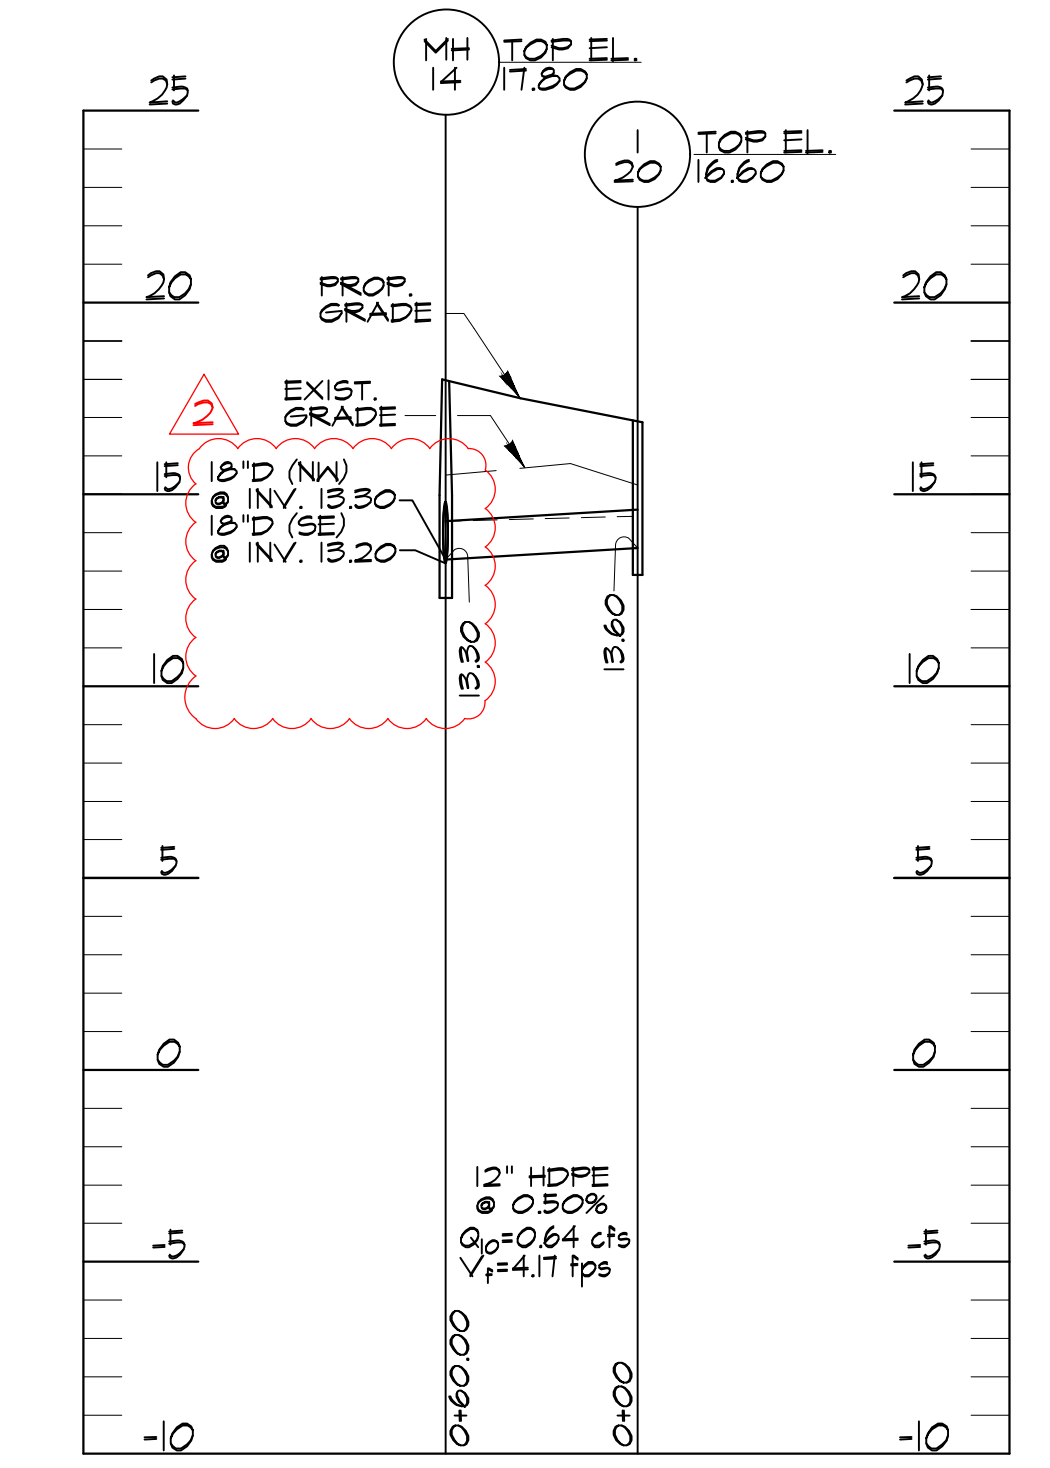

STORM DRAIN PROFILE (I-20 TO MH-14)

SCALE: HORIZ. 1"=60'
VERT. 1"=5'

ISSUED FOR BID



I CERTIFY THAT THESE DOCUMENTS WERE PREPARED OR APPROVED BY ME, AND THAT I AM A FULLY LICENSED ENGINEER UNDER THE LAWS OF THE STATE OF MARYLAND. LICENSE NUMBER: 25058, EXPIRATION DATE: 11/17/20


Revisions	No.	Date	Description
	2	1/28/20	Addendum #2

MIDDLE BRANCH FITNESS & WELLNESS CENTER AT CHERRY HILL
BALTIMORE CITY RECREATION & PARKS

Job No.	18010	Author	SG
Scale	AS SHOWN	Checker	AP
Date	1/28/2019	Approver	SM
Drawing Title	Storm Drain Profiles		


Sheet: **C8.03r2**

KEYNOTES LISTED ON THIS SHEET ARE FOR CONVENIENCE ONLY. REFER TO SHEET CS.3 FOR COMPLETE LIST

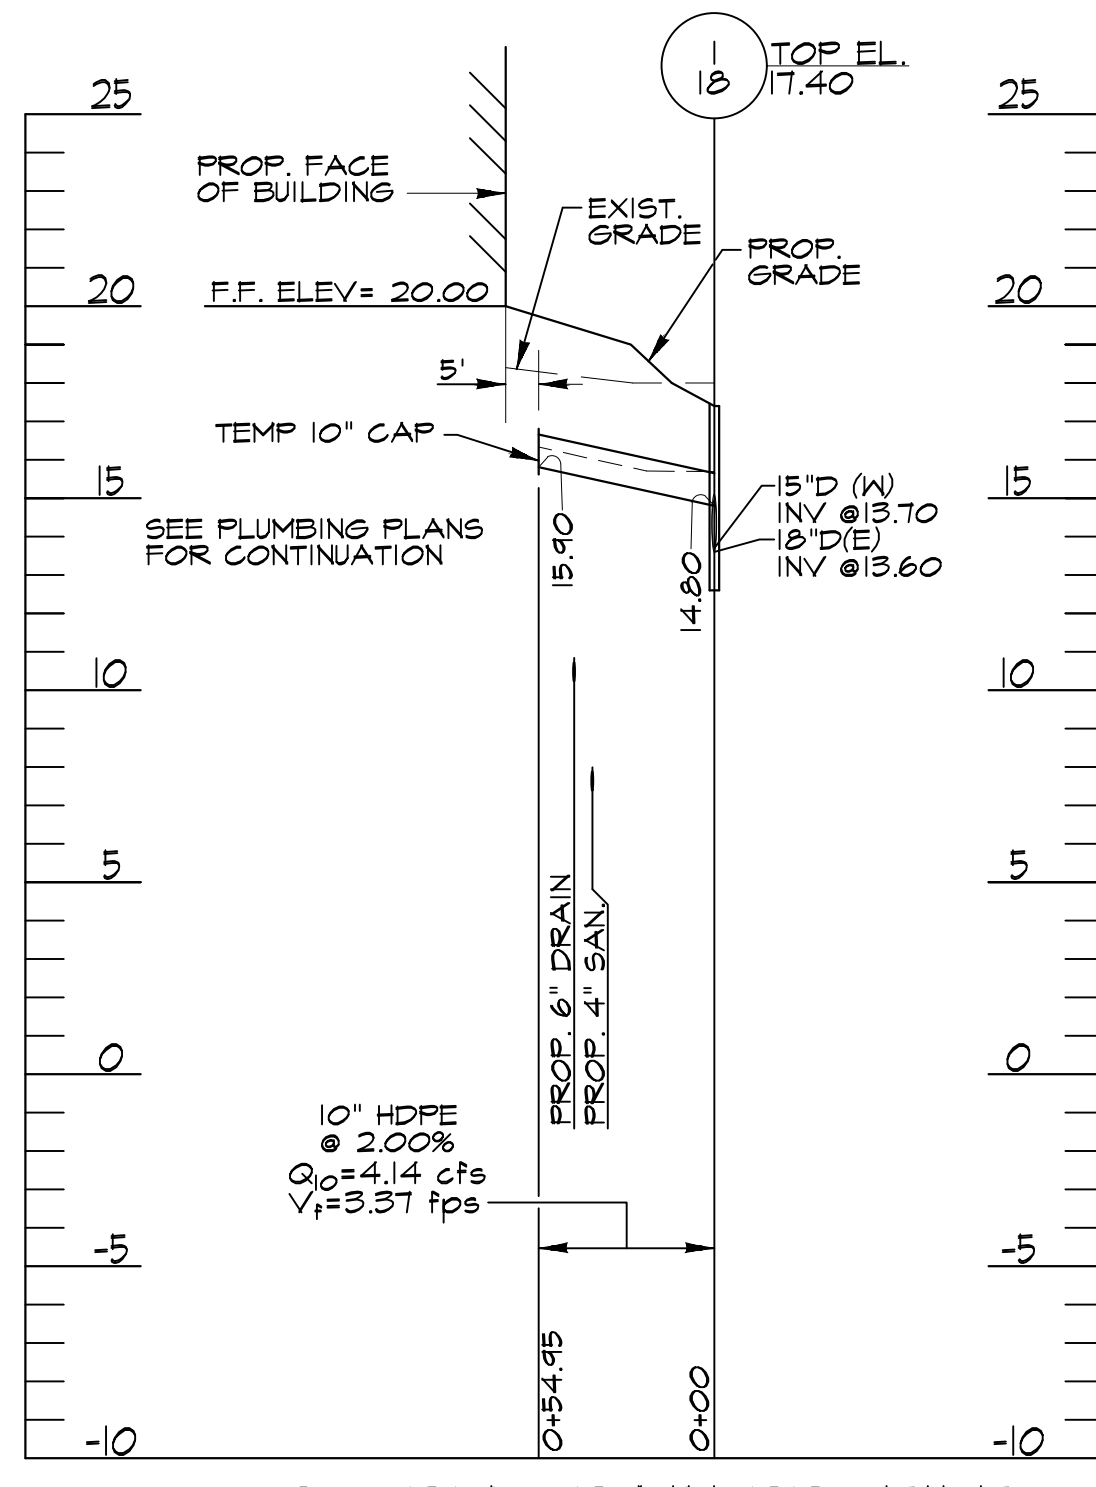


STORM DRAIN PROFILE (ROOF TO 1-18)

SCALE: HORIZ. 1"=60' VERT. 1"=5'

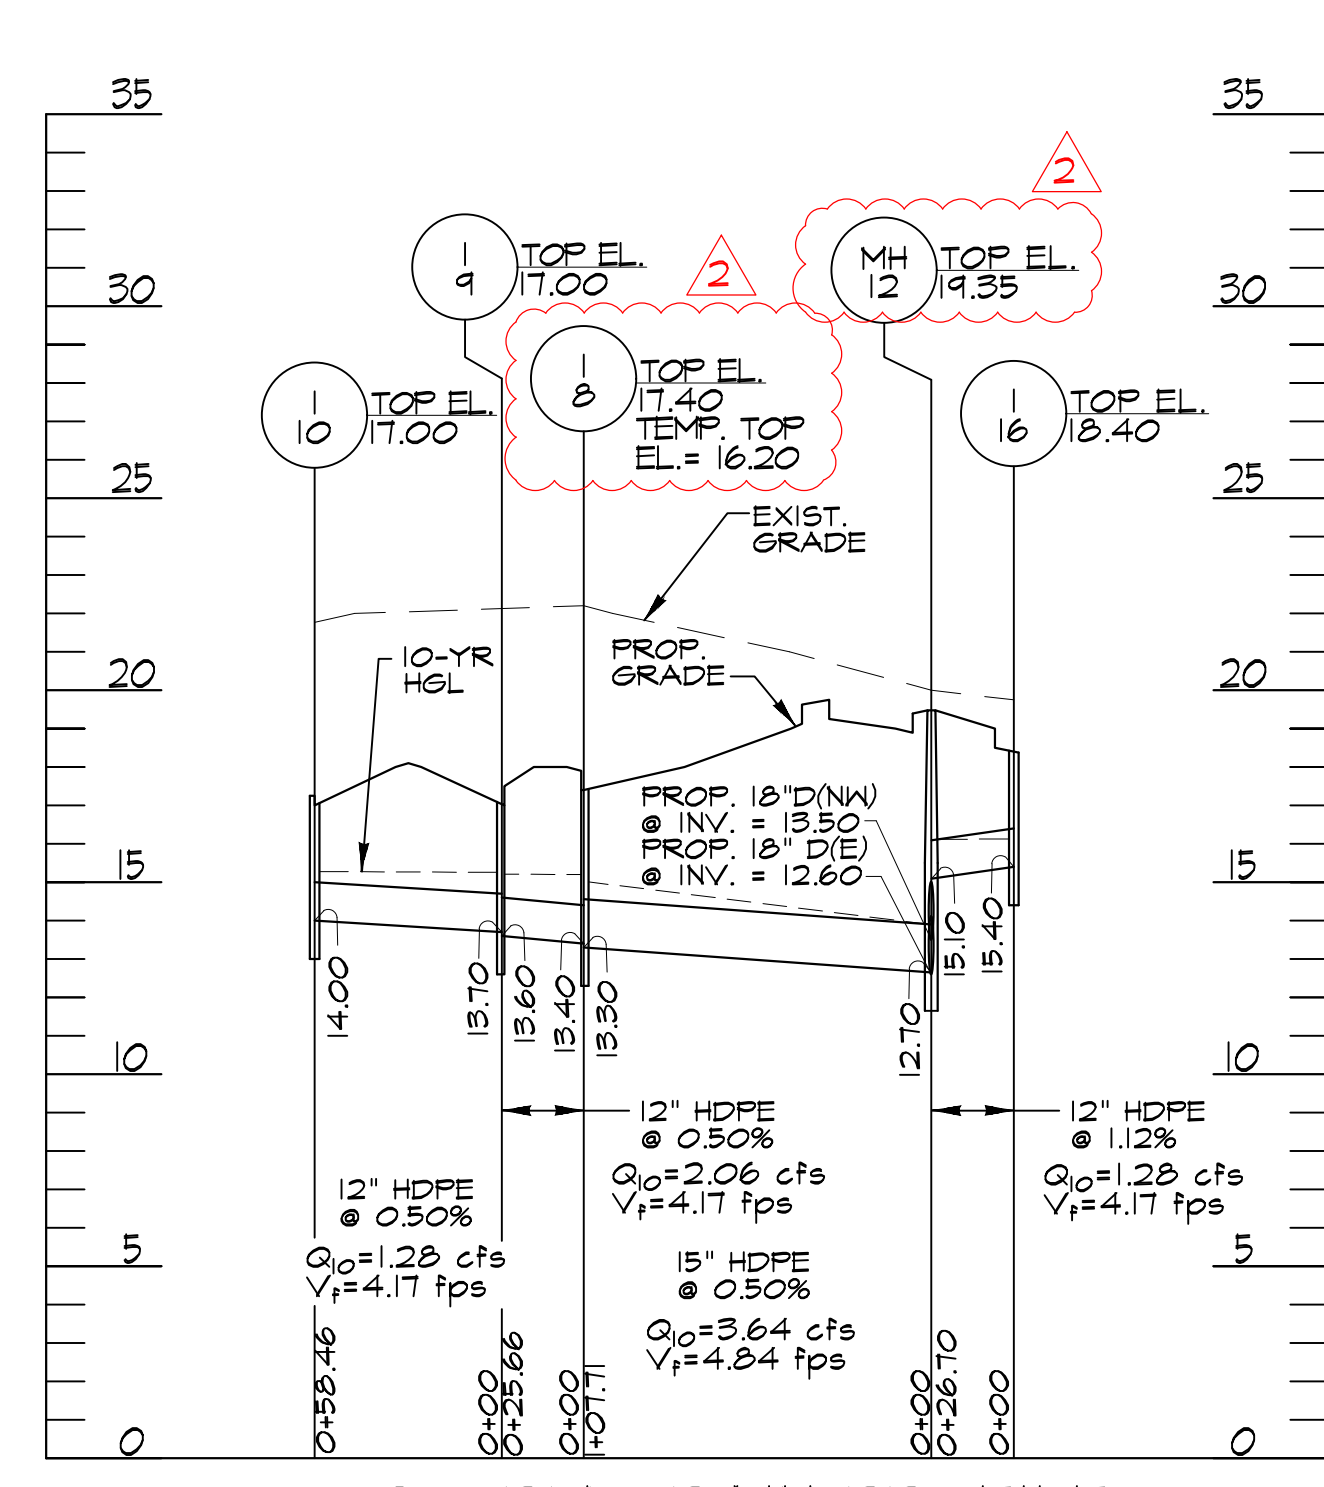


STORM DRAIN PROFILE (1-10 TO MH-12)

SCALE: HORIZ. 1"=60' VERT. 1"=5'

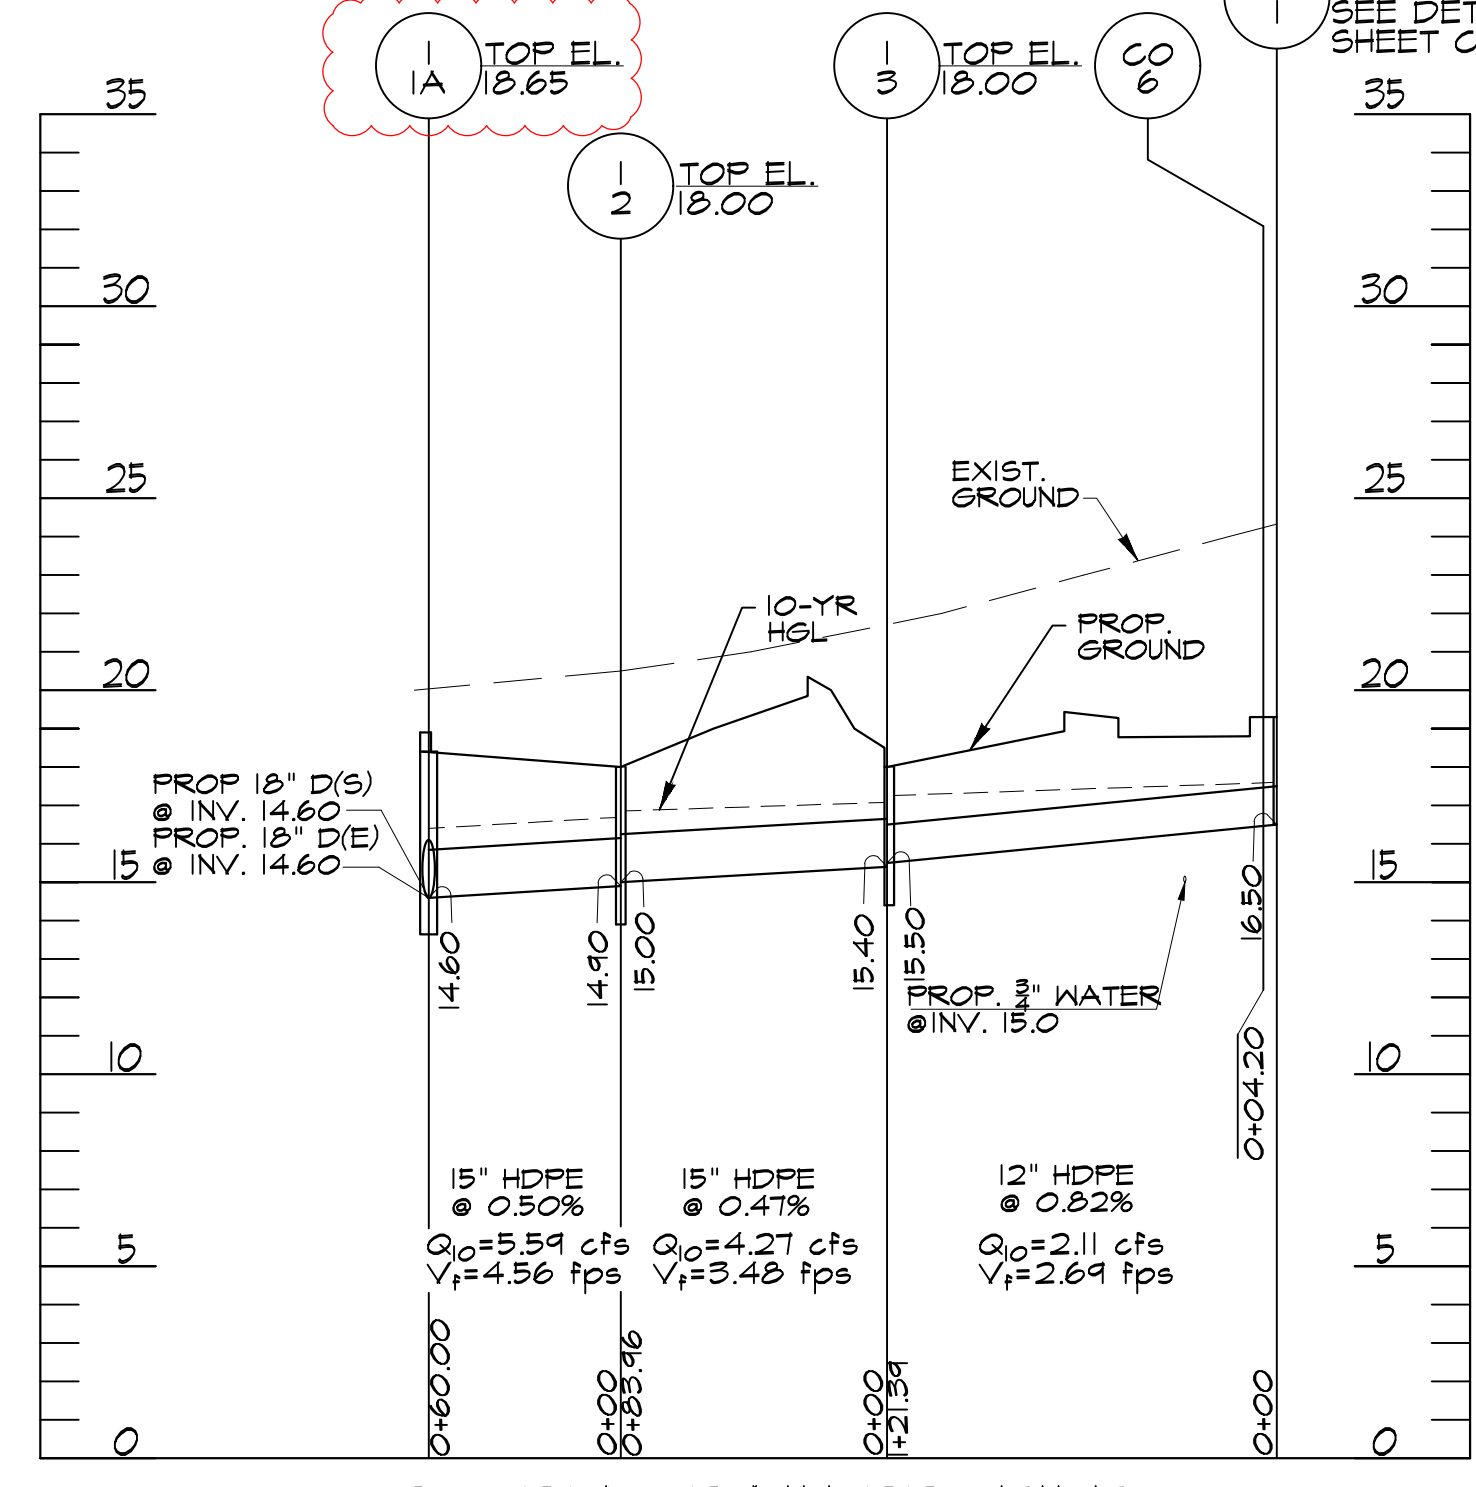


STORM DRAIN PROFILE (TD-1 TO 1-1A)

SCALE: HORIZ. 1"=60' VERT. 1"=5'

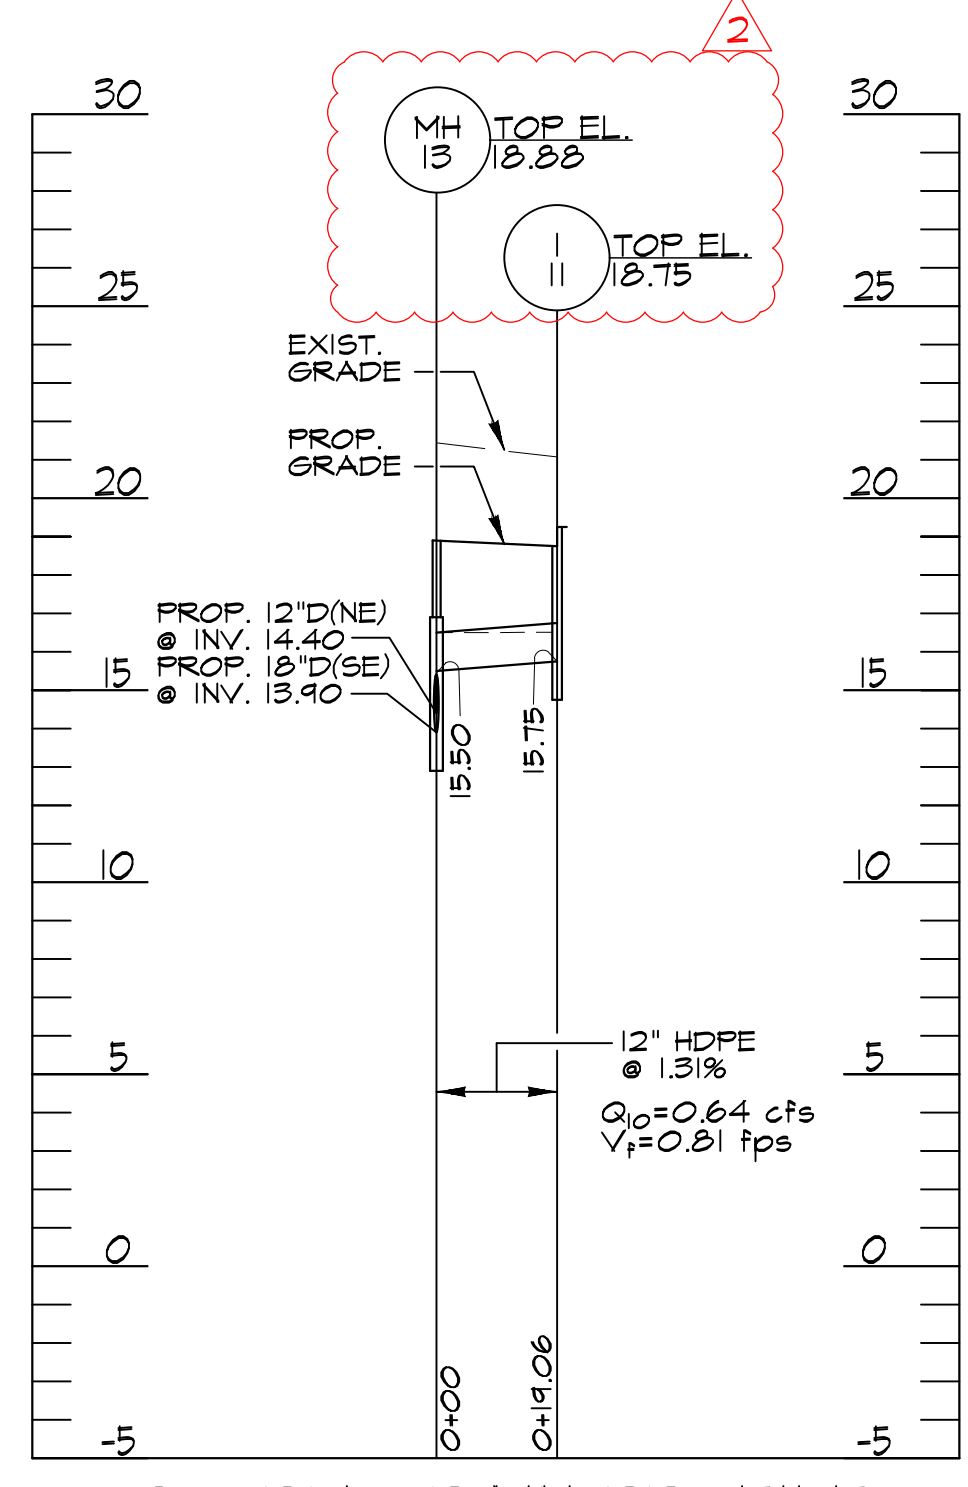


STORM DRAIN PROFILE (1-11 TO MH-13)

SCALE: HORIZ. 1"=60' VERT. 1"=5'

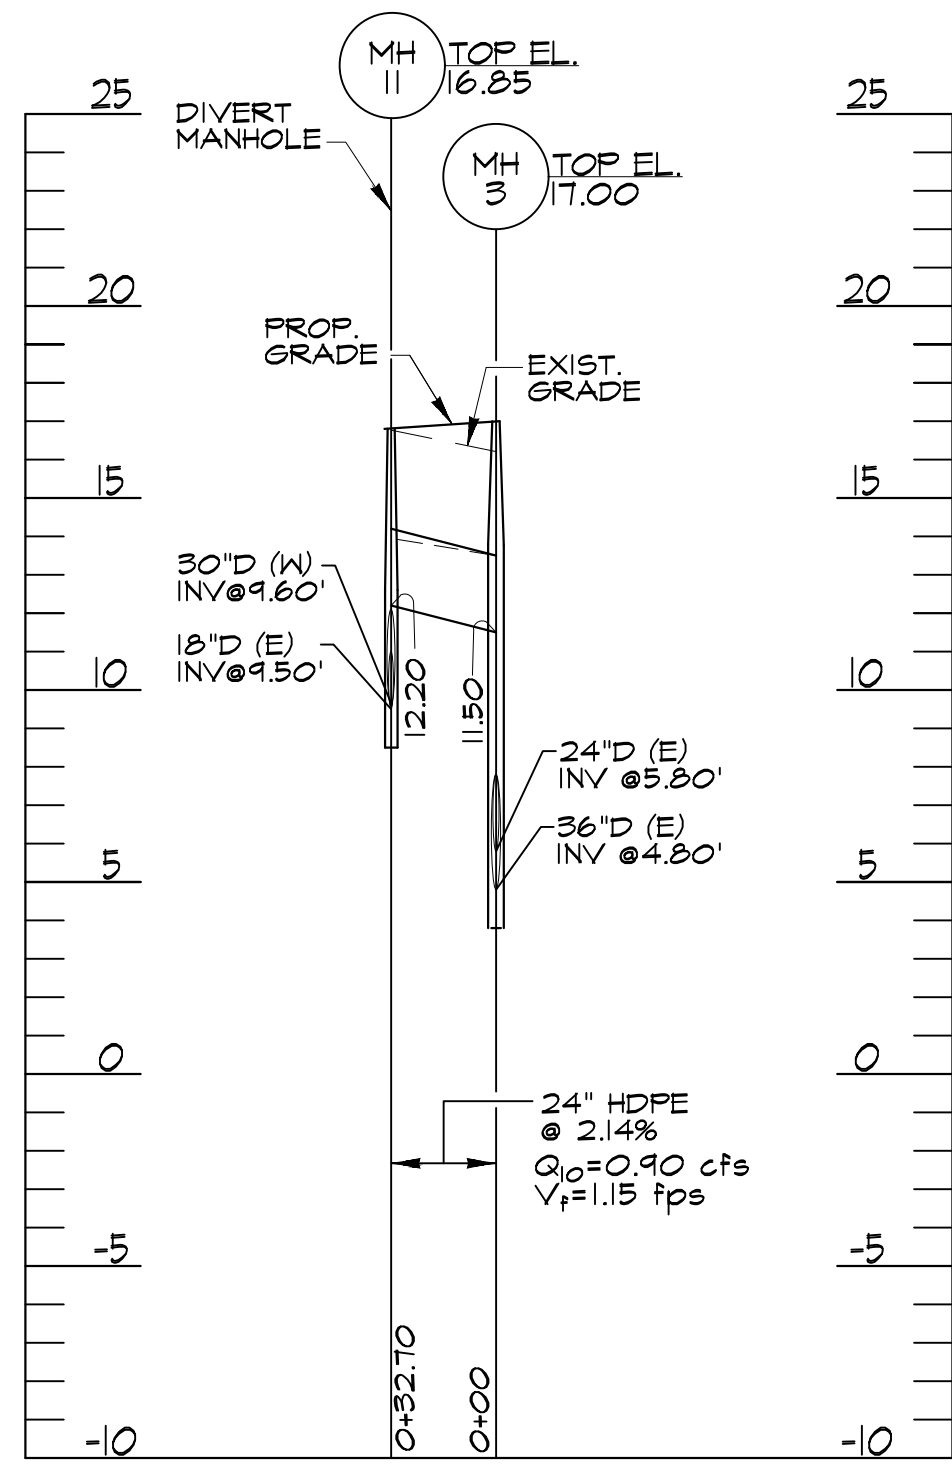


STORM DRAIN PROFILE (MH-11 TO MH-3)

SCALE: HORIZ. 1"=60' VERT. 1"=5'

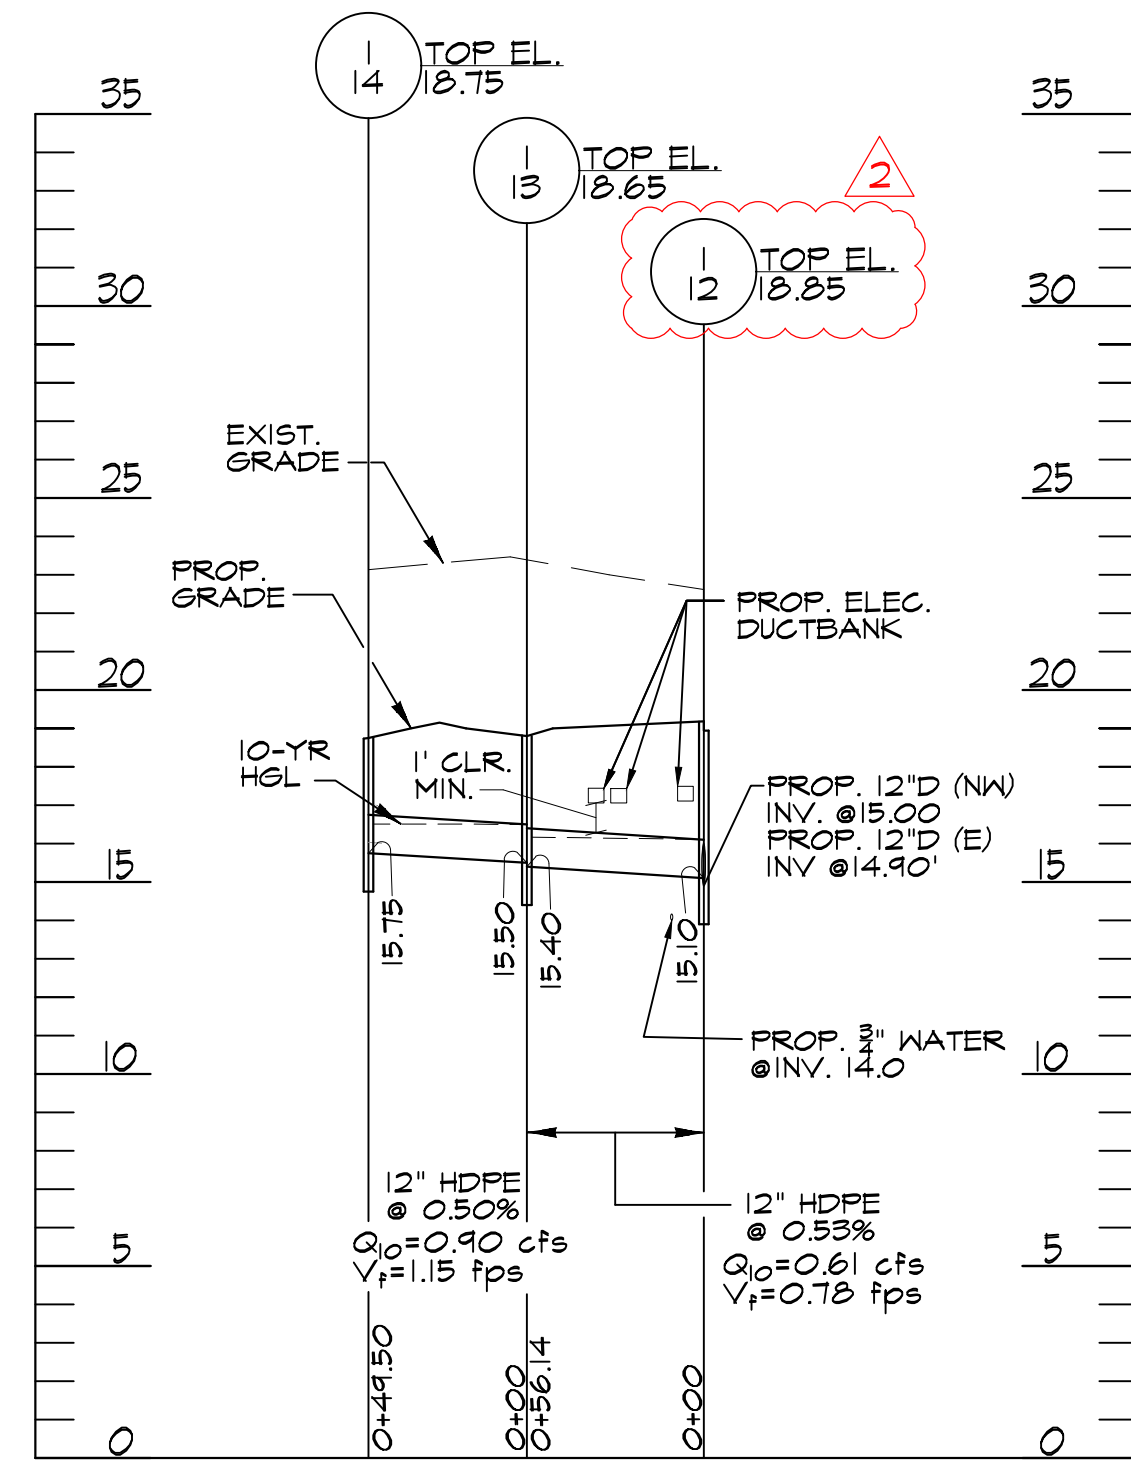


STORM DRAIN PROFILE (1-14 TO 1-12)

SCALE: HORIZ. 1"=60' VERT. 1"=5'

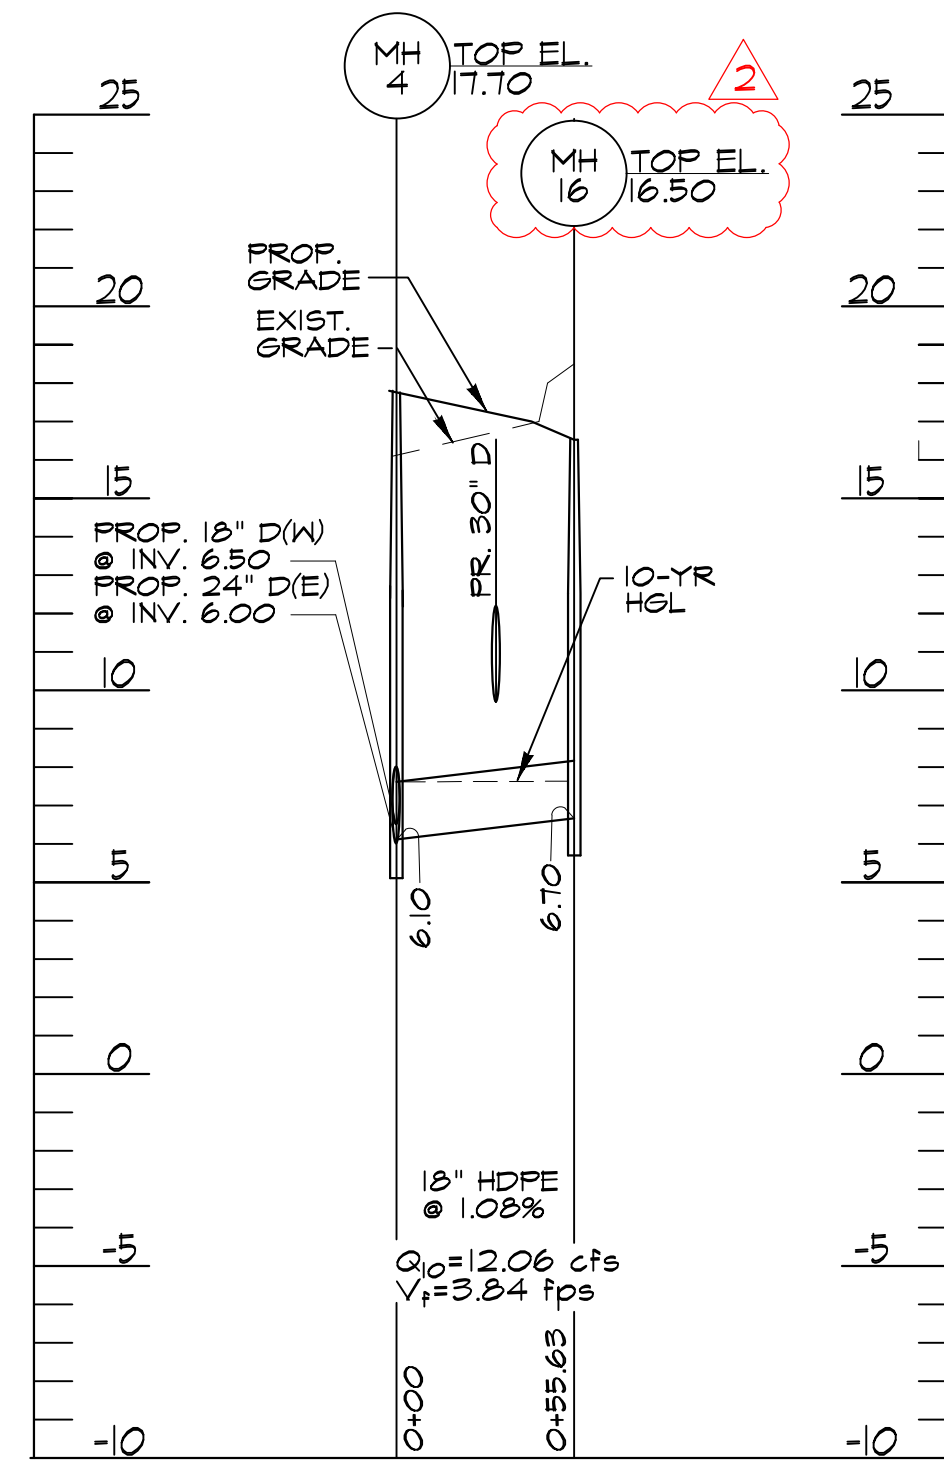

STORM DRAIN PROFILE (MH-4 TO MH-16)

SCALE: HORIZ. 1"=60' VERT. 1"=5'

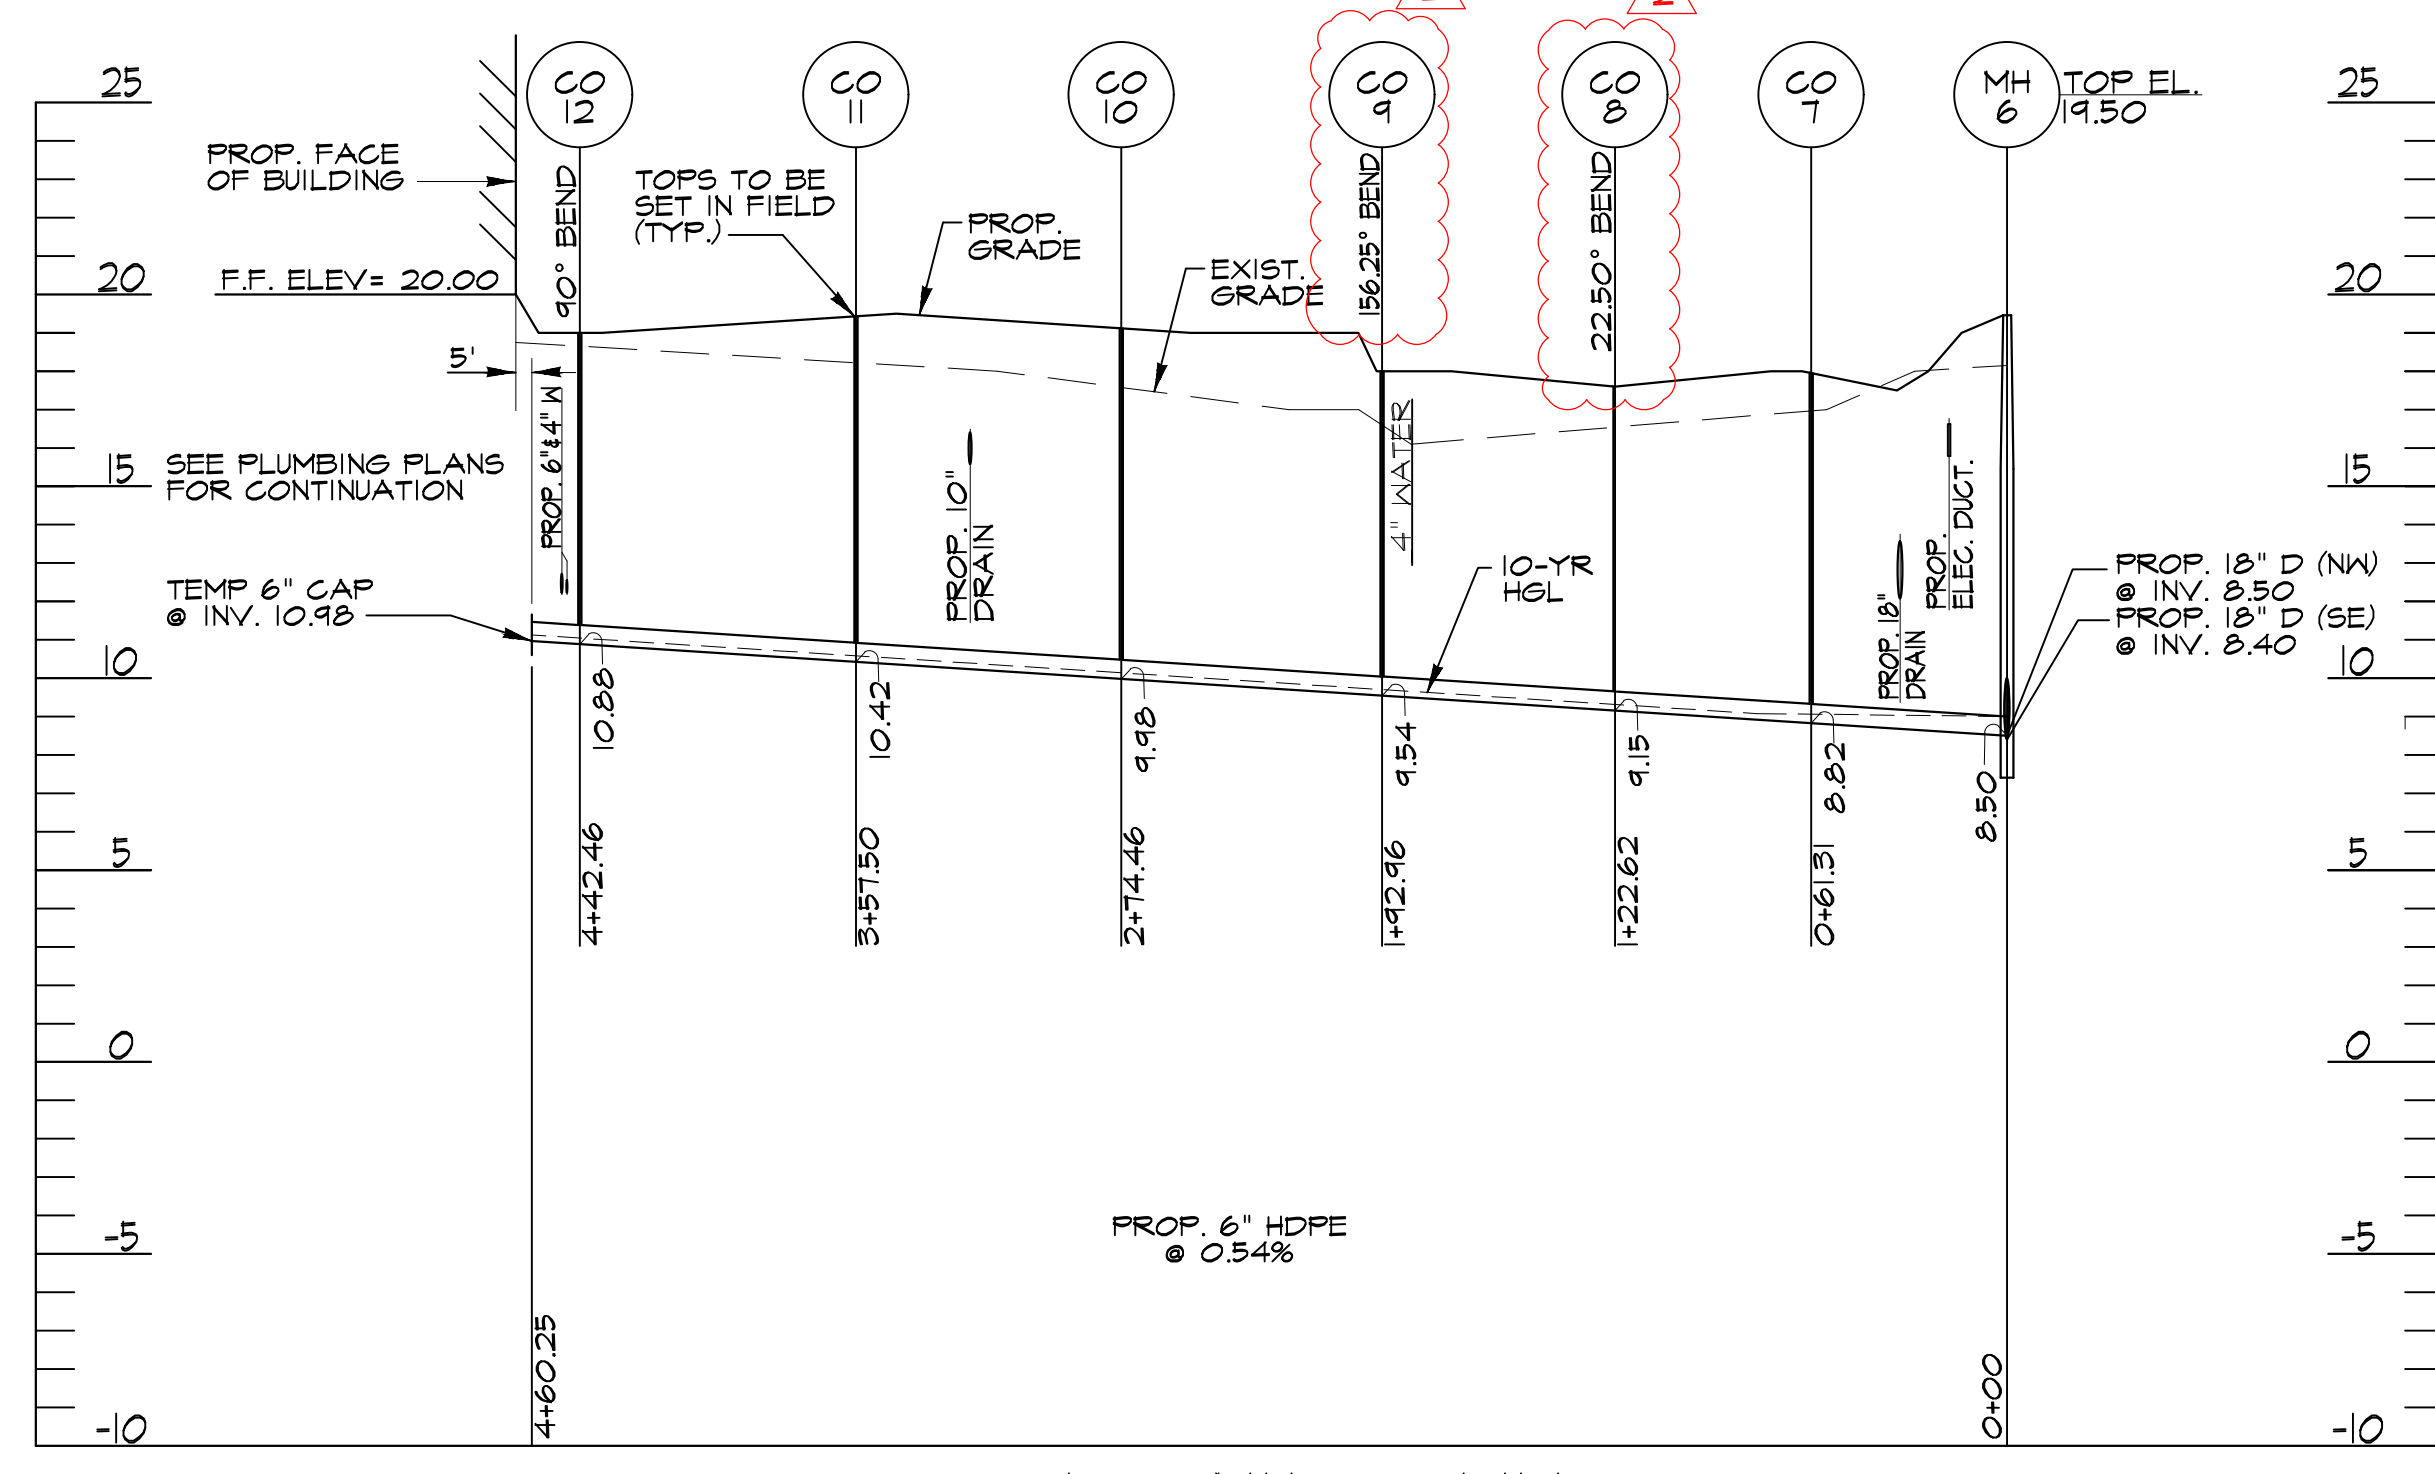

STORM DRAIN PROFILE (POOL TO MH-6)

SCALE: HORIZ. 1"=60' VERT. 1"=5'

ISSUED FOR BID



CERTIFY THAT THESE DOCUMENTS WERE PREPARED OR APPROVED BY ME, AND THAT I AM A FULLY LICENSED ENGINEER UNDER THE LAWS OF THE STATE OF MARYLAND. LICENSE NUMBER: 25058, EXPIRATION DATE: 11/17/20


Revisions	No.	Date	Description
	2	1/28/20	Addendum #2

MIDDLE BRANCH FITNESS & WELLNESS CENTER AT CHERRY HILL
BALTIMORE CITY RECREATION & PARKS


Job No.	18010	Author	SG
Scale		Checker	AP
Date	1/28/2019	Approver	SM
Drawing Title	Storm Drain Profiles		

Sheet: C8.04r2


KEYNOTES LISTED ON THIS SHEET ARE FOR CONVENIENCE ONLY. REFER TO SHEET CS.3 FOR COMPLETE LIST

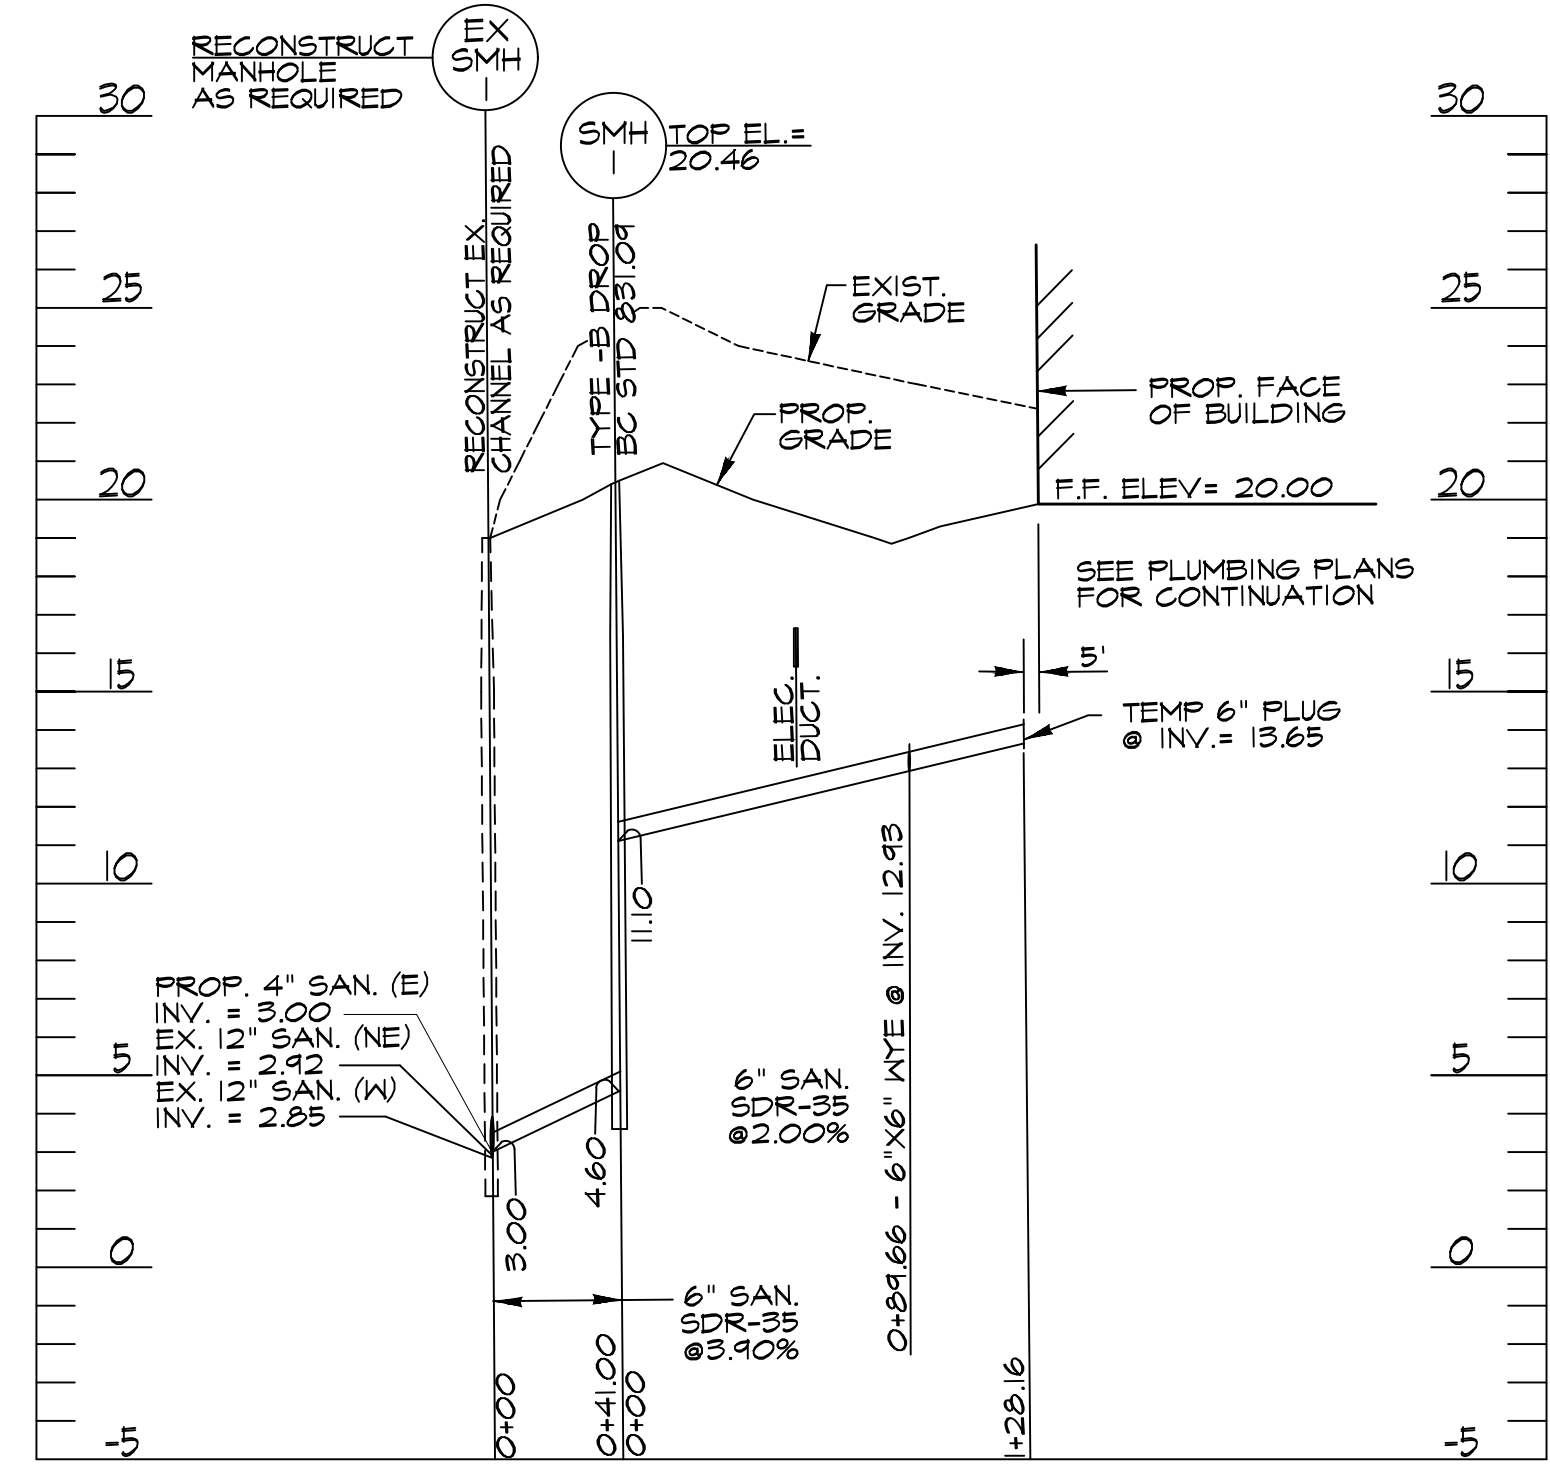


6" SANITARY SEWER PROFILE
(BUILDING TO EX. SMH-1)
SCALE: HORIZ. 1"=60'
VERT. 1"=5'

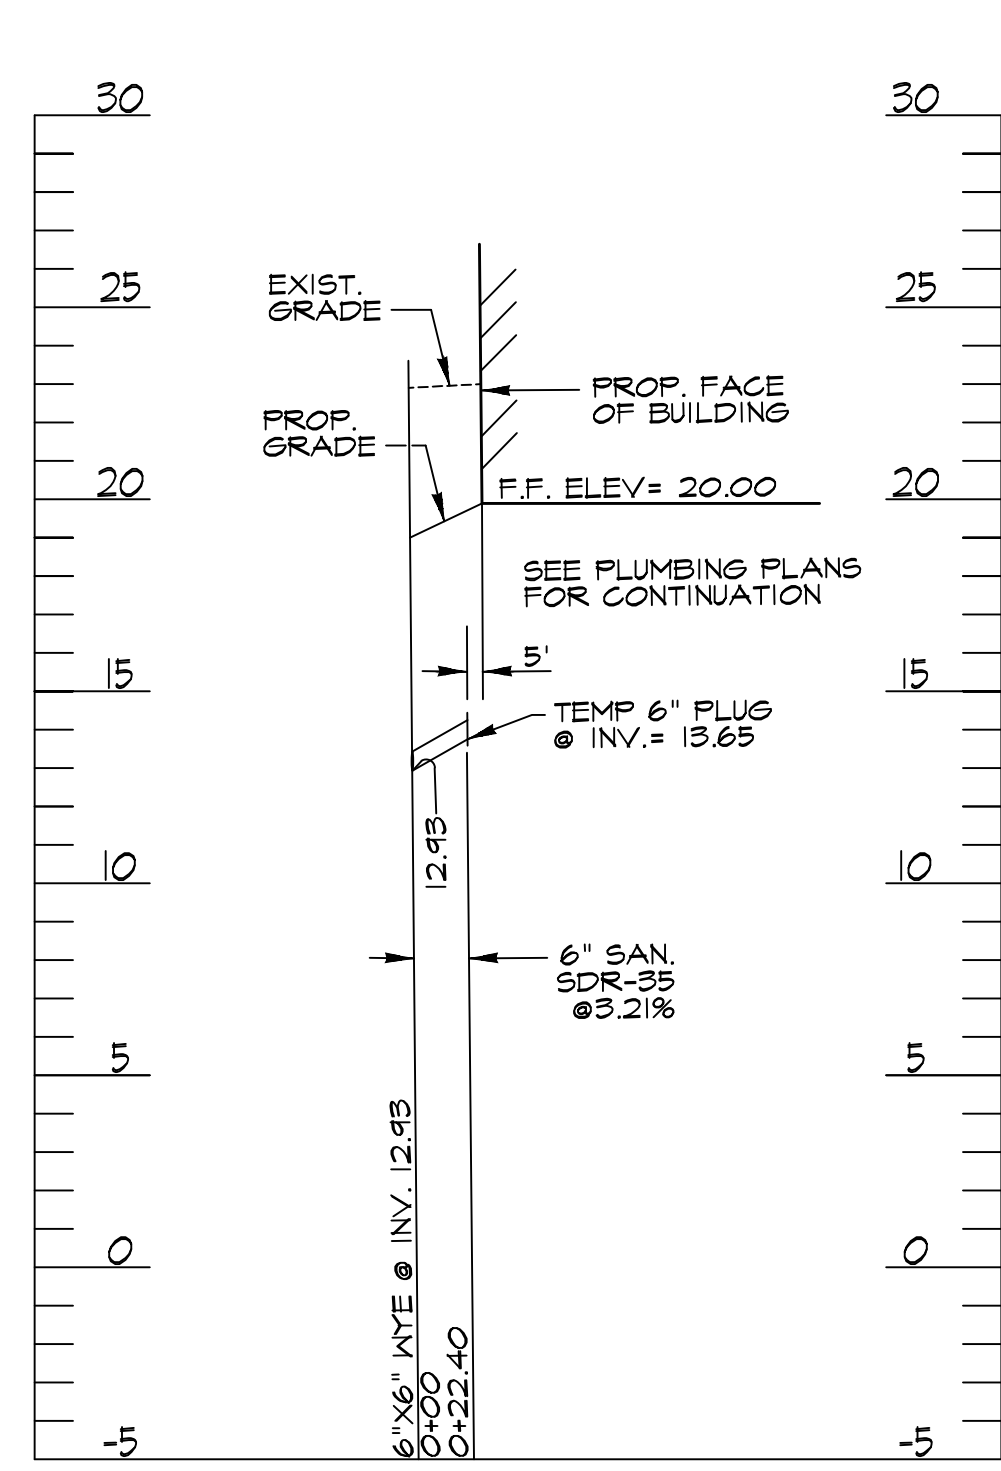


6" SANITARY SEWER PROFILE
(BUILDING TO PROP. 6"X6" WYE)
SCALE: HORIZ. 1"=60'
VERT. 1"=5'

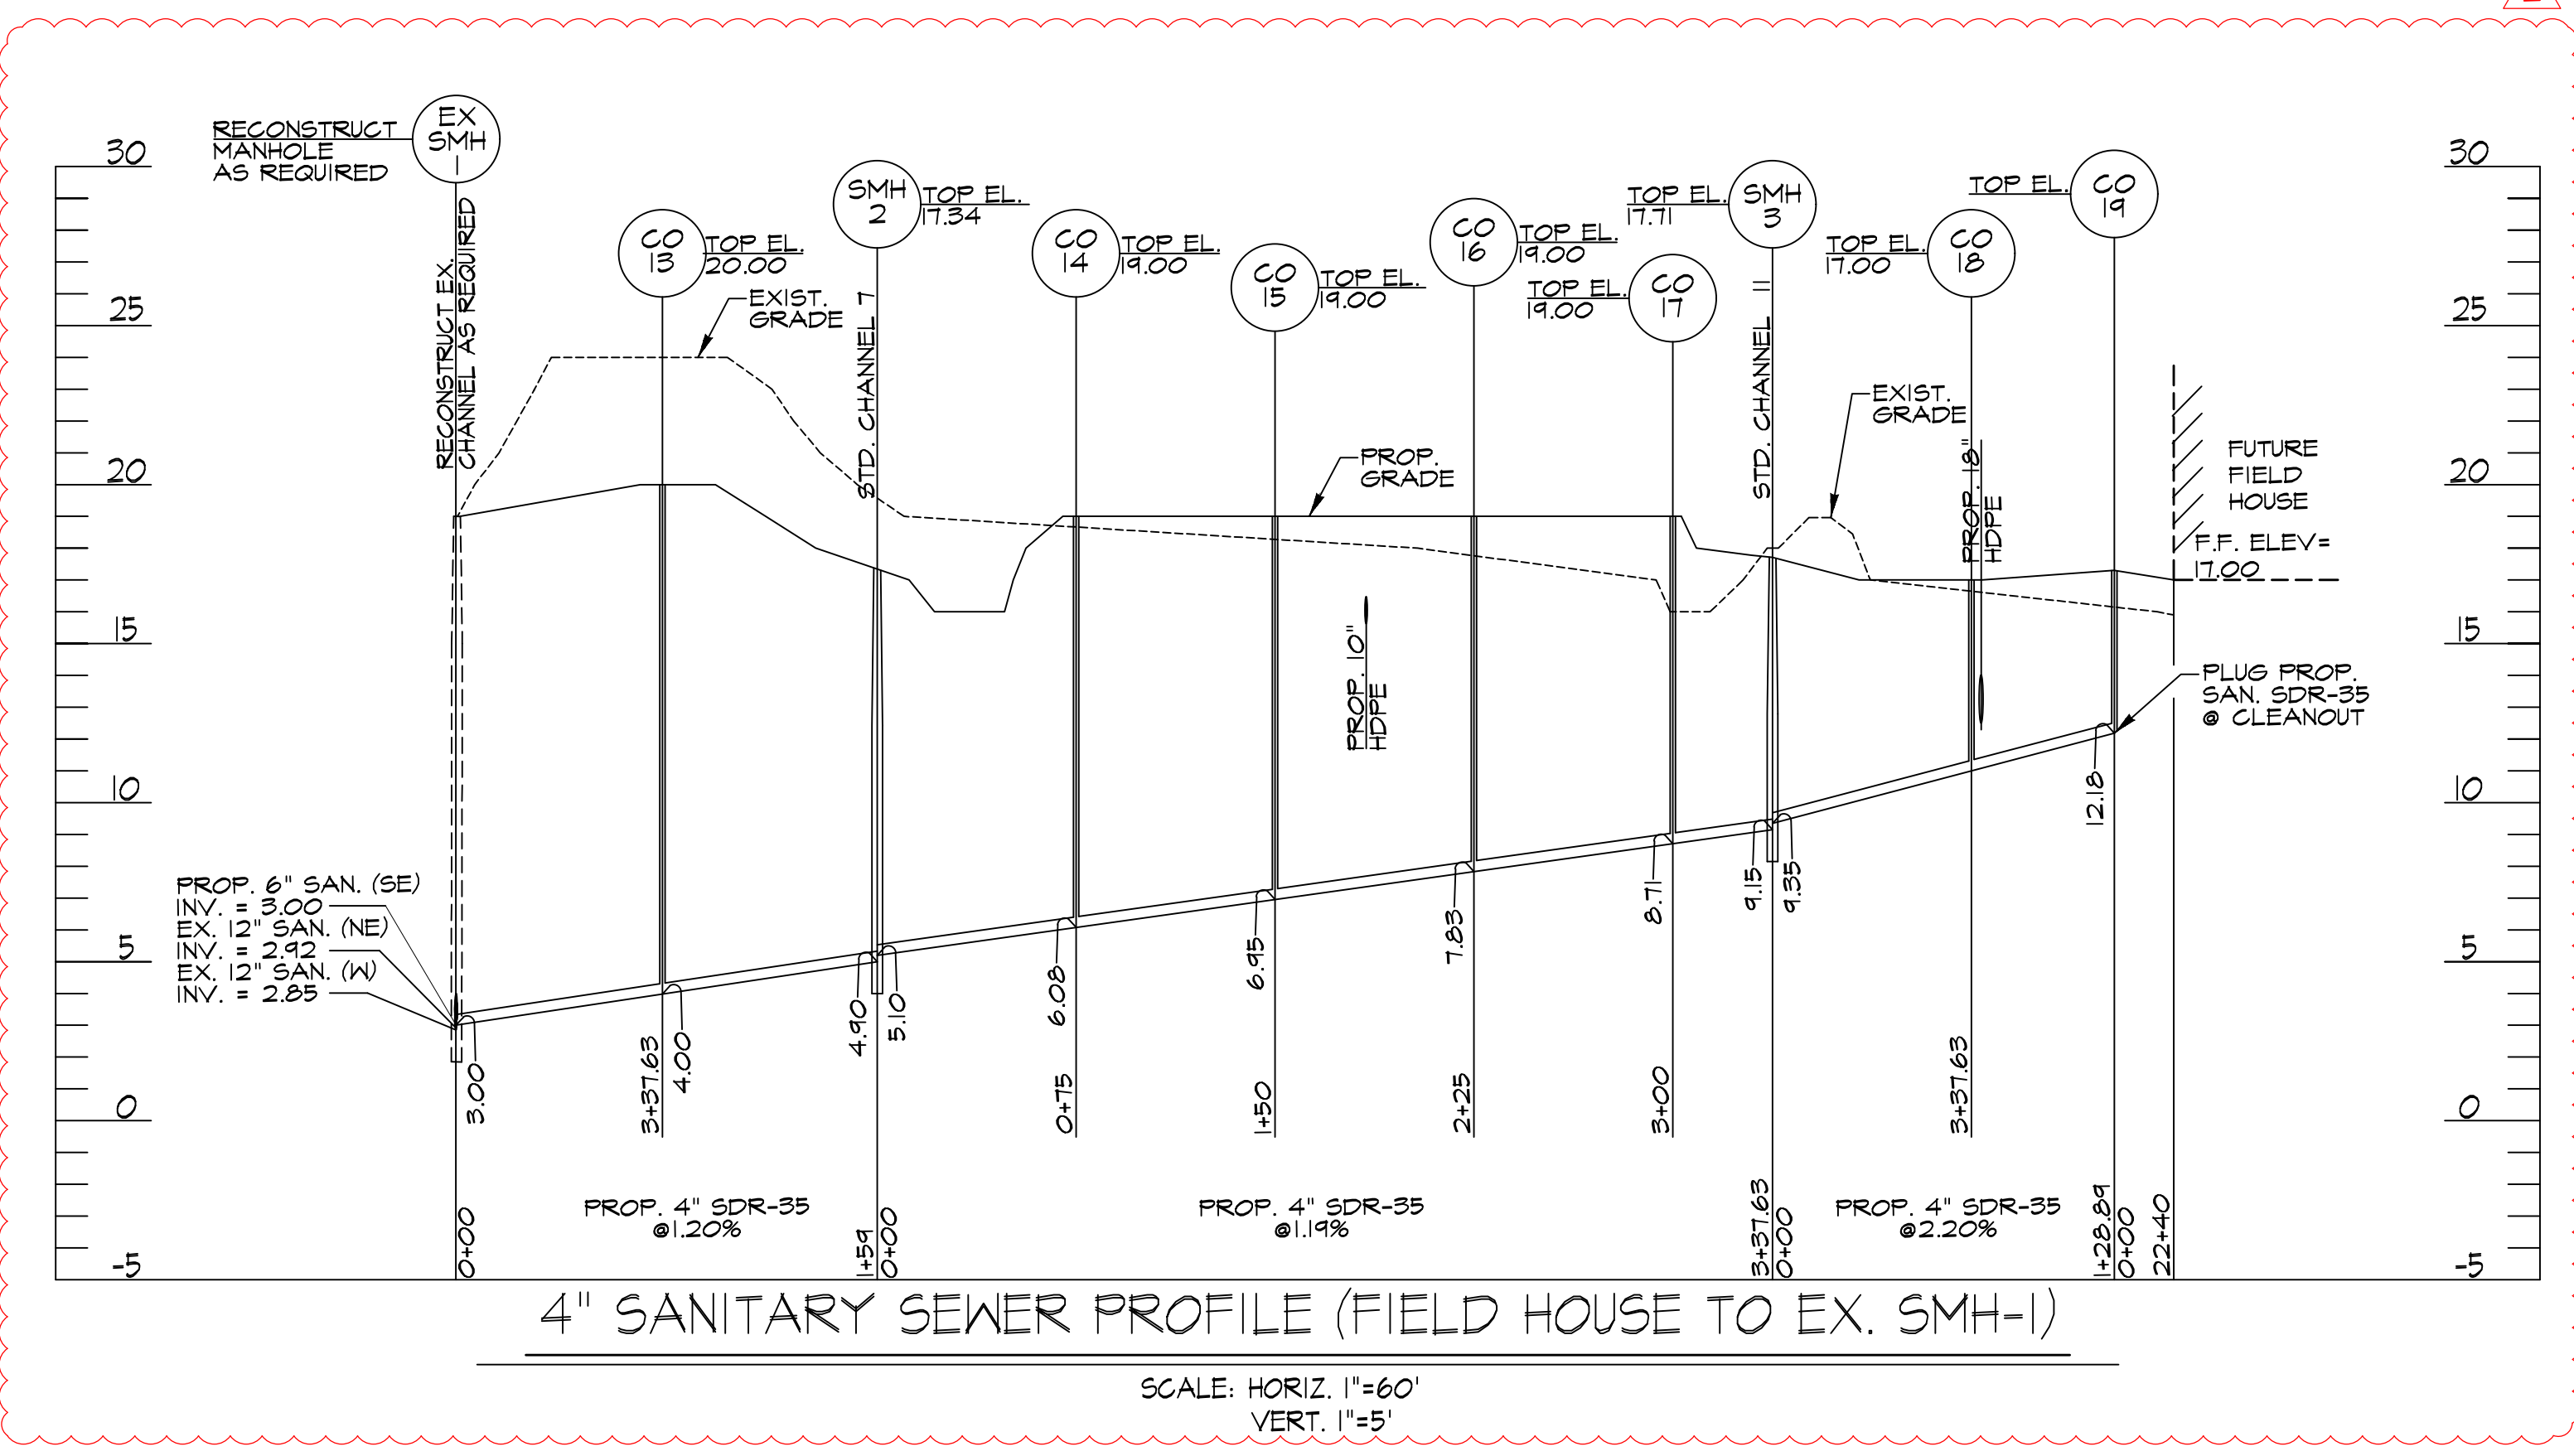


4" SANITARY SEWER PROFILE (FIELD HOUSE TO EX. SMH-1)
SCALE: HORIZ. 1"=60'
VERT. 1"=5'

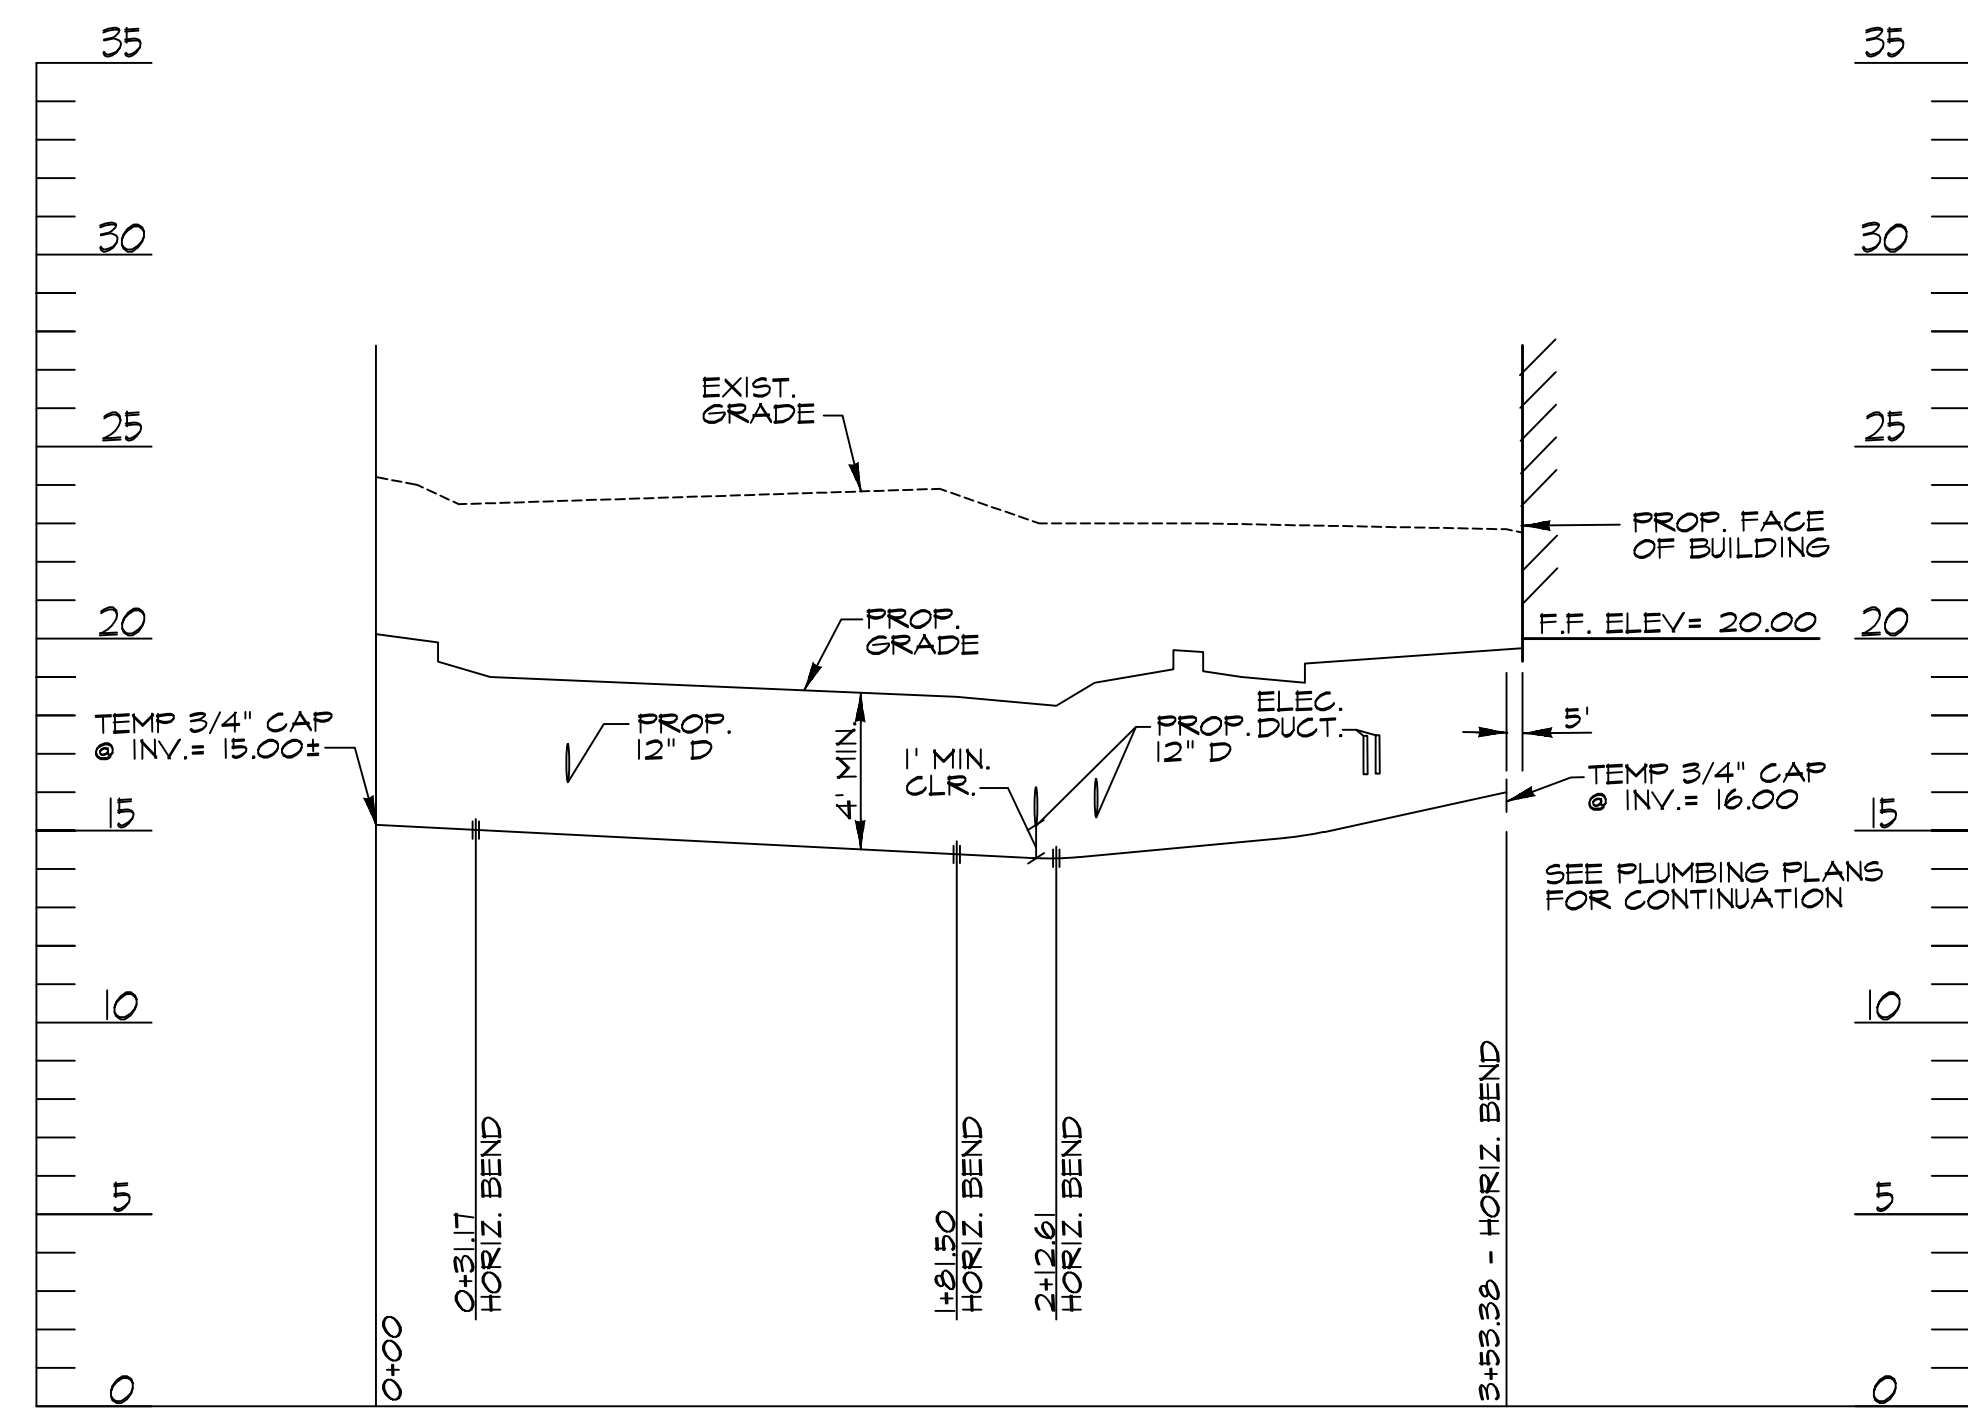

3/4" WATER PROFILE
SCALE: HORIZ. 1"=60'
VERT. 1"=5'

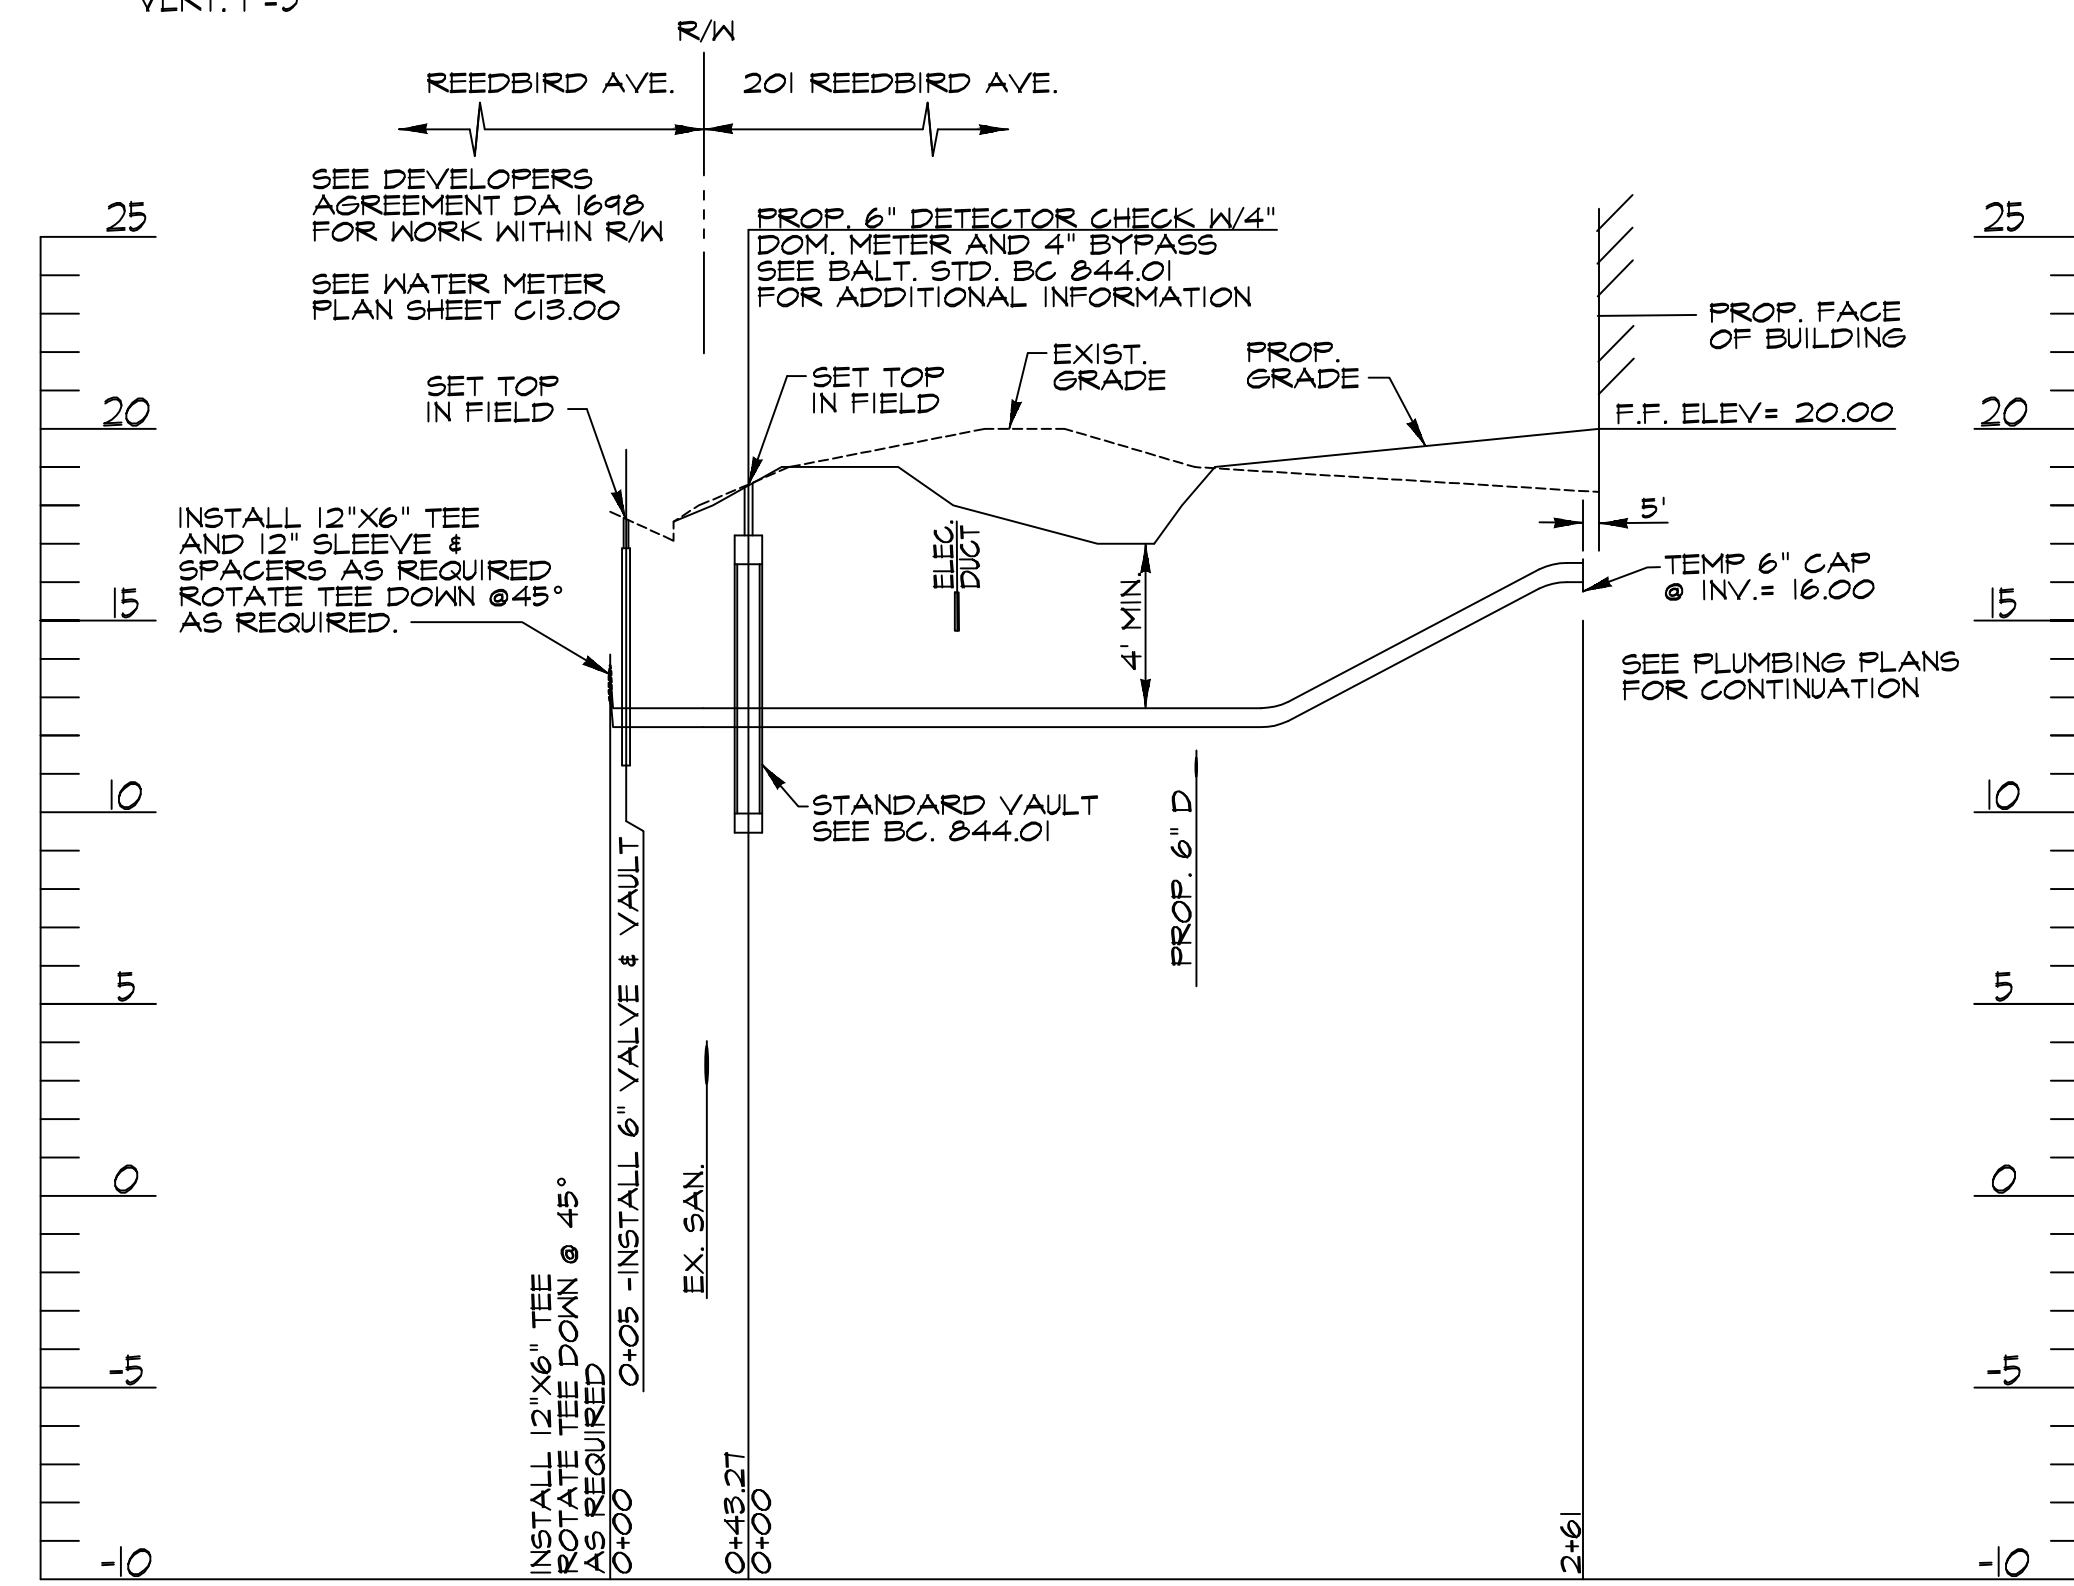

6" WATER PROFILE
SCALE: HORIZ. 1"=60'
VERT. 1"=5'

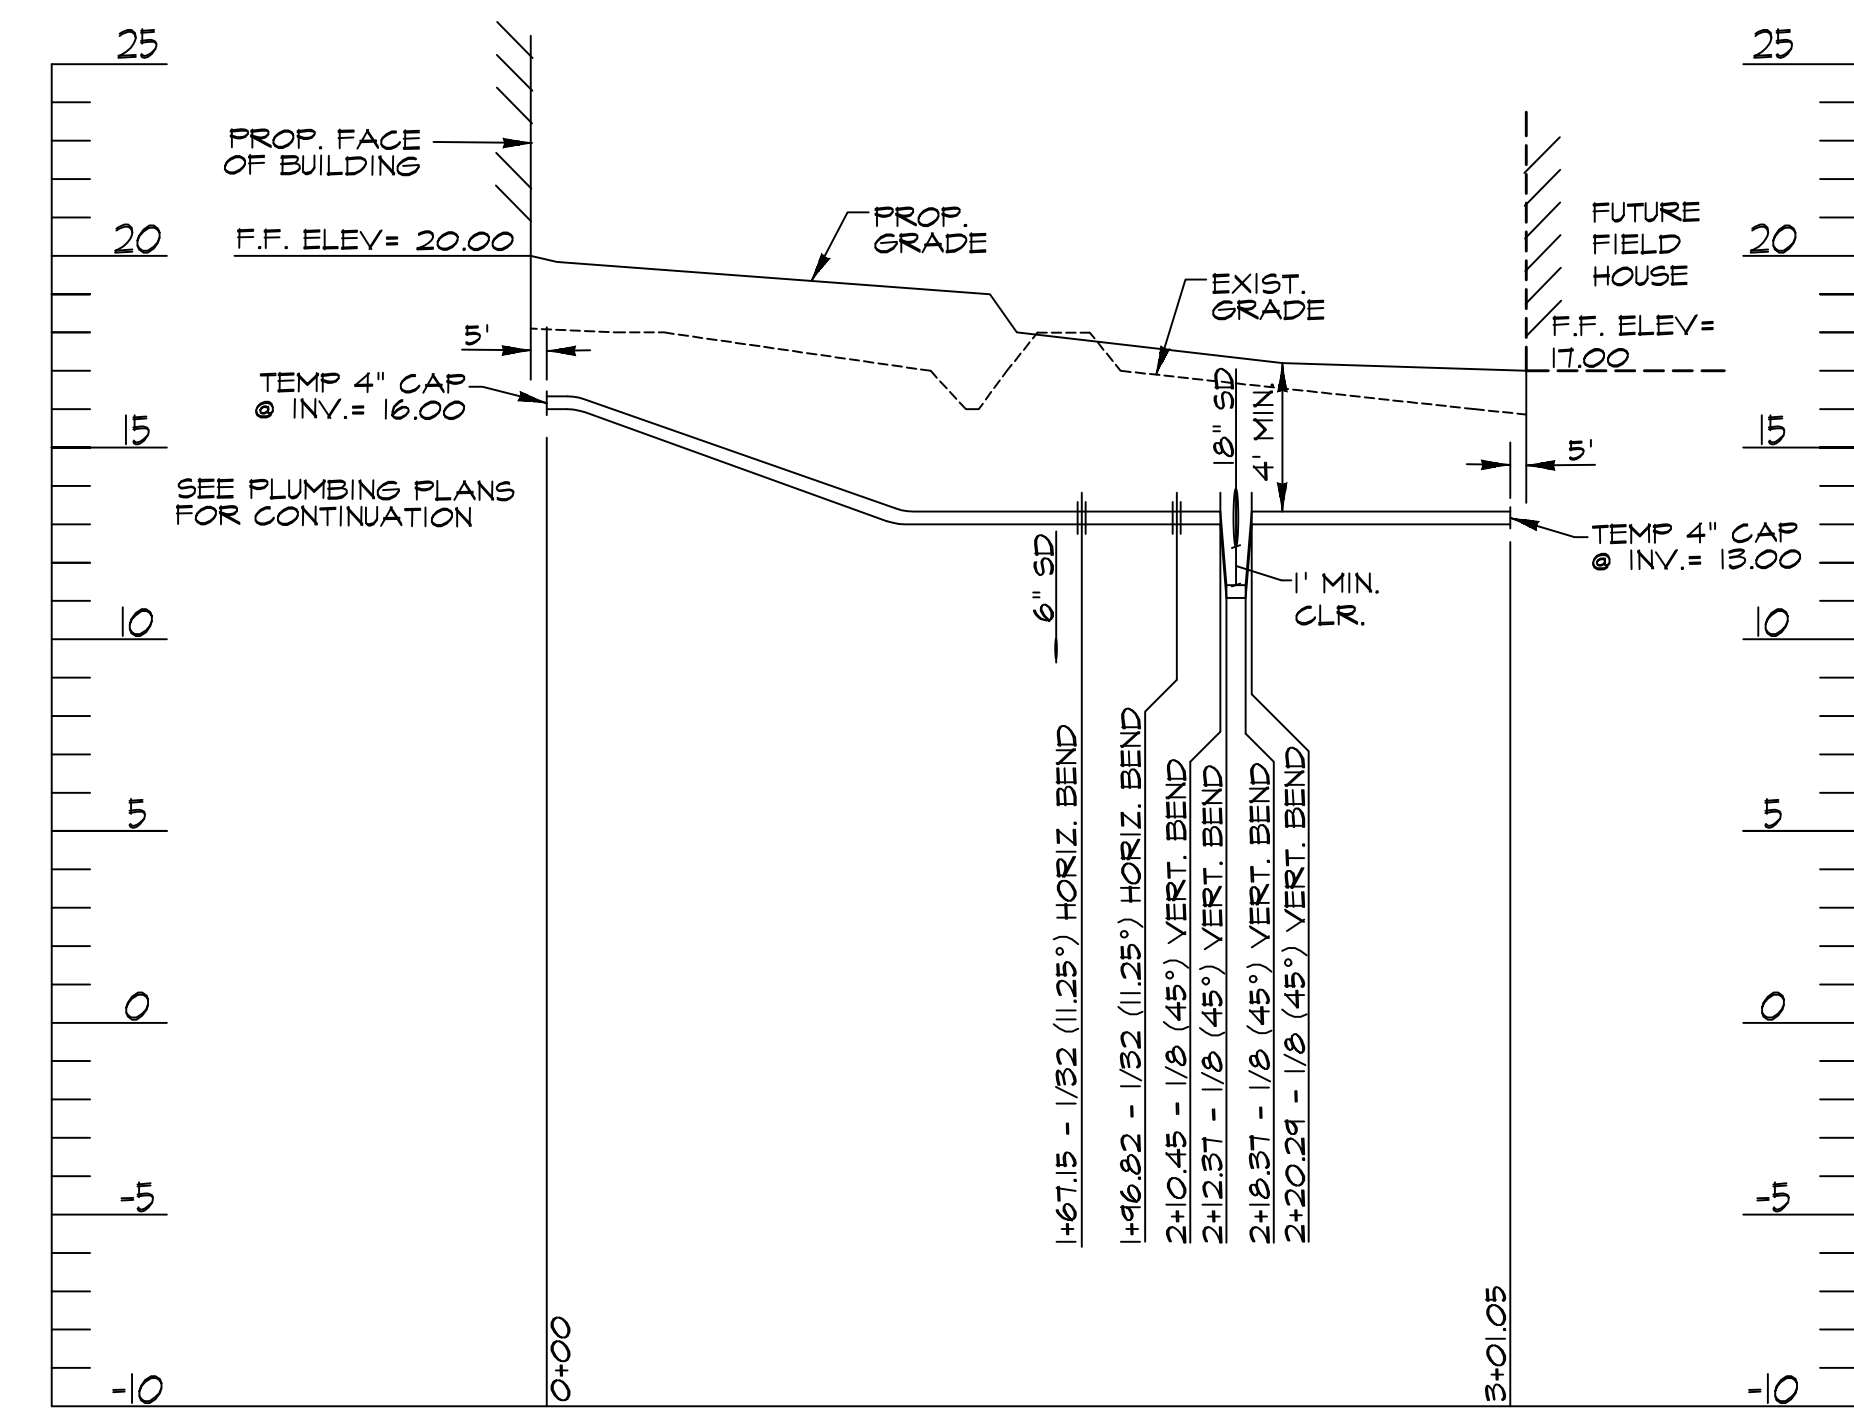

4" WATER PROFILE (FIELD HOUSE)
SCALE: HORIZ. 1"=60'
VERT. 1"=5'

ISSUED FOR BID




© 2019 GWIO INC.
I CERTIFY THAT THESE DOCUMENTS WERE PREPARED OR APPROVED BY ME, AND THAT I AM A FULLY LICENSED ENGINEER UNDER THE LAWS OF THE STATE OF MARYLAND. LICENSE NUMBER: 25058, EXPIRATION DATE: 11/17/20

Revisions	No.	Date	Description
	2	1/28/20	Addendum #2

MIDDLE BRANCH FITNESS & WELLNESS CENTER AT CHERRY HILL
BALTIMORE CITY RECREATION & PARKS


Jcb No.	18010	Author	SG
Scale	AS SHOWN	Checker	AP
Date	1/28/2019	Approver	SM
Drawing Title	UTILITY PROFILES		
Sheet	C8.05r2		

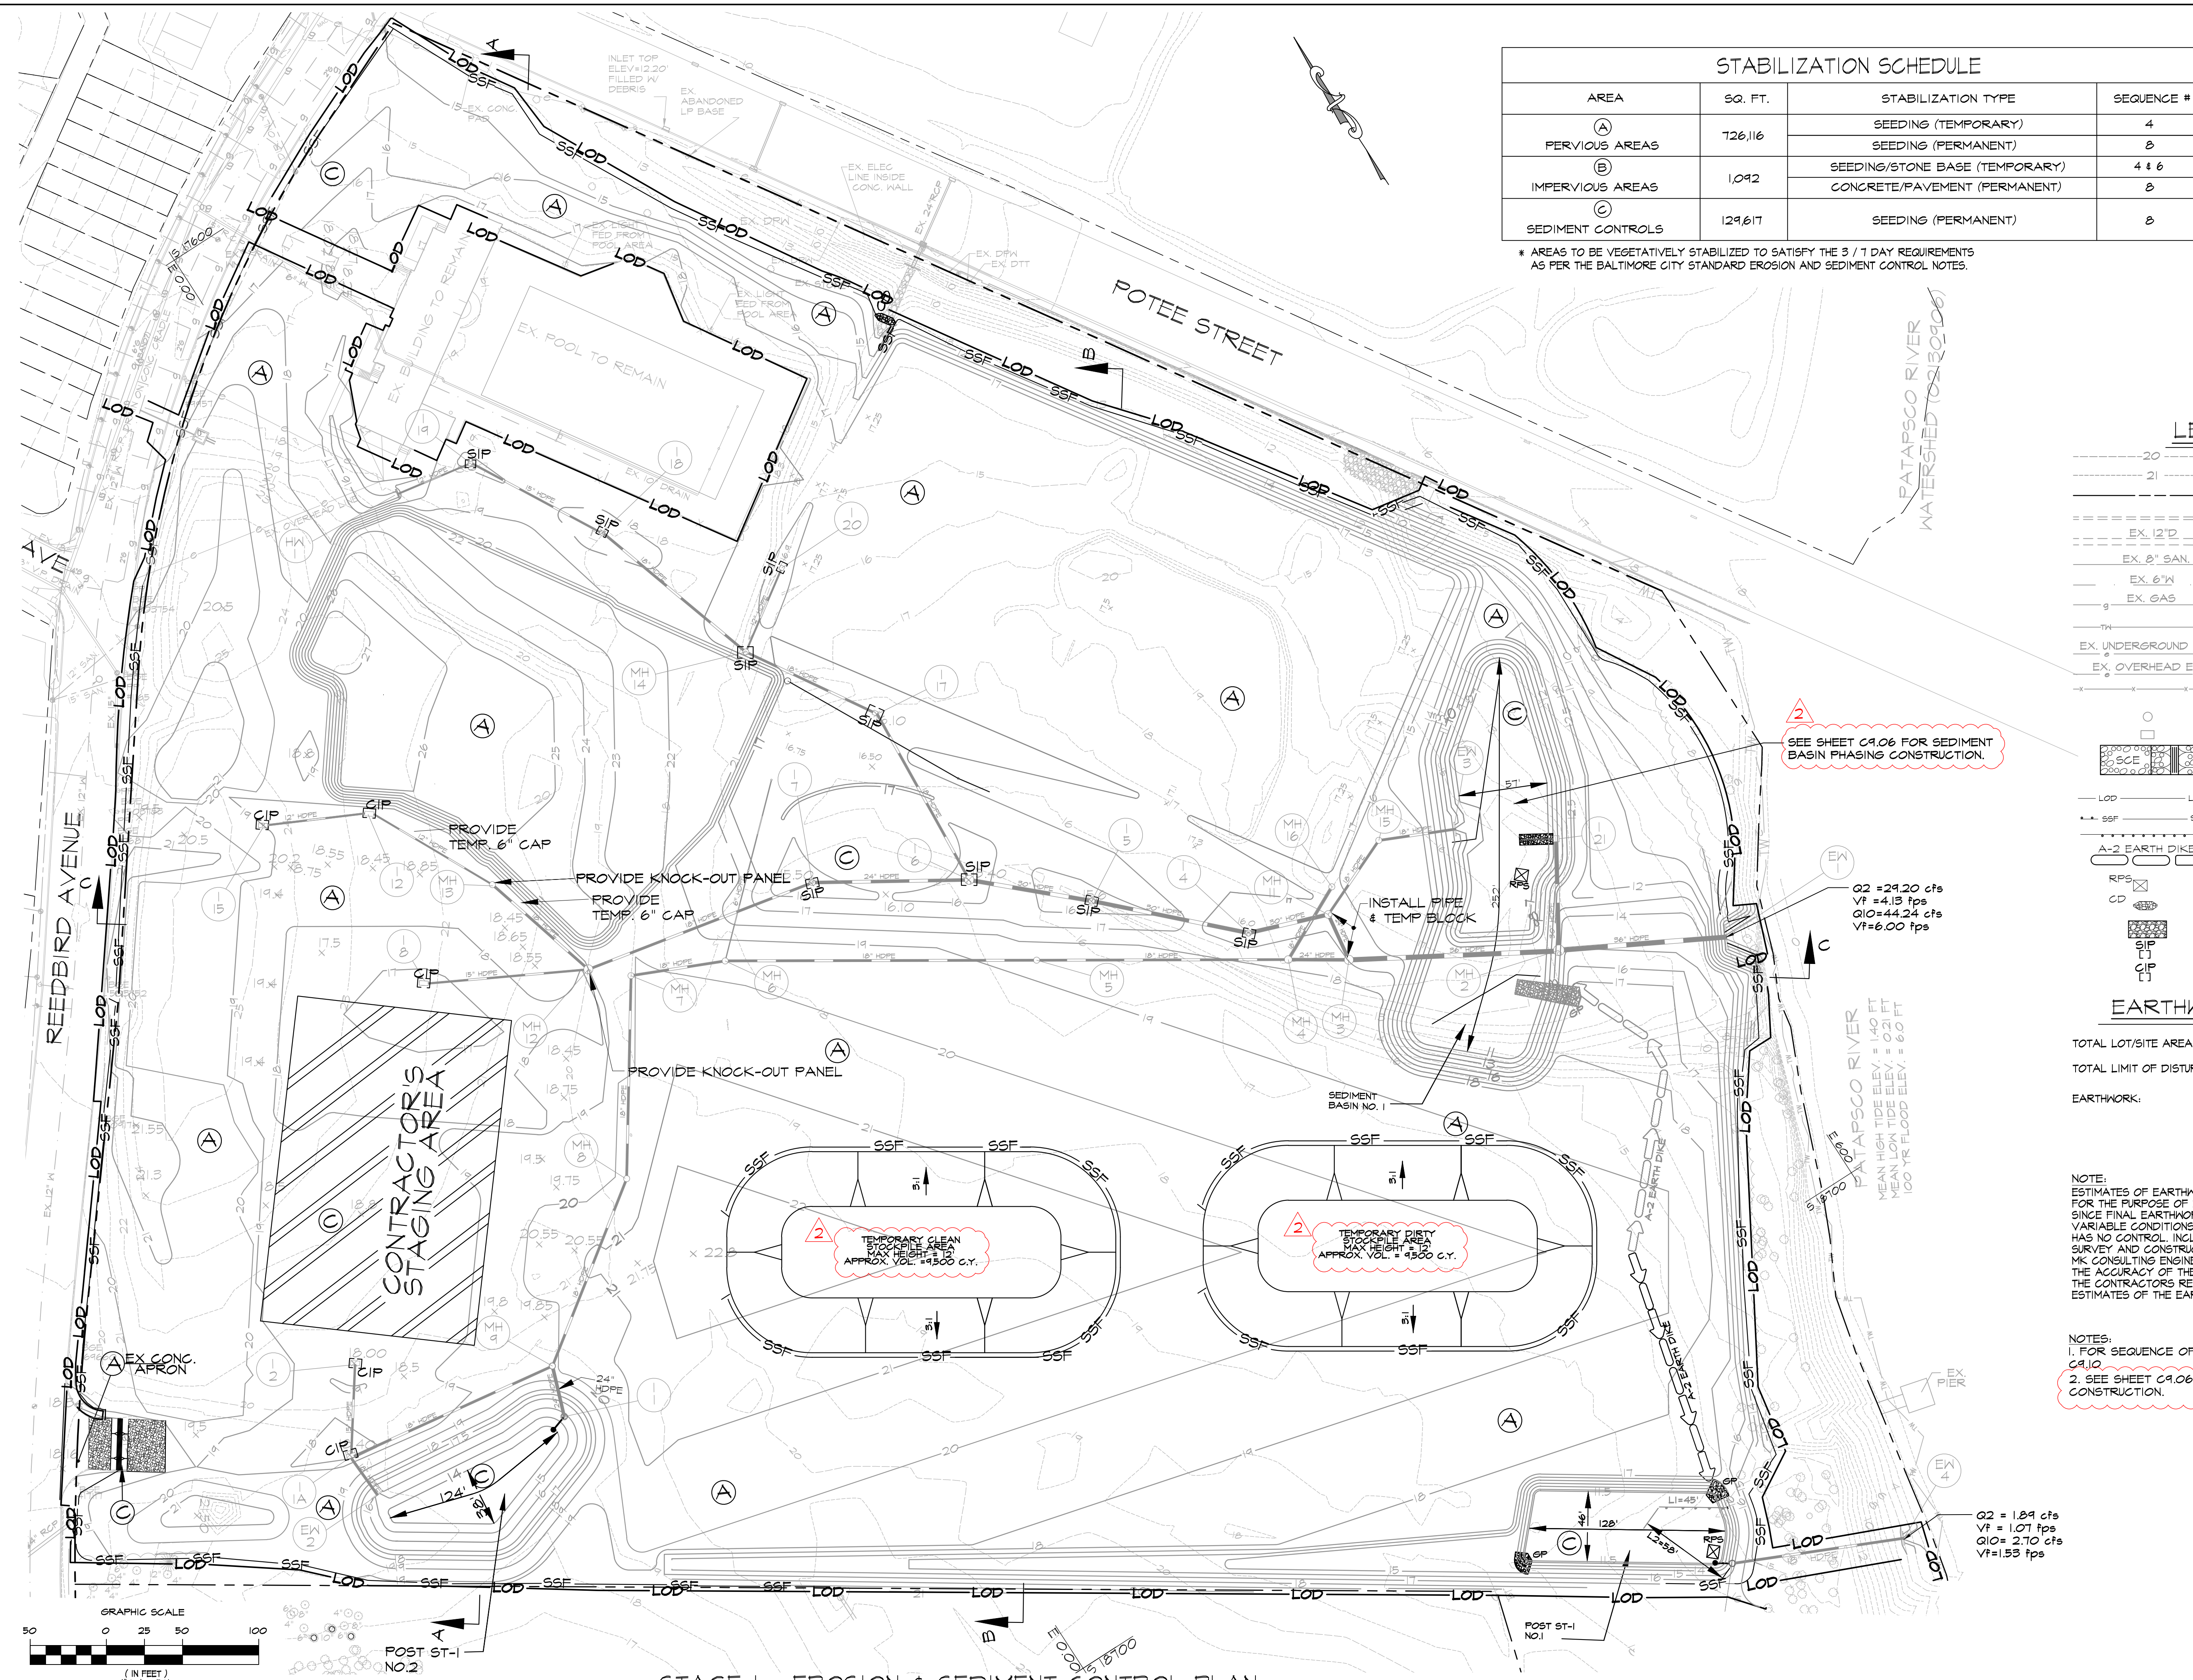

STAGE I - EROSION & SEDIMENT CONTROL PLAN
SCALE: 1" = 50'

STABILIZATION SCHEDULE			
AREA	SQ. FT.	STABILIZATION TYPE	SEQUENCE #
(A) PERVIOUS AREAS	726,116	SEEDING (TEMPORARY)	4
		SEEDING (PERMANENT)	8
(B) IMPERVIOUS AREAS	1,042	SEEDING/STONE BASE (TEMPORARY)	4 & 6
		CONCRETE/PAVEMENT (PERMANENT)	8
SEDIMENT CONTROLS	129,617	SEEDING (PERMANENT)	8

* AREAS TO BE VEGETATIVELY STABILIZED TO SATISFY THE 3 / 1 DAY REQUIREMENTS AS PER THE BALTIMORE CITY STANDARD EROSION AND SEDIMENT CONTROL NOTES.

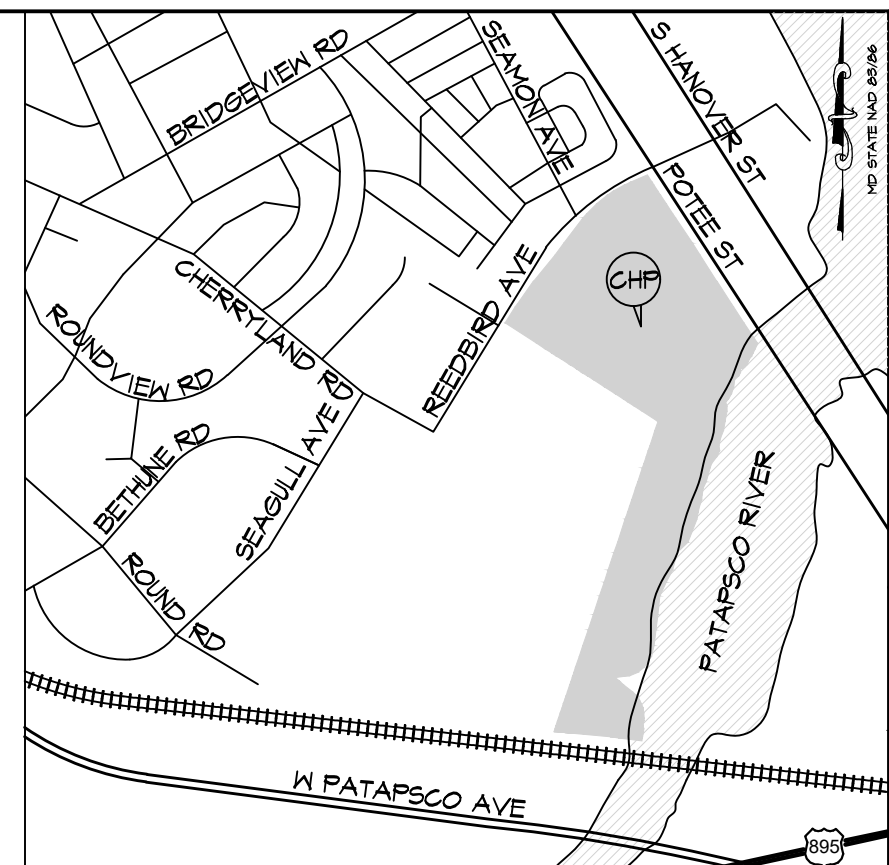

VICINITY MAP
SCALE: 1" = 1000'

- LEGEND**
- 20 --- EX. INDEX CONTOUR
 - 21 --- EX. INTERMEDIATE CONTOUR
 - --- PROPERTY LINE
 - --- EX. CURB AND GUTTER
 - EX. 12" D --- EX. STORM DRAIN
 - EX. 8" SAN --- EX. SANITARY SEWER
 - EX. 6" W --- EX. WATER
 - EX. GAS --- EX. GAS
 - --- EX. TIDAL WETLANDS
 - --- EX. UNDERGROUND ELEC.
 - --- EX. OVERHEAD ELEC.
 - --- EX. FENCE
 - --- EX. MANHOLE
 - --- EX. INLET
 - --- STABILIZED CONSTRUCTION ENTRANCE W/ MOUNTABLE BERM
 - LOD --- LIMIT OF DISTURBANCE
 - SFF --- SUPER SILT FENCE
 - --- Baffle Board
 - A-2 --- EARTH DIKE
 - RPS --- REMOVABLE PUMPING STATION
 - CD --- CHECK DAM
 - --- GABION INFLOW PROTECTION
 - SIP --- STANDARD INLET PROTECTION
 - CIP --- CURB INLET PROTECTION

EARTHWORK ANALYSIS

TOTAL LOT/SITE AREA: 32.97 AC.
 TOTAL LIMIT OF DISTURBANCE: 842,450 S.F. OR 19.94 AC.
 EARTHWORK: CUT = 25,446 C.Y.
 FILL = 33,794 C.Y.
 CUT / FILL RATIO = 1.33 : 1

EXCESS FILL MATERIAL SHALL BE RELOCATED ONSITE TO AN APPROVED LOCATION PER ENGINEER.

NOTE:
 ESTIMATES OF EARTHWORK QUANTITIES ARE PROVIDED SOLELY FOR THE PURPOSE OF DETERMINING PERMITTING REQUIREMENTS. SINCE FINAL EARTHWORK QUANTITIES ARE BASED ON MANY VARIABLE CONDITIONS, OVER WHICH MK CONSULTING ENGINEERS, LLC, HAS NO CONTROL, INCLUDING VARIABILITY OF SOILS, ALLOWABLE SURVEY AND CONSTRUCTION TOLERANCES AND COMPACTION RATIOS, MK CONSULTING ENGINEERS, LLC, DOES NOT WARRANT OR GUARANTEE THE ACCURACY OF THE ESTIMATES FOR FINAL CONSTRUCTION. IT IS THE CONTRACTOR'S RESPONSIBILITY TO PROVIDE THEIR OWN ESTIMATES OF THE EARTHWORK QUANTITIES.

NOTES:
 1. FOR SEQUENCE OF CONSTRUCTION SEE SHEET C9.10.
 2. SEE SHEET C9.06 FOR SEDIMENT BASIN PHASING CONSTRUCTION.

KEY PLAN

KEYNOTES LISTED ON THIS SHEET ARE FOR CONVENIENCE ONLY. REFER TO SHEET CS.3 FOR COMPLETE LIST

ISSUED FOR BID

mk
 Consulting Engineers, LLC
 Wheat Mill
 3300 Clippert Mill Road, Suite 201
 Baltimore, MD 21211
 667-308-6183

G|W
 W|O
 GWVO INC.
 800 WYMAN PARK DRIVE, SUITE 300
 BALTIMORE, MARYLAND 21211, 410-332-0209
 © 2019 GWVO INC.

CERTIFY THAT THESE DOCUMENTS WERE PREPARED OR APPROVED BY ME, AND THAT I AM A DULY LICENSED ENGINEER UNDER THE LAWS OF THE STATE OF MARYLAND. LICENSE NUMBER: 25098, EXPIRATION DATE: 11/17/20

Revisions	No.	Date	Description
	2	1/28/20	Addendum #2


MIDDLE BRANCH FITNESS & WELLNESS CENTER AT CHERRY HILL
 BALTIMORE CITY RECREATION & PARKS

Job No.	18010	Author	SG
Scale	1"=50'	Checker	AP
Date	1/28/2019	Approver	SM
Drawing Title	STAGE I - EROSION & SEDIMENT CONTROL PLAN		
Sheet		Drawing Number	C9.00r2

BENCHMARK DATA

ALL HORIZONTAL AND VERTICAL SURVEY DATA CONTAINED HEREIN ARE REFERENCED TO THE CITY OF BALTIMORE COORDINATE SYSTEM AS DERIVED FROM THE FOLLOWING BENCHMARKS FROM THE PLAN ENTITLED 'REEDBIRD TOPO' DATED APRIL 2018, BY NAVARRO & KRIGT

POINT#	NORTHING	EASTING	DESCRIPTION
1	-11900.95	-34.48	REBAR AND CAP
2	-18007.42	130.90	REBAR AND CAP

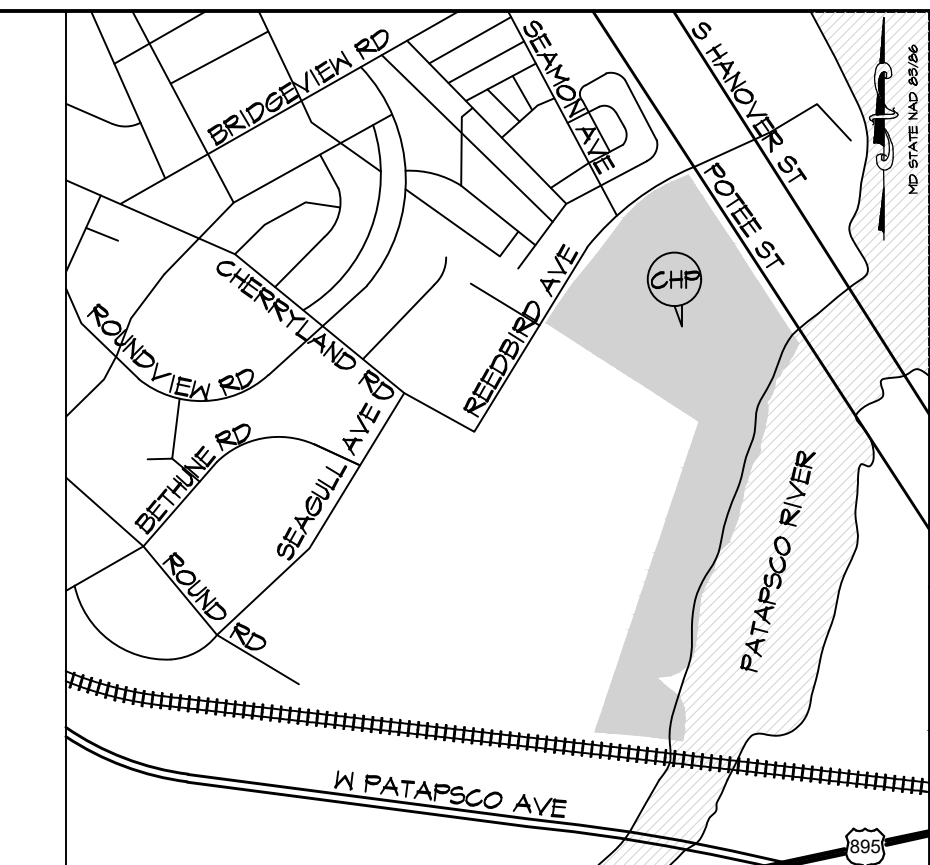

VICINITY MAP
SCALE: 1" = 1000'


KEY PLAN

KEYNOTES LISTED ON THIS SHEET ARE FOR CONVENIENCE ONLY. REFER TO SHEET CS.3 FOR COMPLETE LIST



LEGEND

- 20 --- EX. INDEX CONTOUR
- 21 --- EX. INTERMEDIATE CONTOUR
- --- PROPERTY LINE
- --- EX. CURB AND GUTTER
- --- EX. STORM DRAIN
- --- EX. 8" SAN.
- --- EX. 6" W.
- --- EX. 6" GAS
- --- EX. UNDERGROUND ELEC.
- --- EX. OVERHEAD ELEC.
- --- EX. FENCE
- --- EX. MANHOLE
- --- EX. INLET
- --- DRAINAGE AREA BOUNDARY LINES
- --- STABILIZED CONSTRUCTION ENTRANCE WITH MOUNTABLE BERM
- --- LOD --- LOD --- LIMIT OF DISTURBANCE
- --- SSF --- SSF --- SUPER SILT FENCE
- --- DF --- DF --- DIVERSION FENCE
- --- BAFFLE BOARD
- --- A-2 EARTH DIKE --- EARTH DIKE
- --- RPS --- RPS --- REMOVABLE PUMPING STATION
- --- CD --- CD --- CHECK DAM
- --- GABION --- GABION --- GABION INFLOW PROTECTION

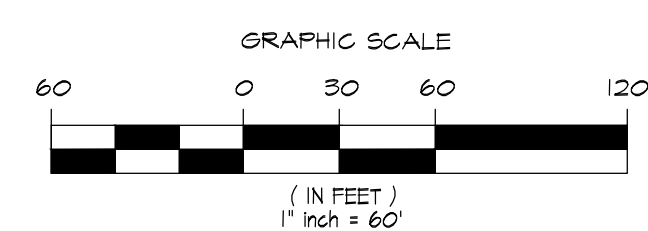

EROSION & SEDIMENT CONTROL EXISTING DRAINAGE AREA MAP
SCALE: 1" = 60'

ISSUED FOR BID

mk
Consulting Engineers, LLC
3300 Clippert Mill Road, Suite 201
Baltimore, MD 21211
667-308-6163

G|W|O
GWIO INC.
800 WYMAN PARK DRIVE, SUITE 300
BALTIMORE, MARYLAND 21211, 410-332-0099

CERTIFY THAT THESE DOCUMENTS WERE PREPARED OR APPROVED BY ME, AND THAT I AM A FULLY LICENSED ENGINEER UNDER THE LAWS OF THE STATE OF MARYLAND. LICENSE NUMBER: 25598, EXPIRATION DATE: 11/17/20

Revisions:

No.	Date	Description
2	1/28/20	Addendum #2

MIDDLE BRANCH FITNESS & WELLNESS CENTER AT CHERRY HILL
BALTIMORE CITY RECREATION & PARKS


Job No.	18010	Author	SG
Scale		Checker	AP
Date	1/28/2019	Approver	SM

Drawing Title: **EROSION & SEDIMENT CONTROL PLAN EX. DA**
Drawing Number: **C9.02r2**

BENCHMARK DATA


ALL HORIZONTAL AND VERTICAL SURVEY DATA CONTAINED HEREIN ARE REFERENCED TO THE CITY OF BALTIMORE COORDINATE SYSTEM AS DERIVED FROM THE FOLLOWING BENCHMARKS FROM THE PLAN ENTITLED "REEDBIRD TOPO" DATED APRIL 2018, BY NAVARRO & WRIGHT

POINT#	NORTHING	EASTING	DESCRIPTION
1	-11900.95	-34.48	REBAR AND CAP
2	-18007.42	130.90	REBAR AND CAP

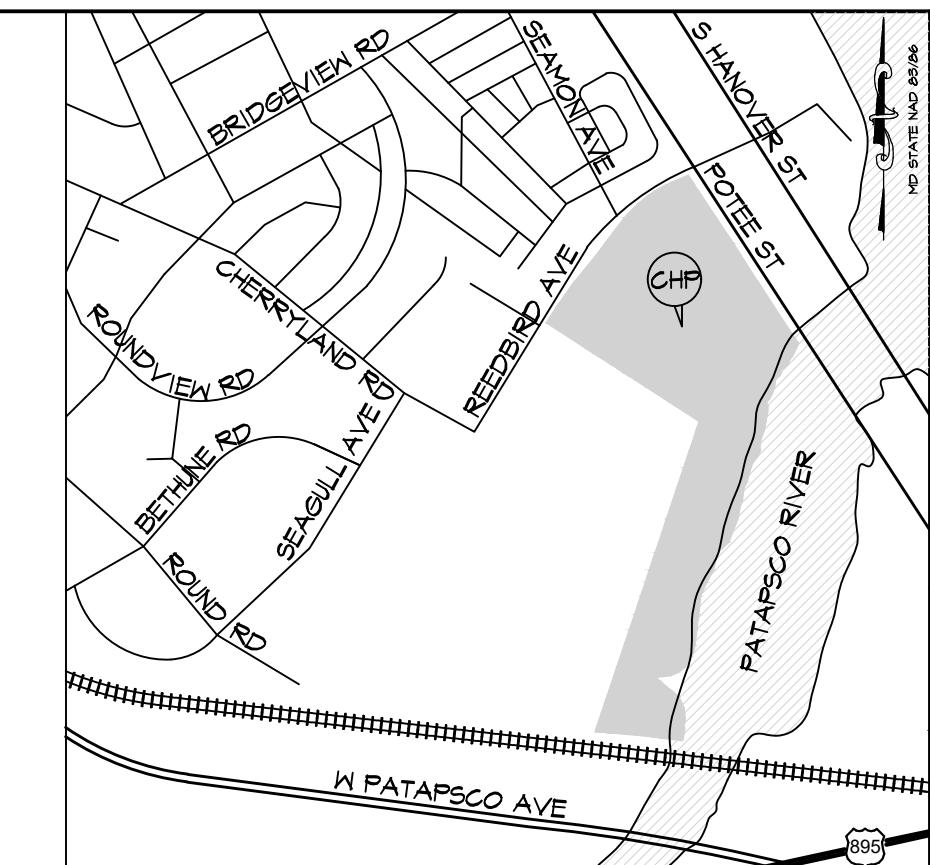

KEY PLAN


KEYNOTES LISTED ON THIS SHEET ARE FOR CONVENIENCE ONLY. REFER TO SHEET CS.3 FOR COMPLETE LIST

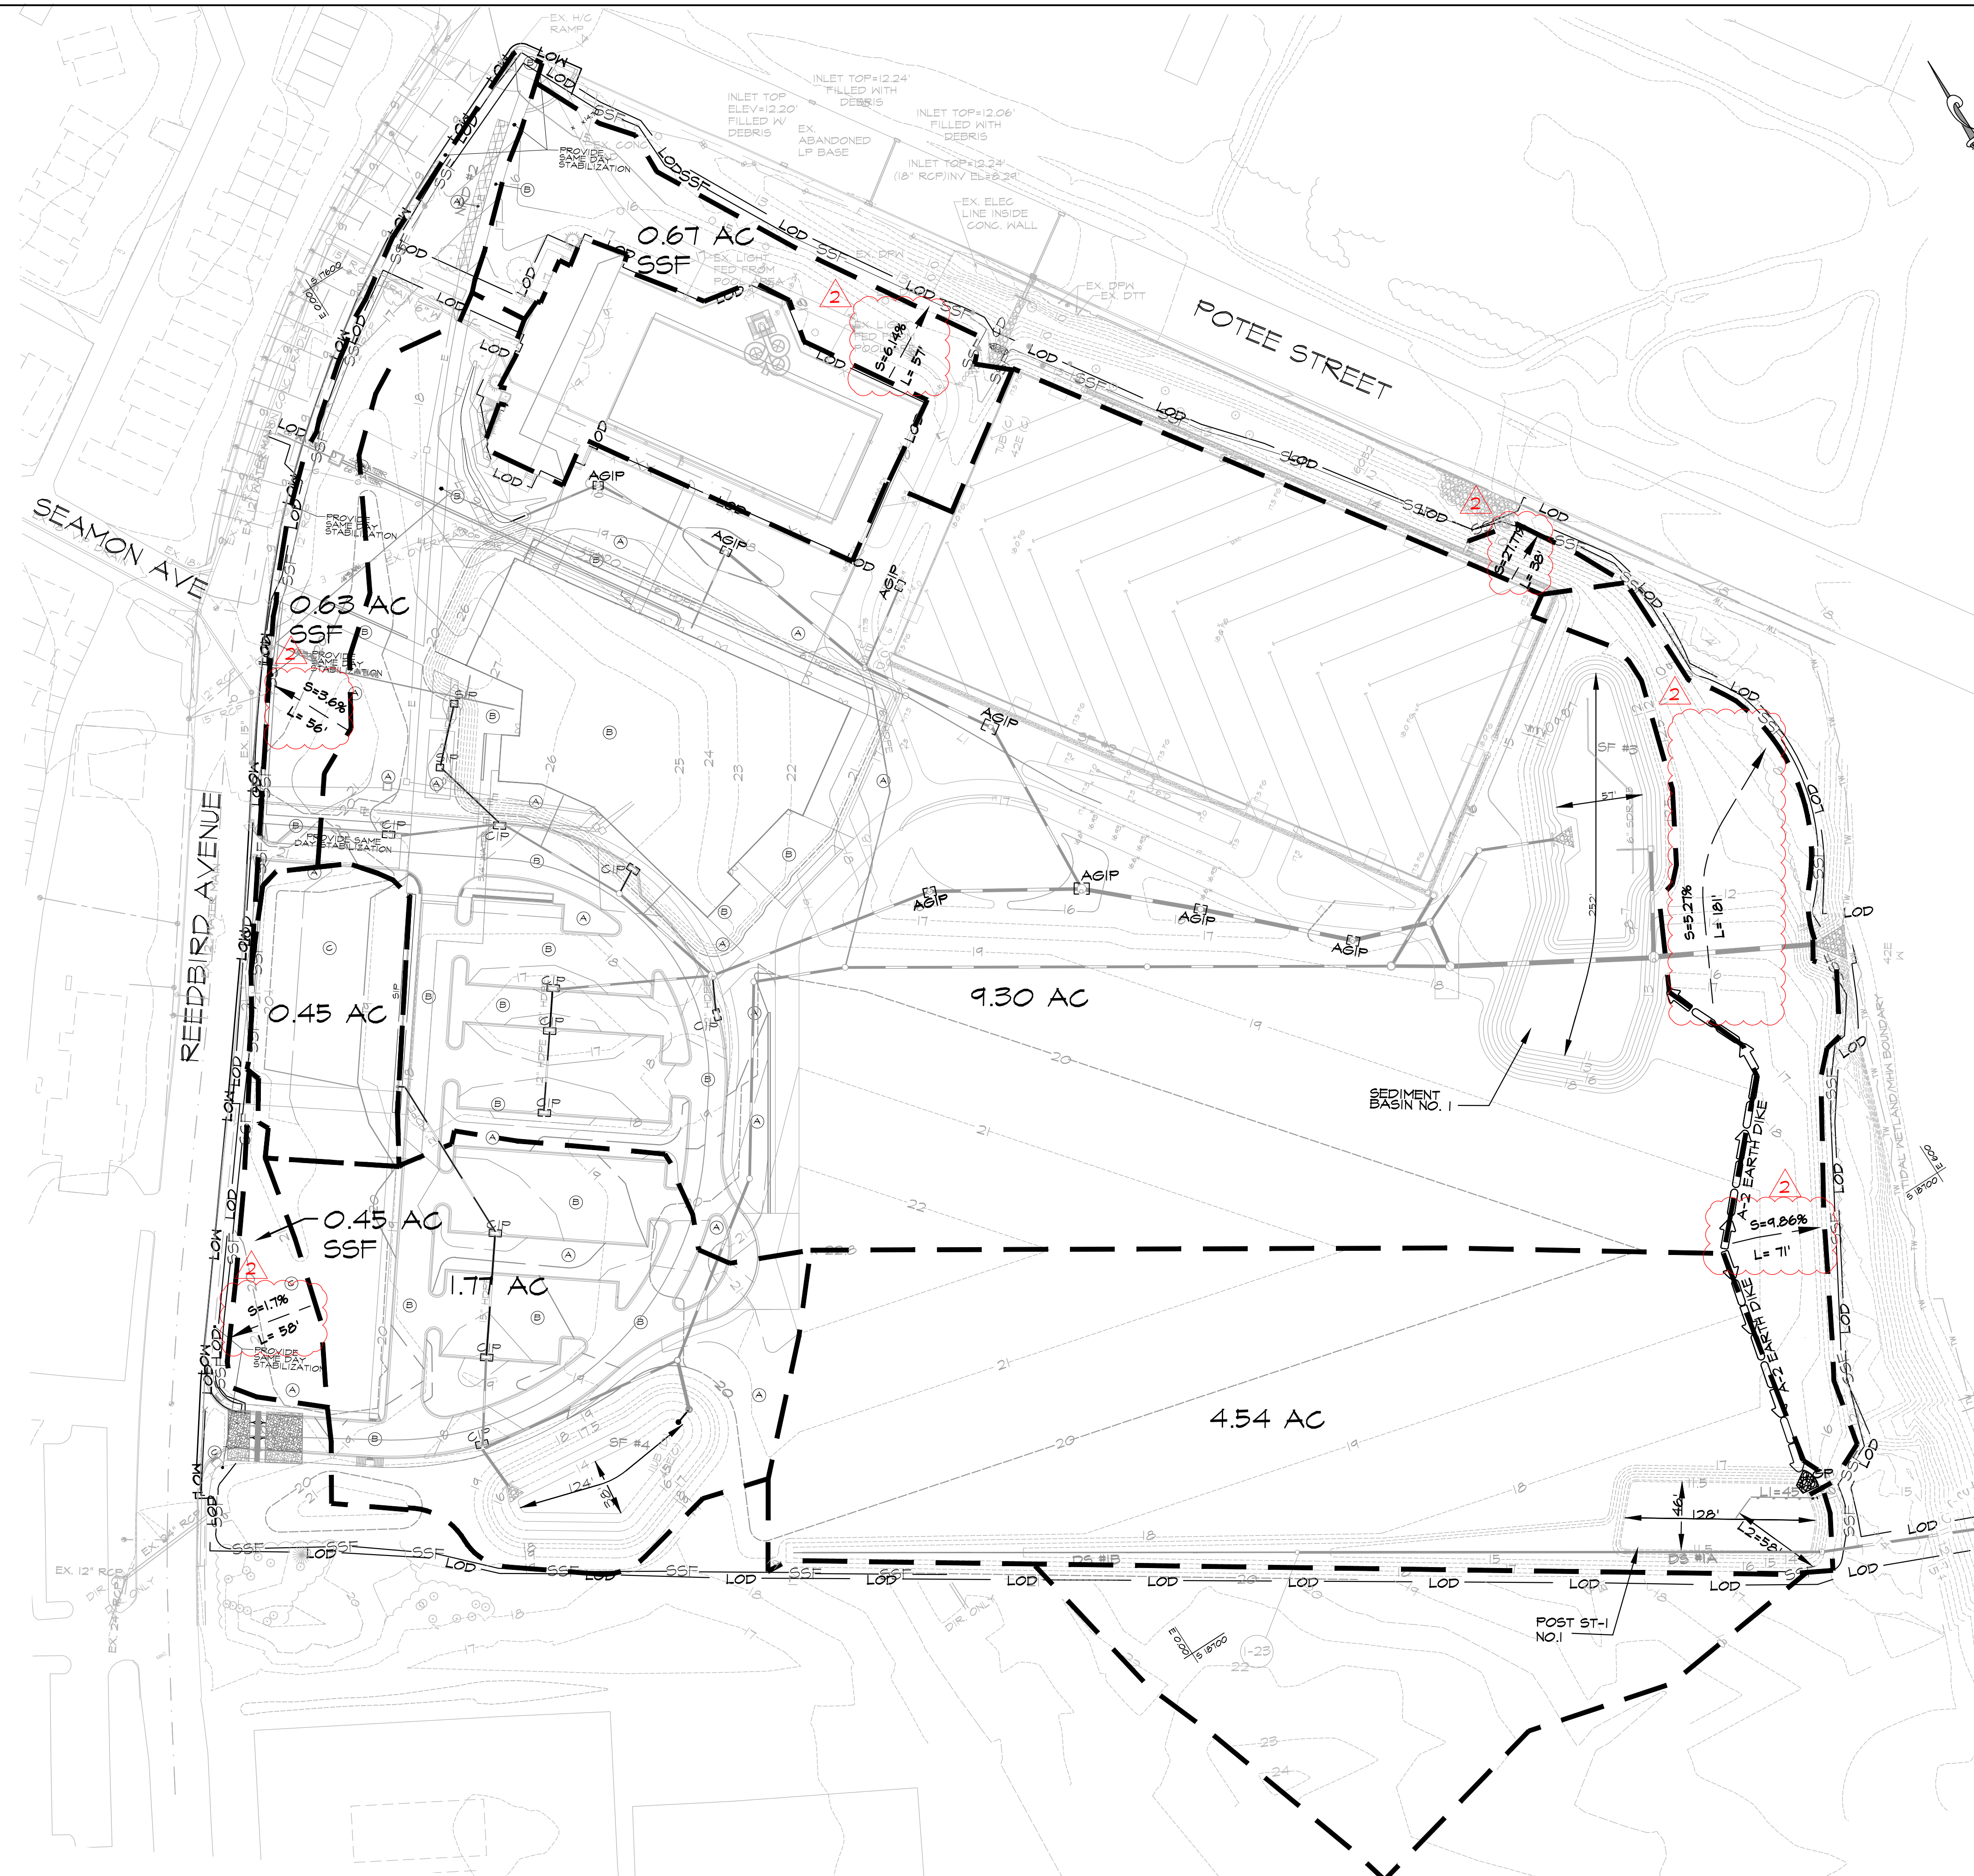

LEGEND

---	EX. INDEX CONTOUR
---	EX. INTERMEDIATE CONTOUR
---	PROPERTY LINE
---	EX. CURB AND GUTTER
---	EX. STORM DRAIN
---	EX. 8" SAN.
---	EX. SANITARY SEWER
---	EX. WATER
---	EX. GAS
---	EX. UNDERGROUND ELEC.
---	EX. OVERHEAD ELEC.
---	EX. FENCE
---	EX. MANHOLE
---	EX. INLET
---	DRAINAGE AREA BOUNDARY LINES
---	STABILIZED CONSTRUCTION ENTRANCE WITH MOUNTABLE BERM
---	LIMIT OF DISTURBANCE
---	SUPER SILT FENCE
---	DIVERSION FENCE
---	BAFFLE BOARD
---	EARTH DIKE
---	REMOVABLE PUMPING STATION
---	CHECK DAM
---	GABION INFLOW PROTECTION

PATAPSCO RIVER
MEAN HIGH TIDE ELEV. = 140 FT
MEAN LOW TIDE ELEV. = 0.25 FT
100 YR FLOOD ELEV. = 60 FT

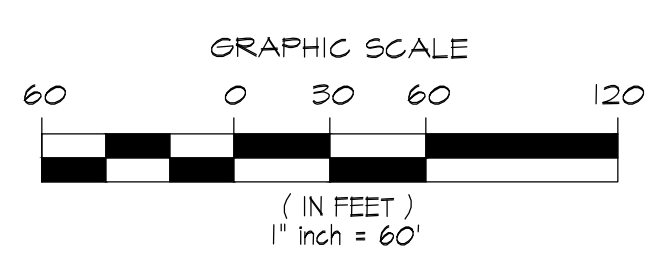

EROSION & SEDIMENT CONTROL PROPOSED DRAINAGE AREA MAP
SCALE: 1" = 60'

ISSUED FOR BID



© 2019 GW|O INC.
I CERTIFY THAT THESE DOCUMENTS WERE PREPARED OR APPROVED BY ME, AND THAT I AM A DULY LICENSED ENGINEER UNDER THE LAWS OF THE STATE OF MARYLAND. LICENSE NUMBER: 25598, EXPIRATION DATE: 11/17/20.

Revisions:

No.	Date	Description
2	1/28/20	Addendum #2

MIDDLE BRANCH FITNESS & WELLNESS CENTER AT CHERRY HILL
BALTIMORE CITY RECREATION & PARKS


Job No.	18010	Author	SG
Scale		Checker	AP
Date	1/28/2019	Approver	SM

Drawing Title: EROSION & SEDIMENT CONTROL PLAN PROP. DA
Drawing Number: **C9.03r2**



EMBANKMENT CENTERLINE DATA			
STA.	BEARING / RADIUS	DISTANCE / ARC LENGTH	CHORD
0+00			
0+03.04	4.0'	3.04'	N58°20'04.20"E L=3.01'
0+30.44	32.0'	27.40'	N55°54'15.51"E L=26.51'
0+81.06	N51°22'26.17"E	50.51'	
1+51.24	N16°12'14.65"E	76.23'	
1+78.53	32.0'	21.24'	N02°48'47.11"W L=20.85'
2+07.06	N21°44'48.86"W	28.53'	

SEDIMENT BASIN TABLE	
EXISTING DRAINAGE AREA (AC.)	8.32
INTERIM DRAINAGE AREA (AC.)	8.48
PROPOSED DRAINAGE AREA (AC.)	9.74
STORAGE REQUIRED (C.F.)	
WET	17,532
DRY	1,732
TOTAL	55,064
STORAGE PROVIDED (C.F.)	
WET	18,523
DRY	14,206
TOTAL	31,724
EXISTING GROUND ELEV.	N/A
TOP EMBANKMENT ELEV.	12.50
RISER CREST ELEV.	10.50
NET STORAGE / OUTLET ELEV.	4.00
CLEANOUT ELEV.	8.00
BOTTOM ELEV.	7.00
EMBANKMENT WIDTH	8.0'
EMERGENCY SPILLWAY WIDTH (EARTHEN)	N/A
BOTTOM DIMENSION (AVG.)	250' X 55'
TRAP SIDELOPES	3:1 / 4:1
TRAP DEPTH	
WET	2.00'
DRY	1.50'
TOTAL	3.50'
NET STORAGE ELEV. RANGE	1.00 - 4.00
DRY STORAGE ELEV. RANGE	4.00 - 10.50
TOP OF BAFFLE ELEV.	9.75


BASIN STRUCTURE SCHEDULE				
NO.	TYPE	NORTHING	EASTING	REMARKS
MH-2	TYPE 'C' PRECAST 24" MANHOLE	-18485.06	510.74	SEE BC STD BC 383.07
I-2	PRECAST CONCRETE RISER	-18410.78	556.04	SEE DETAILS SHEET C4.05
EW-3	PRECAST ENDWALL	-18370.54	506.18	SEE BC STD BC 354.02
MH-15	TYPE 'C' PRECAST 48" MANHOLE	-18348.58	451.71	SEE BC STD BC 383.04

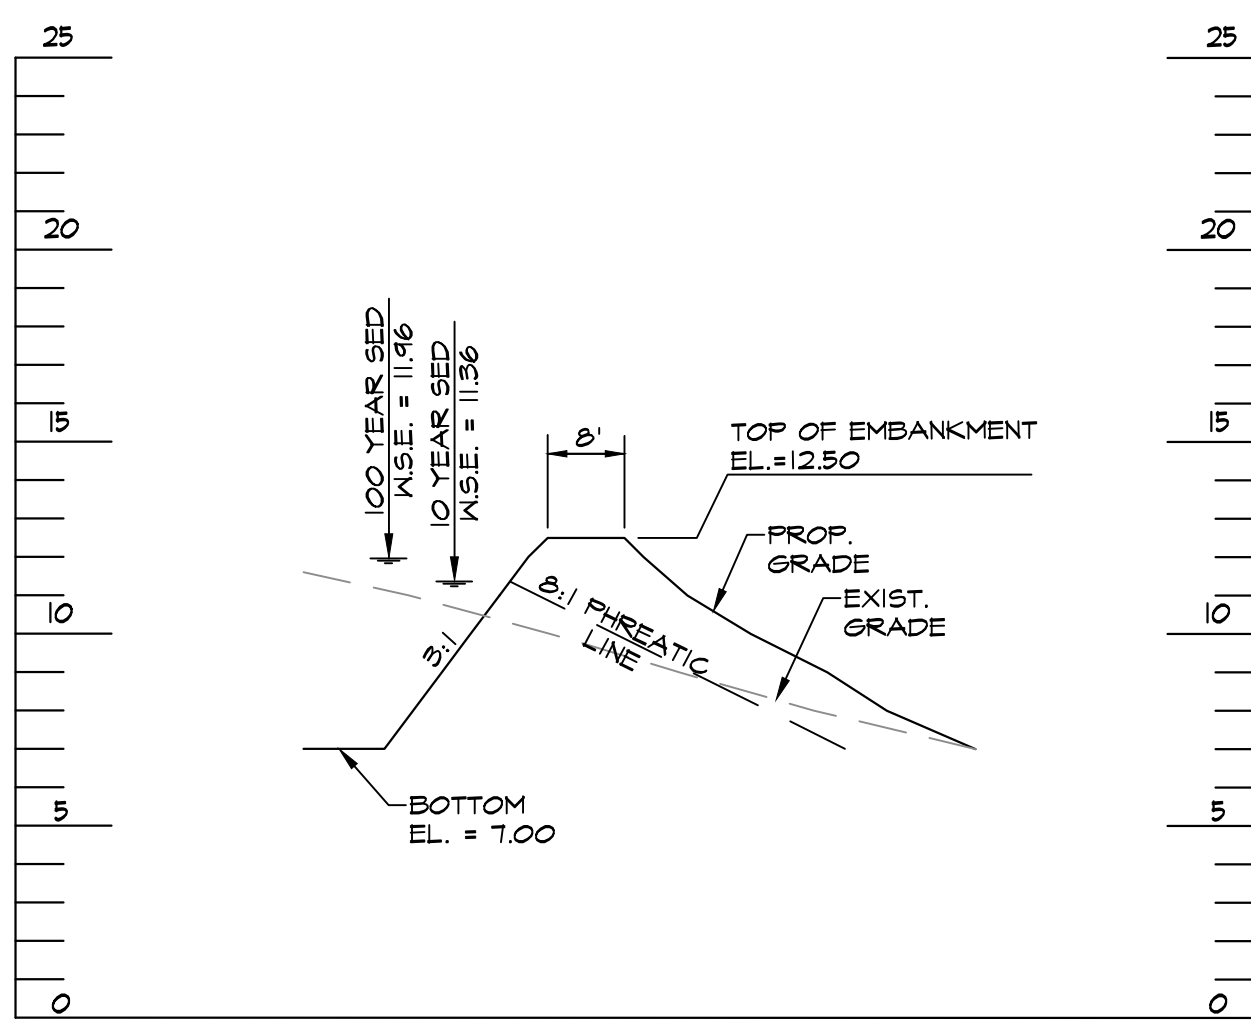


SECTION A-A THRU EMBANKMENT
SCALE: HORIZ. 1" = 20'
VERT. 1" = 5'

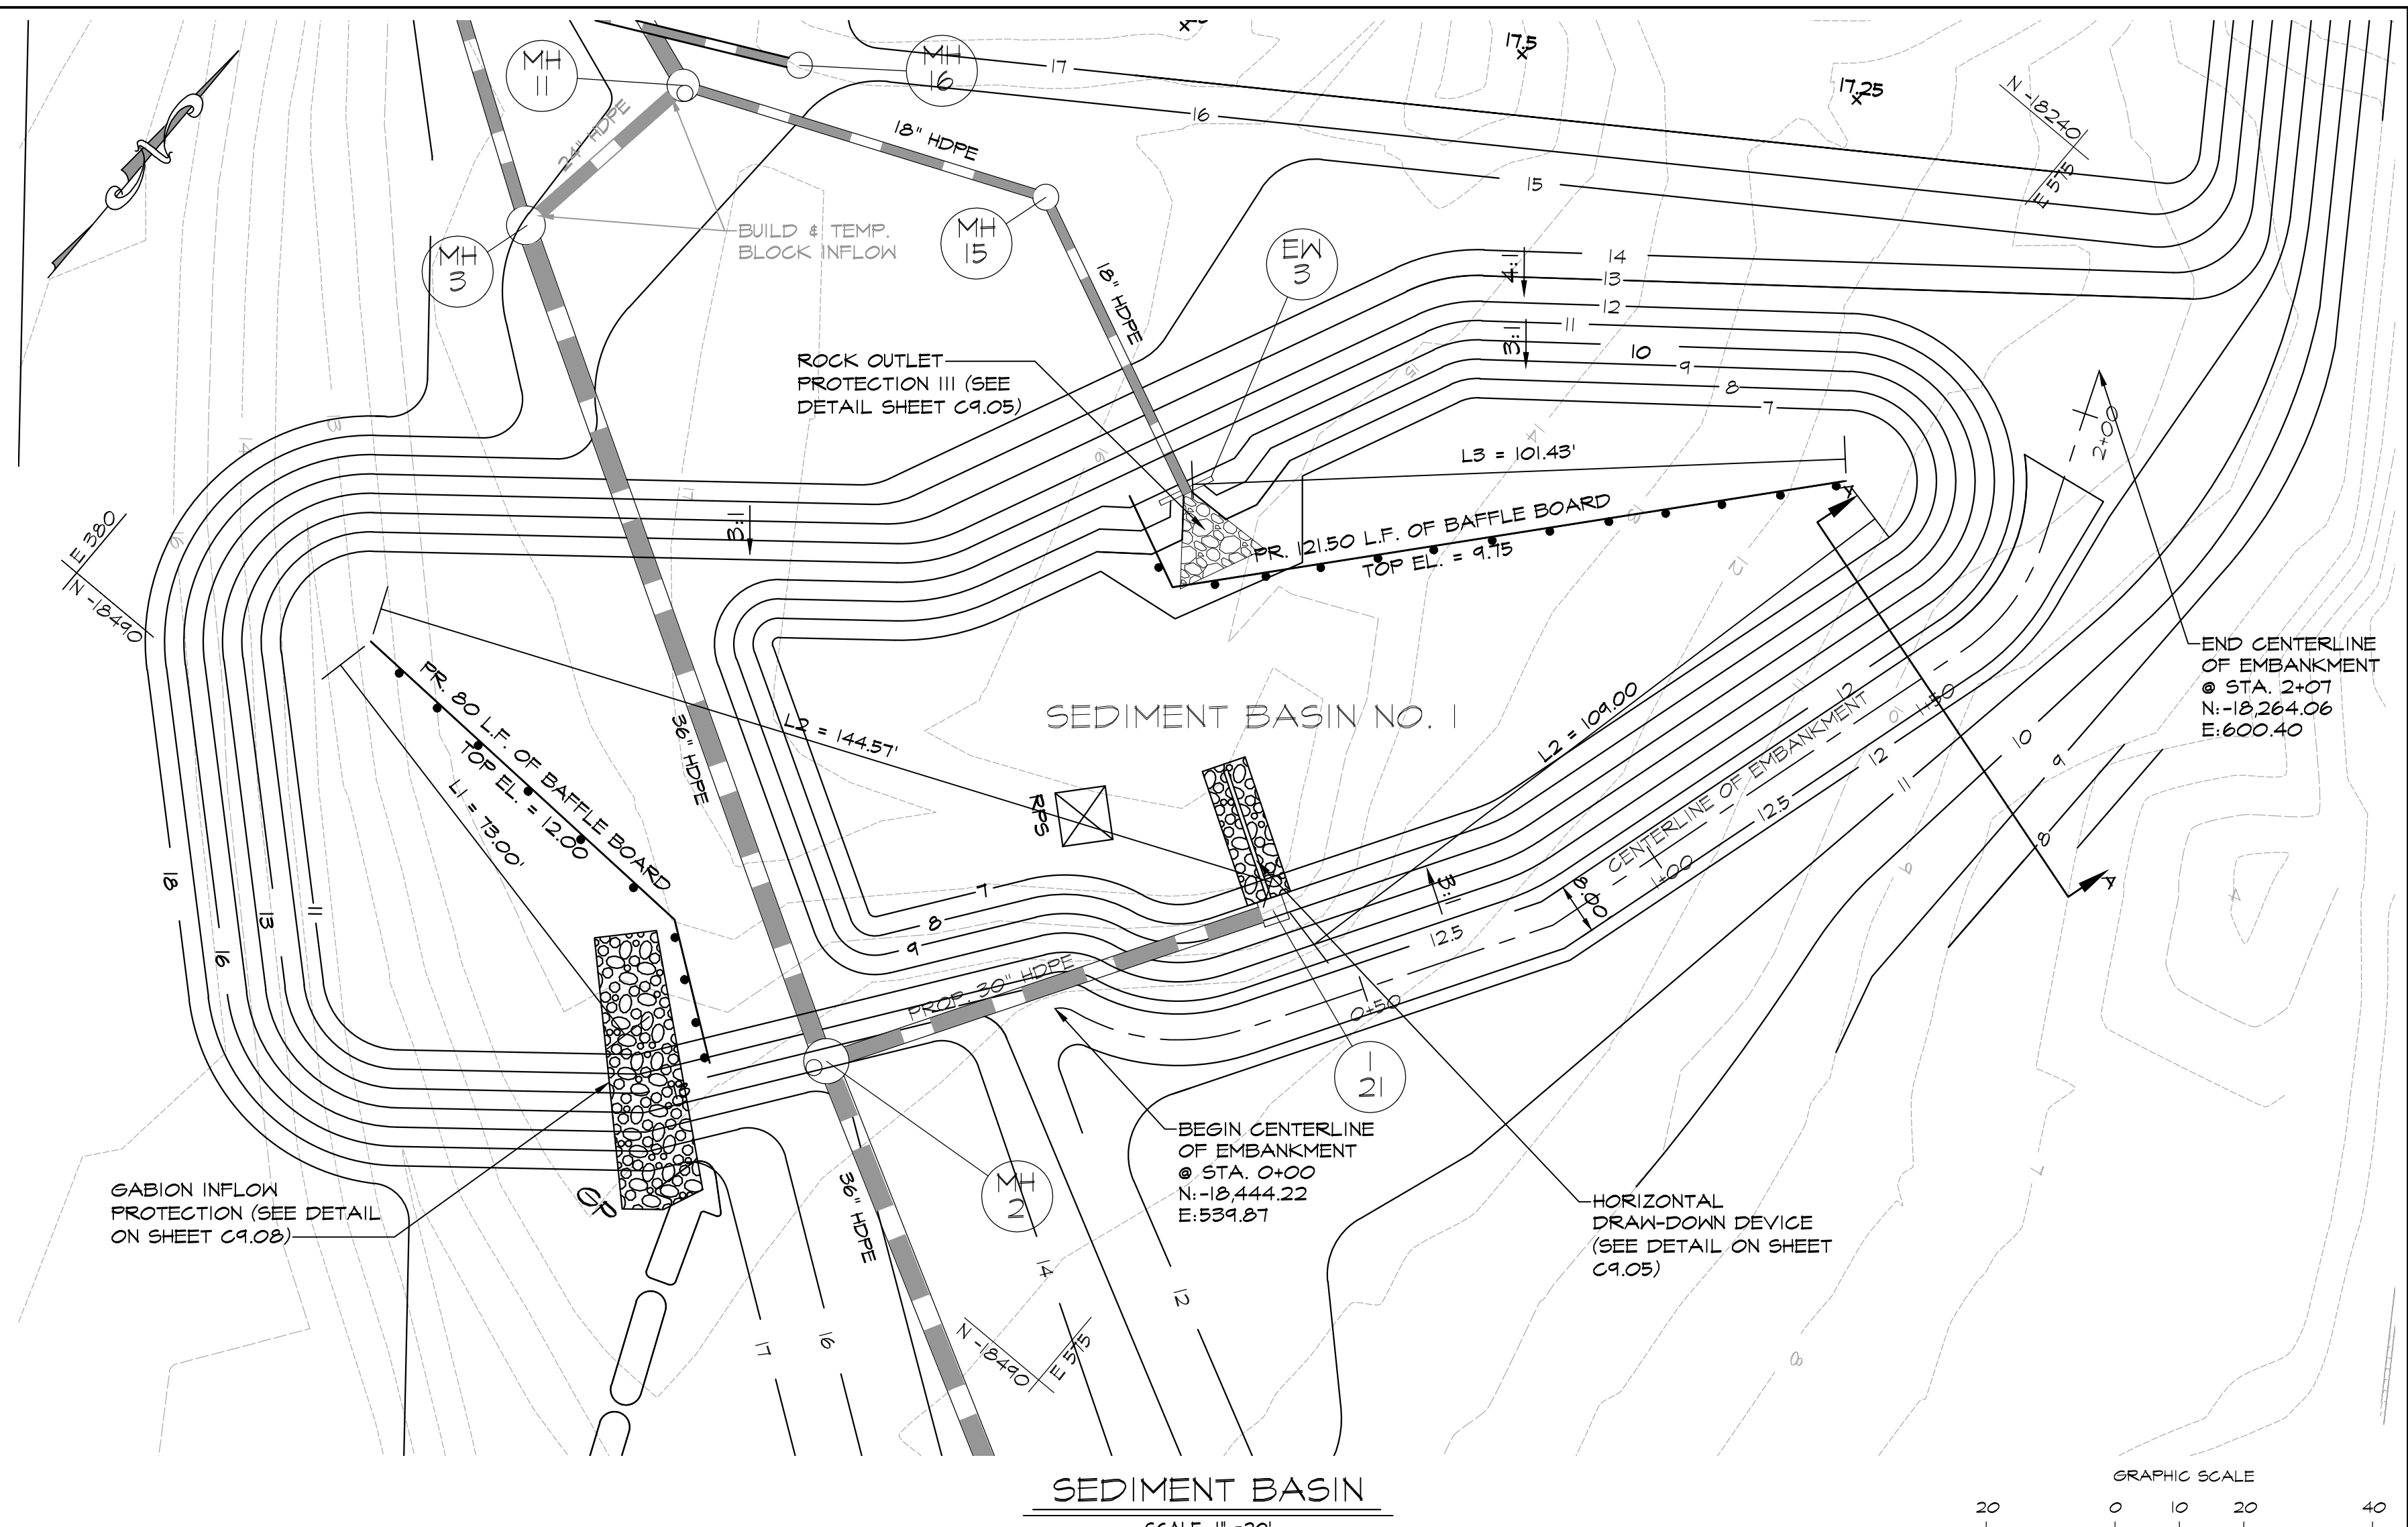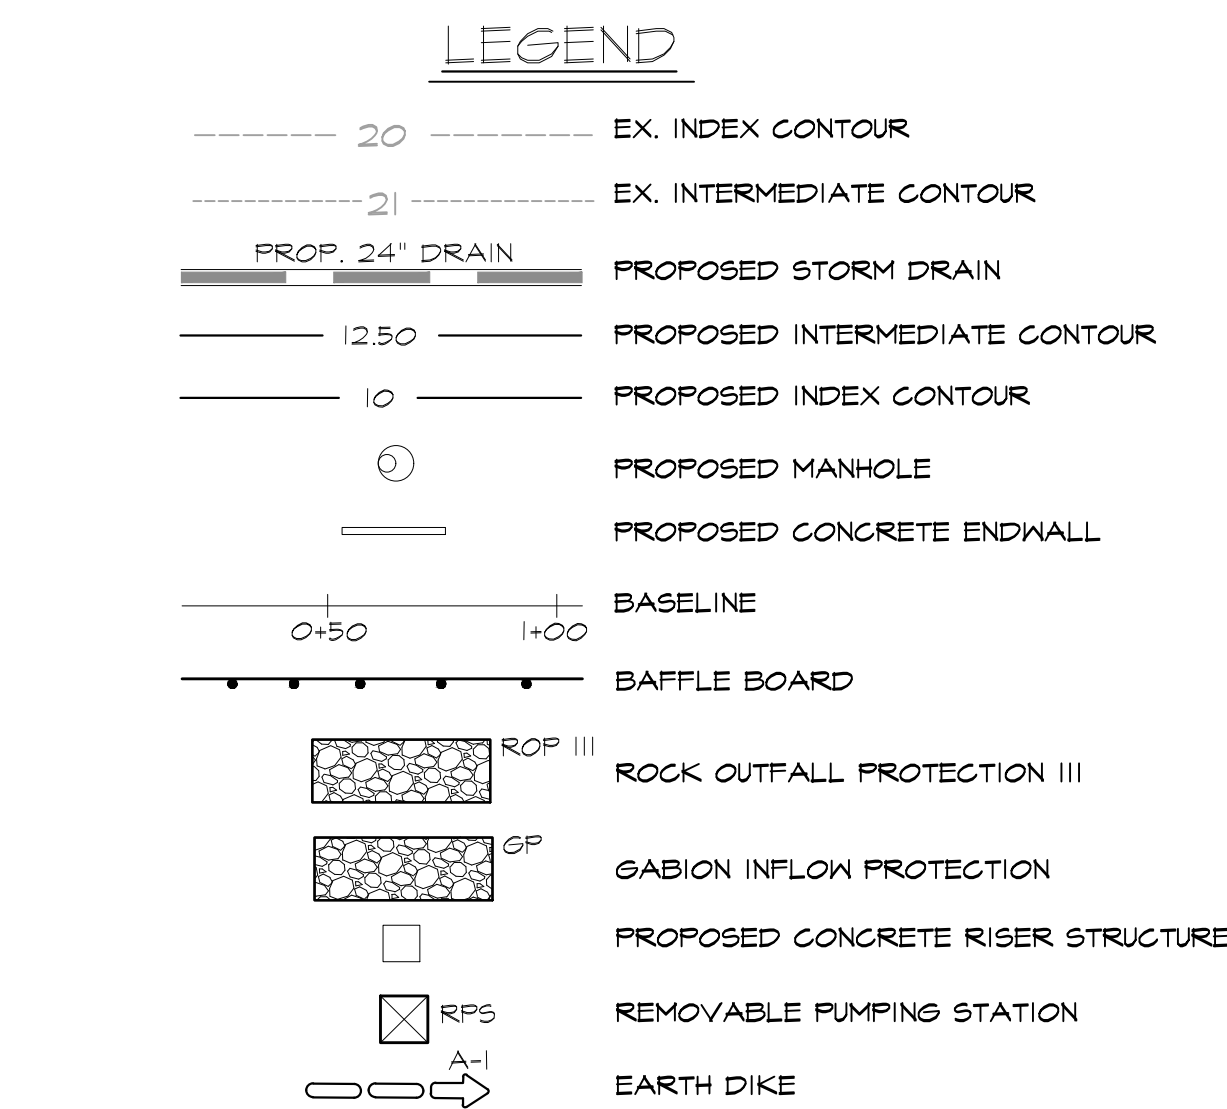

SEDIMENT BASIN
SCALE: 1" = 20'

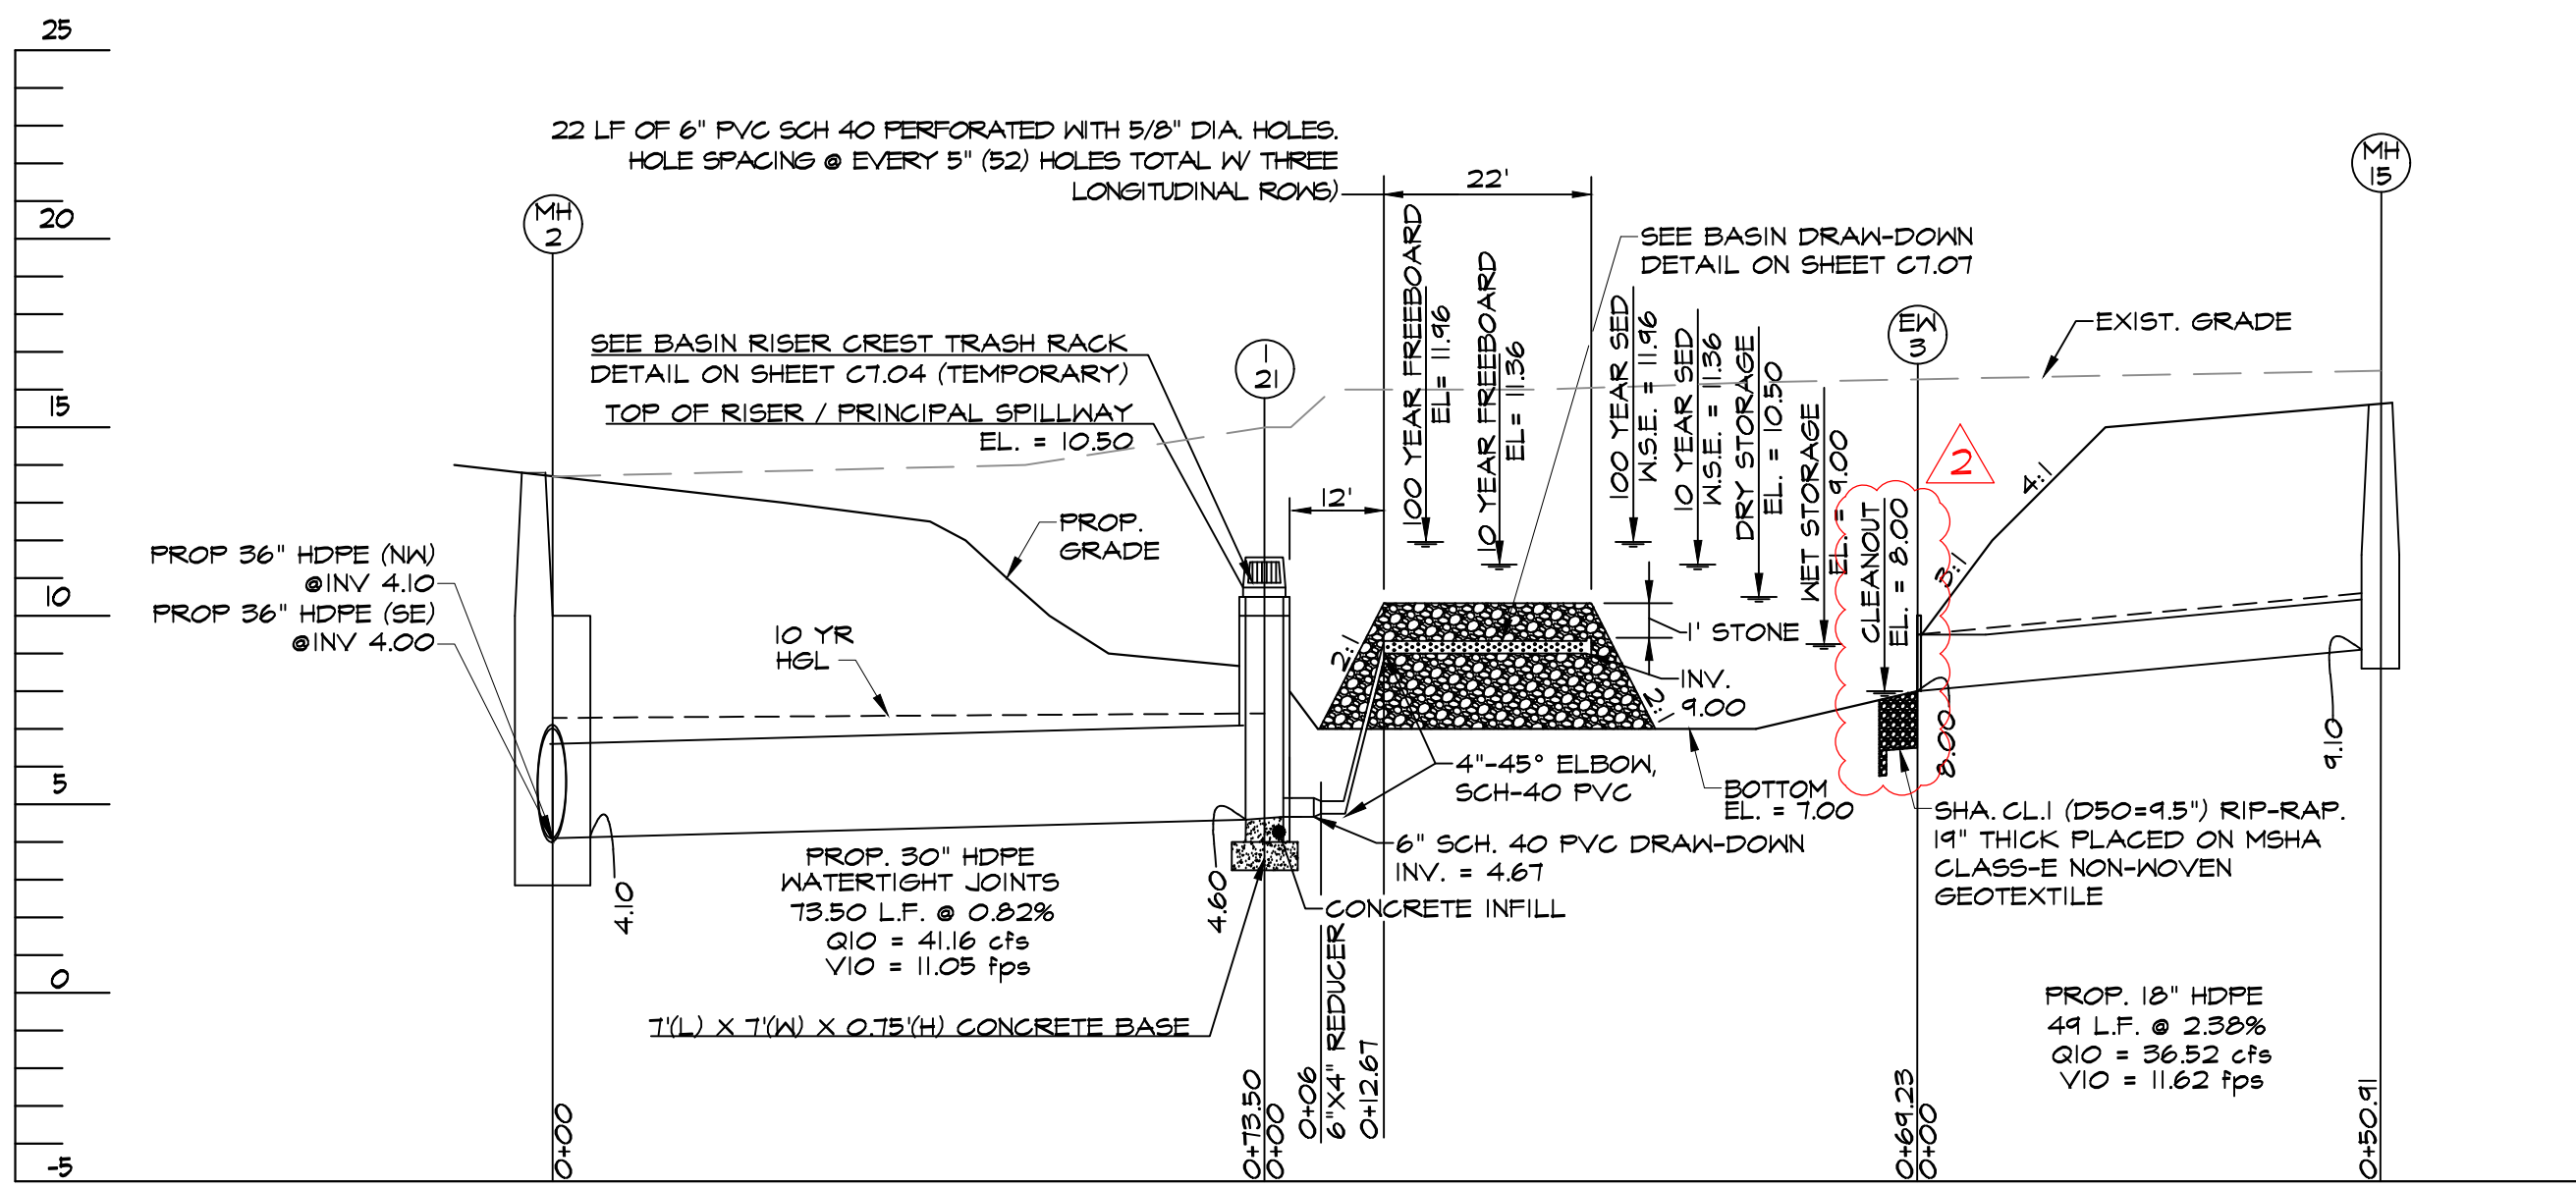

PRINCIPAL SPILLWAY PROFILE
SCALE: HORIZ. 1" = 20'
VERT. 1" = 5'

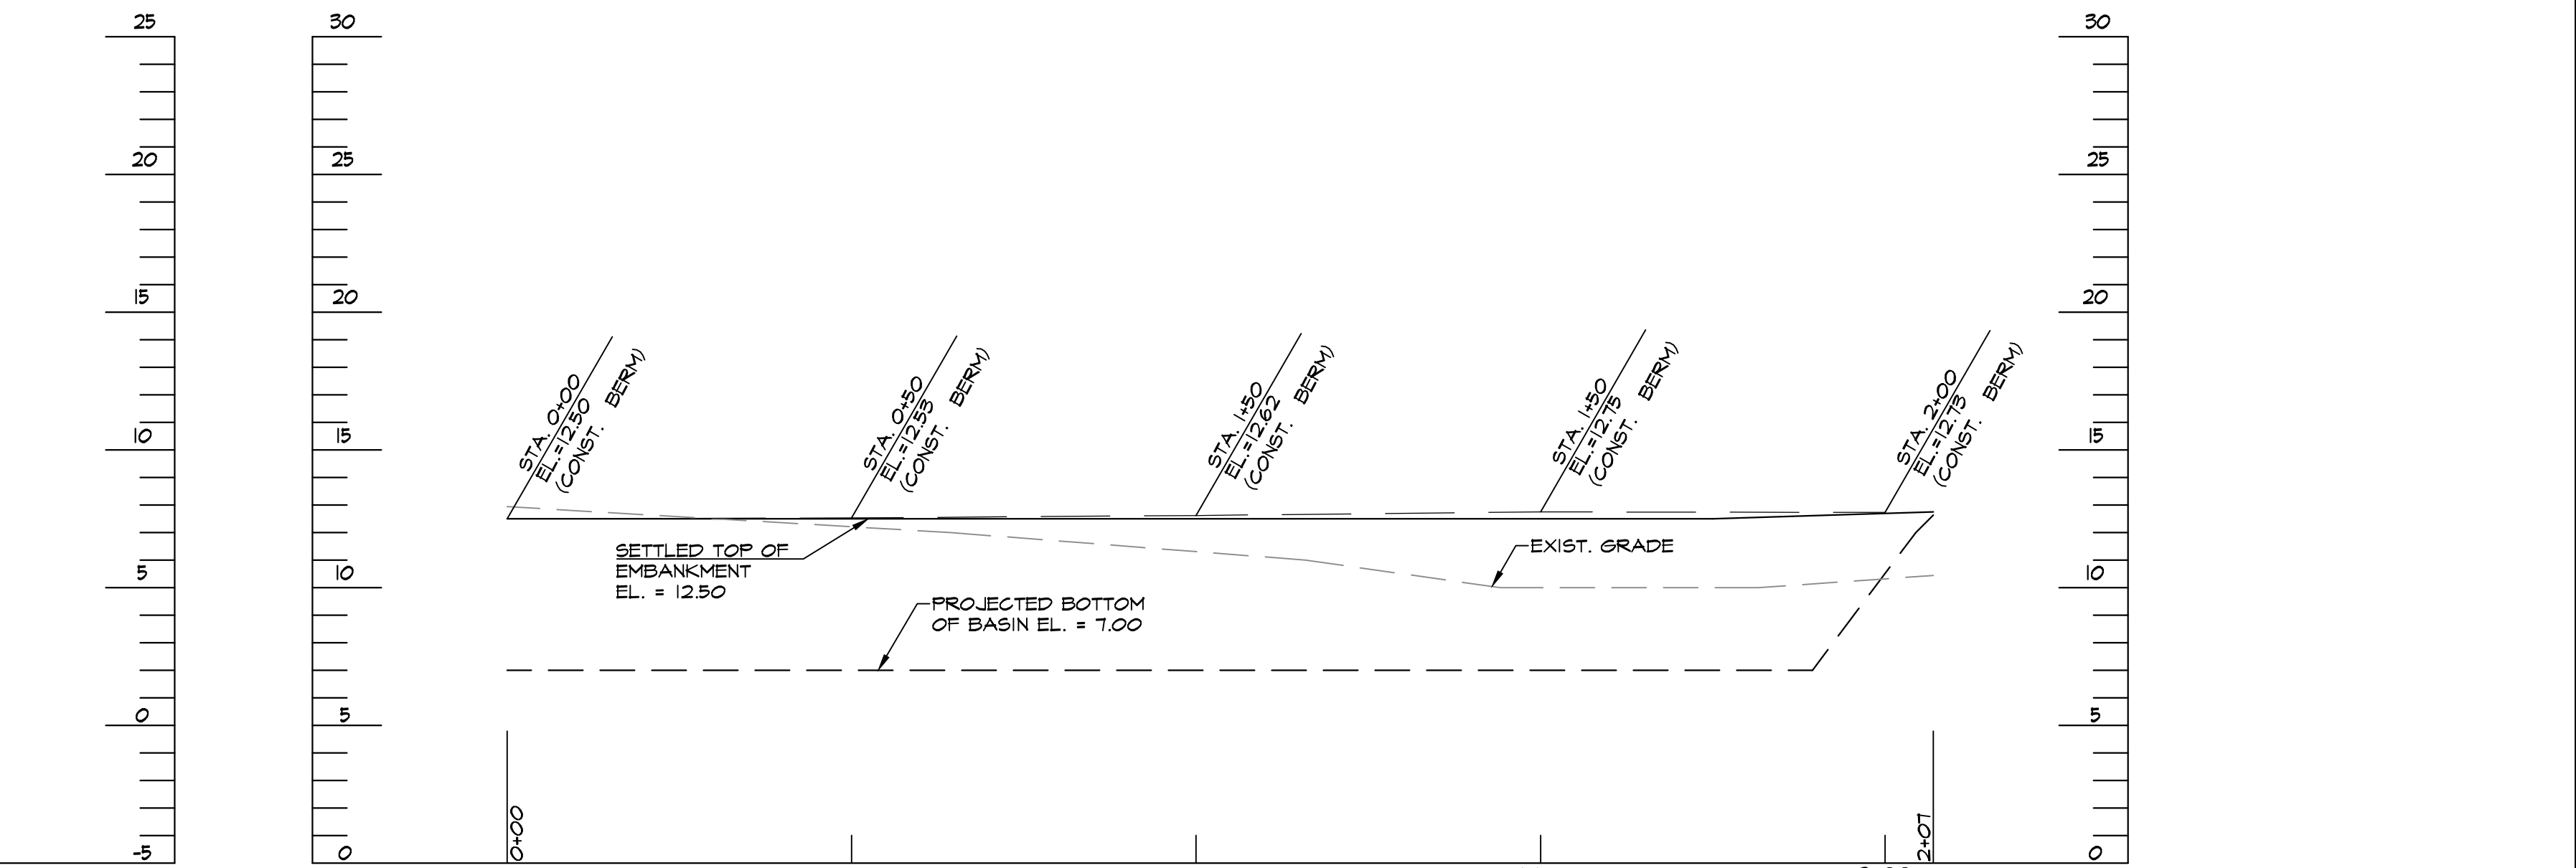

EMBANKMENT PROFILE
SCALE: HORIZ. 1" = 20'
VERT. 1" = 5'

KEY PLAN
KEYNOTES LISTED ON THIS SHEET ARE FOR CONVENIENCE ONLY. REFER TO SHEET CS.3 FOR COMPLETE LIST

ISSUED FOR BID

mk
Consulting Engineers, LLC
Whitell Hill
3300 Clipper Mill Road, Suite 201
Baltimore, MD 21211
667-308-6153

G|W|O
GWIO INC.
800 WYMAN PARK DRIVE, SUITE 300
BALTIMORE, MARYLAND 21211, 410-332-0209



© 2019 GWIO INC.
I CERTIFY THAT THESE DOCUMENTS WERE PREPARED OR APPROVED BY ME, AND THAT I AM A FULLY LICENSED ENGINEER UNDER THE LAWS OF THE STATE OF MARYLAND. LICENSE NUMBER: 25598, EXPIRATION DATE: 11/17/20.

Revisions	No.	Date	Description
	2	1/28/20	Addendum #2

MIDDLE BRANCH FITNESS & WELLNESS CENTER AT CHERRY HILL
BALTIMORE CITY RECREATION & PARKS

Job No.	18010	Author	SG
Scale	AS SHOWN	Checker	AP
Date	1/28/2019	Approver	SM
Drawing Title	EROSION & SEDIMENT CONTROL PLAN BASIN #1		
Sheet	C9.04r2		

KEYNOTES LISTED ON THIS SHEET ARE FOR CONVENIENCE ONLY. REFER TO SHEET CS.3 FOR COMPLETE LIST

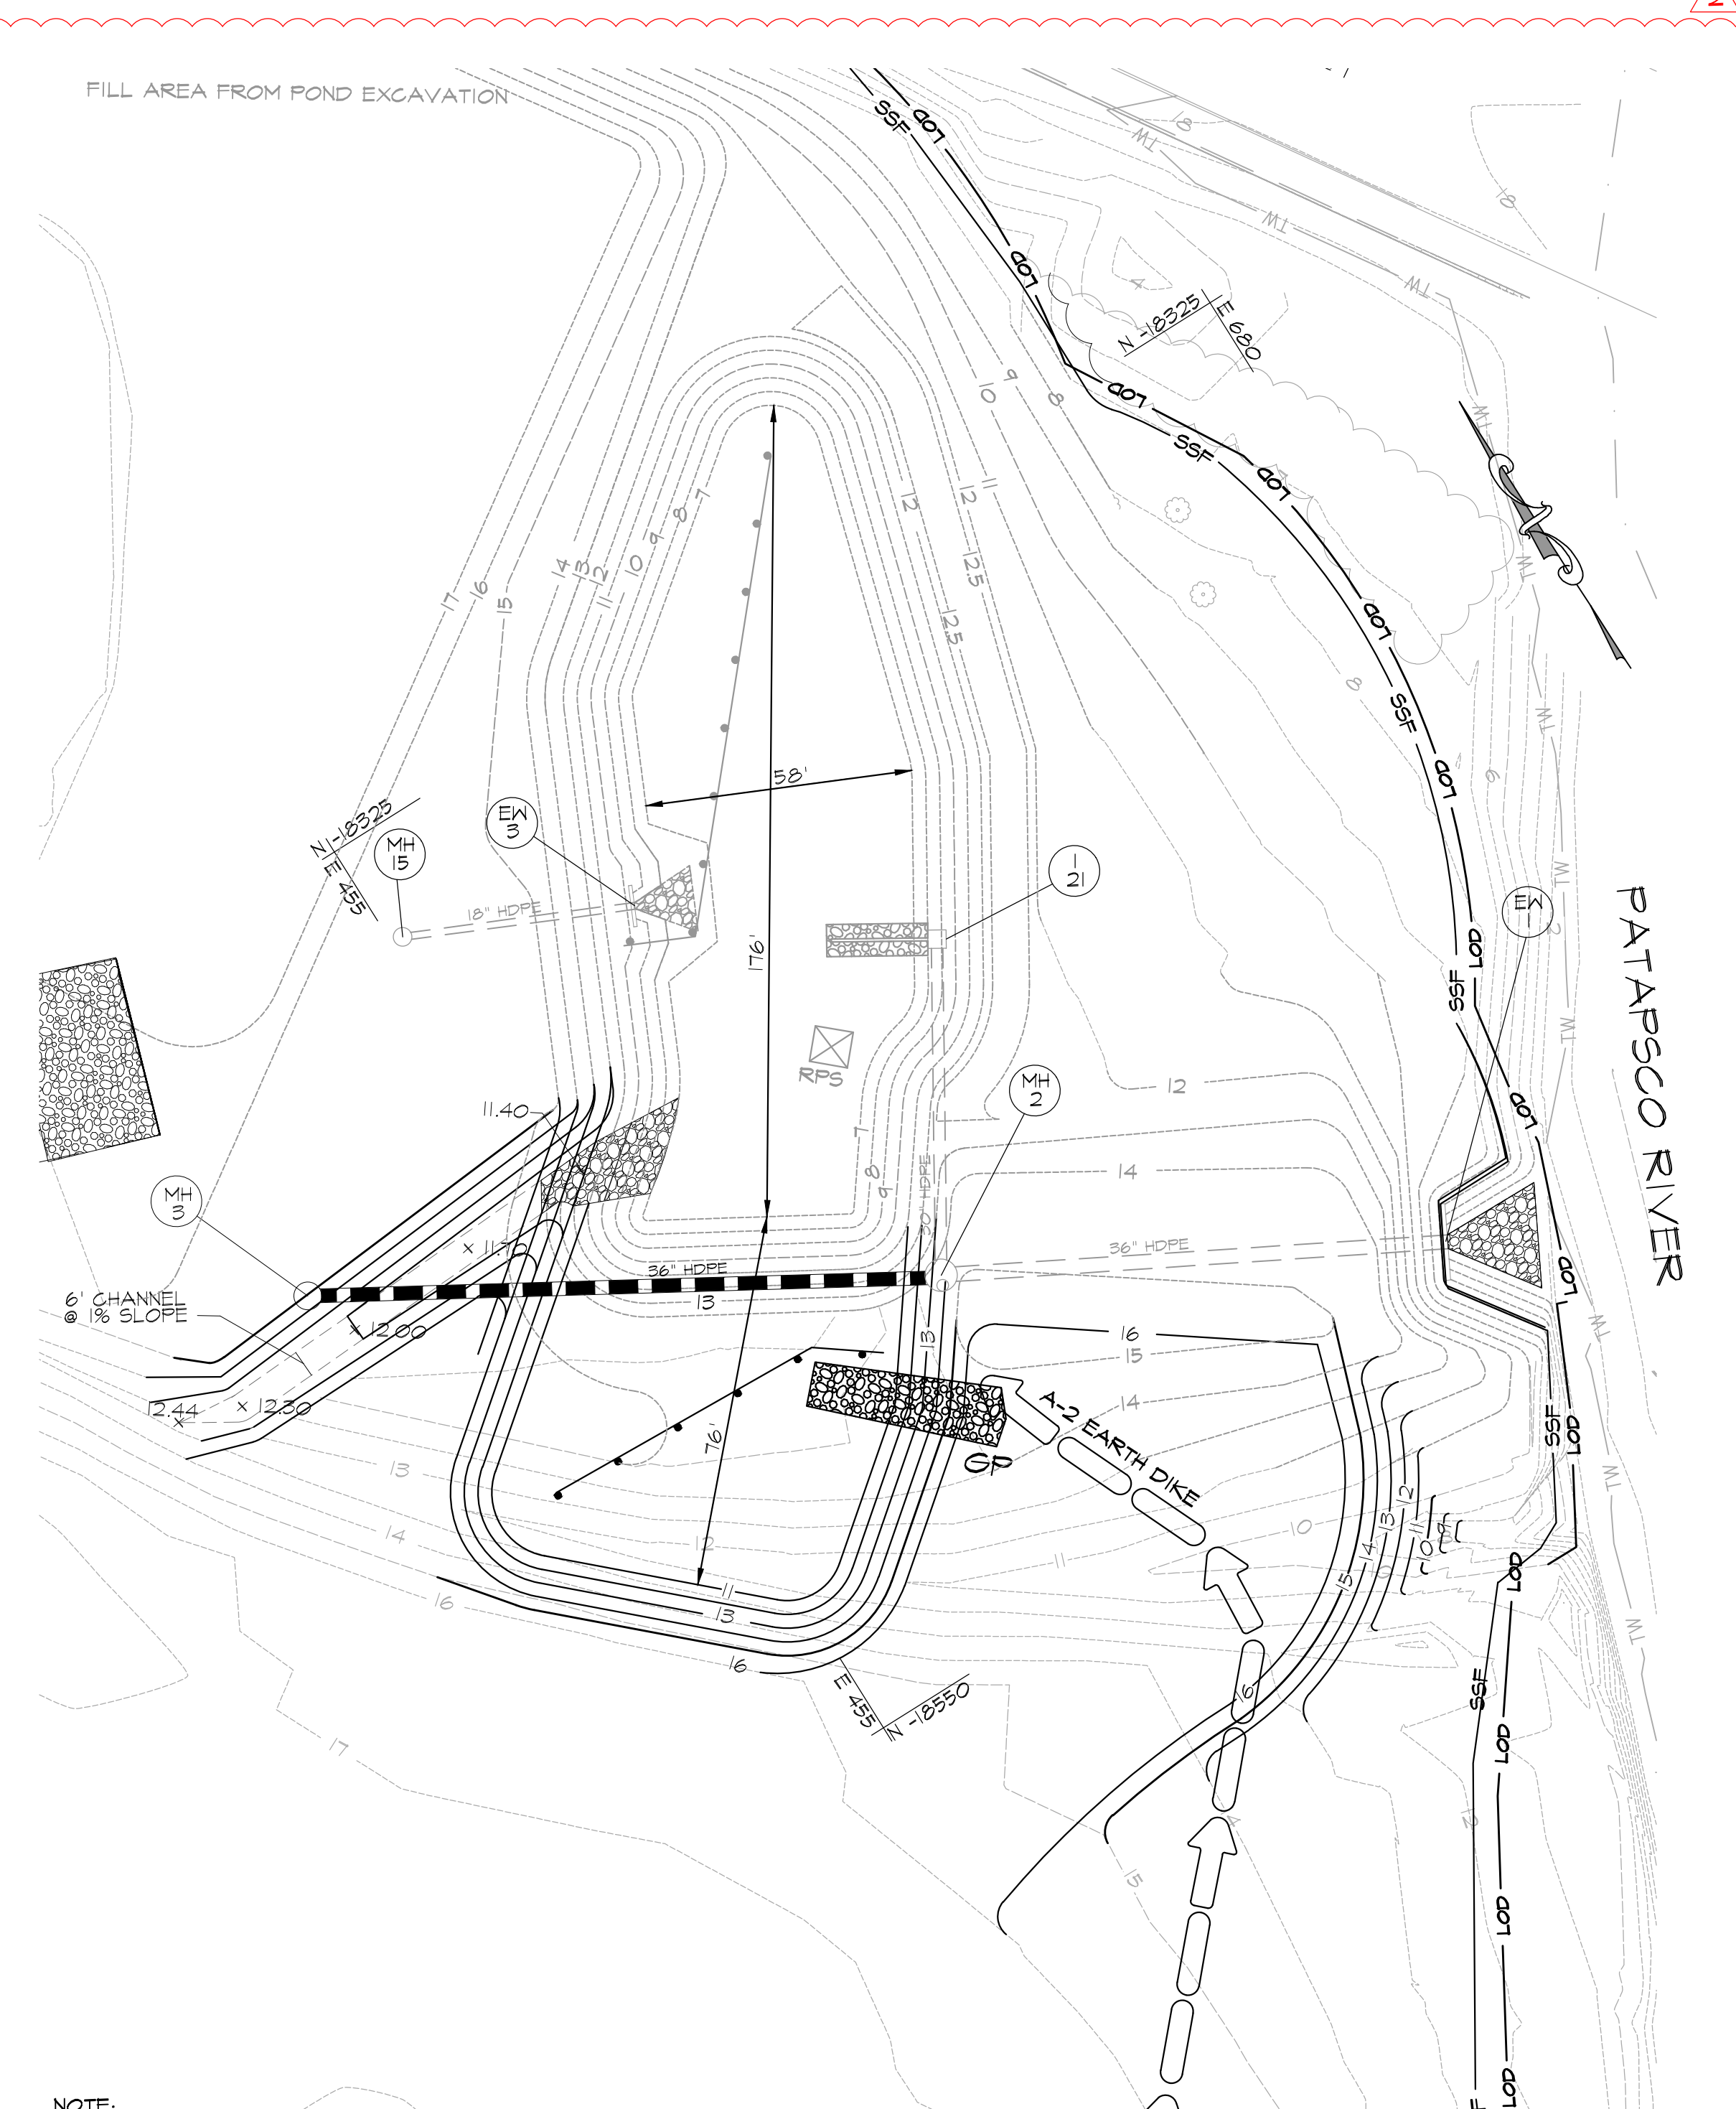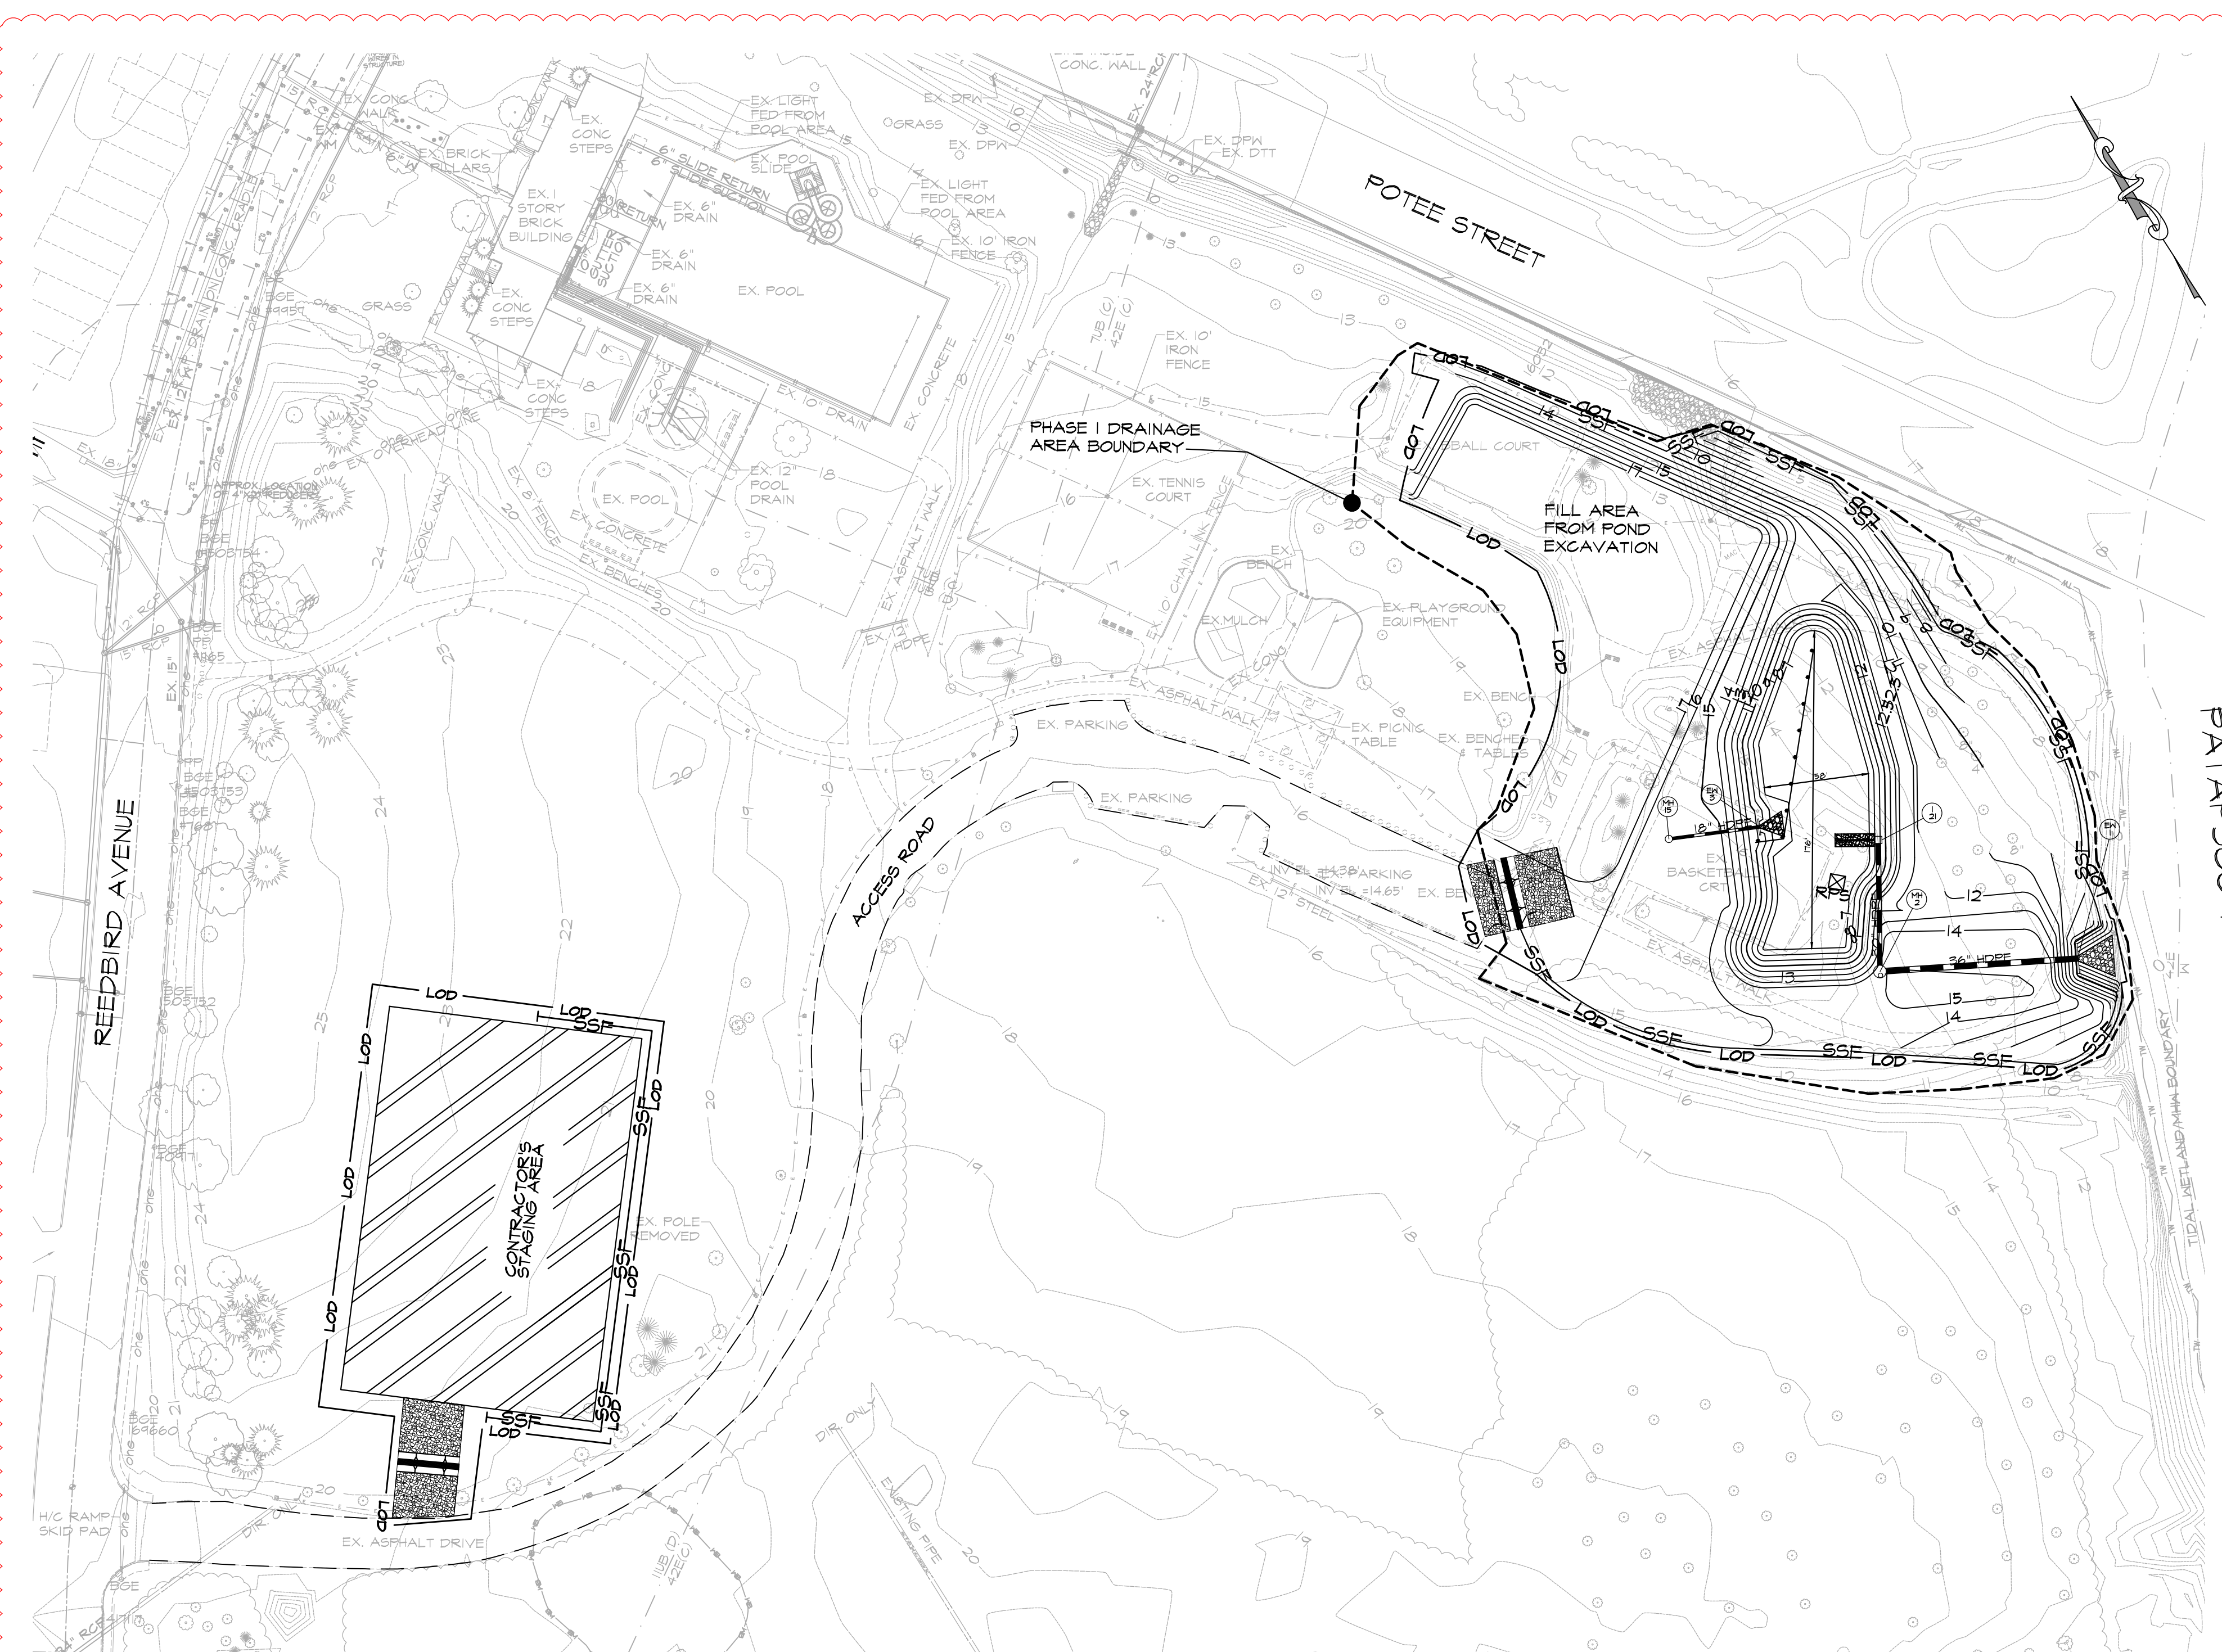


NOTE: SEE SHEET C9.04 FOR FINAL BASIN GRADING.

- LEGEND**
- 20 --- EX. INDEX CONTOUR
 - 21 --- EX. INTERMEDIATE CONTOUR
 - TW --- EX. TIDAL WETLAND
 - 12 --- PROPOSED STORM DRAIN
 - 10 --- PROPOSED INTERMEDIATE CONTOUR
 - 10 --- PROPOSED INDEX CONTOUR
 - --- PROPOSED MANHOLE
 - --- PROPOSED CONCRETE ENDWALL
 - --- BAFFLE BOARD
 - GP --- GABION INFLOW PROTECTION
 - SSF --- SUPER SILT FENCE
 - DF --- DIVERSION FENCE
 - LOD --- LIMIT OF DISTURBANCE
 - ⊠ RPS --- REMOVABLE PUMPING STATION
 - --- ACCESS ROAD
 - --- CONTRACTOR ACCESS ROAD

SEDIMENT BASIN #1 PHASE I CONSTRUCTION


SCALE: 1"=60'

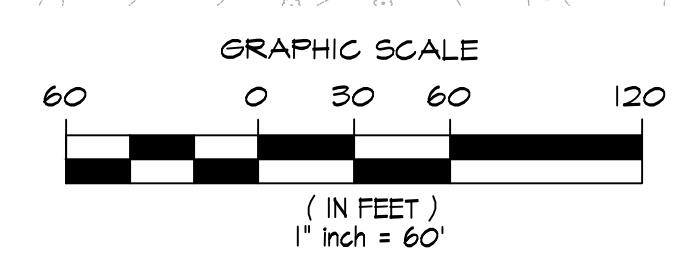

SEDIMENT BASIN TABLE		
EXISTING DRAINAGE AREA (AC.)		2.58
INTERIM DRAINAGE AREA (AC.)		2.58
PROPOSED DRAINAGE AREA (AC.)		2.58
STORAGE REQUIRED (C.F.)		
	WET	4,644
	DRY	4,644
	TOTAL	9,288
PHASE I STORAGE PROVIDED (C.F.)		
	WET	10,491
	DRY	11,814
	TOTAL	22,305
EXISTING GROUND ELEV.		N/A
TOP EMBANKMENT ELEV.		12.50
RISER CREST ELEV.		10.50
WET STORAGE / OUTLET ELEV.		4.00
CLEANOUT ELEV.		8.00
BOTTOM ELEV.		7.00
EMBANKMENT WIDTH		8.0'
EMERGENCY SPILLWAY WIDTH (EARTHEN)		N/A
BOTTOM DIMENSION (AVG.)		25' X 55'
TRAP SIDESLOPES		3:1 / 4:1
TRAP DEPTH		
	WET	2.00'
	DRY	1.50'
	TOTAL	3.50'
WET STORAGE ELEV. RANGE		7.00 - 4.00
DRY STORAGE ELEV. RANGE		4.00 - 10.50
TOP OF BAFFLE ELEV.		4.75

SEDIMENT BASIN #1 PHASE 2 CONSTRUCTION

SCALE: 1"=30'

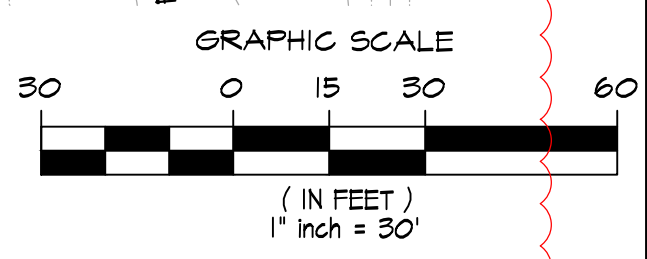

ISSUED FOR BID

mk
Consulting Engineers, LLC
Whitetail Mill
3300 Clipper Mill Road, Suite 201
Baltimore, MD 21211
667-308-6183

G|W|O
GWVO INC.
800 WYMAN PARK DRIVE, SUITE 300
BALTIMORE, MARYLAND 21211, 410-332-0209

CERTIFY THAT THESE DOCUMENTS WERE PREPARED OR APPROVED BY ME, AND THAT I AM A FULLY LICENSED ENGINEER UNDER THE LAWS OF THE STATE OF MARYLAND. LICENSE NUMBER: 25058, EXPIRATION DATE: 11/17/20

Revisions	No.	Date	Description
	2	1/28/20	Addendum #2

MIDDLE BRANCH FITNESS & WELLNESS CENTER AT CHERRY HILL


BALTIMORE CITY RECREATION & PARKS

Job No.	18010	Author	SG
Scale	AS SHOWN	Checker	AP
Date	1/28/2019	Approver	SM

Drawing Title	SEDIMENT BASIN #1 PHASE I CONSTRUCTION	Drawing Number	C9.06r2
Sheet			OF

N:\1810\Proj\18010\06-Revit\Revit Model to Consultants\2019-11-08\18010-Middle Branch-Architectural.rvt

11/8/2019 3:30:51 PM

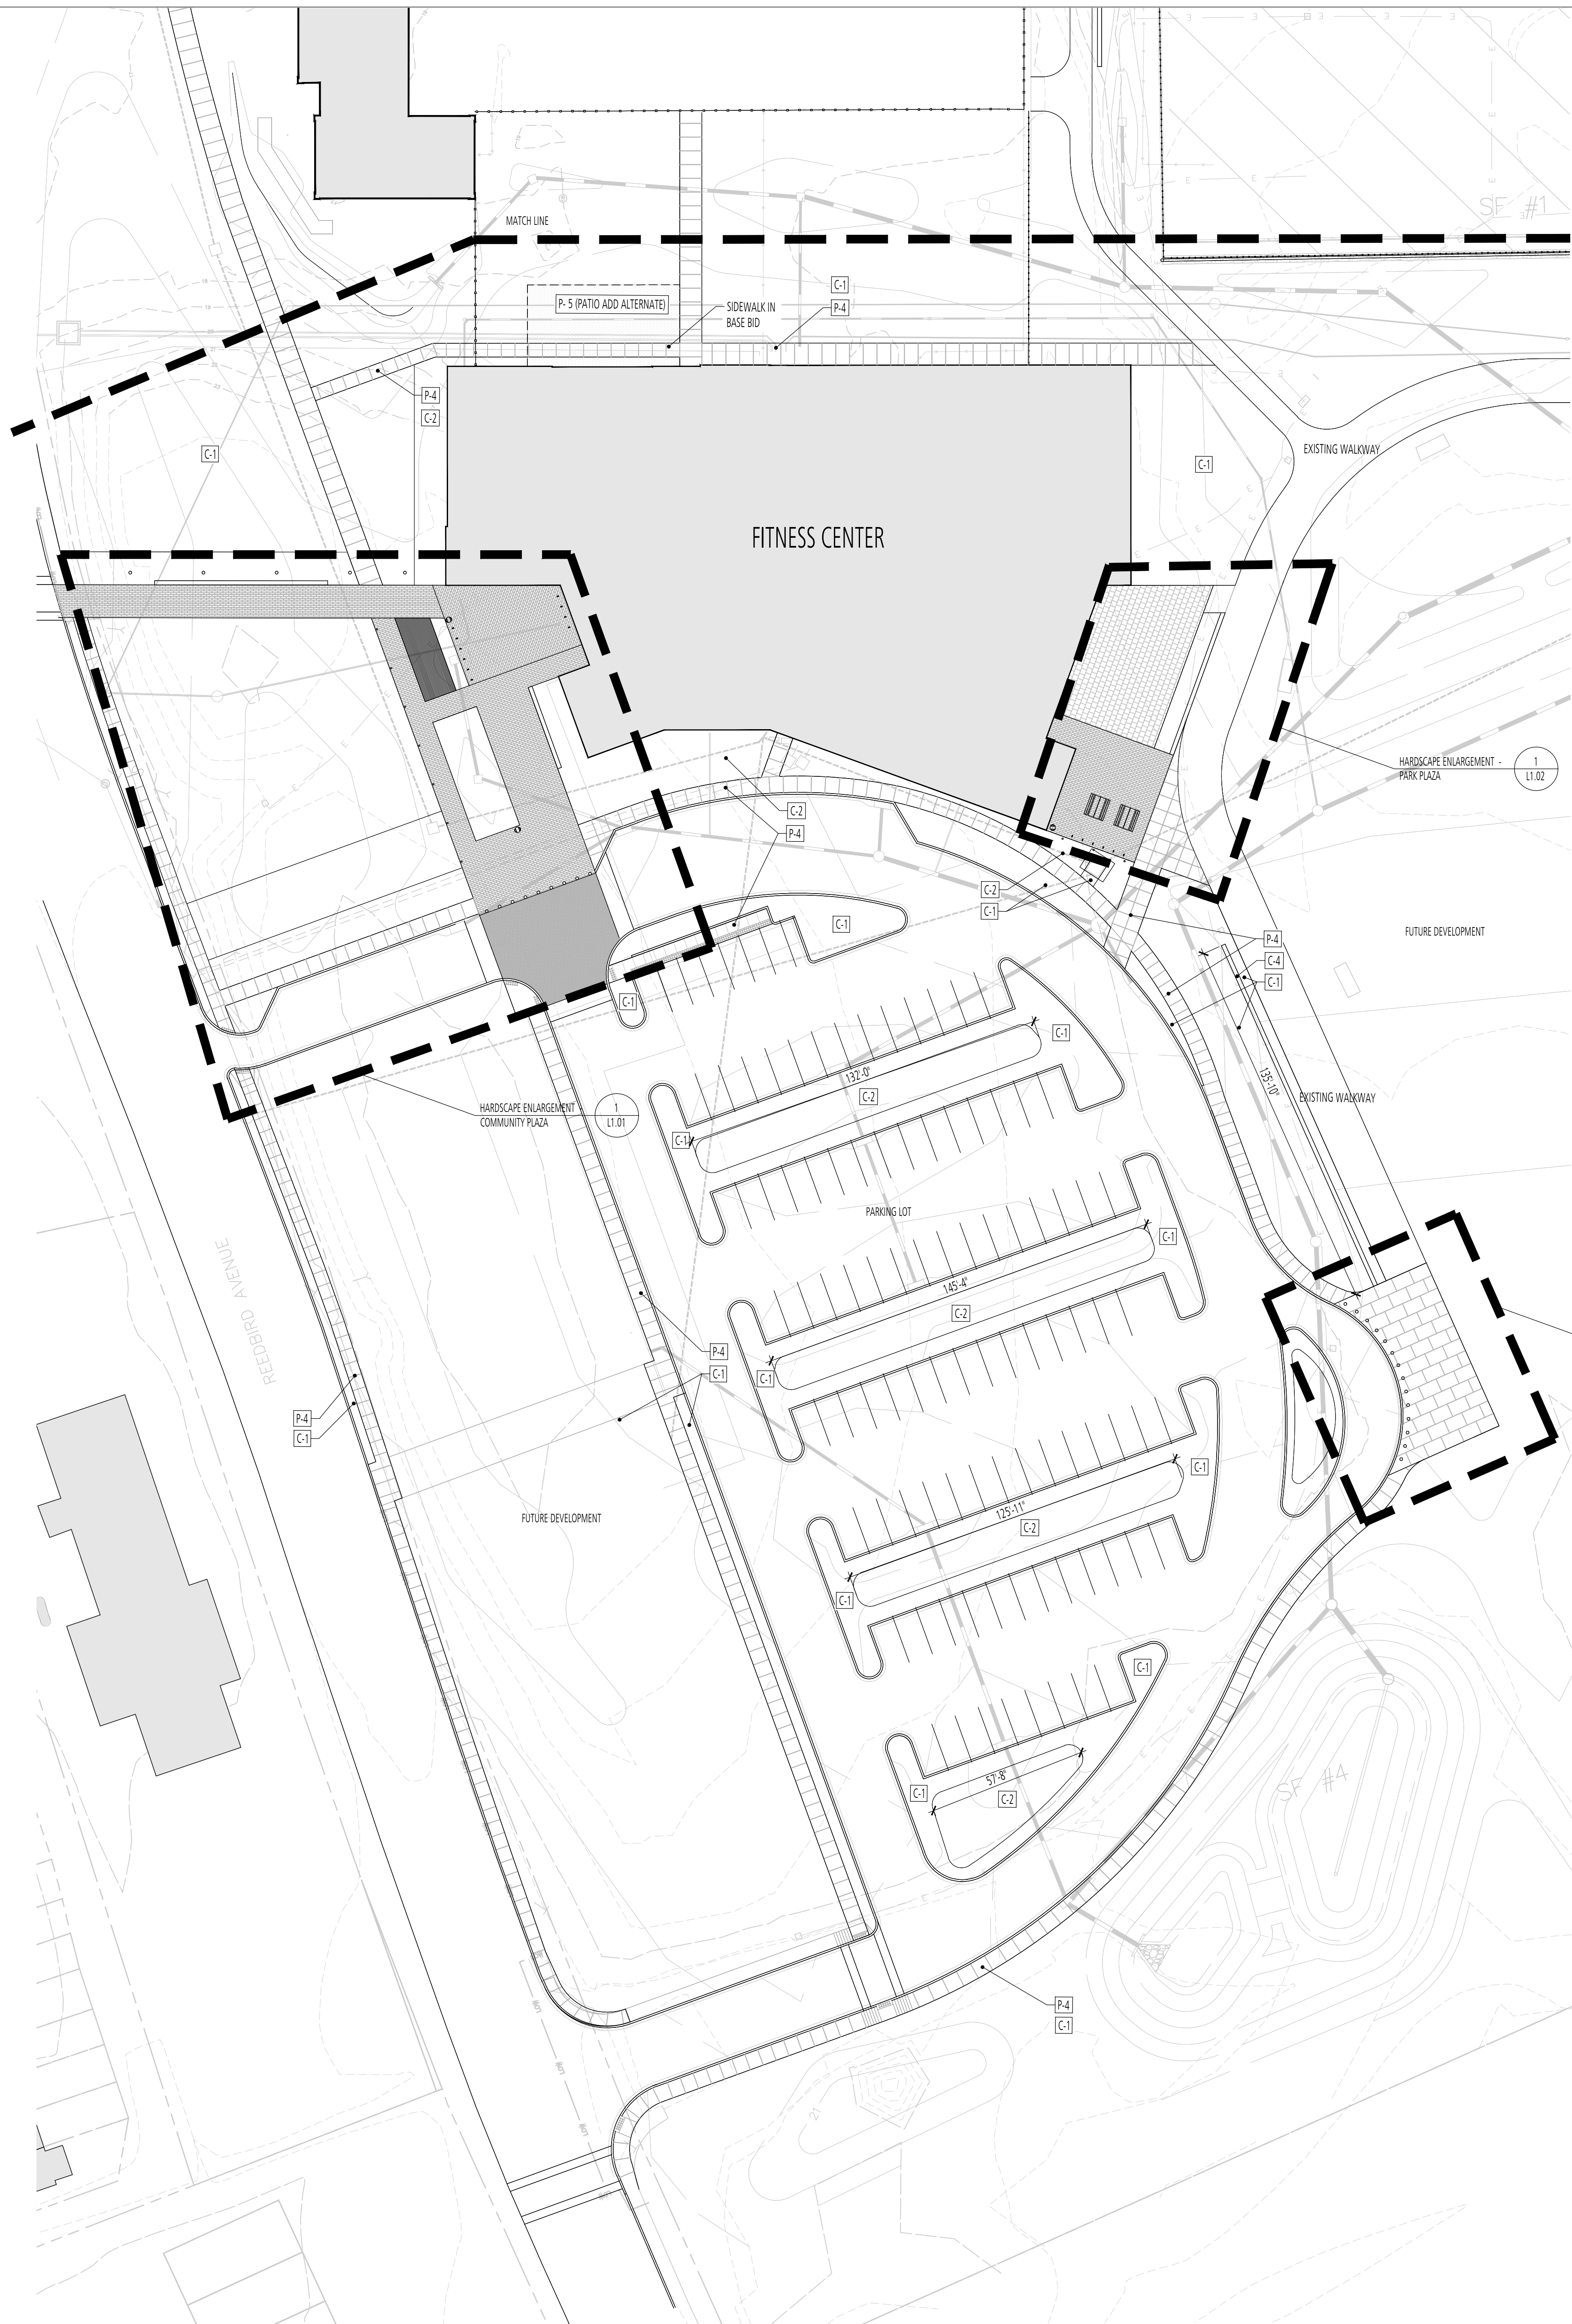

1 SOUTHWEST HARDSCAPE PLAN
PLAN


FTLA_L1.00-Overall Hardscape Plan.dwg
SCALE: 1"=30'-0"

KEYNOTES:

CONSTRUCTION NOTES			
SYMBOL	ITEM TYPE	NOTES	REFERENCE
C-1	LAWN		1/L4.00
C-2	PLANTING BED		1/L4.00
C-3	BENCH A	REFER TO SPECIFICATIONS	
C-4	CONCRETE SEATWALL		5/L3.00
C-5	VEHICULAR GRADE BOLLARDS	REFER TO SPECIFICATIONS	7/L3.00
C-6	LIGHT COLUMN	REFER TO ELECTRICAL	
C-7	LIGHT BOLLARDS	REFER TO ELECTRICAL	
C-8	LITTER RECEPTACLE	REFER TO SPECIFICATIONS	
C-9	BICYCLE RACK	REFER TO SPECIFICATIONS	
C-10	HARVEST TABLE	REFER TO SPECIFICATIONS	
PAVEMENT NOTES			
SYMBOL	PAVER TYPE	NOTES	REFERENCE
P-1	PAVER A	REFER TO SPECIFICATIONS	2/L300
P-1.1	PAVER A.1	REFER TO SPECIFICATIONS	3/L3.00
P-2	PAVER B - VEHICULAR USE	REFER TO SPECIFICATIONS	3/L3.00
P-3	EXTERIOR FITNESS TILE	REFER TO SPECIFICATIONS	4/L3.00
P-4	SCORED CONCRETE		1/L3.00
P-5	SUNDECK	REFER TO ARCHITECTURAL DRAWINGS	


GENERAL NOTES:

- IT IS THE CONTRACTOR'S RESPONSIBILITY TO FIELD VERIFY SITE CONDITIONS PRIOR TO THE START OF ANY WORK. ANY DISCREPANCY FOUND SHALL BE REPORTED TO THE ARCHITECT IMMEDIATELY.
- THE CONTRACTOR SHALL CONTACT THE ARCHITECT IMMEDIATELY UPON FINDING ANY UNFORESEEN CONDITIONS.
- MAINTAIN POSITIVE DRAINAGE FROM BUILDINGS THROUGHOUT CONSTRUCTION, REFER TO CIVIL DRAWINGS FOR PROPOSED GRADING AND SPOT ELEVATIONS.
- THE CONTRACTOR IS RESPONSIBLE FOR REMOVAL AND PROPER DISPOSAL OF ANY WASTE FROM THE SITE.
- PROVIDE MOCK UPS OF WALL AND PAVING ASSEMBLIES PRIOR TO STARTING INSTALLATION. APPROVED MOCK UPS MAY BE USED IN COMPLETED PROJECT IF UNDAMAGED THROUGHOUT CONSTRUCTION.

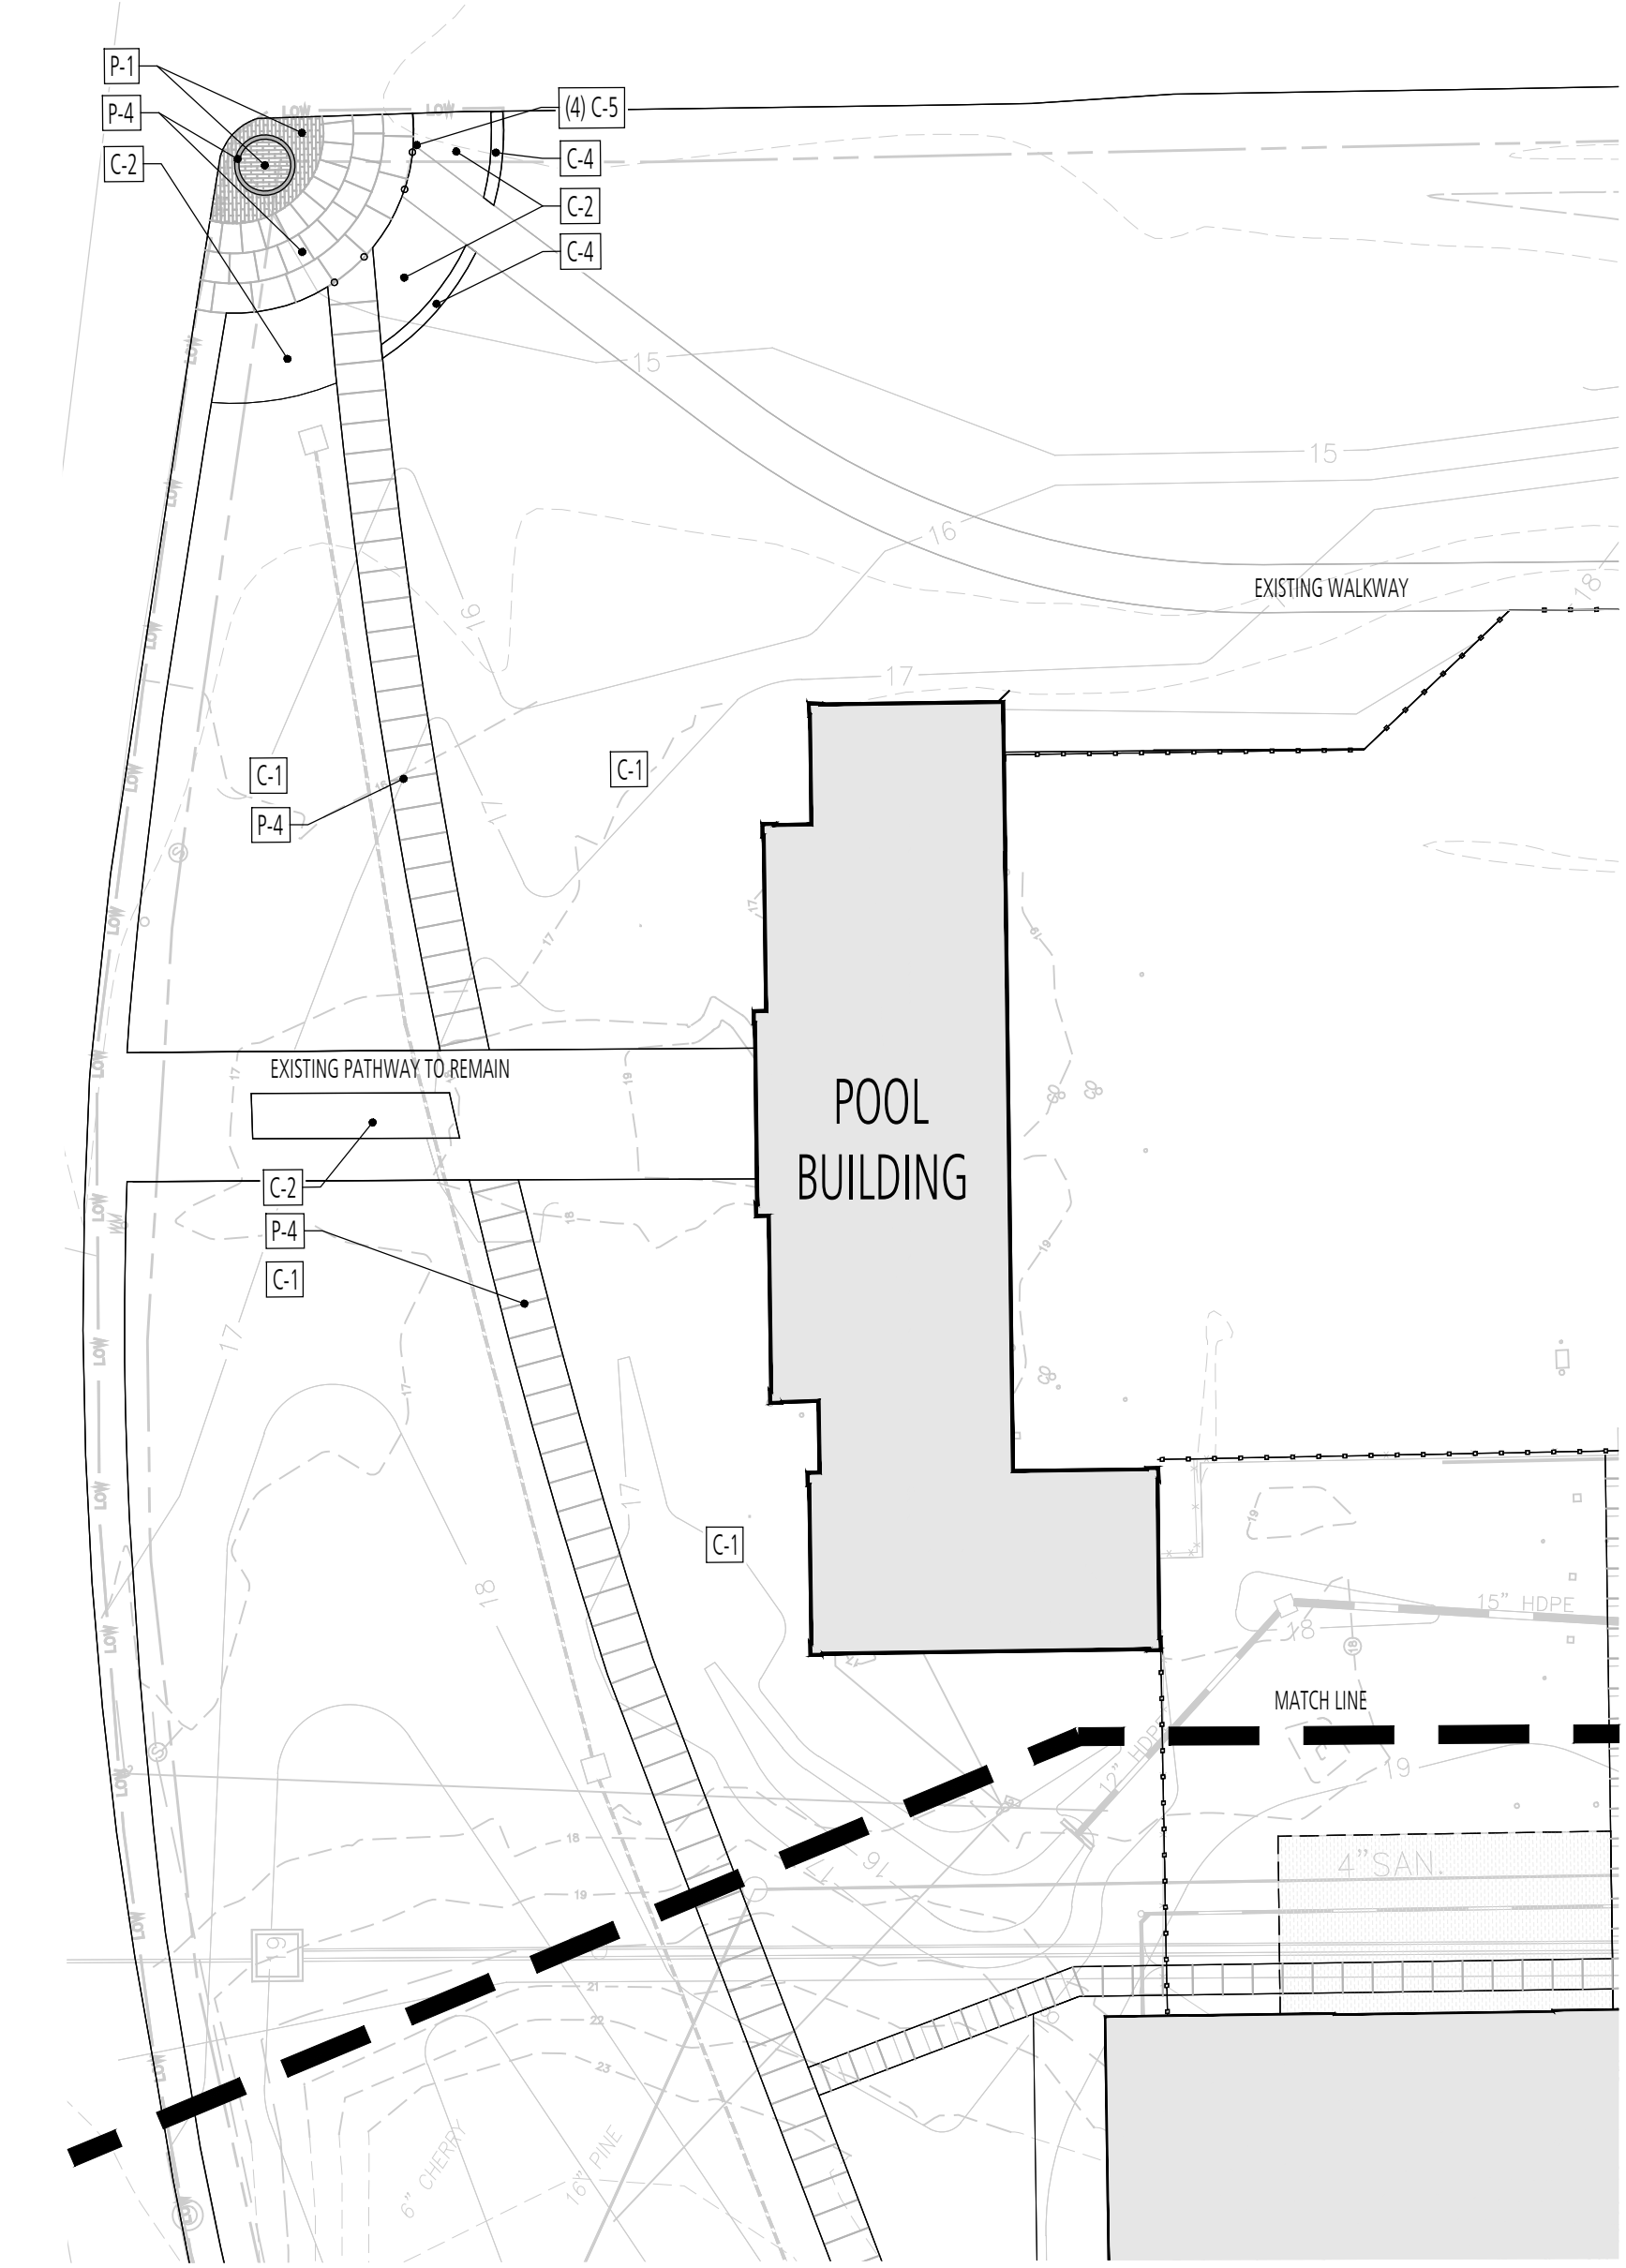

2 NORTHEAST HARDSCAPE PLAN
PLAN


SCALE: 1"=30'-0"

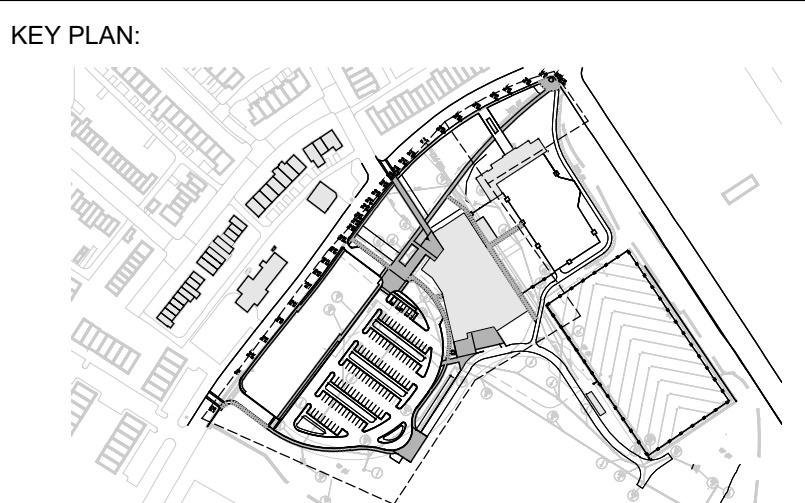

KEYNOTES LISTED ON THIS SHEET ARE FOR CONVENIENCE ONLY. REFER TO SHEET CS.2 FOR COMPLETE LIST

ISSUED FOR BID

Seal: _____

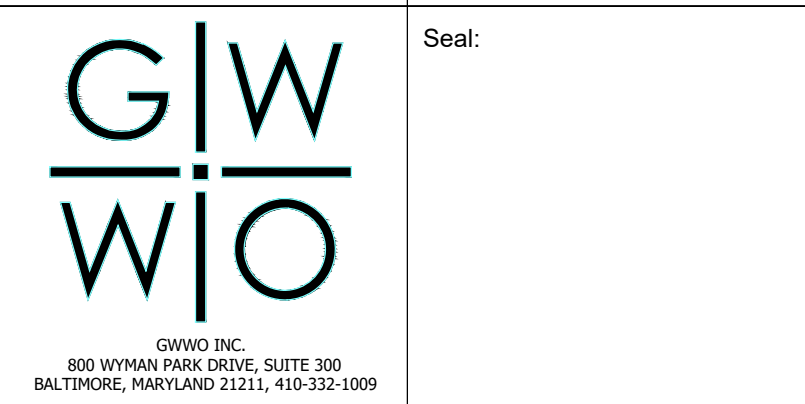

GW WIO INC.
800 WYMAN PARK DRIVE, SUITE 300
BALTIMORE, MARYLAND 21211, 410-332-1009


I CERTIFY THAT THESE DOCUMENTS WERE PREPARED OR APPROVED BY ME, AND THAT I AM A DULY LICENSED ARCHITECT UNDER THE LAWS OF THE STATE OF MARYLAND.
LICENSE NUMBER: XXXXXXXX, EXPIRATION DATE: XXXXXXXX

Revisions:	No.	Date	Description
	1	1/13/2020	Addendum 1
	2	1/28/2020	Addendum 2


MIDDLE BRANCH FITNESS & WELLNESS CENTER AT CHERRY HILL
BALTIMORE CITY RECREATION & PARKS

Job No. #18010 Author _____ Drawn _____
Scale Checker _____ Checked _____
Date 01/28/2019 Approver _____ Approved _____

Drawing Title OVERALL HARDSCAPE PLAN Drawing Number L1.00r2
Sheet _____ Of _____

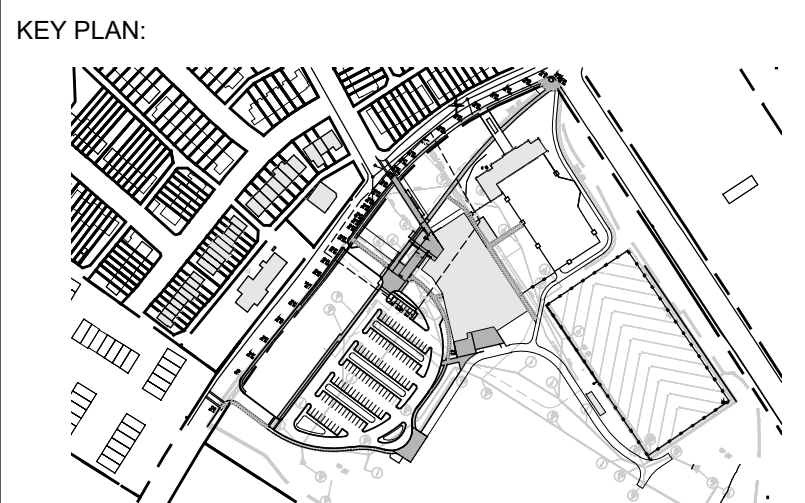

KEYNOTES LISTED ON THIS SHEET ARE FOR CONVENIENCE ONLY. REFER TO SHEET CS.3 FOR COMPLETE LIST

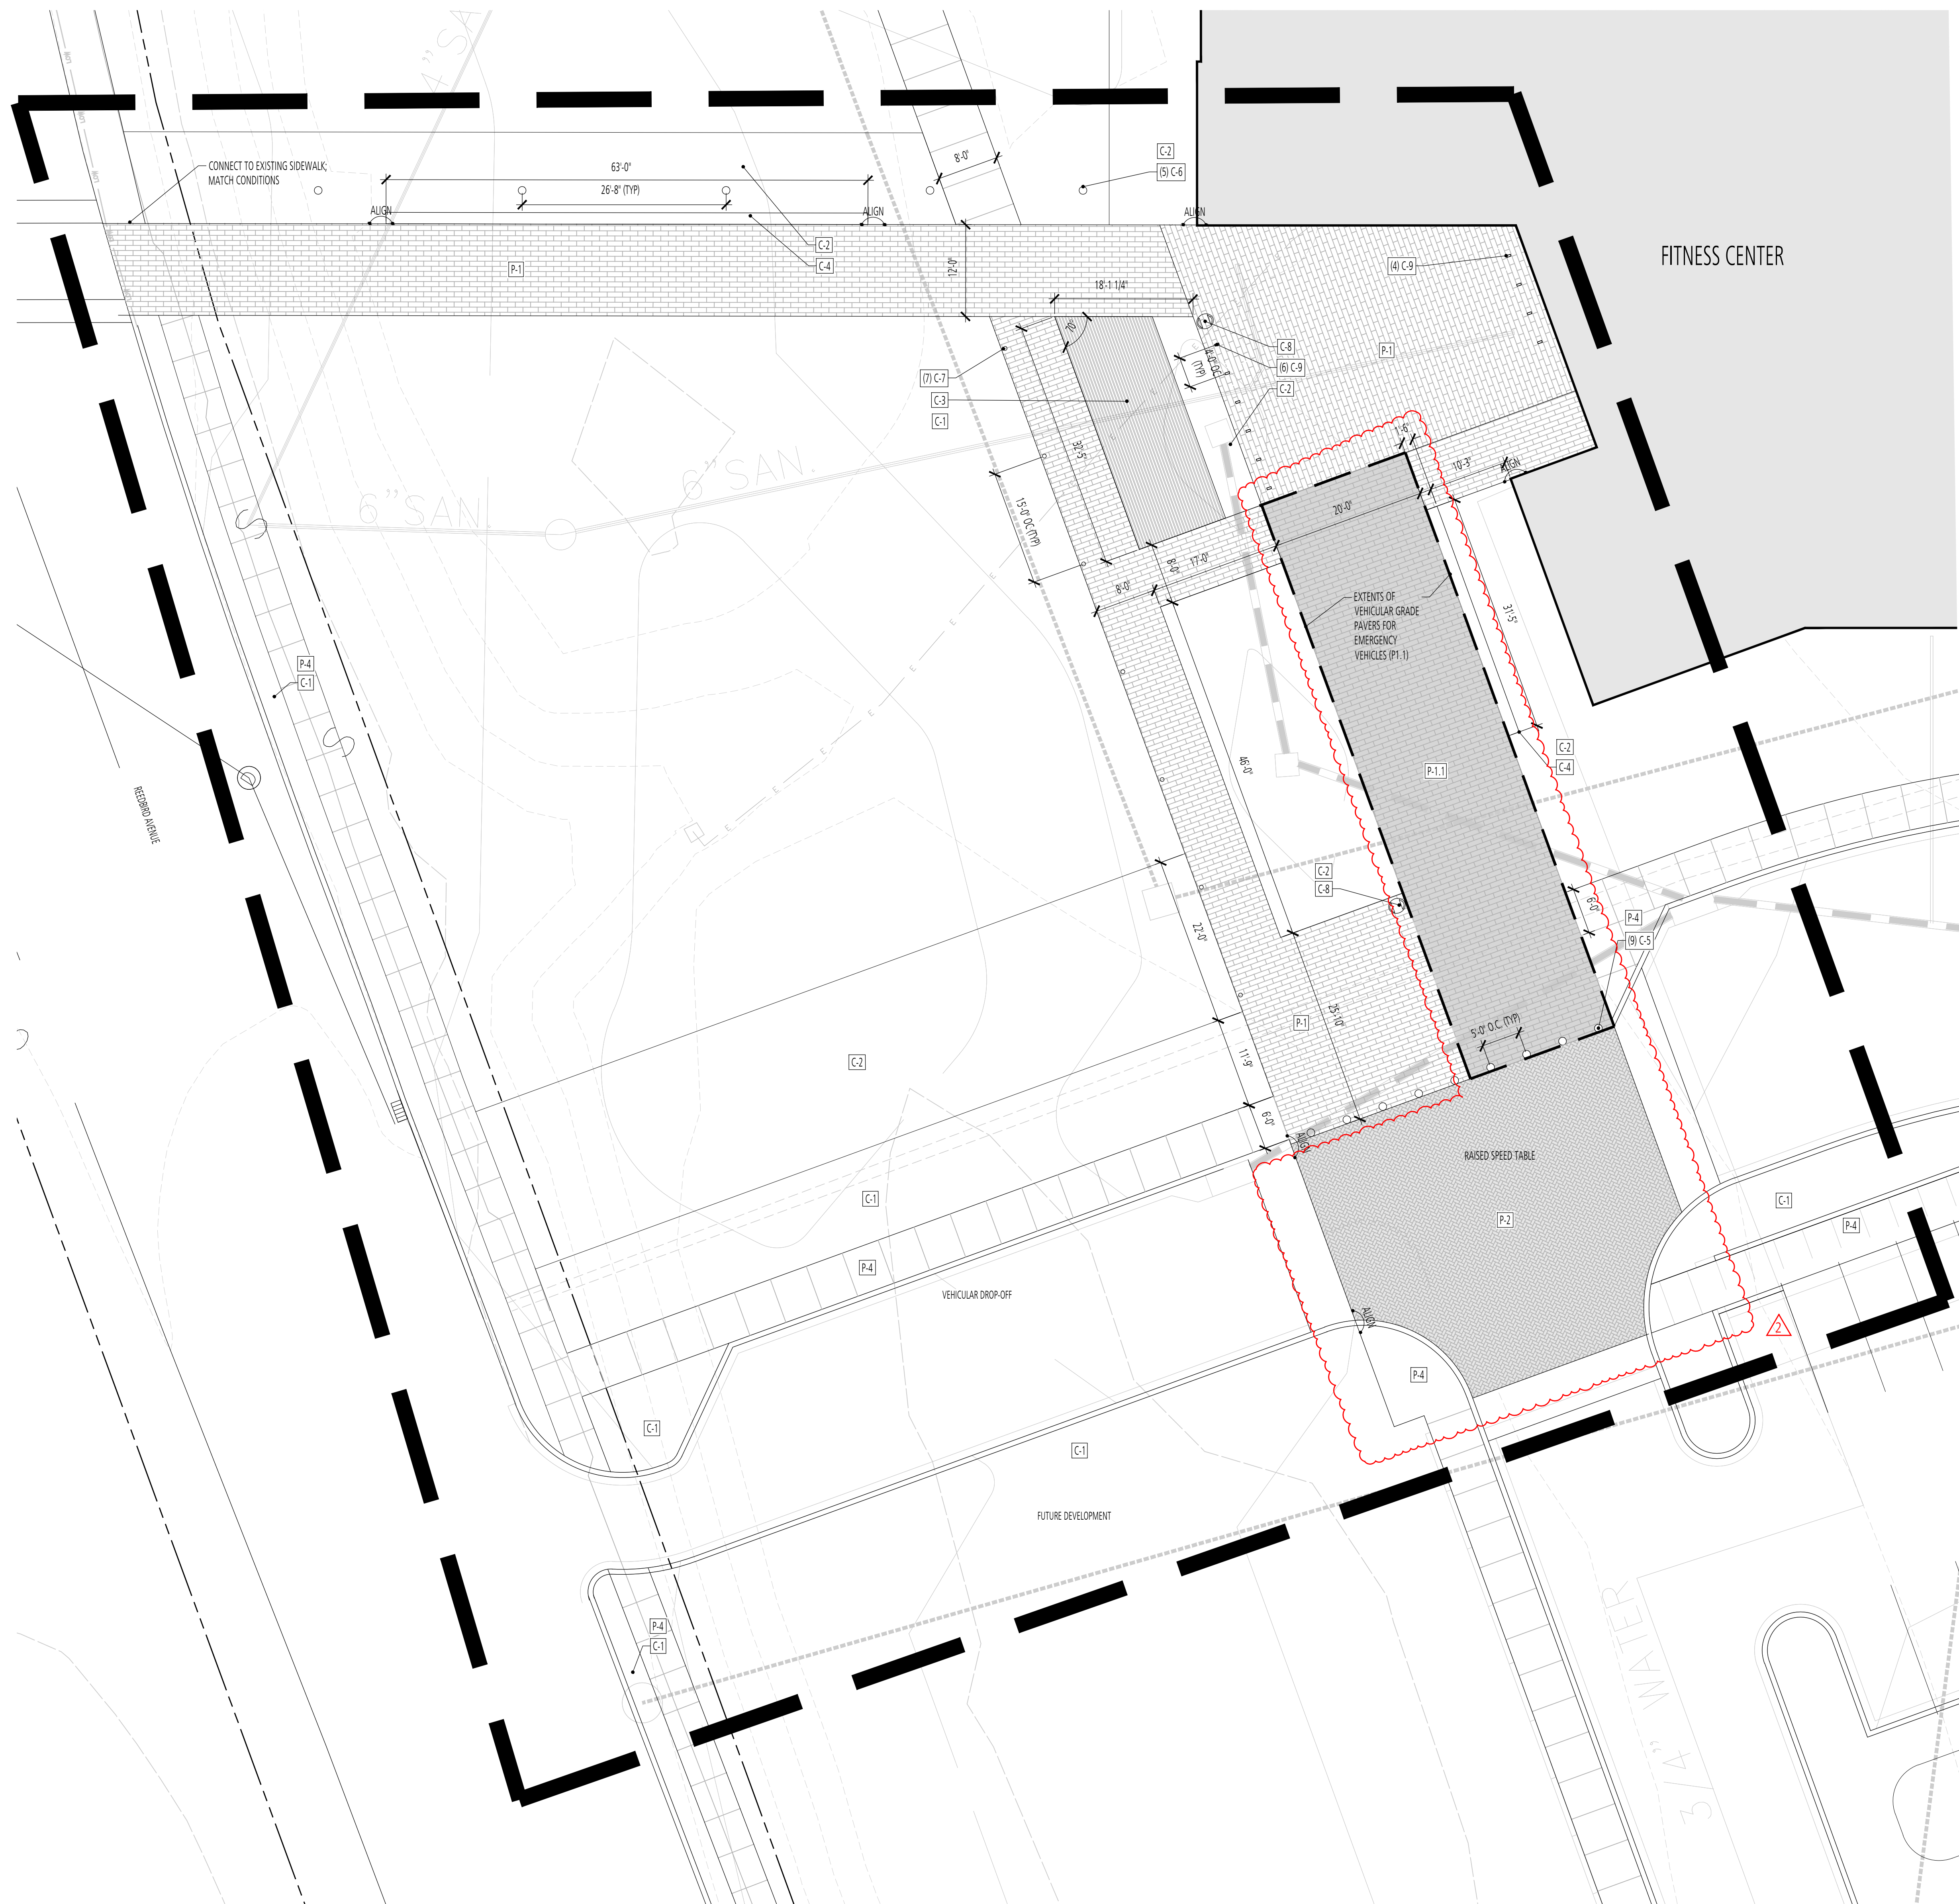


KEYNOTES:

CONSTRUCTION NOTES		
SYMBOL	ITEM TYPE	REFERENCE
C-1	LAWN	1/L4.00
C-2	PLANTING BED	1/L4.00
C-3	BENCH A	REFER TO SPECIFICATIONS
C-4	CONCRETE SEATWALL	5/L3.00
C-5	VEHICULAR GRADE BOLLARDS	REFER TO SPECIFICATIONS
C-6	LIGHT COLUMN	REFER TO ELECTRICAL
C-7	LIGHT BOLLARDS	REFER TO ELECTRICAL
C-8	LITTER RECEPTACLE	REFER TO SPECIFICATIONS
C-9	BICYCLE RACK	REFER TO SPECIFICATIONS
C-10	HARVEST TABLE	REFER TO SPECIFICATIONS
PAVEMENT NOTES		
SYMBOL	PAVER TYPE	REFERENCE
P-1	PAVER A	REFER TO SPECIFICATIONS
P-1.1	PAVER A.1	REFER TO SPECIFICATIONS
P-2	PAVER B - VEHICULAR USE	REFER TO SPECIFICATIONS
P-3	EXTERIOR FITNESS TILE	REFER TO SPECIFICATIONS
P-4	SCORED CONCRETE	1/L3.00
P-5	SUNDECK	REFER TO ARCHITECTURAL DRAWINGS

GENERAL NOTES:

- IT IS THE CONTRACTOR'S RESPONSIBILITY TO FIELD VERIFY SITE CONDITIONS PRIOR TO THE START OF ANY WORK. ANY DISCREPANCY FOUND SHALL BE REPORTED TO THE ARCHITECT IMMEDIATELY.
- THE CONTRACTOR SHALL CONTACT THE ARCHITECT IMMEDIATELY UPON FINDING ANY UNFORESSEEN CONDITIONS.
- MAINTAIN POSITIVE DRAINAGE FROM BUILDINGS THROUGHOUT CONSTRUCTION. REFER TO CIVIL DRAWINGS FOR PROPOSED GRADING AND SPOT ELEVATIONS.
- THE CONTRACTOR IS RESPONSIBLE FOR REMOVAL AND PROPER DISPOSAL OF ANY WASTE FROM THE SITE.
- PROVIDE MOCK UPS OF WALL AND PAVING ASSEMBLIES PRIOR TO STARTING INSTALLATION. APPROVED MOCK UPS MAY BE USED IN COMPLETED PROJECT IF UNDAMAGED THROUGHOUT CONSTRUCTION.

PAVING LEGEND:

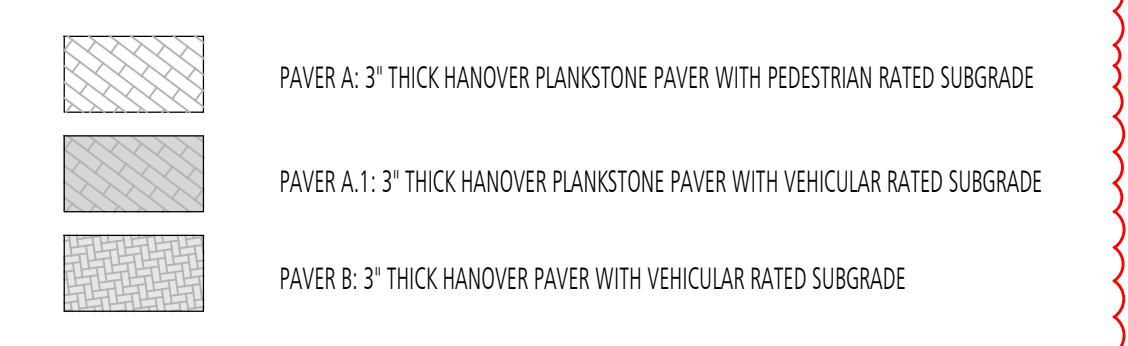

ISSUED FOR BID

Seal:



© 2019 GWWO INC.
 I CERTIFY THAT THESE DOCUMENTS WERE PREPARED OR APPROVED BY ME, AND THAT I AM A FULLY LICENSED ARCHITECT UNDER THE LAWS OF THE STATE OF MARYLAND. LICENSE NUMBER: XXXXXXXXX, EXPIRATION DATE XXXXXXXXX

Revisions:		
No.	Date	Description
1	1/13/2020	Addendum 1
2	1/28/2020	Addendum 2

MIDDLE BRANCH FITNESS & WELLNESS CENTER AT CHERRY HILL

BALTIMORE CITY RECREATION & PARKS

Job No.	#18010	Author	Drawn
Scale		Checker	Checked
Date	01/28/2019	Approver	Approved


Drawing Title: HARDSCAPE ENLARGEMENT - COMMUNITY PLAZA
 Drawing Number: L1.01r2

1 HARDSCAPE ENLARGEMENT PLAN - COMMUNITY PLAZA

FLA_L1.01-Hardscape Enlargment Plan - Community Plaza
 SCALE: 1"= 10'-0"

N:\1801006-Revit\Revit Model to Consultants\2019-11-08\18010-Middle Branch-Architectural.rvt

1/18/2019 3:30:51 PM

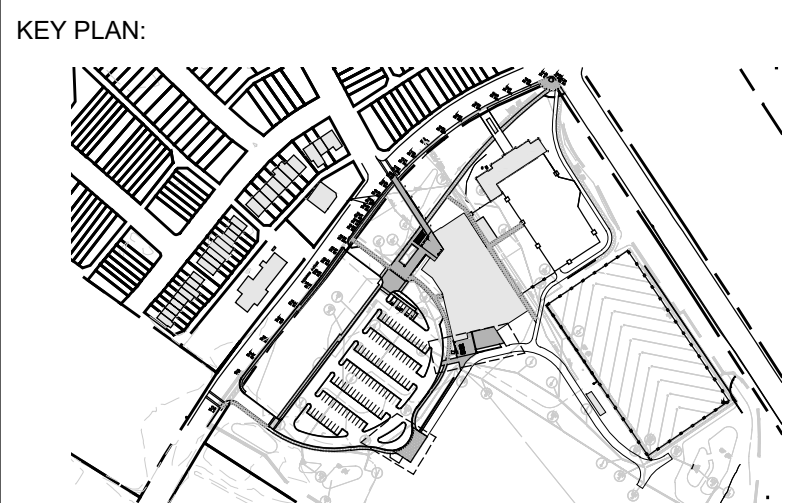



KEYNOTES LISTED ON THIS SHEET ARE FOR CONVENIENCE ONLY. REFER TO SHEET CS.3 FOR COMPLETE LIST

KEYNOTES:

CONSTRUCTION NOTES			
SYMBOL	ITEM TYPE	NOTES	REFERENCE
C-1	LAWN		1/L4.00
C-2	PLANTING BED		1/L4.00
C-3	BENCH A	REFER TO SPECIFICATIONS	
C-4	CONCRETE SEATWALL		5/L3.00
C-5	VEHICULAR GRADE BOLLARDS		
C-6	LIGHT COLUMN	REFER TO ELECTRICAL	
C-7	LIGHT BOLLARDS	REFER TO ELECTRICAL	
C-8	LITTER RECEPTACLE	REFER TO SPECIFICATIONS	
C-9	BICYCLE RACK	REFER TO SPECIFICATIONS	
C-10	HARVEST TABLE	REFER TO SPECIFICATIONS	
PAVEMENT NOTES			
SYMBOL	PAVER TYPE	NOTES	REFERENCE
P-1	PAVER A	REFER TO SPECIFICATIONS	2/L 300
P-1.1	PAVER A.1	REFER TO SPECIFICATIONS	3/L3.00
P-2	PAVER B - VEHICULAR USE	REFER TO SPECIFICATIONS	3/L3.00
P-3	EXTERIOR FITNESS TILE	REFER TO SPECIFICATIONS	4/L3.00
P-4	SCORED CONCRETE	REFER TO SPECIFICATIONS	1/L3.00
P-5	SUNDECK	REFER TO ARCHITECTURAL DRAWINGS	

GENERAL NOTES:

- IT IS THE CONTRACTOR'S RESPONSIBILITY TO FIELD VERIFY SITE CONDITIONS PRIOR TO THE START OF ANY WORK. ANY DISCREPANCY FOUND SHALL BE REPORTED TO THE ARCHITECT IMMEDIATELY.
- THE CONTRACTOR SHALL CONTACT THE ARCHITECT IMMEDIATELY UPON FINDING ANY UNFORESEEN CONDITIONS.
- MAINTAIN POSITIVE DRAINAGE FROM BUILDINGS THROUGHOUT CONSTRUCTION. REFER TO CIVIL DRAWINGS FOR PROPOSED GRADING AND SPOT ELEVATIONS.
- THE CONTRACTOR IS RESPONSIBLE FOR REMOVAL AND PROPER DISPOSAL OF ANY WASTE FROM THE SITE.
- PROVIDE MOCK UPS OF WALL AND PAVING ASSEMBLIES PRIOR TO STARTING INSTALLATION. APPROVED MOCK UPS MAY BE USED IN COMPLETED PROJECT IF UNDAMAGED THROUGHOUT CONSTRUCTION.

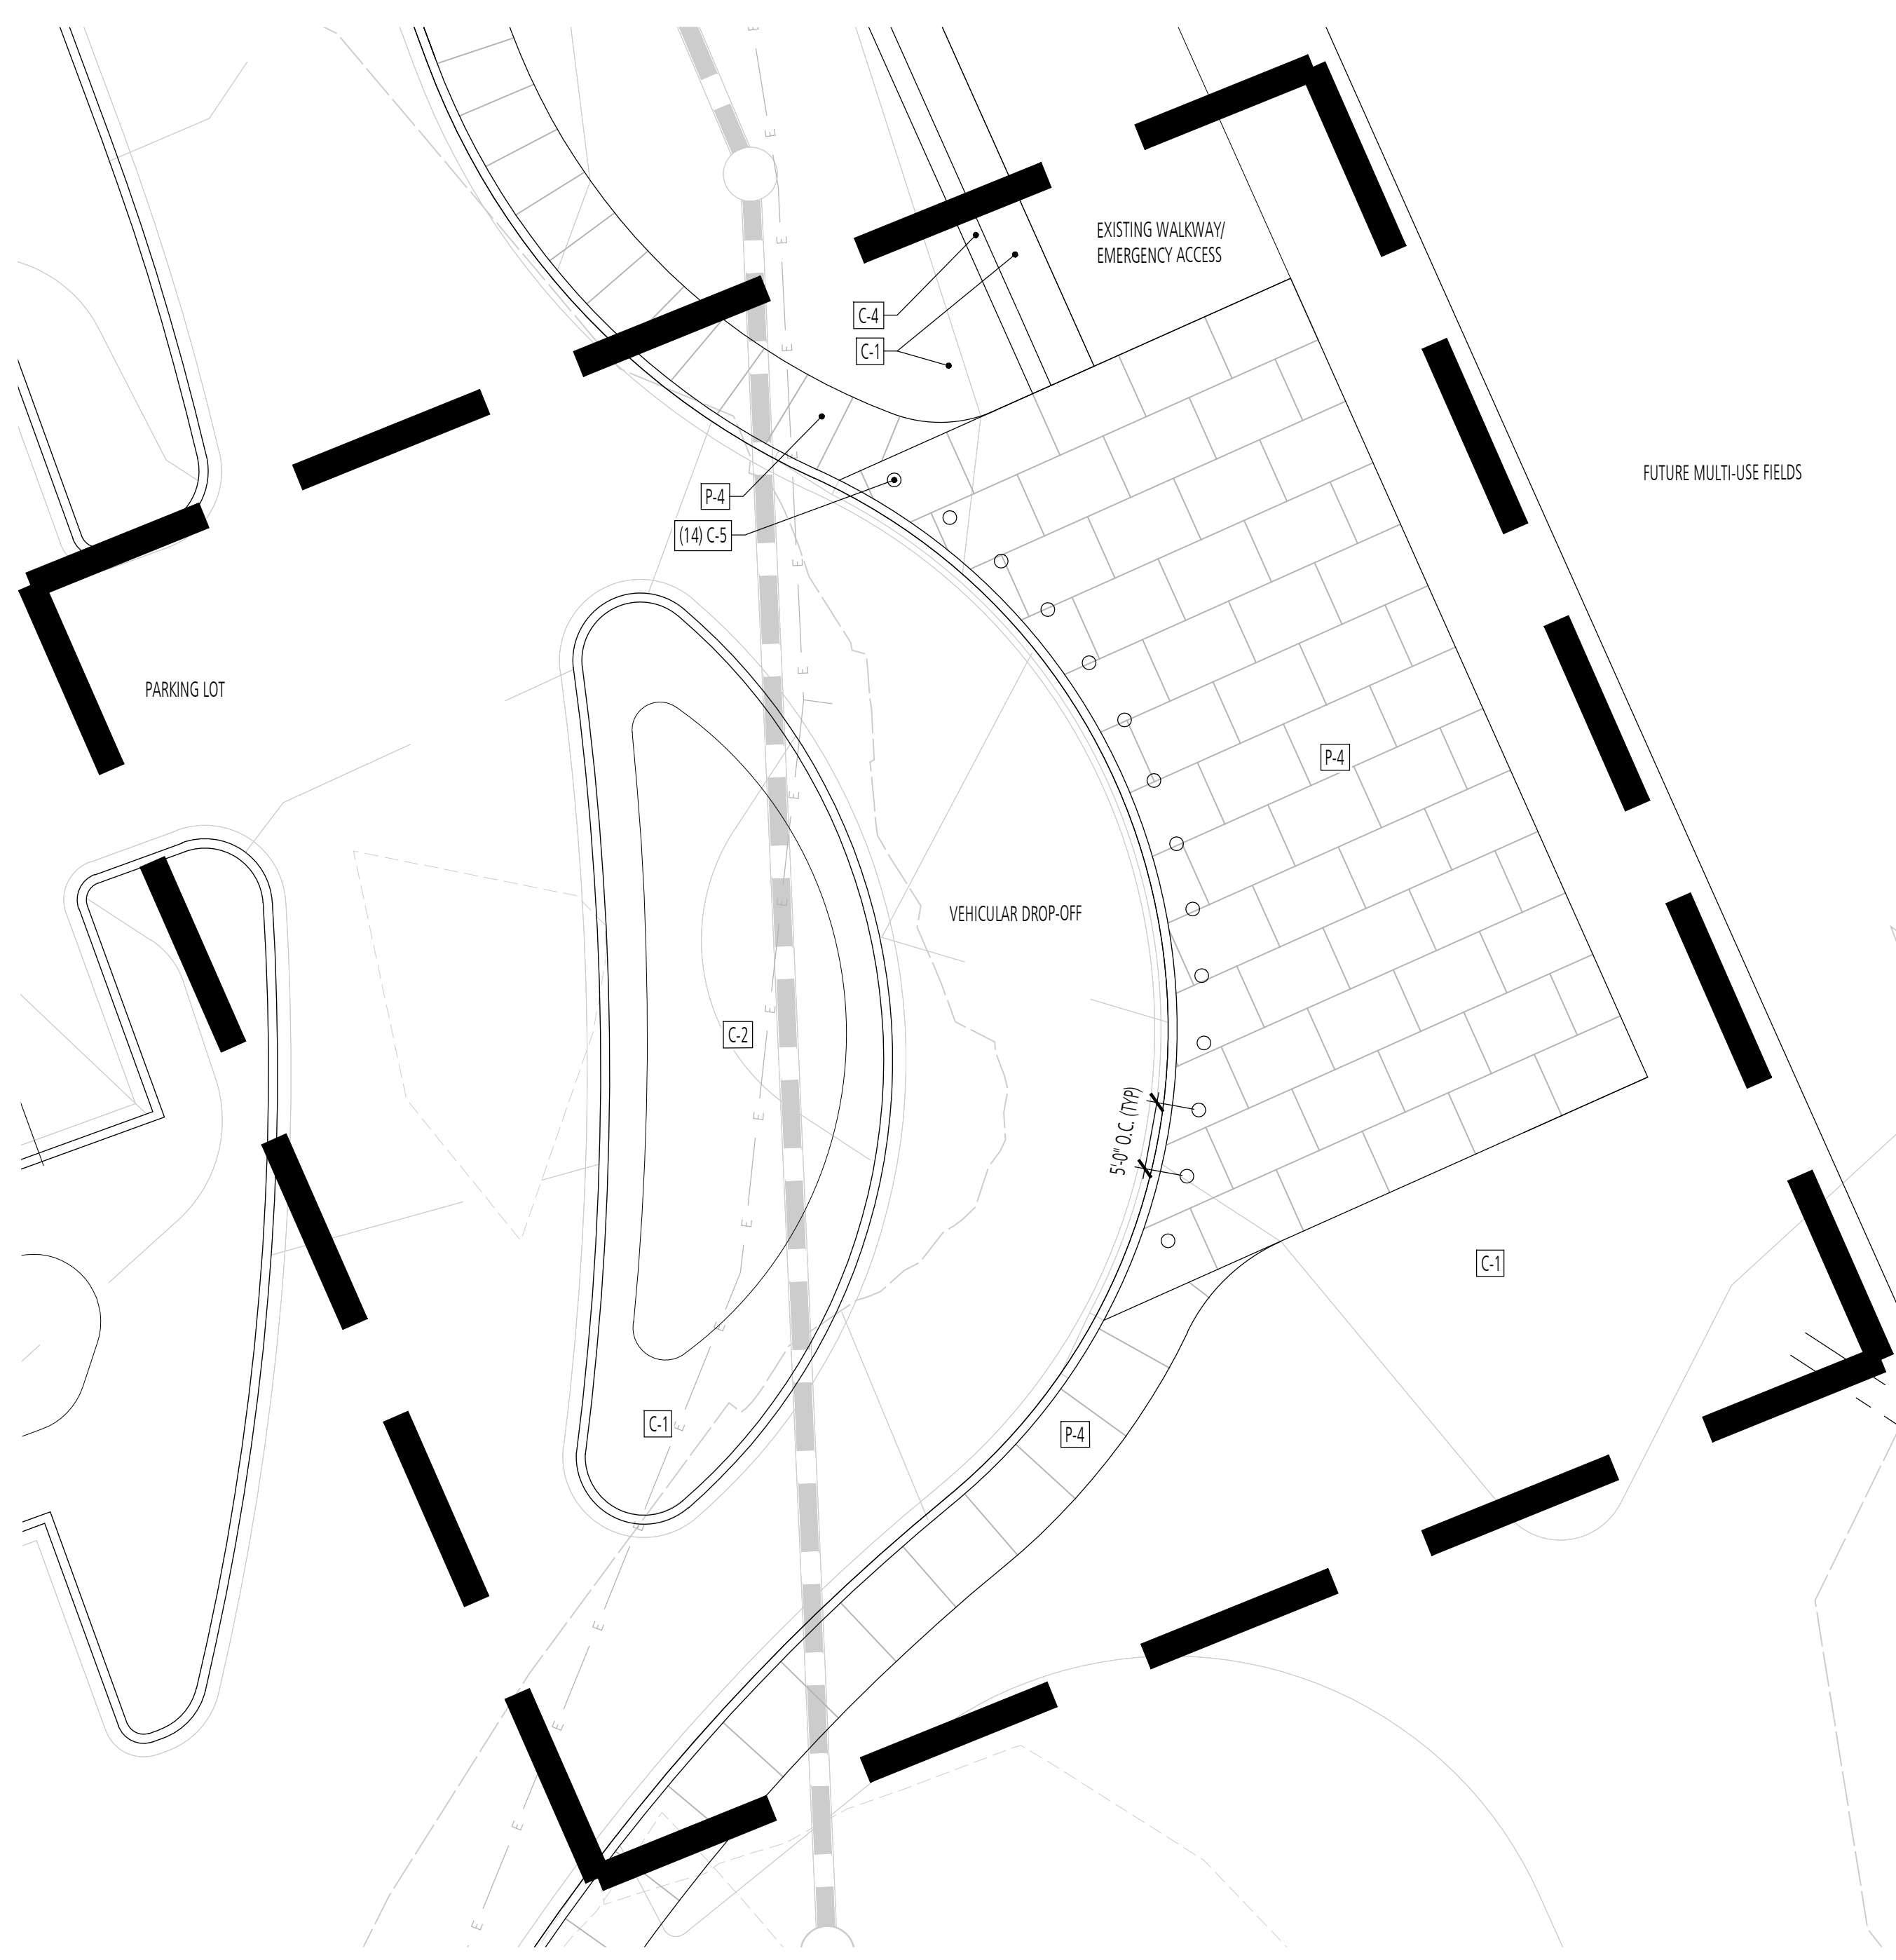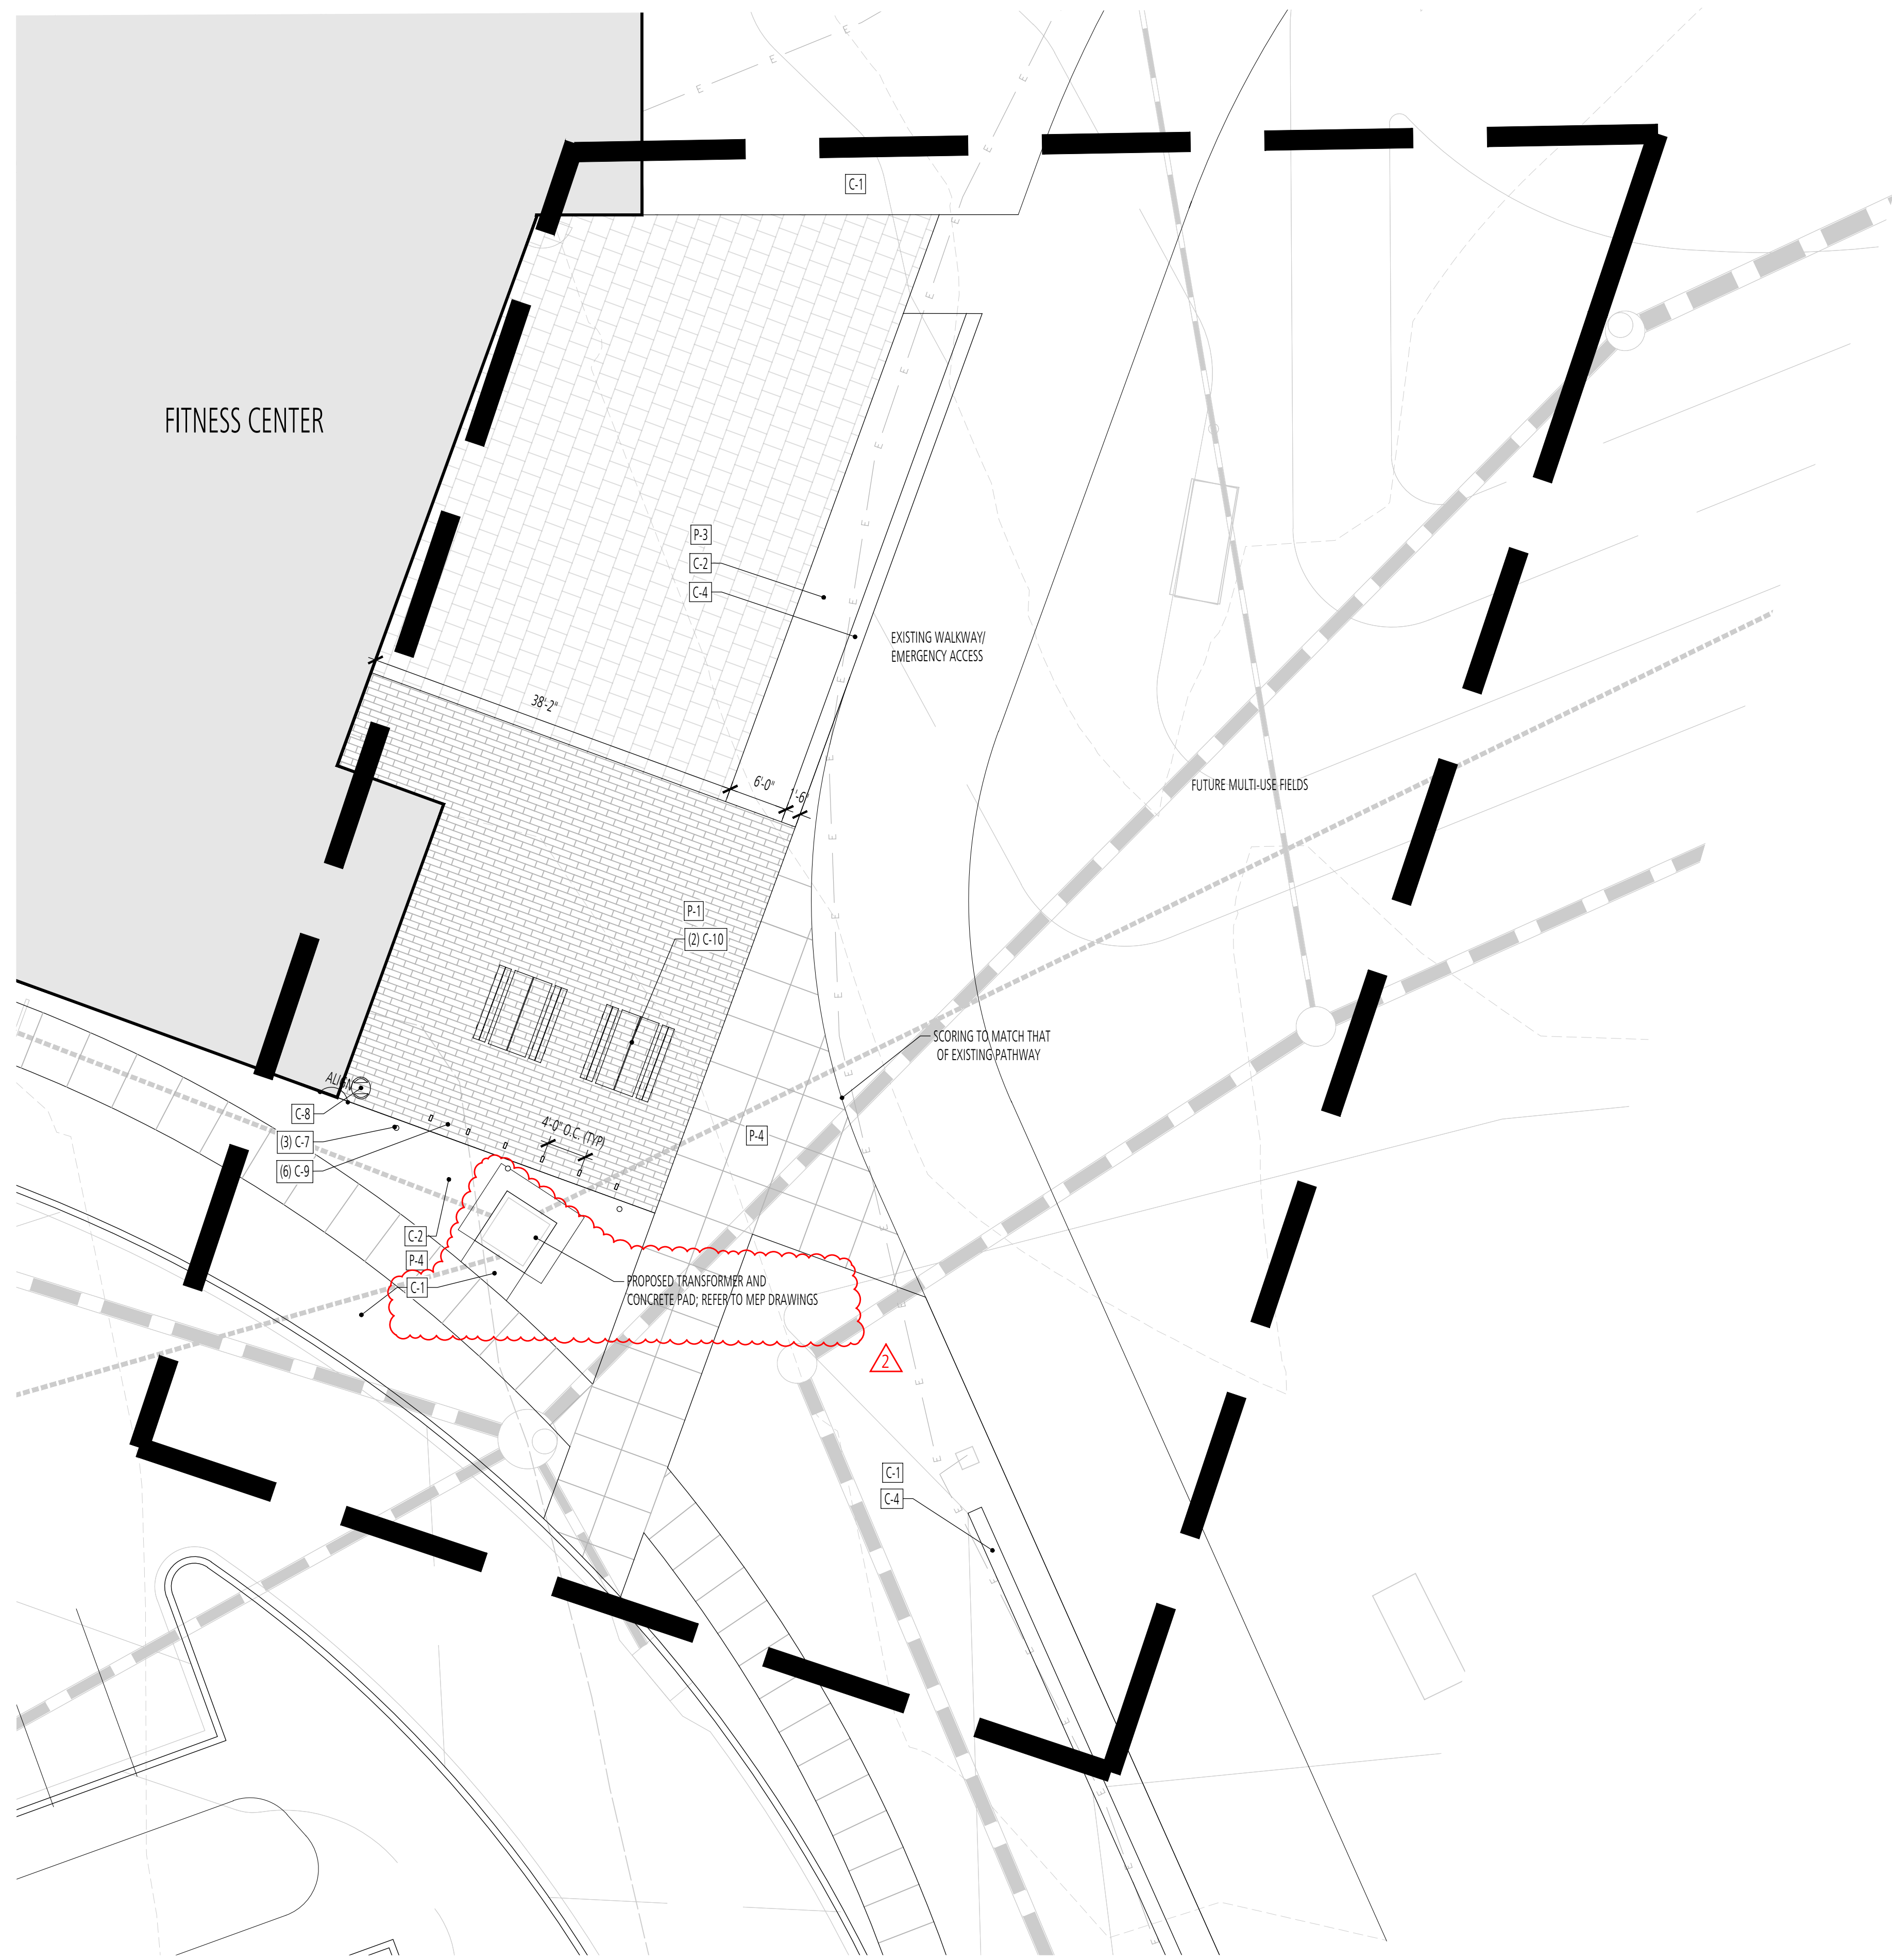

1 HARDSCAPE ENLARGEMENT PLAN - PARK PLAZA
PLAN

FTLA_L1.02-Hardscape Enlargement Plans - Park Plaza and Field Drop Off
SCALE: 1"=10'-0"

2 HARDSCAPE ENLARGEMENT PLAN - FIELD DROP OFF
PLAN

HARDSCAPE ENLARGEMENT PLAN - PARK PLAZA
SCALE: 1"=10'-0"

ISSUED FOR BID

Seal: _____




© 2019 GWWO INC.
I CERTIFY THAT THESE DOCUMENTS WERE PREPARED OR APPROVED BY ME, AND THAT I AM A FULLY LICENSED ARCHITECT UNDER THE LAWS OF THE STATE OF MARYLAND. LICENSE NUMBER: XXXXXXXXX, EXPIRATION DATE XXXXXXXXX

Revisions:	No.	Date	Description
	1	1/13/2020	Addendum 1
	2	1/28/2020	Addendum 2

MIDDLE BRANCH FITNESS & WELLNESS CENTER AT CHERRY HILL
BALTIMORE CITY RECREATION & PARKS

Job No.	#18010	Author	Drawn
Scale		Checker	Checked
Date	01/28/2019	Approver	Approved
Drawing Title	Drawing Number		
HARDSCAPE ENLARGEMENTS - PARK PLAZA AND FIELD DROP OFF	L1.02r2		
Sheet	Of		

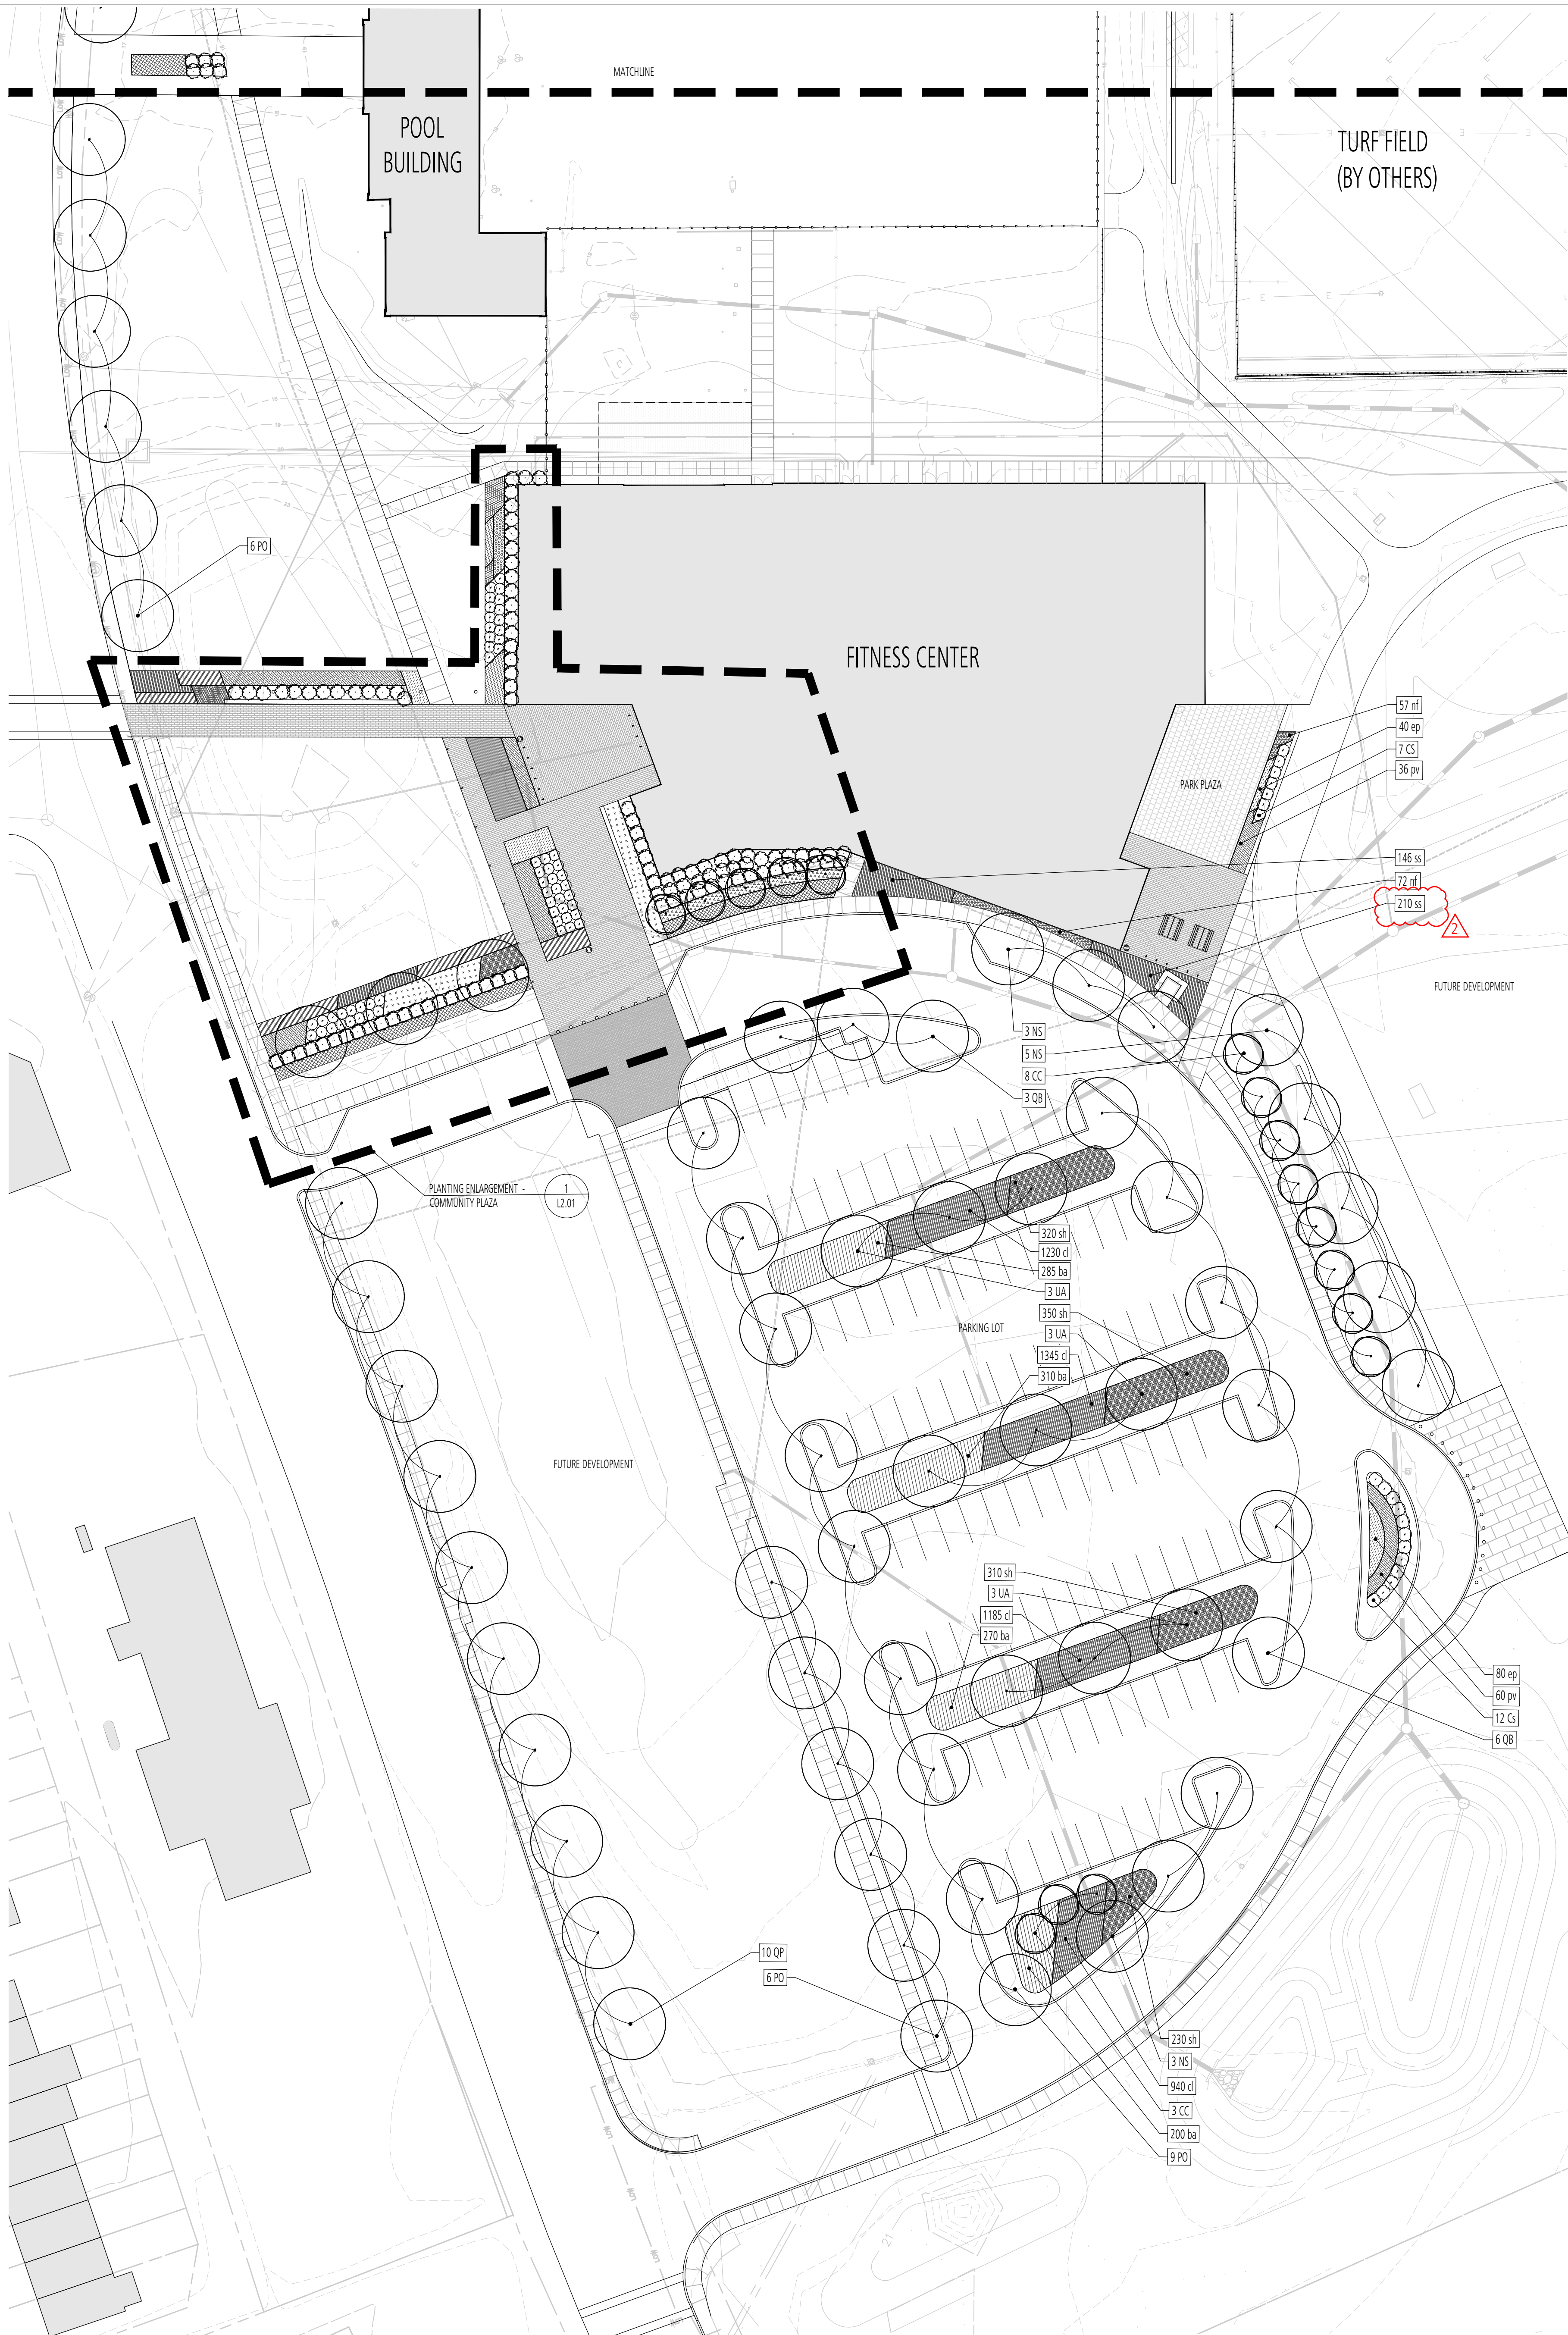


STREETScape, PARKING LOT, AND PARK PLAZA PLANT SCHEDULE:


Symbol	Quantity	Botanical Name	Common Name	Size	Note	Native or Adaptive
NS	11	Nyssa sylvatica	Black Gum	3" Cal	B&B	Native
PO	15	Platanus occidentalis	Sycamore	3" Cal	B&B	Native
QB	9	Quercus bicolor	Swamp White Oak	3" Cal	B&B	Native
QP	16	Quercus phellos	Willow Oak	3" Cal	B&B	Native
UA	10	Ulmus americana 'Princeton'	Princeton Elm	3" Cal	B&B	Native
Minor Trees						
Symbol	Quantity	Botanical Name	Common Name	Size	Note	Native or Adaptive
CC	11	Cercis canadensis	Eastern Redbud	8" ht.	B&B	Native
Deciduous & Coniferous Shrubs						
Symbol	Quantity	Botanical Name	Common Name	Size	Note	Native or Adaptive
Cs	19	Cornus stolonifera 'Farrow'	Arctic Fire Red Twig Dogwood	24" Ht.	CG	Native
Grasses and Perennials						
Symbol	Quantity	Botanical Name	Common Name	Size	Note	Native or Adaptive
ba	1065	Baptisia australis	Wild Blue Indigo	#SP4	18" OC	Native
cl	4700	Camassia leichtlinii	Large Camas	bulb	plant randomly in groups of 3 bulbs	Native
ep	120	Echinacea purpurea	Purple Coneflower	1 Qt.	15" OC	Native
mc	42	Muhlenbergia capillaris	Pink Muhly Grass	1 Gal.	24" OC	Native
mf	125	Nepeta x faassenii 'Walker's Low'	Walker's Low Catmint	1 Qt.	18" OC	Native
pv	84	Panicum virgatum 'Shenandoah'	Switchgrass	1 Gal.	24" OC	Native
rf	197	Rudbeckia fulgida var. fulgida	Black Eyed Susan	1 Qt.	15" OC	Native
sh	1210	Sporobolus heterolepis	Prairie Dropseed	1 Gal.	24" OC	Native
ss	356	Schizacyrium scoparium 'Standing Ovation'	Little Blue Stem	1 Gal.	18" OC	Native

PLANTING NOTES:

1. ALL PLANT MATERIAL SHALL CONFORM TO THE SIZES GIVEN IN THE PLANT SCHEDULE AND SHALL BE NURSERY GROWN IN ACCORDANCE WITH THE 'AMERICAN STANDARDS FOR NURSERY STOCK, ANSI Z60.1-2004' LATEST EDITION PREPARED BY THE AMERICAN ASSOCIATION OF NURSERMEN, 230 SOUTHERN BUILDING, WASHINGTON, D.C. 20005.
2. CONTRACTOR MUST VERIFY THE CORRECT LOCATION OF ANY EXISTING UTILITIES WHICH ARE UNDERGROUND, PRIOR TO PLANT INSTALLATION. THE CONTRACTOR SHALL CALL MISS UTILITY (1-800-353-7777) A MINIMUM OF 48 HOURS PRIOR TO CONSTRUCTION. CONTRACTOR IS RESPONSIBLE FOR OBTAINING ALL PERMITS AND REQUIREMENTS FOR CONSTRUCTION.
3. ALL PLANT BEDS SHALL BE MULCHED WITH 3" OF MULCH WITHIN TWO DAYS AFTER PLANTING. THIS SHALL BE SHREDED HARDWOOD BARK, AND SHALL COVER ENTIRELY THE PLANTING BED.
4. ALL PLANTS SHALL BE GUARANTEED TO REMAIN ALIVE AND HEALTHY FOR A PERIOD OF TWO FULL YEARS AFTER INITIAL ACCEPTANCE. ANY REPLACEMENT PLANTS, REQUIREMENTS, ETC. AND METHOD OF PLACING SHALL COMPLY WITH THE REQUIREMENTS SPECIFIED HEREIN, WITHIN THE SPECIFICATIONS, AND ON THE DRAWINGS.
5. EXISTING SOIL IN PLANTING BED AREAS SHALL BE AMENDED TO A MINIMUM DEPTH OF 12" PER THE SOIL PLACEMENT SPECIFICATIONS.
6. PLANT MATERIAL AVAILABILITY MAY VARY AT THE TIME OF CONSTRUCTION. ANY SUBSTITUTIONS ARE TO BE OF EQUIVALENT TYPE AND SIZE (OR LARGER), AND MUST BE APPROVED BY ENGINEER BEFORE INSTALLATION.
7. WHERE THE CONDITION EXISTS THAT THE BALLED AND BURLAPPED TREES ARE DELIVERED IN WIRE BASKETS, THE WIRE BASKETS SHALL BE CUT DOWN THE SIDE OF EACH MESH AND PEELLED AWAY FROM THE ROOTBALL OR REMOVED ENTIRELY. NO PORTION OF THE WIRE BASKET SHALL REMAIN INTACT AROUND THE SIDES OF THE ROOTBALL OR EXTEND ABOVE FINISHED GRADE.
8. ANY DAMAGE TO THE EXISTING UTILITIES, BUILDINGS, PARKING, CURBS, WALLS, VEGETATION AND ANY OTHER EXISTING FEATURES NOT DESIGNATED FOR REMOVAL ON THESE PLANS, SHALL BE REPAIRED TO PREVIOUS CONDITION OR REPLACED BY THE CONTRACTOR AT HIS OR HER EXPENSE. ALL AREAS DISTURBED DURING CONSTRUCTION ARE TO BE SEEDED PER THE PLANS AND SPECIFICATION UNLESS OTHERWISE NOTED.
9. FOR PLANTS DENOTED TO 'NATURALIZE', PLANT IN CLUSTERS OF 3-3 PLANTS, RANDOMLY SPACED THROUGHOUT AREA SHOWN ON PLAN.
10. DO NOT PRUNE PLANT MATERIAL TO CONFORM TO SPECIFIED SIZES, HEIGHT AND/OR SPREAD INDICATED IN THE PLANT SCHEDULE SHALL BE THE MINIMUM ACCEPTABLE SIZE.

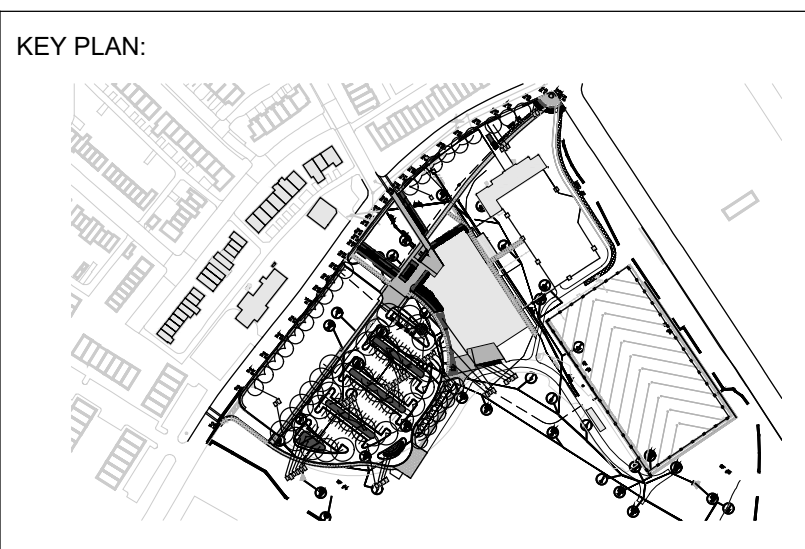

KEYNOTES LISTED ON THIS SHEET ARE FOR CONVENIENCE ONLY. REFER TO SHEET CS-3 FOR COMPLETE LIST

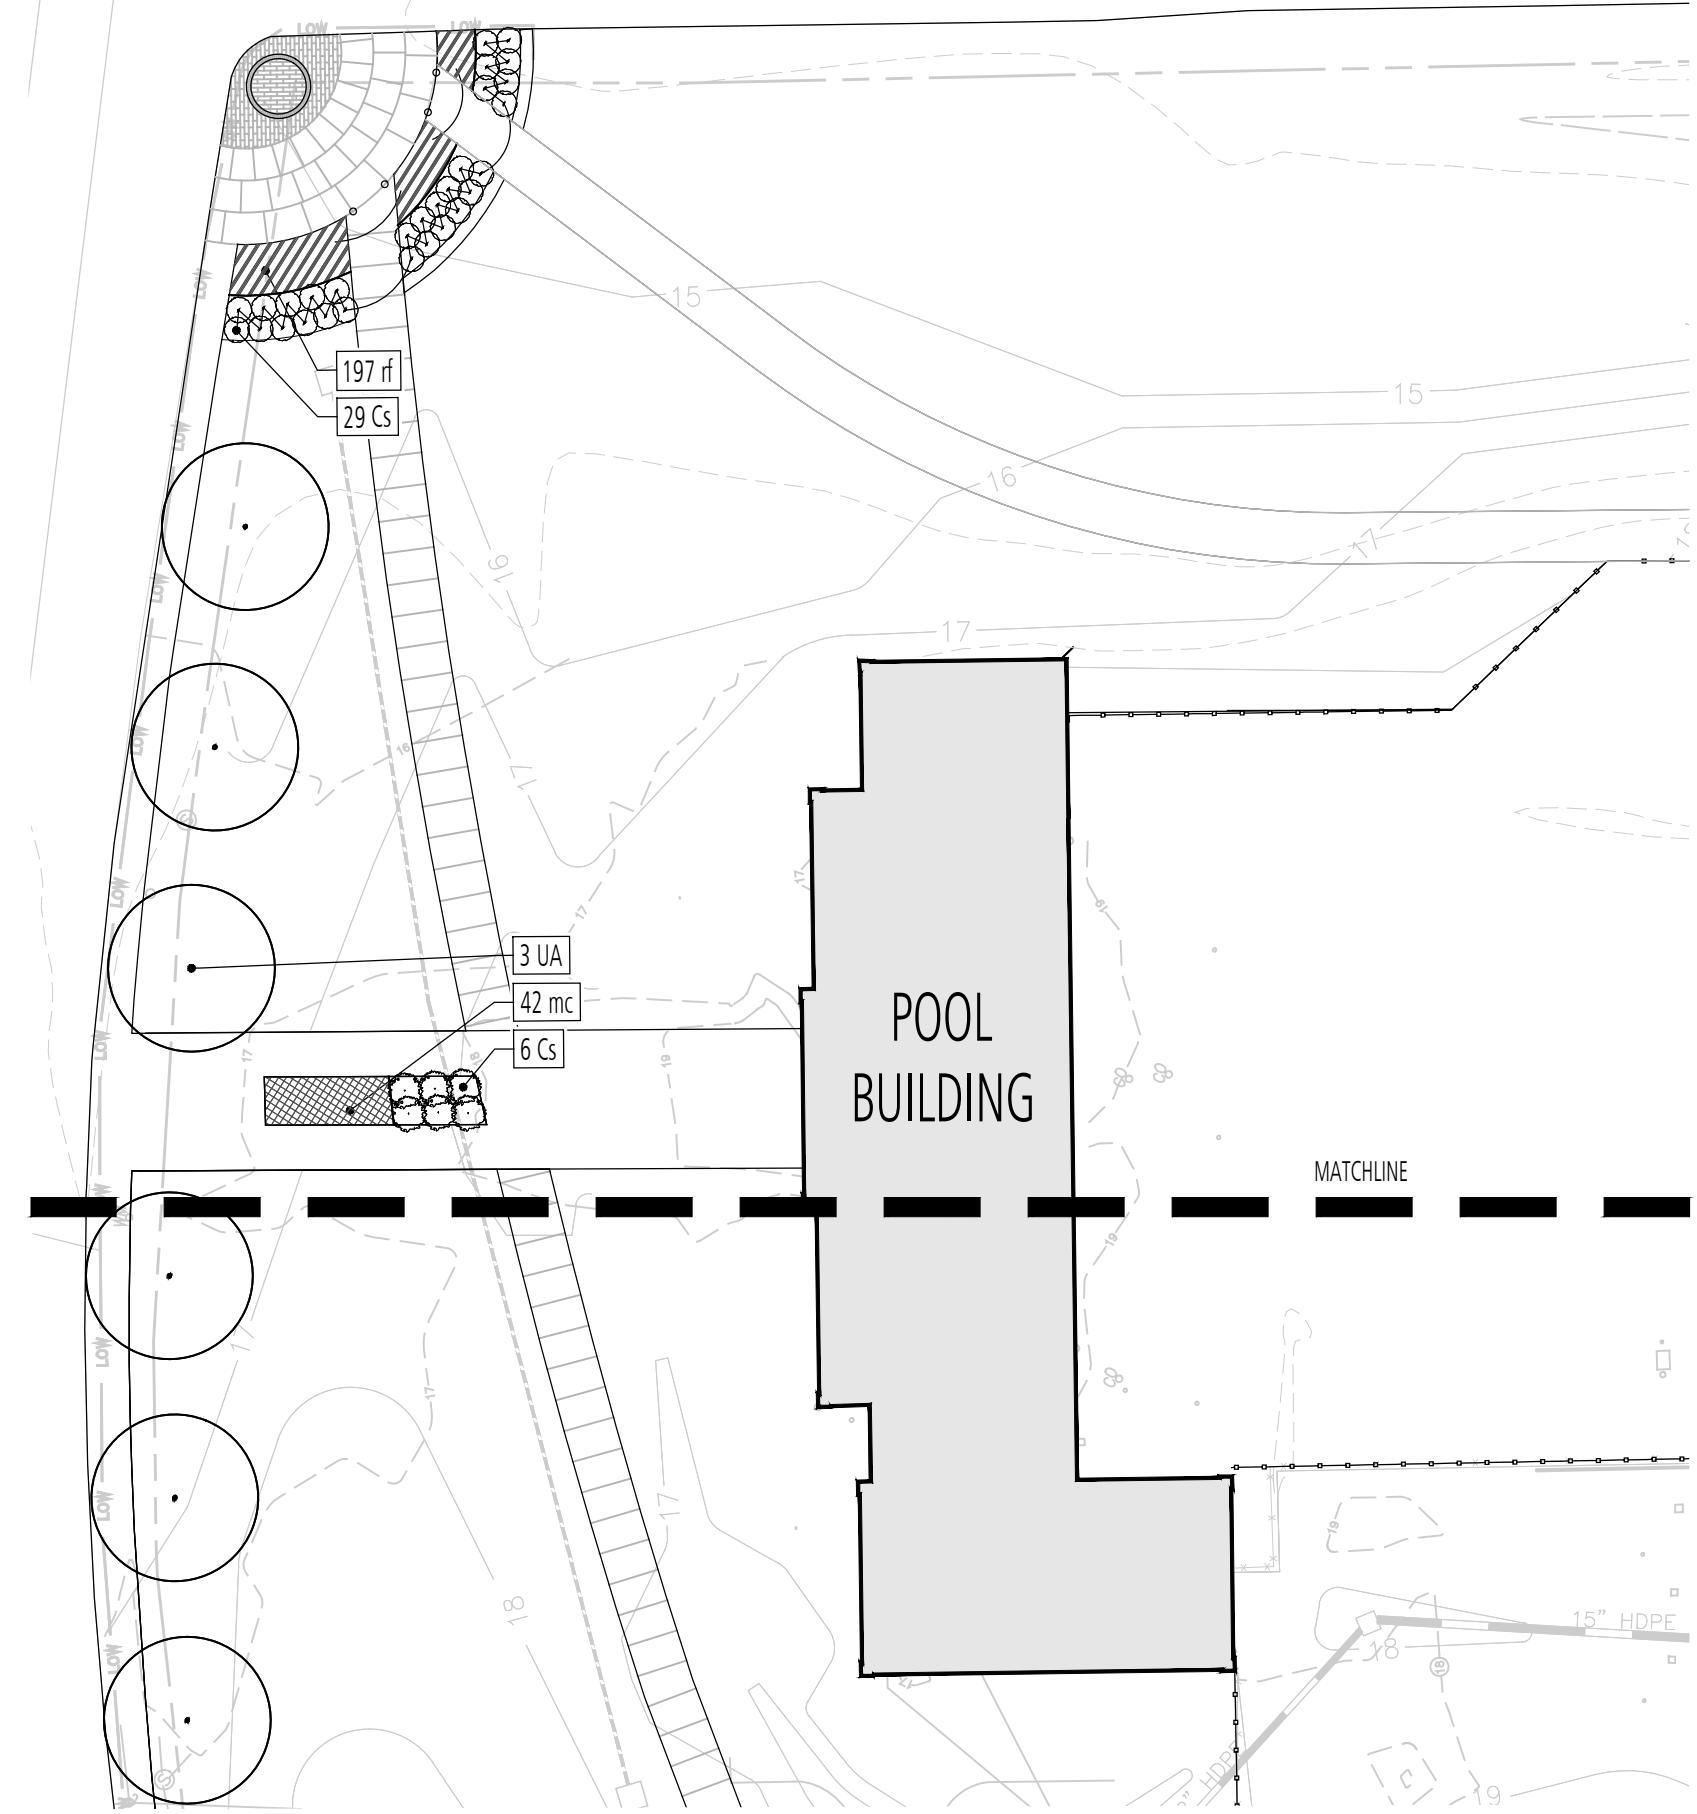

2 NORTHEAST PLANTING PLAN
SCALE: 1"=30'-0"

1 SOUTHWEST PLANTING PLAN
SCALE: 1"=30'-0"

ISSUED FOR BID

Seal:



CERTIFY THAT THESE DOCUMENTS WERE PREPARED OR APPROVED BY ME, AND THAT I AM A DULY LICENSED ARCHITECT UNDER THE LAWS OF THE STATE OF MARYLAND. LICENSE NUMBER: XXX-XXXXXX, EXPIRATION DATE XXXXXXXX

Revisions:	No.	Date	Description
	1	1/13/2020	Addendum 1
	2	1/28/2020	Addendum 2

MIDDLE BRANCH FITNESS & WELLNESS CENTER AT CHERRY HILL








BALTIMORE CITY RECREATION & PARKS

Job No. #18010 Author Drawn
Scale Checker Checked
Date 01/28/2019 Approver Approved

Drawing Title OVERALL PLANTING PLAN Drawing Number L2.00r2
Sheet OF

1/18/2019 3:30:51 PM N:\18Proj\1801006-Rev\1801006-Middle Branch-Architectural.rvt

KEYNOTES LISTED ON THIS SHEET ARE FOR CONVENIENCE ONLY. REFER TO SHEET CS-3 FOR COMPLETE LIST

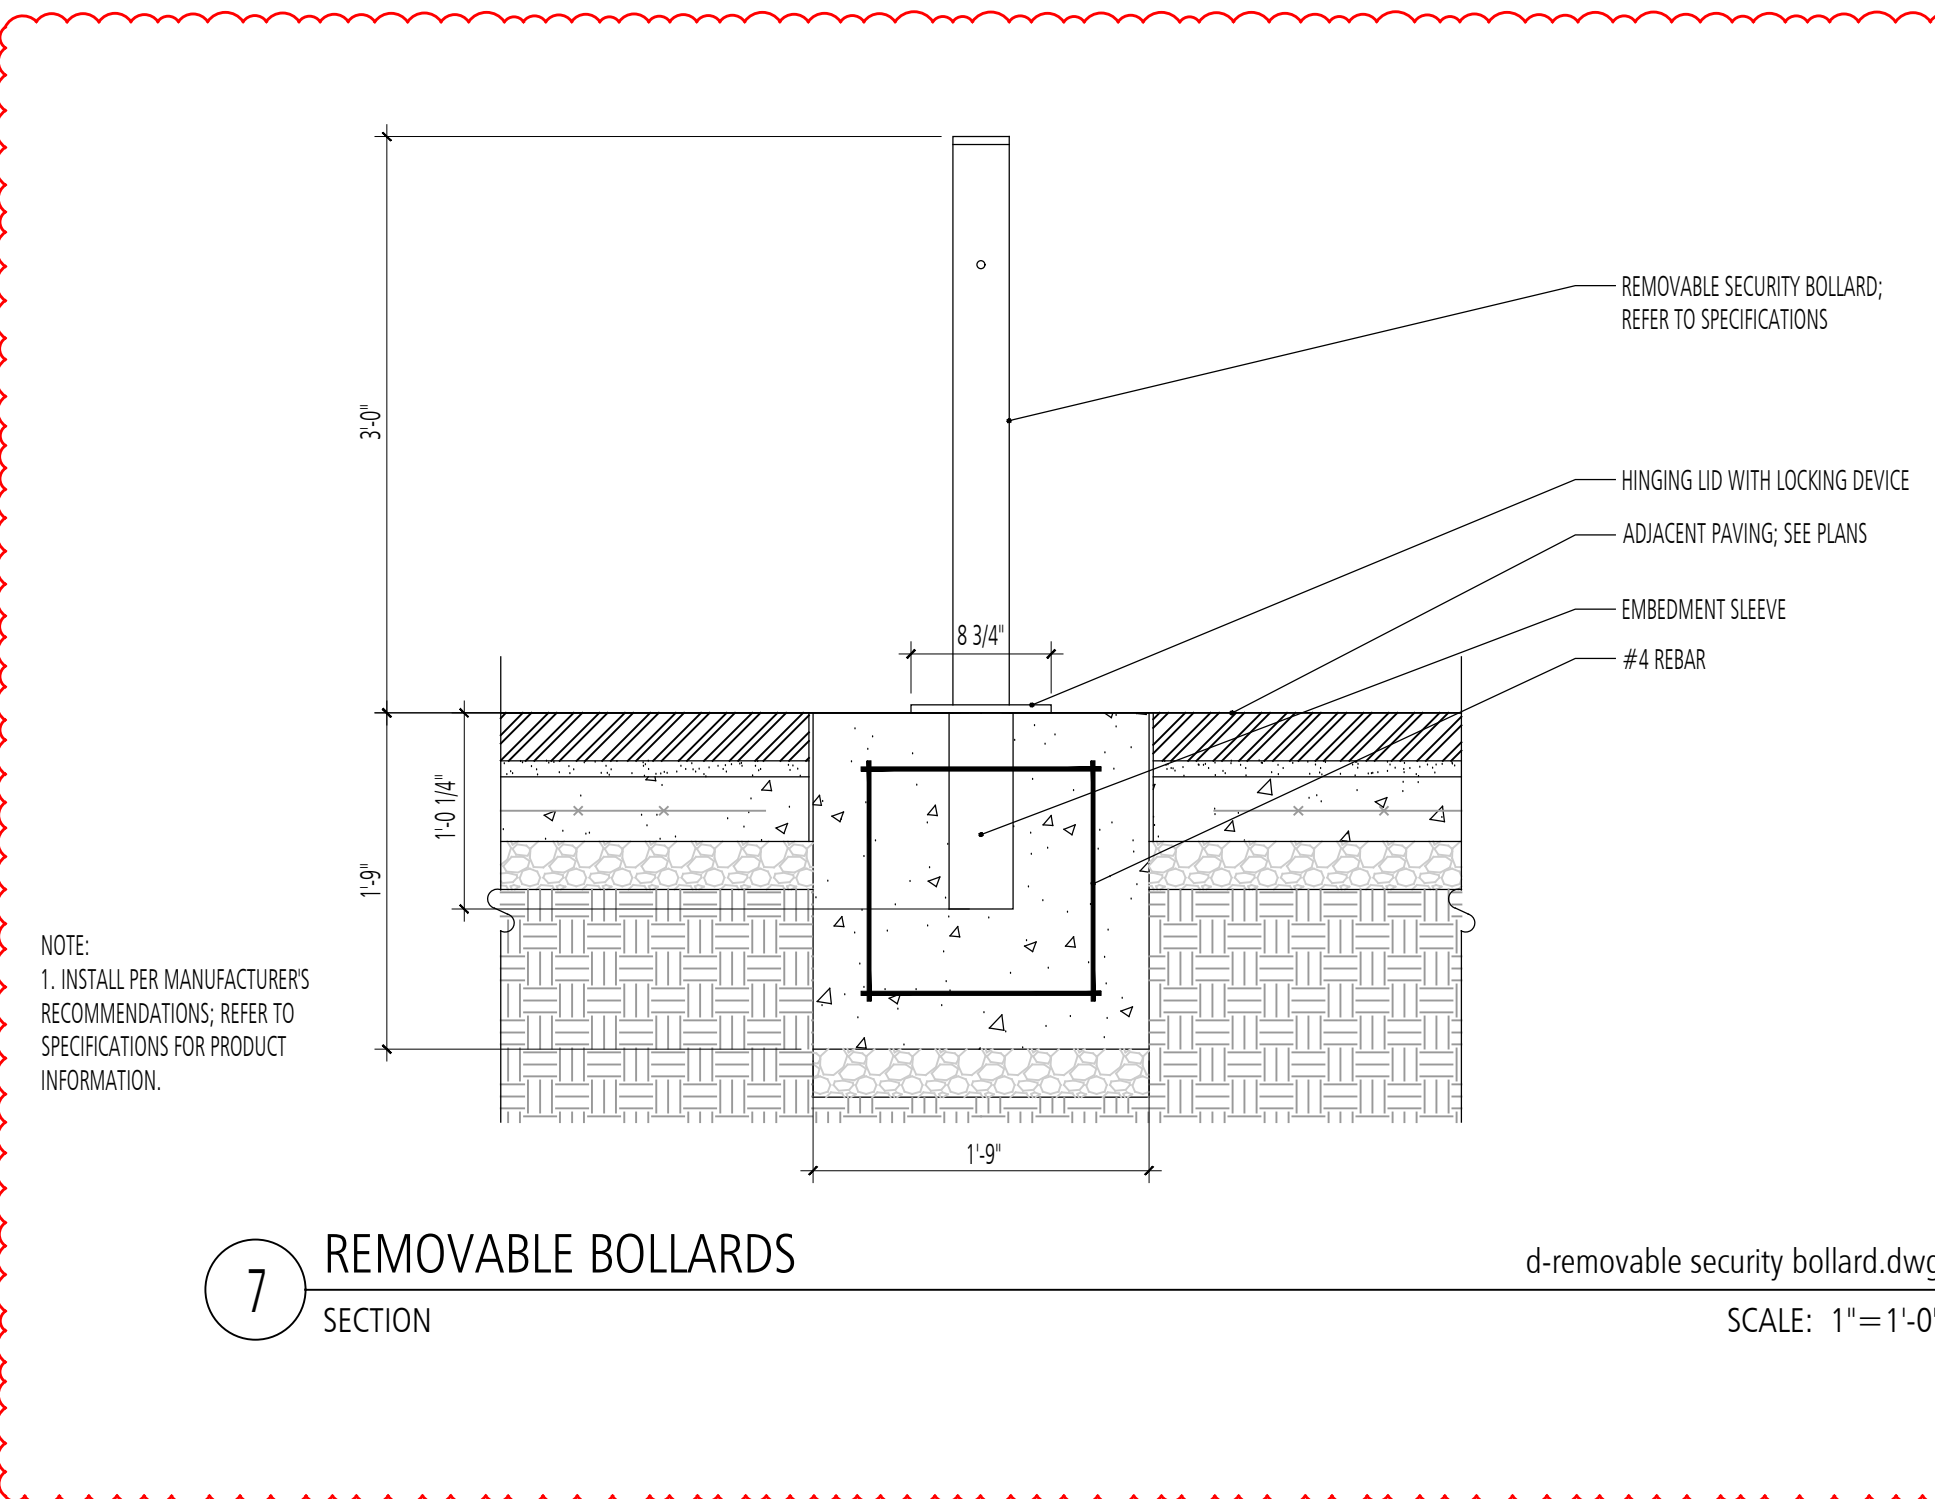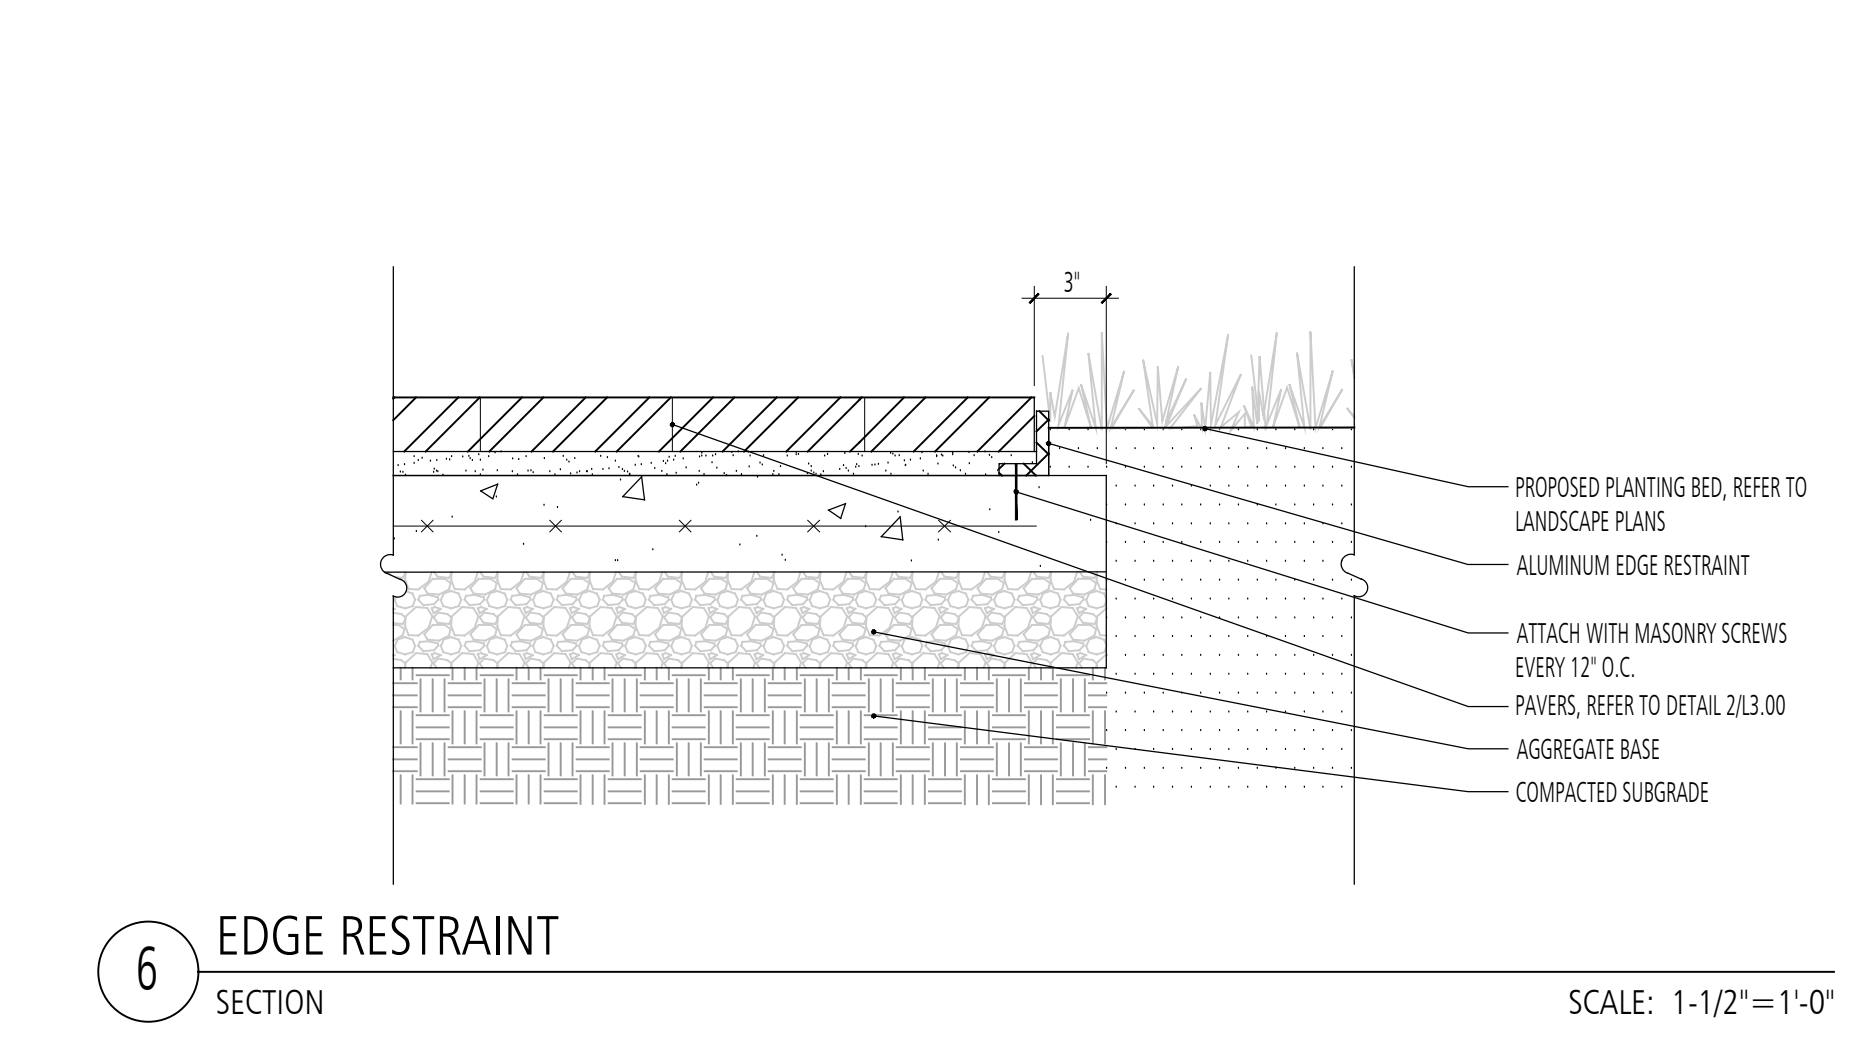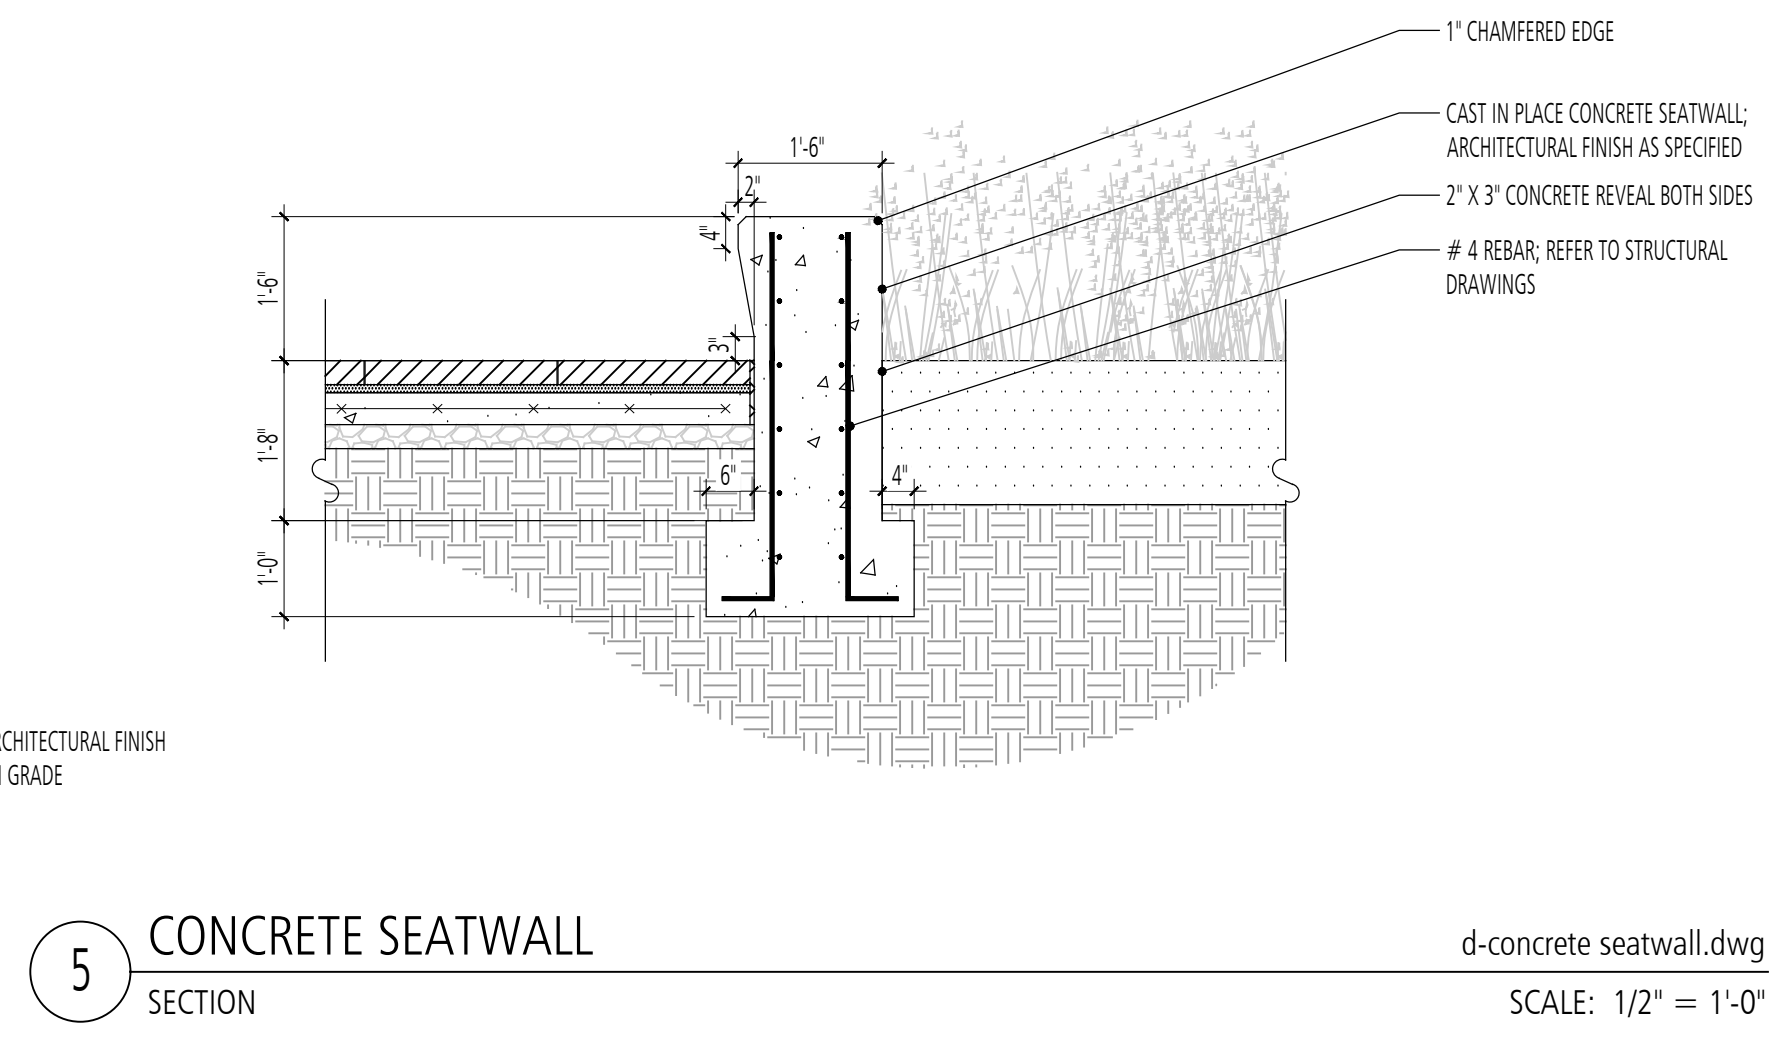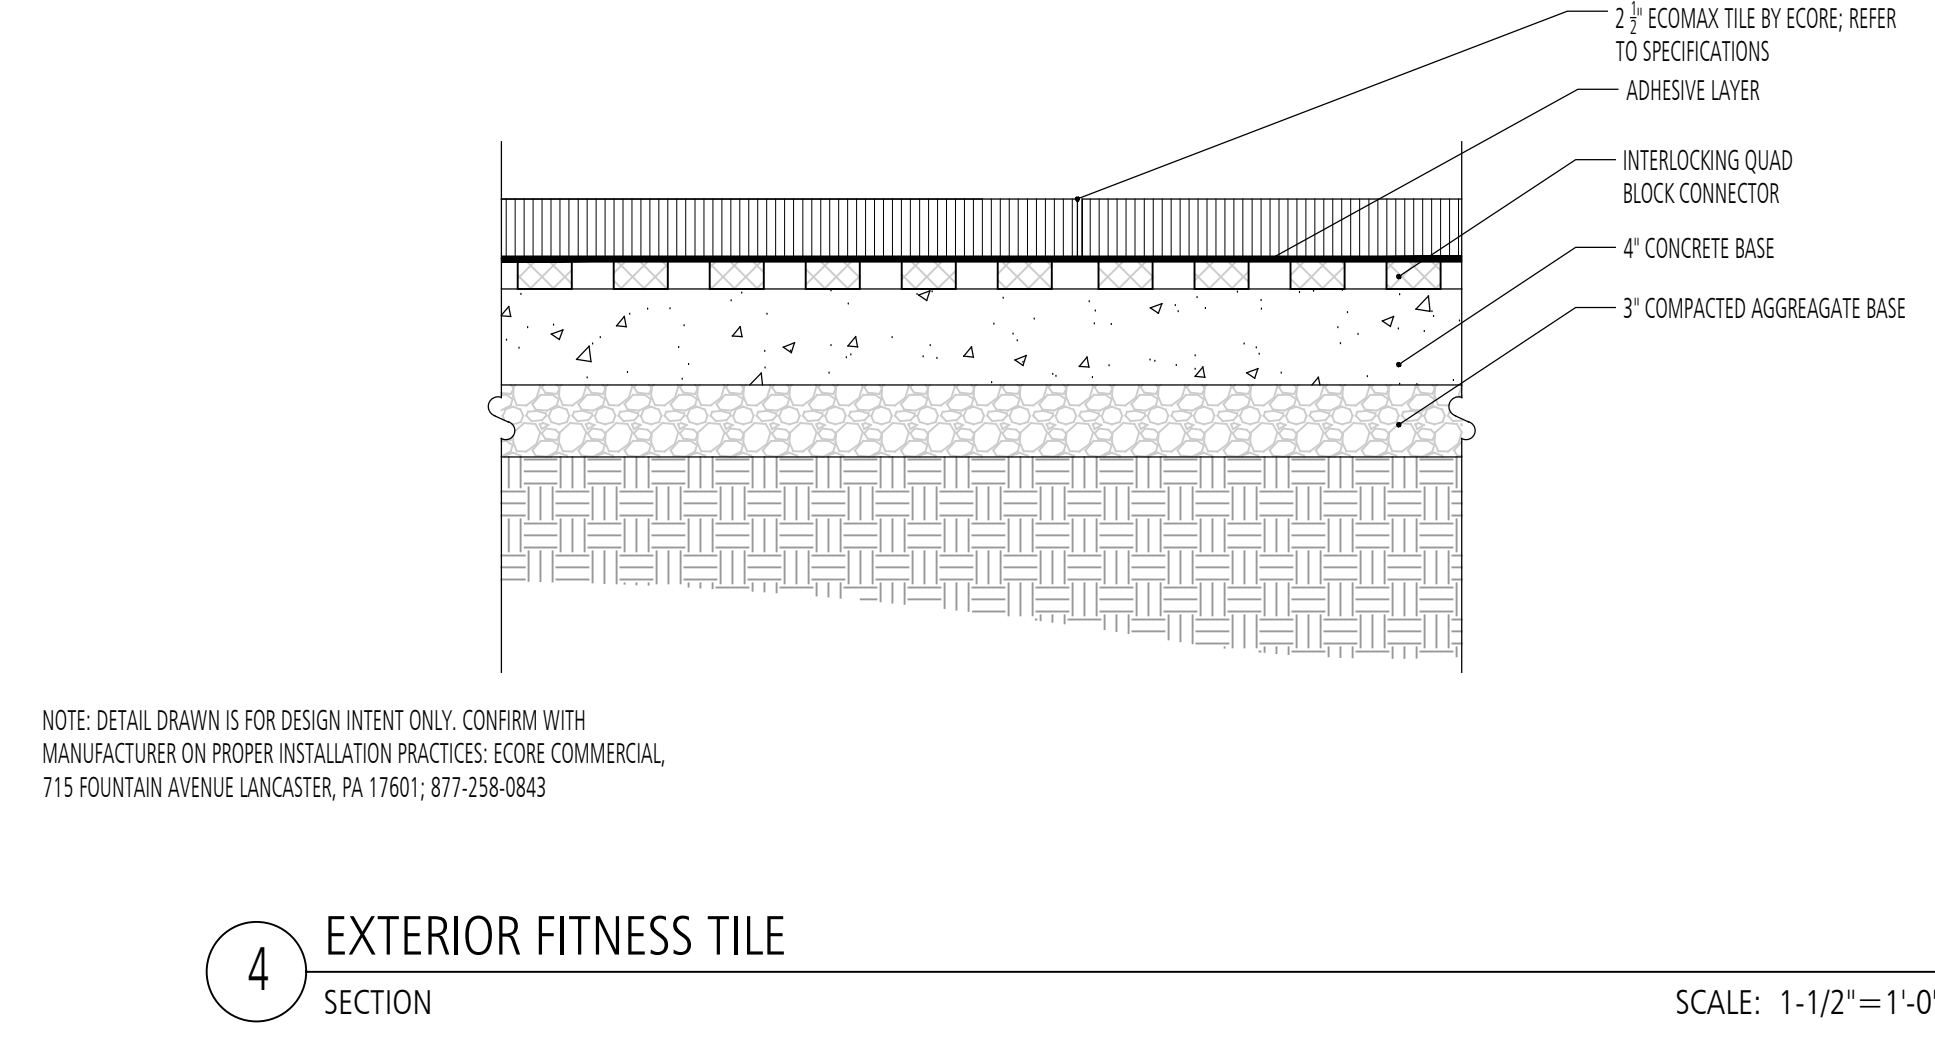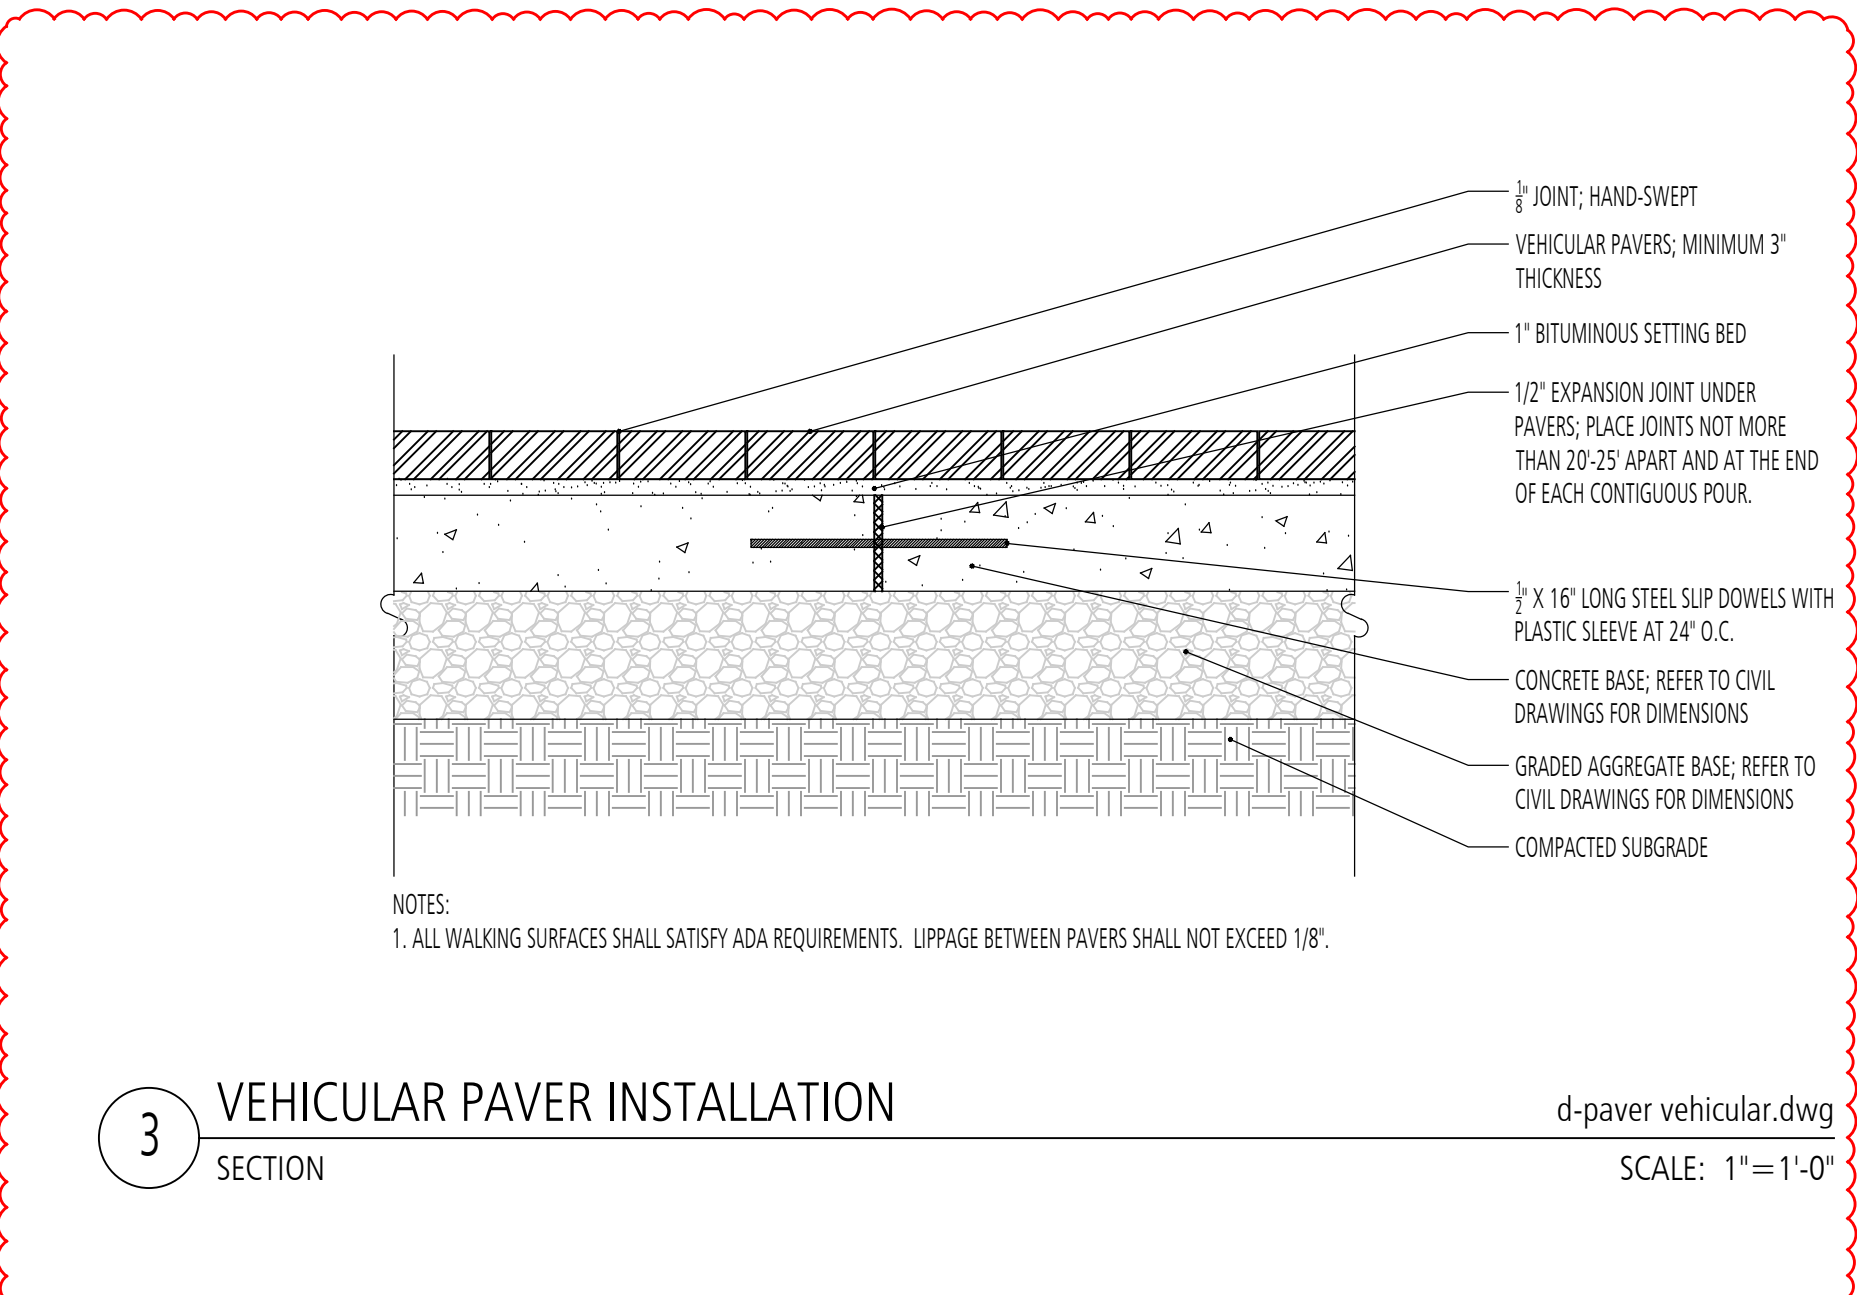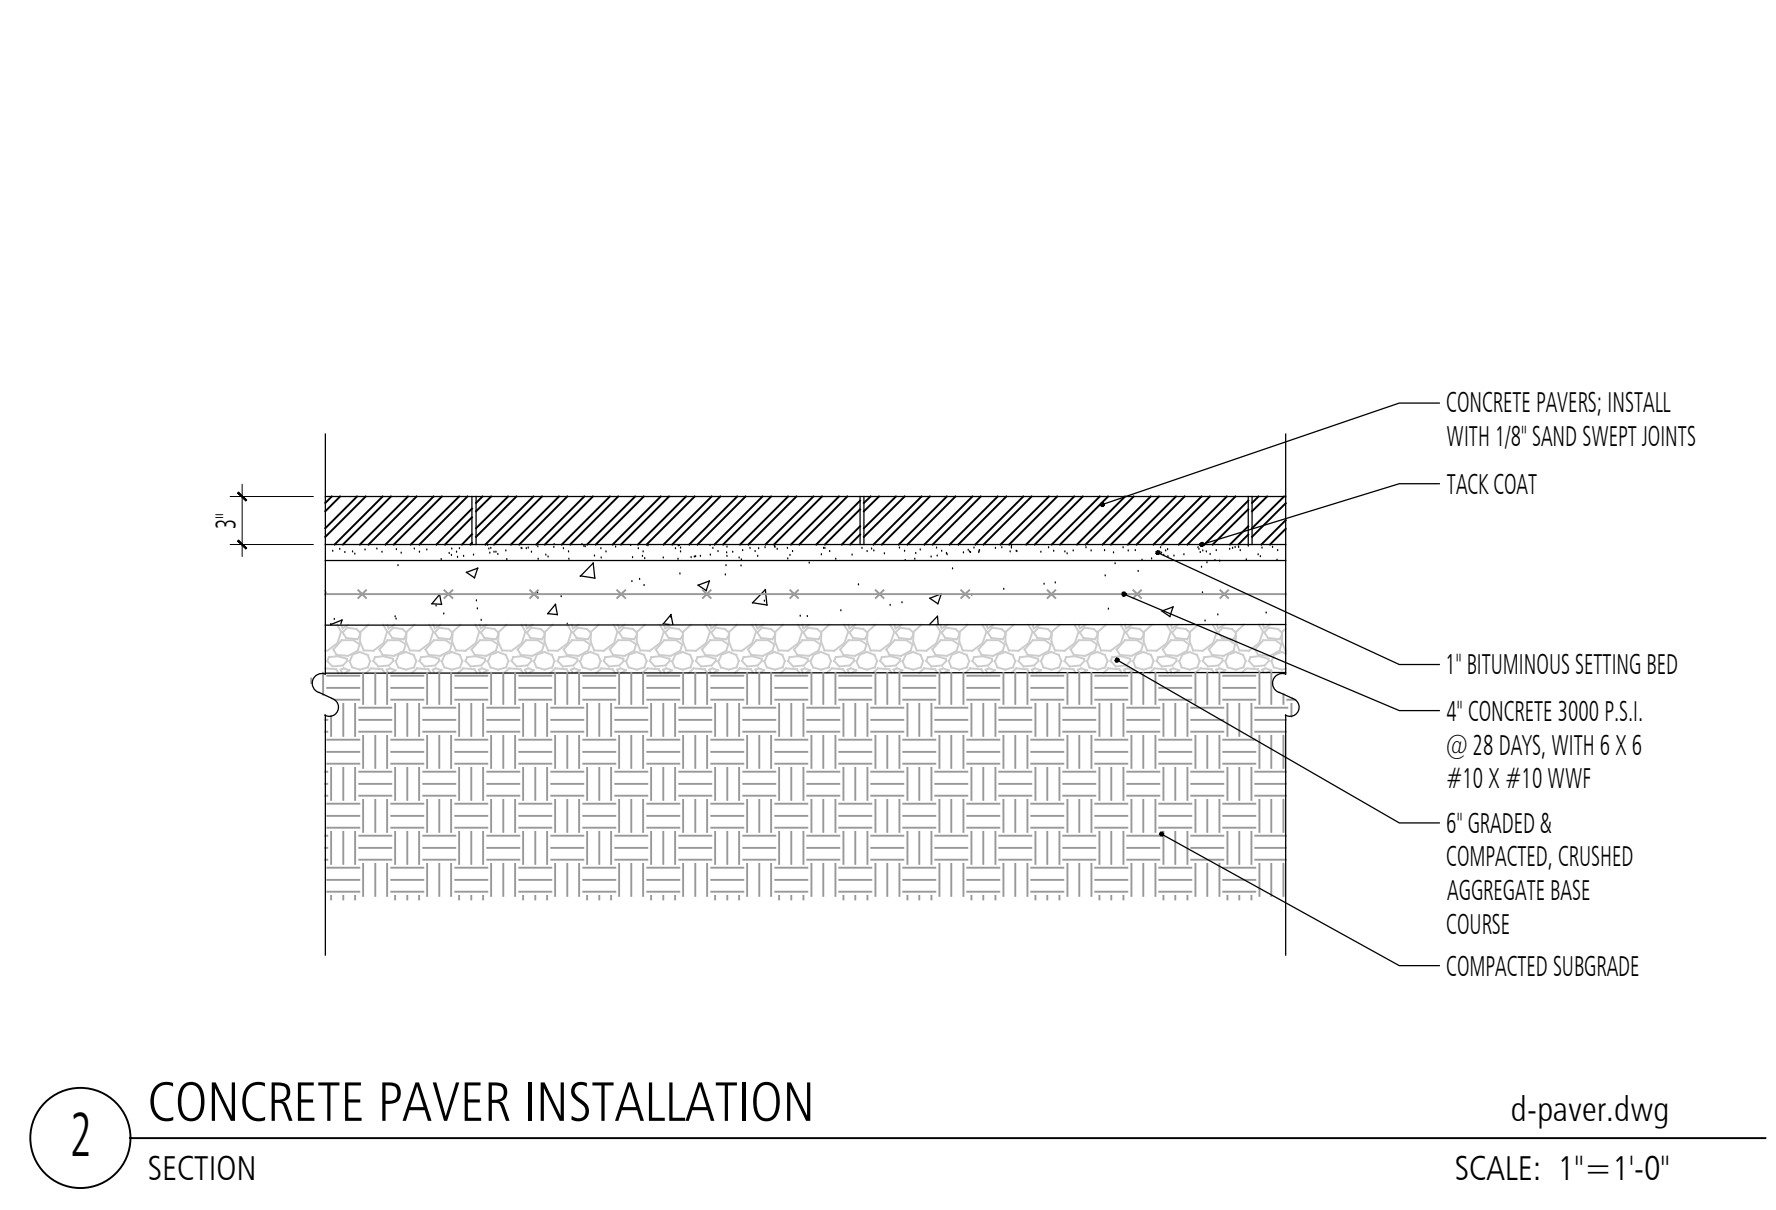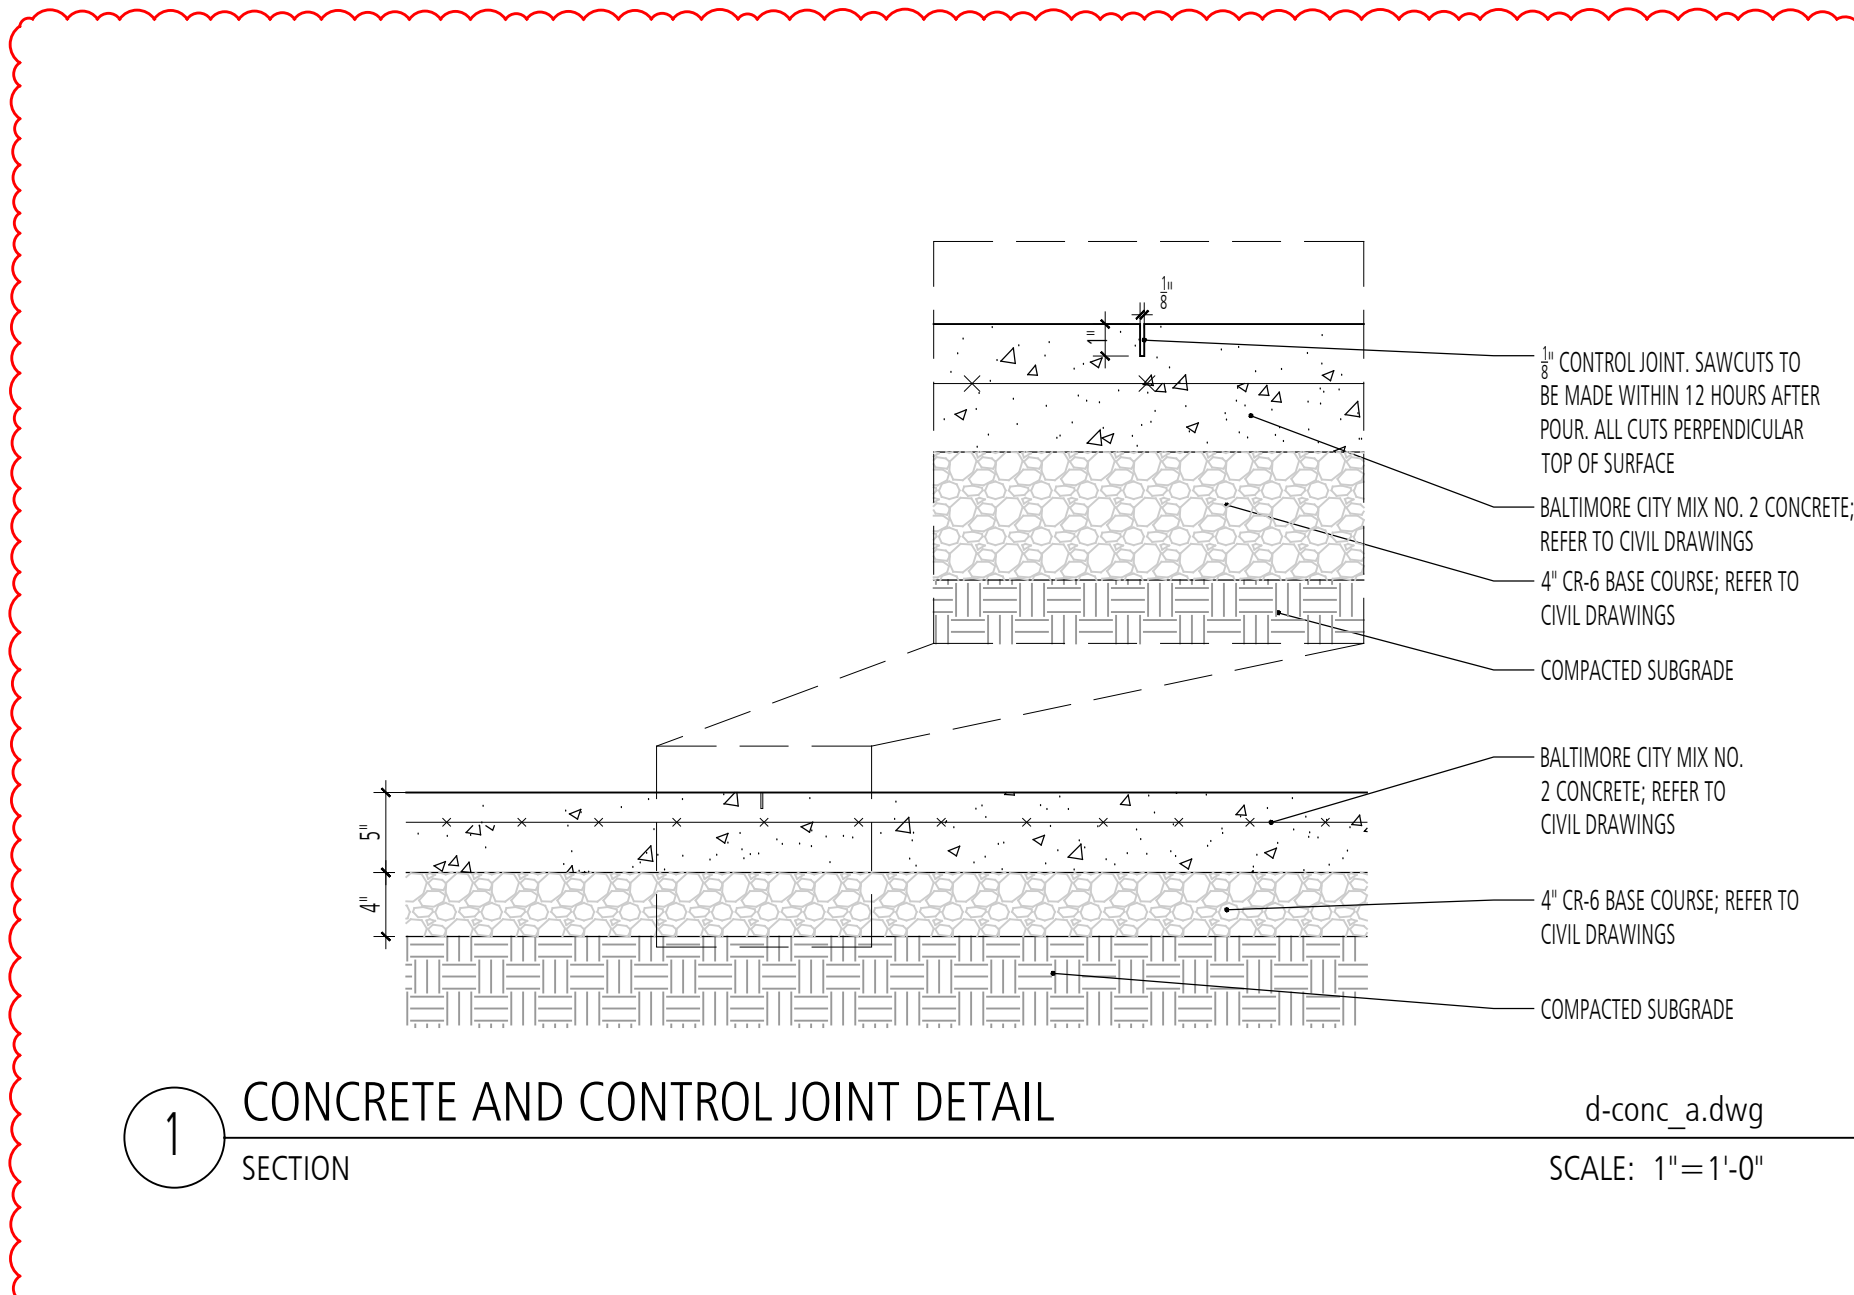

ISSUED FOR BID

Seal:	
-------	--

Seal:	
-------	--

G|W|O
G|W|O INC.
800 WYMAN PARK DRIVE, SUITE 300
BALTIMORE, MARYLAND 21211, 410-332-0099

© 2019 GWWO INC.

CERTIFY THAT THESE DOCUMENTS WERE PREPARED OR APPROVED BY ME, AND THAT I AM A FULLY LICENSED ARCHITECT UNDER THE LAWS OF THE STATE OF MARYLAND. LICENSE NUMBER: XXX-XXXXXX, EXPIRATION DATE XXXXXXXXX

Revisions:	No.	Date	Description
	1	1/13/2020	Addendum 1
	2	1/28/2020	Addendum 2


MIDDLE BRANCH FITNESS & WELLNESS CENTER AT CHERRY HILL

BALTIMORE CITY RECREATION & PARKS


Job No.	#18010	Author	Drawn
Scale		Checker	Checked
Date	01/28/2019	Approver	Approved
Drawing Title	HARDSCAPE DETAILS	Drawing Number	L3.00r2
Sheet			OF

ADDENDUM NO. 2 pg. 104 of 132


KEYNOTES LISTED ON THIS SHEET ARE FOR CONVENIENCE ONLY. REFER TO SHEET CS-3 FOR COMPLETE LIST

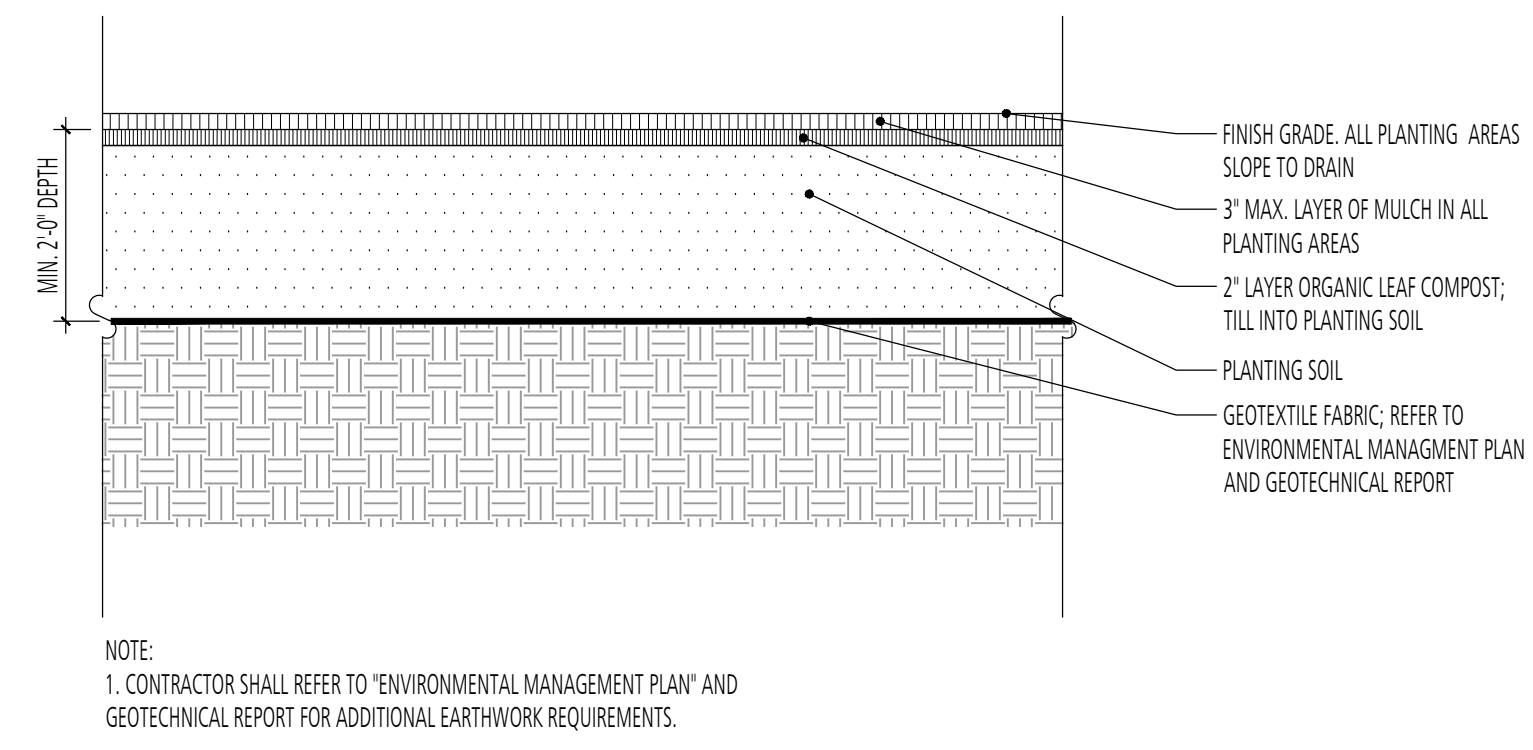


1 SOIL PLACEMENT DETAIL
SECTION
d-bedprep.dwg
SCALE: 1/2" = 1'-0"

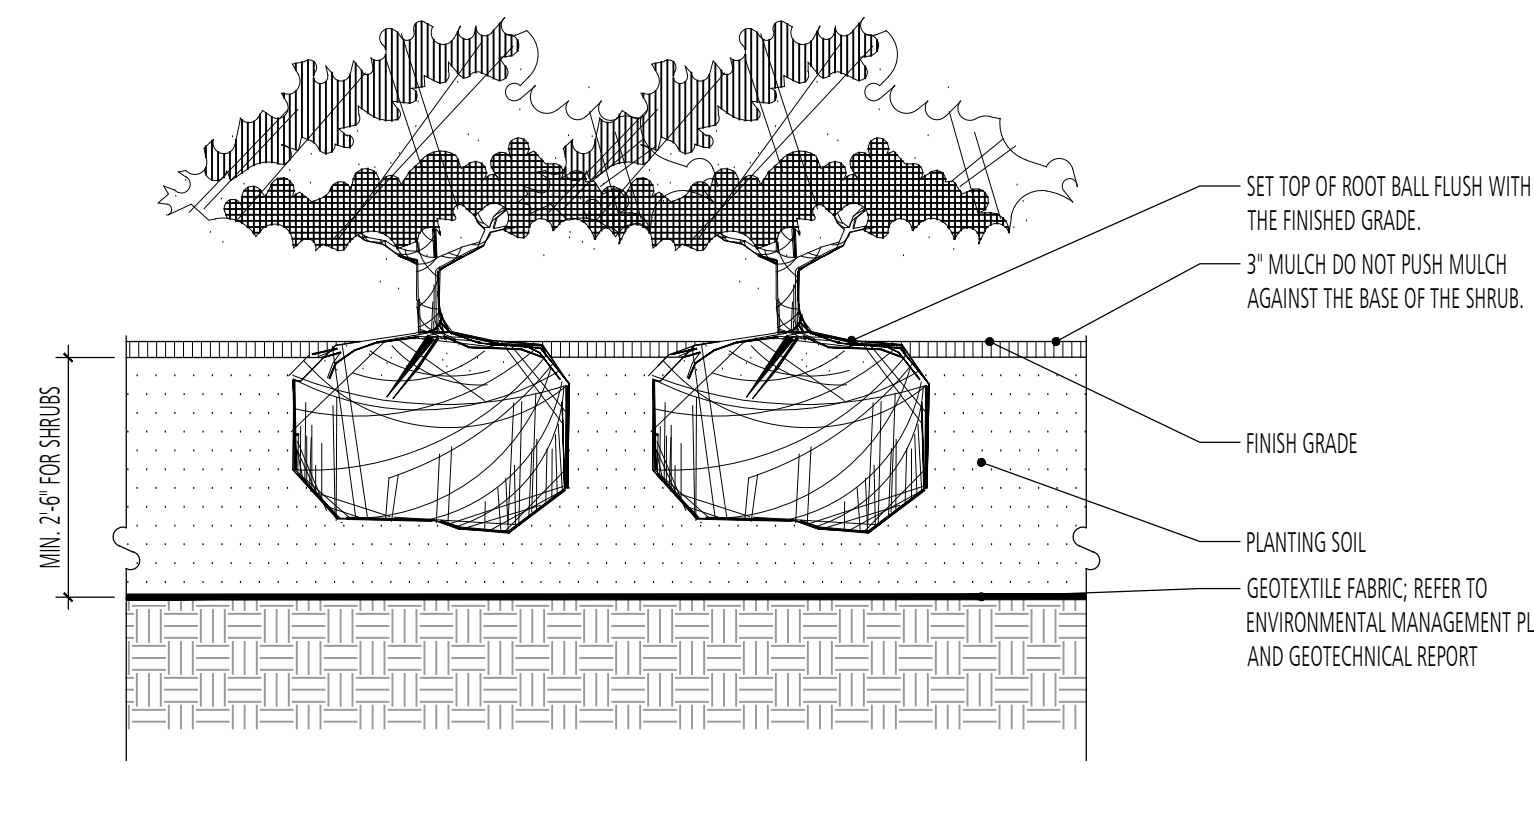


2 SHRUB PLANTING
SECTION
d-shrub_planting.dwg
SCALE: 1/2" = 1'-0"

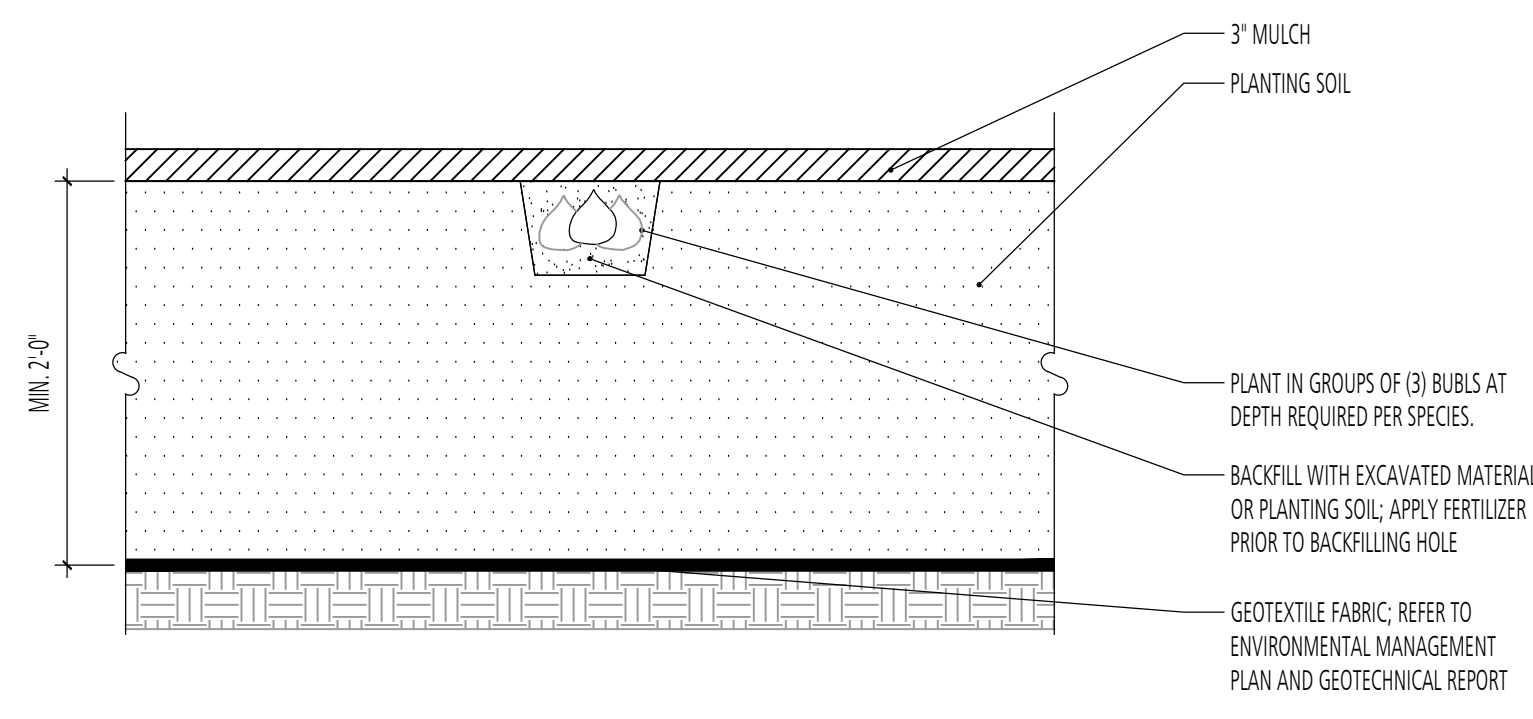

3 BULB PLANTING DETAIL (TYP.)
SECTION
d-bulb_planting_detail.dwg
SCALE: 1" = 1'-0"

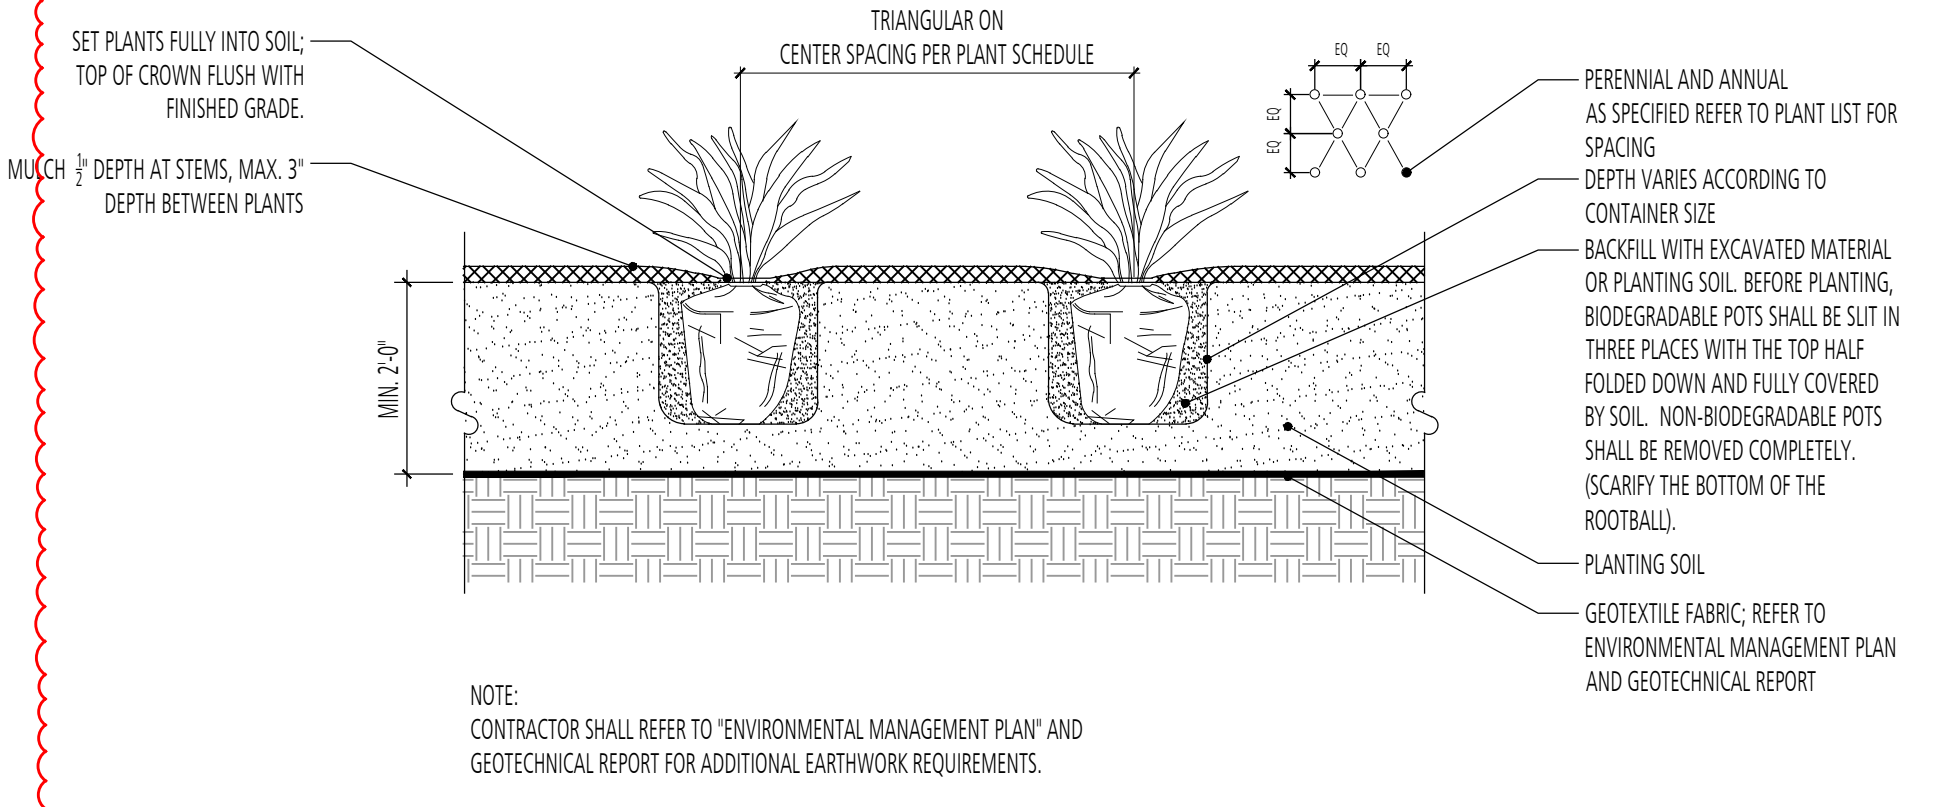

4 PERENNIAL PLANTING DETAIL
SECTION
d-grndcover_planting.dwg
SCALE: 1/2" = 1'-0"

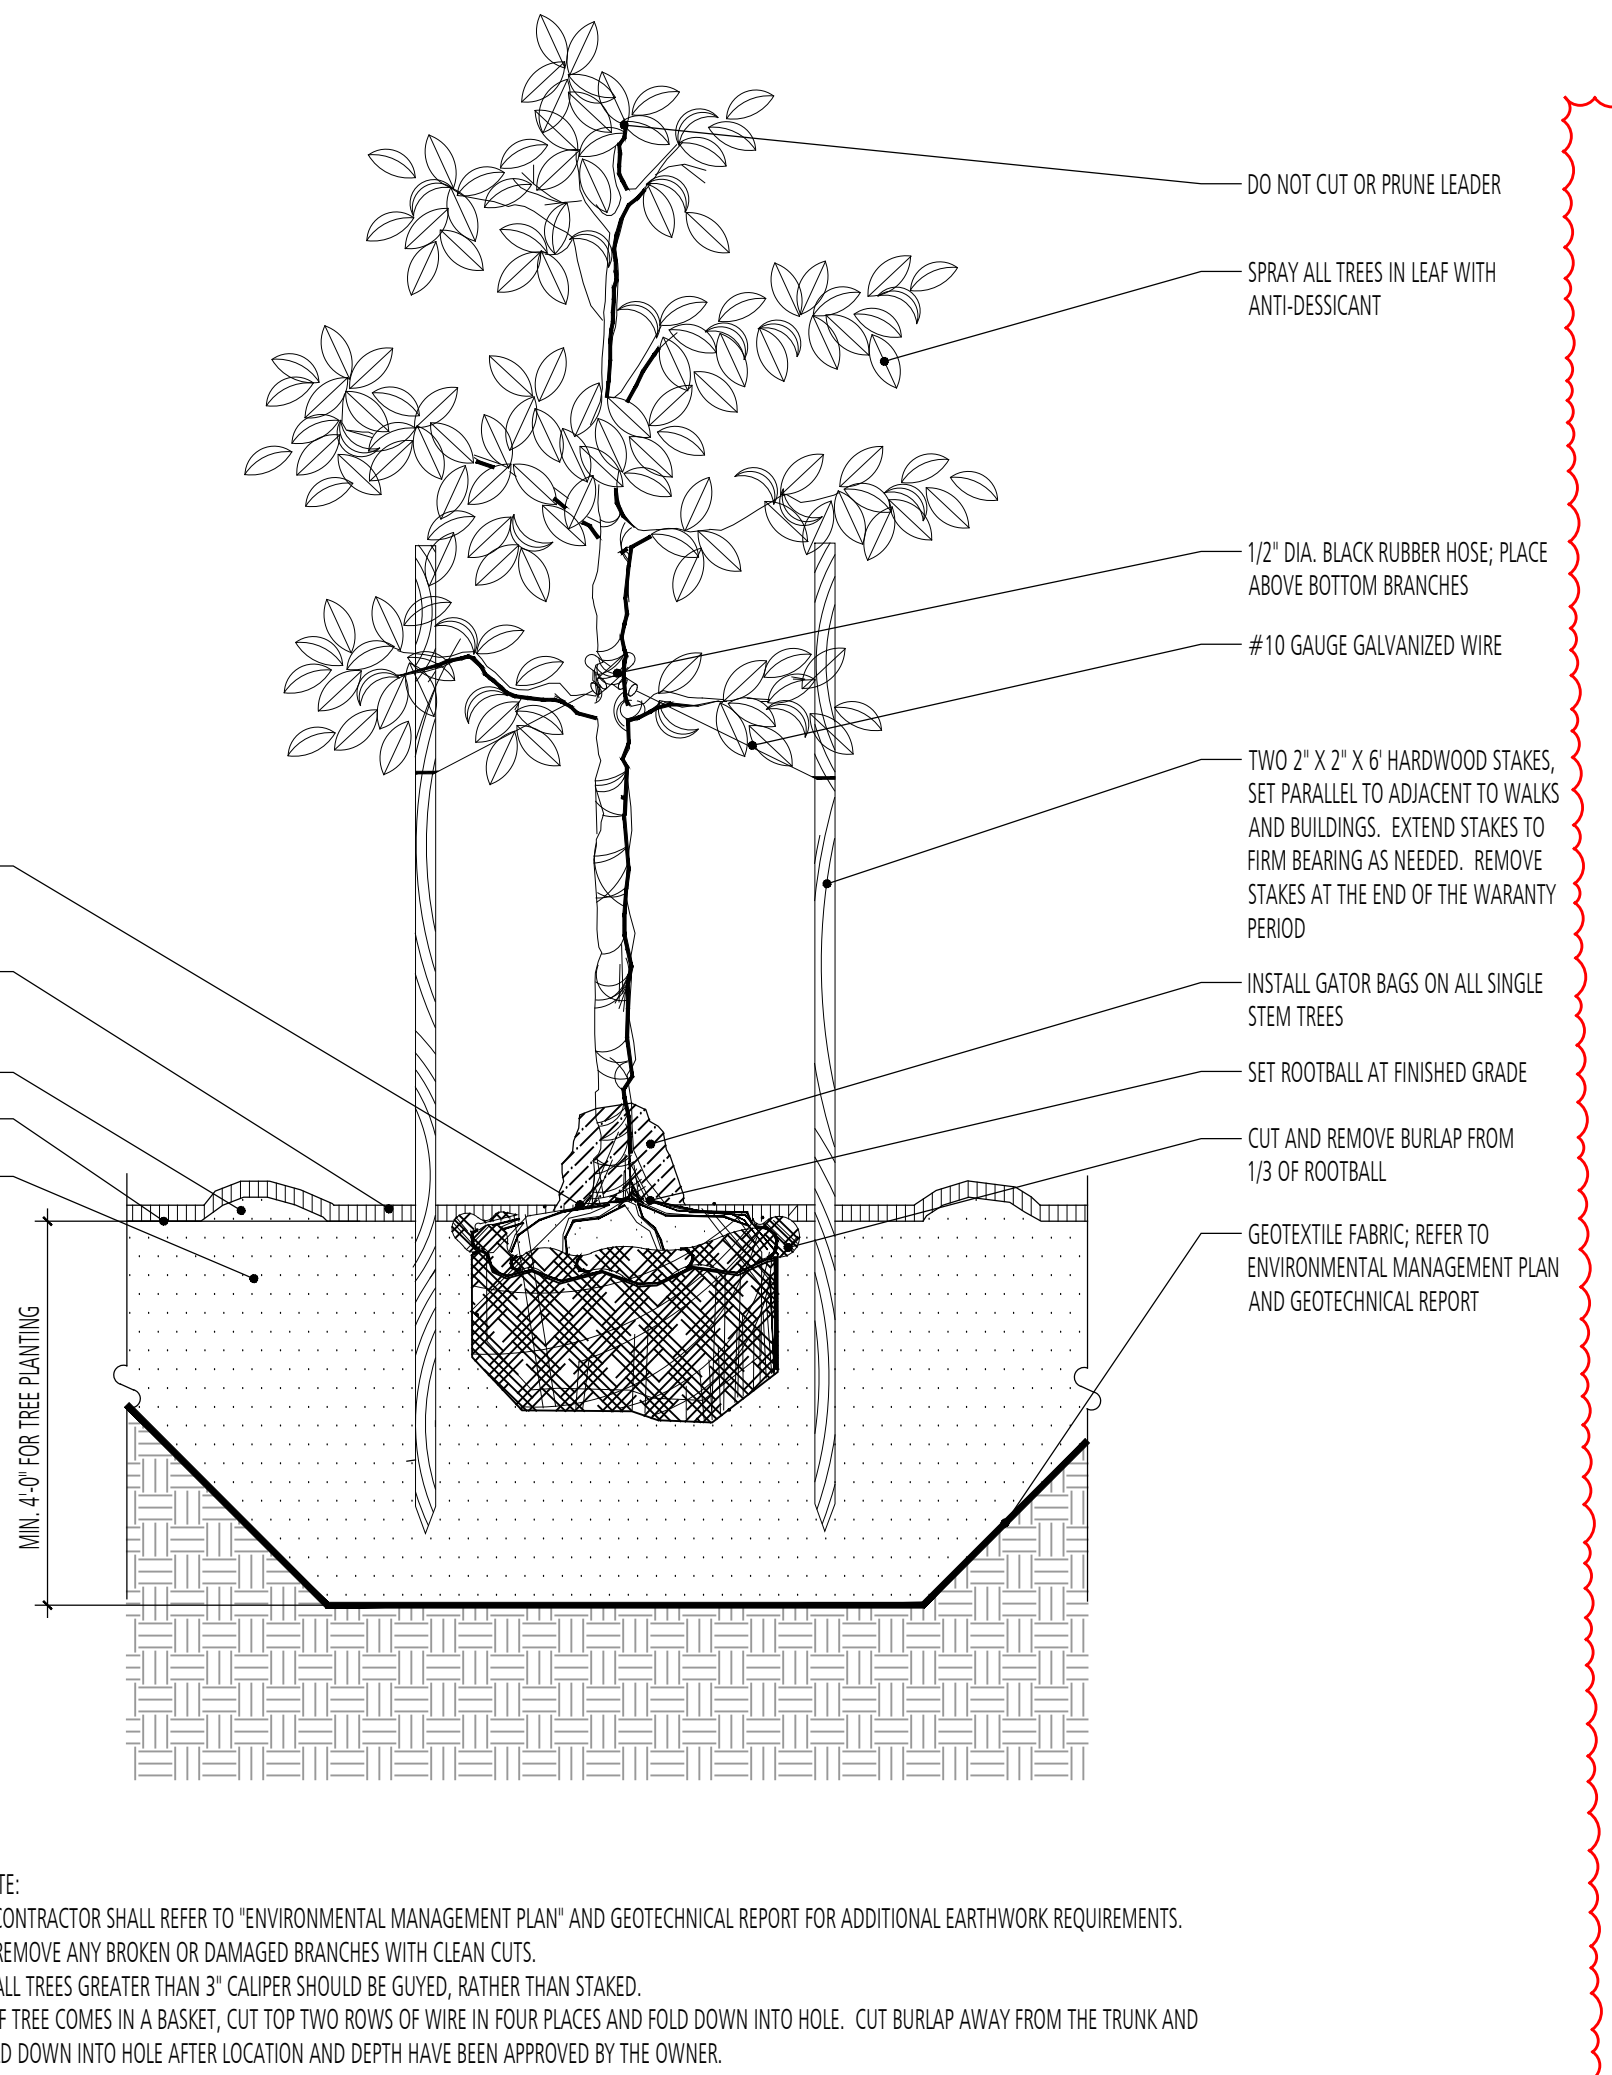

5 TREE PLANTING
SECTION
d-tree_planting.dwg
SCALE: 1/2" = 1'-0"



ISSUED FOR BID

Seal:

Seal:

G|W
W|O
G|W|O INC.
800 WYMAN PARK DRIVE, SUITE 300
BALTIMORE, MARYLAND 21211, 410-332-0209

© 2019 G|W|O INC.

I CERTIFY THAT THESE DOCUMENTS WERE PREPARED OR APPROVED BY ME, AND THAT I AM A FULLY LICENSED ARCHITECT UNDER THE LAWS OF THE STATE OF MARYLAND. LICENSE NUMBER: XXX-XXXXXX, EXPIRATION DATE XXXXXXXXX





Revisions:	No.	Date	Description
	1	1/13/2020	Addendum 1
	2	1/28/2020	Addendum 2

MIDDLE BRANCH FITNESS & WELLNESS CENTER AT CHERRY HILL
BALTIMORE CITY RECREATION & PARKS

Job No.	#18010	Author	Drawn
Scale		Checker	Checked
Date	01/28/2019	Approver	Approved
Drawing Title	PLANTING DETAILS	Drawing Number	L4.00 r2
Sheet			OF

ADDENDUM NO. 2 pg. 105 of 132

C:\Autodesk\Local Files\18010-MBFW-Bid-2019-1_amcallister@gwwinc.com.rvt
 1/24/2020 4:05:15 PM

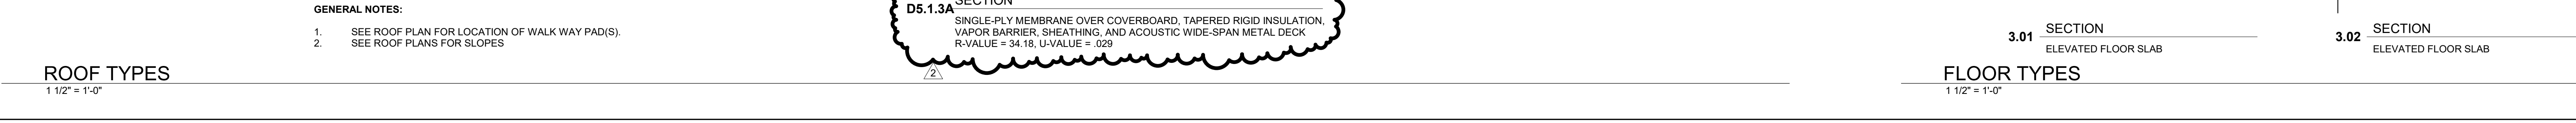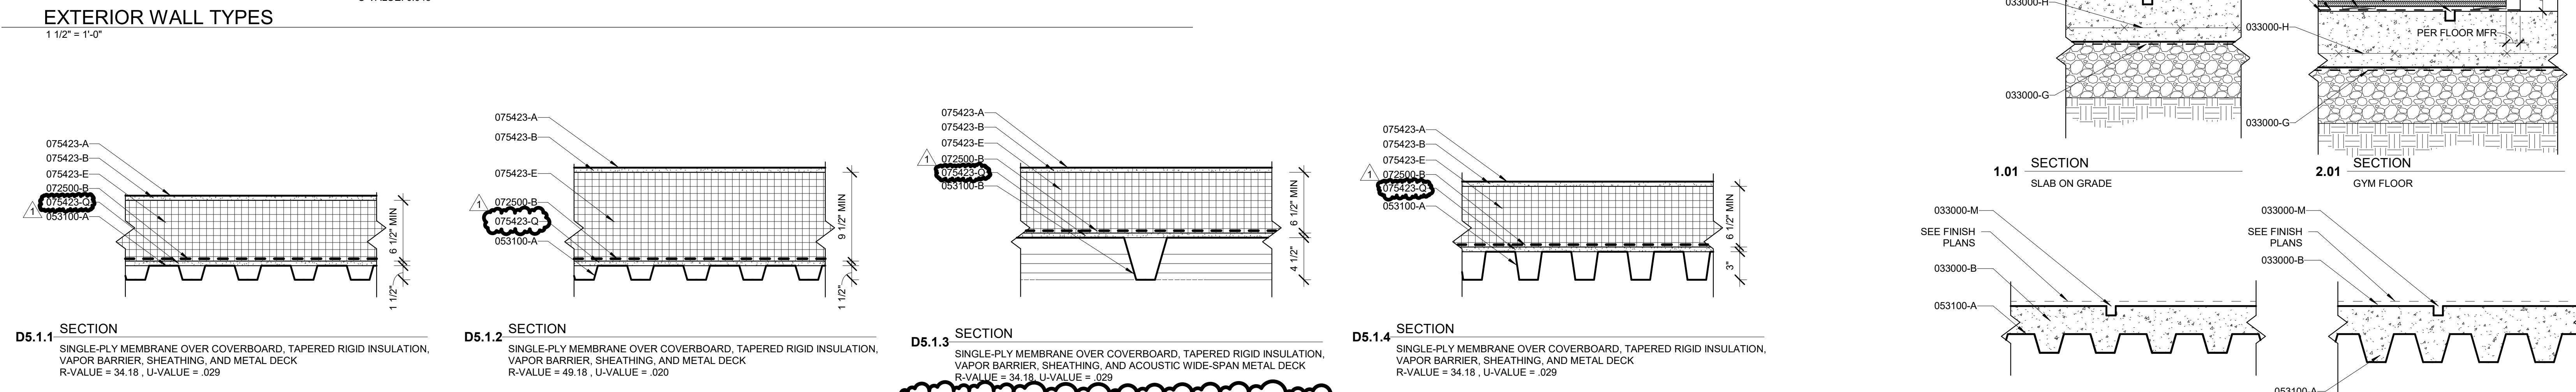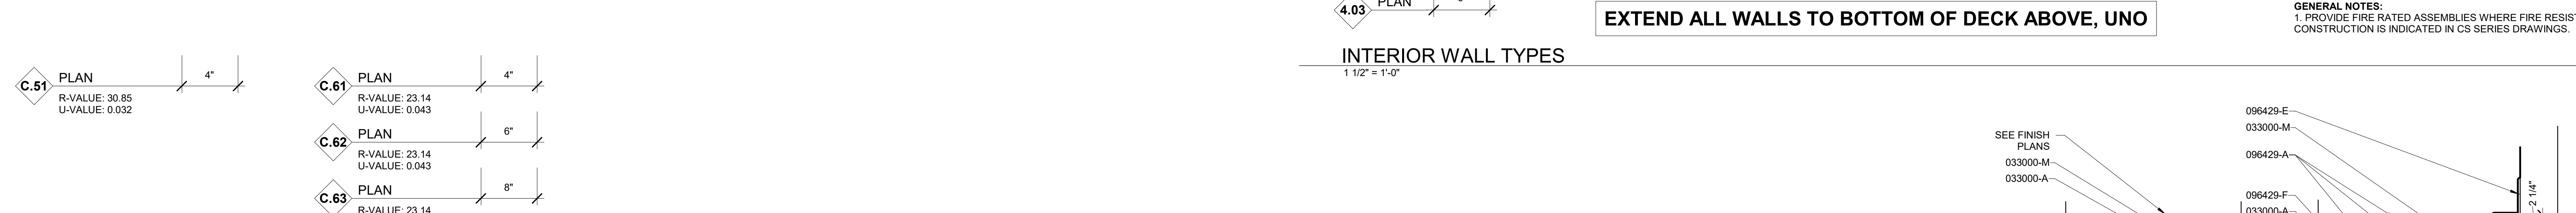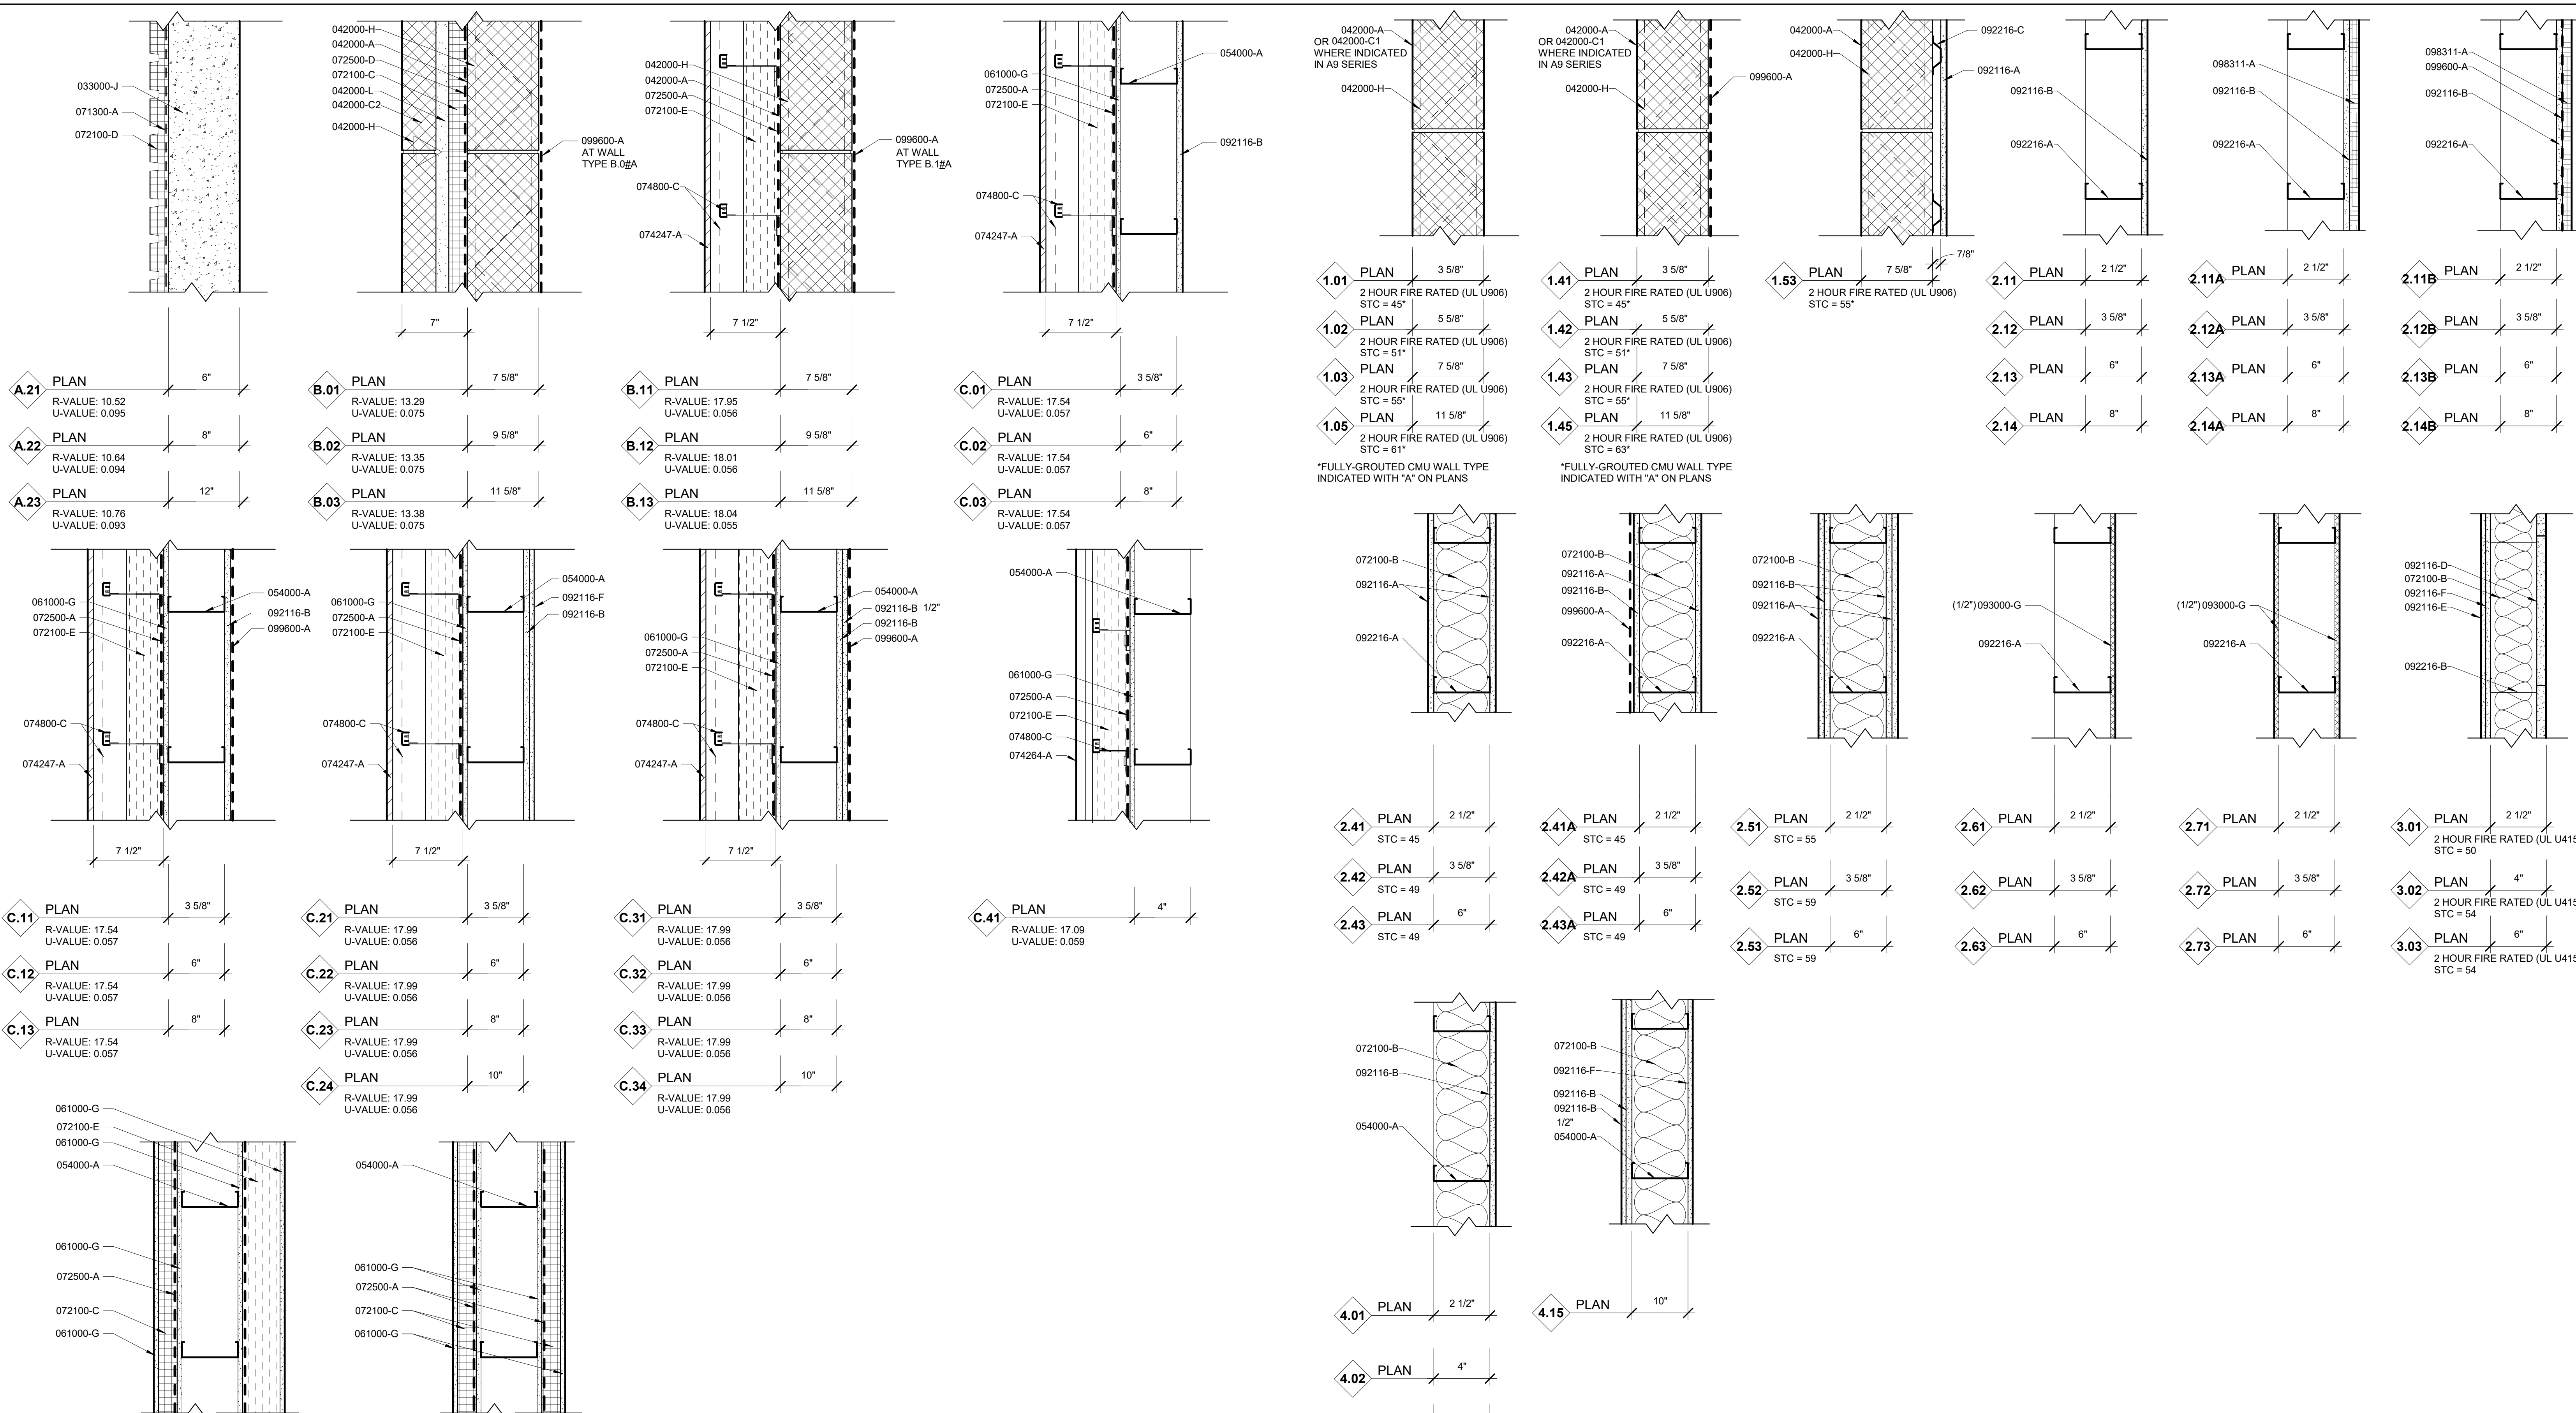

KEY PLAN:

KEYNOTES LISTED ON THIS SHEET ARE FOR CONVENIENCE ONLY. REFER TO SHEET CS.2 FOR COMPLETE LIST

033000-A	CONCRETE SLAB ON GRADE (REFER TO STRUCTURAL FOR MORE INFORMATION)
033000-B	CONCRETE SLAB ON STEEL DECK (REFER TO STRUCTURAL FOR MORE INFORMATION)
033000-G	UNDER SLAB VAPOR BARRIER
033000-H	WELDED WIRE FABRIC (REFER TO STRUCTURAL FOR MORE INFORMATION)
033000-J	ANCHOR BOLTS
033000-M	CONTROL JOINT
042000-A	CONCRETE MASONRY UNIT, SIZE AS INDICATED
042000-C1	GROUND FACE CMU 1, SIZE AND COLOR AS INDICATED
042000-C2	GROUND FACE CMU 2, SIZE AND COLOR AS INDICATED
042000-H	JOINT REINFORCEMENT/MASONRY TIE
042000-L	CEMENTITIOUS GROUT
053100-A	STEEL DECK (REFER TO STRUCTURAL FOR MORE INFORMATION)
053100-B	ACOUSTIC METAL DECK (REFER TO STRUCTURAL FOR MORE INFORMATION)
054000-A	COLD-FORMED STEEL FRAMING, SIZE AS INDICATED
061000-G	EXTERIOR GYPSUM SHEATHING, 1/2" UNO
071300-A	SELF-ADHERING MEMBRANE WATERPROOFING
072100-B	BATT INSULATION, 5 1/2" UNO (OR MAX THICKNESS FOR LOCATION)
072100-C	RIGID INSULATION BOARD, 2" THICK UNO
072100-D	RIGID INSULATION BOARD WITH DRAINAGE CHANNEL AND FILTER FABRIC, 2" THICK UNO
072100-E	MINERAL WOOL INSULATION BOARD, 4" THICK UNO
072500-A	VAPOR-PERMEABLE, AIR/WATER-RESISTIVE BARRIER
072500-B	VAPOR-IMPERMEABLE, AIR/WATER-RESISTIVE BARRIER
072500-D	BELOW GRADE VAPOR-PERMEABLE, AIR/WATER-RESISTIVE BARRIER
074200-A	CONCRETE PANEL
074264-A	ALUMINUM COMPOSITE PANEL
074800-C	THERMAL BRACKET
075423-A	TPO ROOFING
075423-B	COVER BOARD
075423-E	ROOF INSULATION
075423-Q	EXTERIOR GYPSUM SHEATHING, 1/2" UNO
092116-A	GYPSUM BOARD, ABUSE AND MOISTURE RESISTANT, 5/8" THICKNESS UNO
092116-B	GYPSUM BOARD, MOISTURE RESISTANT TYPE 'XP', 5/8" THICKNESS UNO
092116-D	GYPSUM BOARD, MOISTURE RESISTANT SHAFTLINER PANELS TYPE 'XP', 1" THICKNESS UNO
092116-E	GYPSUM BOARD, ABUSE AND MOISTURE RESISTANT, TYPE 'C', 1/2" THICKNESS UNO
092116-F	GYPSUM BOARD, MOISTURE RESISTANT, TYPE 'C', 1/2" THICKNESS UNO
092216-A	NON-STRUCTURAL METAL STUD, SIZE AS INDICATED
092216-B	NON-STRUCTURAL METAL SHAFTWALL STUD, SIZE AS INDICATED
092216-C	HAT SHAPED METAL FURRING CHANNEL, SIZE AS INDICATED
093000-G	CEMENTITIOUS BACKER BOARD, 1/2" THICKNESS UNO
096429-A	GYMNASIUM WOOD FLOORING SYSTEM
096429-E	BASE TRIM
096429-F	VAPOR RETARDER
098311-A	SHREDDED WOOD ACOUSTIC PANEL, PAINTED PT-1 UNO, 2" THICK UNO
099600-A	MULTI-LAYER IMPERMEABLE SURFACE

SCALE OF FEET
 1/8" = 1'-0"

ISSUED FOR BID

GENERAL NOTES:
 1. PROVIDE FIRE RATED ASSEMBLIES WHERE FIRE RESISTANT CONSTRUCTION IS INDICATED IN CS SERIES DRAWINGS.

Seal:

G|W|O

GW INC.
 800 WYMAN PARK DRIVE, SUITE 300
 BALTIMORE, MARYLAND 21211, 410-352-1909

© 2019 GWWO INC.

CHECK THAT THESE DOCUMENTS WERE PREPARED OR APPROVED BY ME, AND THAT I AM A DULY LICENSED ARCHITECT UNDER THE LAWS OF THE STATE OF MARYLAND.
 LICENSE NUMBER: 8400, EXPIRATION DATE: 12/31/2020

Revisions:	No.	Date	Description
	1	1/13/2020	ADDENDUM 1
	2	1/28/2020	ADDENDUM 2

MIDDLE BRANCH FITNESS & WELLNESS CENTER AT CHERRY HILL

BALTIMORE CITY RECREATION & PARKS





Job No.	#18010	AWM	Drawn
Scale	1 1/2" = 1'-0"	KMS	Checked
Date	12/13/2019	AER	Approved

Drawing Title: CONSTRUCTION TYPES, TYPICAL DETAILS, AND DIAGRAMS
 Drawing Number: AC.1r2
 Sheet: OF






ADDENDUM NO. 2 pg. 106 of 132

KEYNOTES LISTED ON THIS SHEET ARE FOR CONVENIENCE ONLY. REFER TO SHEET CS.2 FOR COMPLETE LIST








042000-A	CONCRETE MASONRY UNIT, SIZE AS INDICATED
042000-C1A	GROUND FACE CMU 1, SPECIAL SHAPE. SEE AC SERIES
042000-C2A	GROUND FACE CMU 2, SPECIAL SHAPE. SEE AC SERIES
042000-L	CEMENTITIOUS GROUT
051200-A	STRUCTURAL STEEL (REFER TO STRUCTURAL FOR MORE INFORMATION)
052100-A	STEEL JOIST (REFER TO STRUCTURAL FOR MORE INFORMATION)
053100-A	STEEL DECK (REFER TO STRUCTURAL FOR MORE INFORMATION)
054000-A	COLD-FORMED STEEL FRAMING, SIZE AS INDICATED
055000-R	SUSPENDED CEILING METAL SUB-FRAME
061000-C	SHIM
061000-F	PLYWOOD SHEATHING, FIRE-RETARDANT TREATED, 3/4" THICK UNO
061000-G	EXTERIOR GYPSUM SHEATHING, 1/2" UNO
061000-H	FIRE-RETARDANT TREATED BLOCKING
062000-B	TONGUE AND GROOVE WOOD PANELING, 3/4" THICK (NIC)
062000-C	WOOD FURRING, 3/4" THICK
064100-U	BLOCKING
071300-A	SELF-ADHERING MEMBRANE WATERPROOFING
072100-B	BATT INSULATION, 5 1/2" UNO (OR MAX THICKNESS FOR LOCATION)
072100-C	RIGID INSULATION BOARD, 2" THICK UNO
072100-E	MINERAL WOOL INSULATION BOARD, 4" THICK UNO
072500-A	VAPOR-PERMEABLE, AIR/WATER-RESISTIVE BARRIER
07426-A	ALUMINUM COMPOSITE PANEL
074800-C	THERMAL BRACKET
075423-A	TPO ROOFING
075423-C	TPO FLASHING
075423-L	FASTENER
075423-M	STAINLESS STEEL CLAMPING RING AND CONT BEAD OF SEALANT
076200-E	2-PIECE METAL COUNTER FLASHING
076200-F	CONTINUOUS LOCKING METAL CLEAT
077200-A	METAL CLAD INSULATION CURB WITH WOOD NAILER
078400-A	FIRE SAFING
078400-B	FIRESTOP SEALANT
079005-B	JOINT SEALANT
092116-A	GYPSUM BOARD, ABUSE AND MOISTURE RESISTANT, 5/8" THICKNESS UNO
092116-B	GYPSUM BOARD, MOISTURE RESISTANT TYPE 'XP', 5/8" THICKNESS UNO
092116-D	GYPSUM BOARD, MOISTURE RESISTANT SHAFTLINER PANELS TYPE 'XP', 1" THICKNESS
092116-E	GYPSUM BOARD, ABUSE AND MOISTURE RESISTANT, TYPE 'C', 1/2" THICKNESS
092116-F	GYPSUM BOARD, MOISTURE RESISTANT, TYPE 'C', 1/2" THICKNESS
092116-K	SOUND ATTENUATION BLANKET, SIZE AS INDICATED
092116-L	WIRE MESH FOR CONTAINMENT OF SOUND ATTENUATION
092216-A	NON-STRUCTURAL METAL STUD, SIZE AS INDICATED
092216-B	NON-STRUCTURAL METAL SHAFTHALL STUD, SIZE AS INDICATED
092216-C	HAT SHAPED METAL FURRING CHANNEL, SIZE AS INDICATED
092216-D	1 1/2" METAL CARRYING CHANNEL
092216-E	Z-FURRING, SIZE AS INDICATED
092216-F	NON-STRUCTURAL METAL STUD TRACK
092216-G	DEFLECTION TRACK
092216-H	FIRE STOP TRACK
092216-J	HANGER WIRE
093000-G	CEMENTITIOUS BACKER BOARD, 1/2" THICKNESS UNO
093000-H	WATERPROOF MEMBRANE
095100-A	ACOUSTICAL CEILING PANEL
095100-B	GRID SUSPENSION SYSTEM
096700-A	FLUID-APPLIED FLOORING
096700-B	FLUID-APPLIED FLOORING INTEGRAL COVE BASE
099000-A	WATER-BASED FIRE RETARDANT
099600-A	MULTI-LAYER IMPERMEABLE SURFACE
105100-B	HDPE LOCKER
105100-G	HDPE LOCKER BASE
220000-A	PLUMBING (REFER TO PLUMBING FOR MORE INFORMATION)
230000-A	MECHANICAL (REFER TO MECHANICAL FOR MORE INFORMATION)
230000-D	CLIMATE CONTROL (REFER TO MECHANICAL FOR MORE INFORMATION)

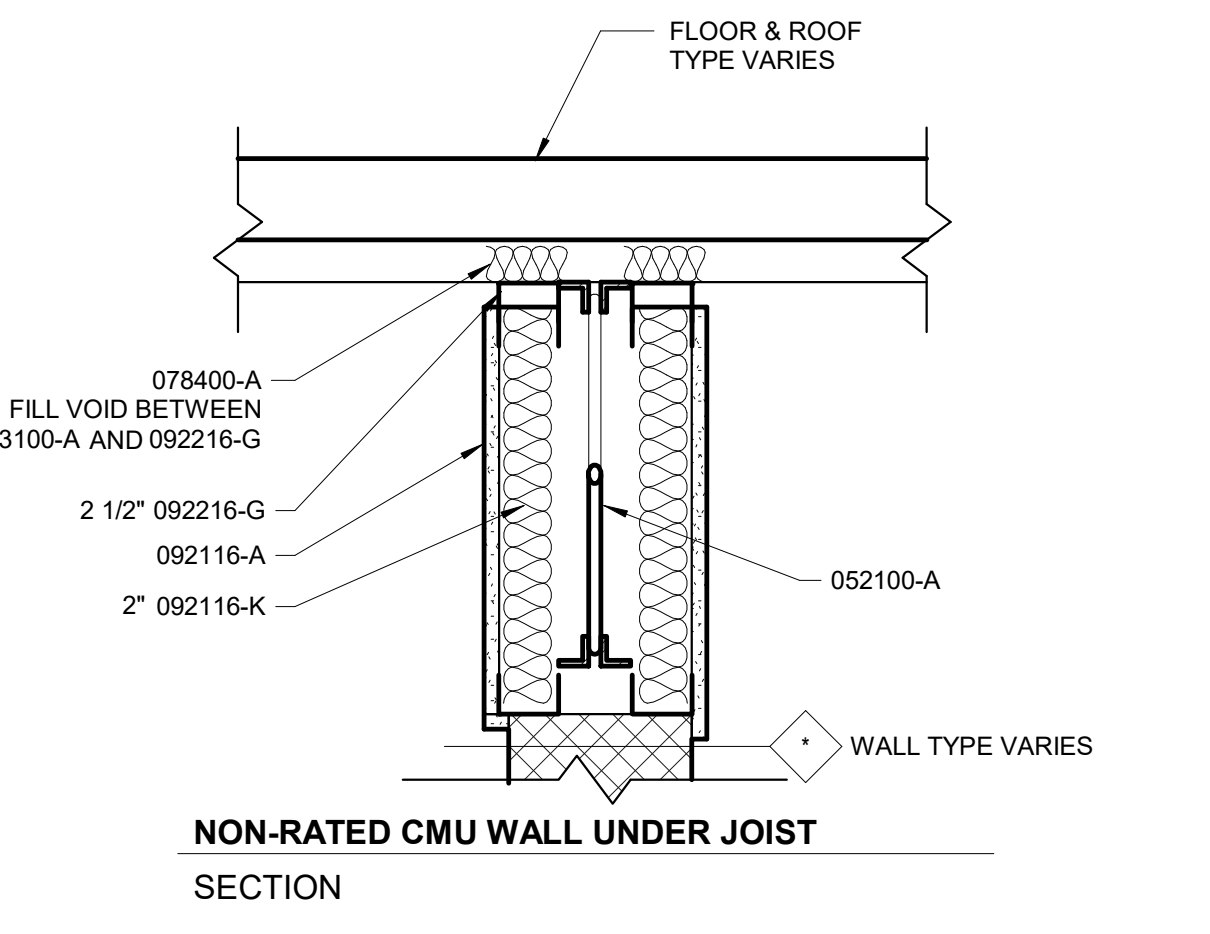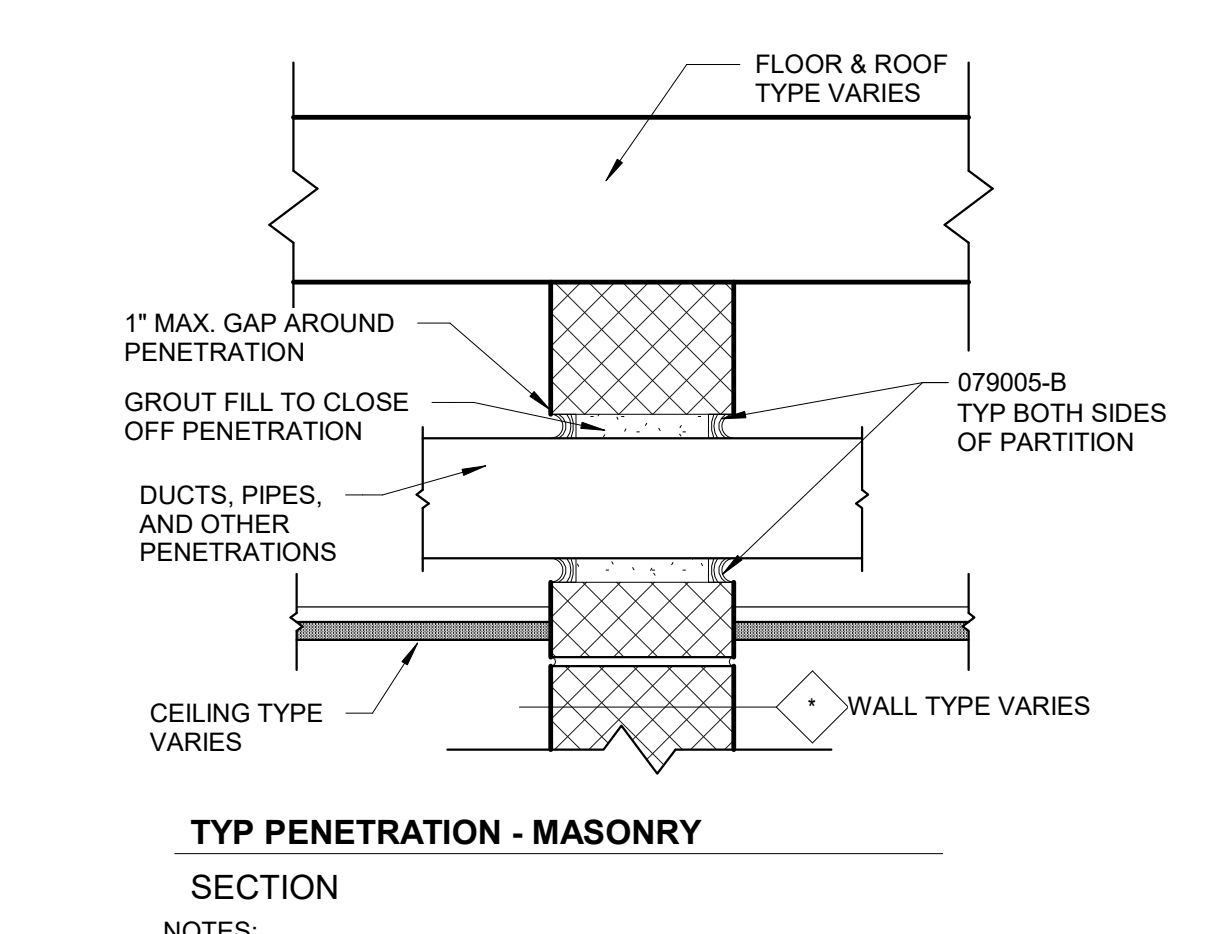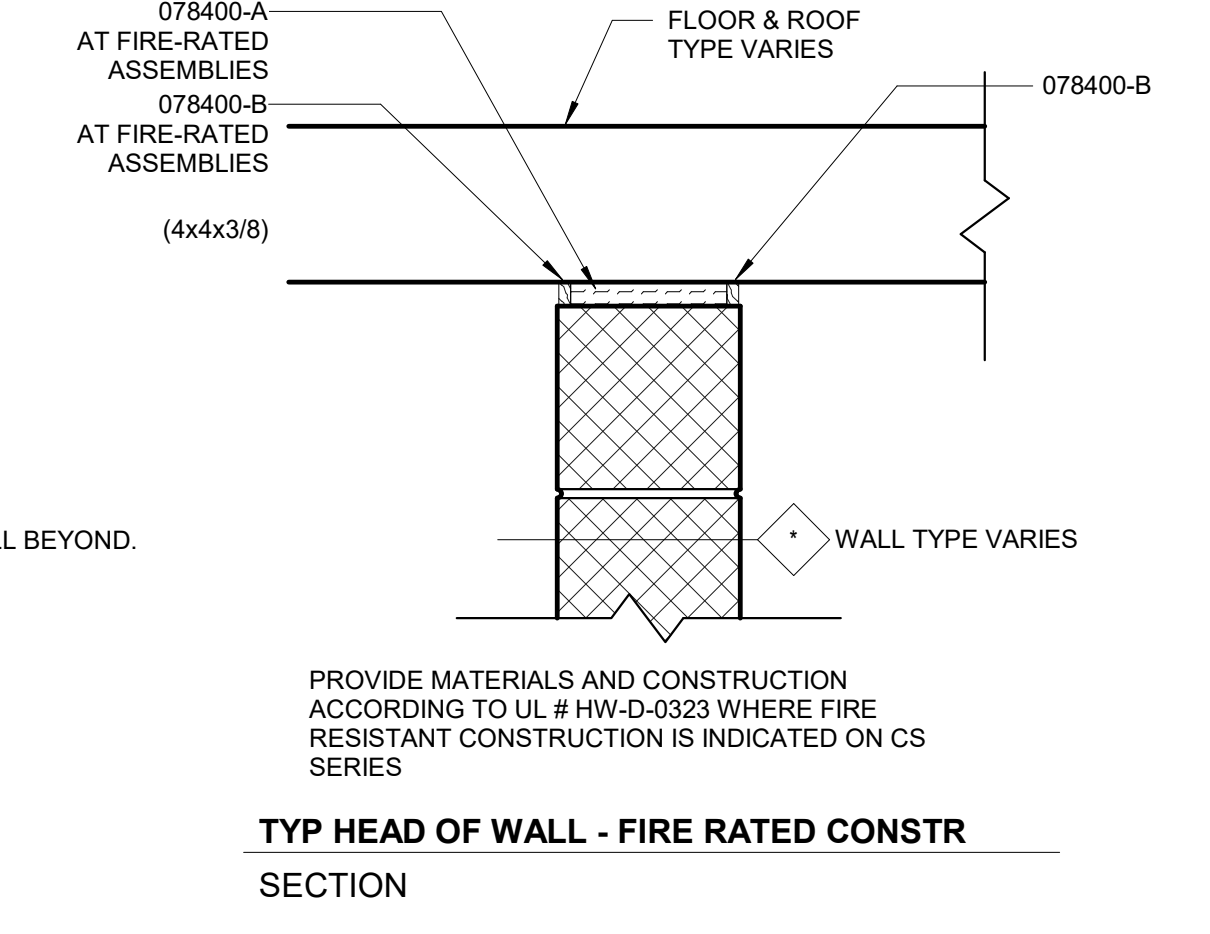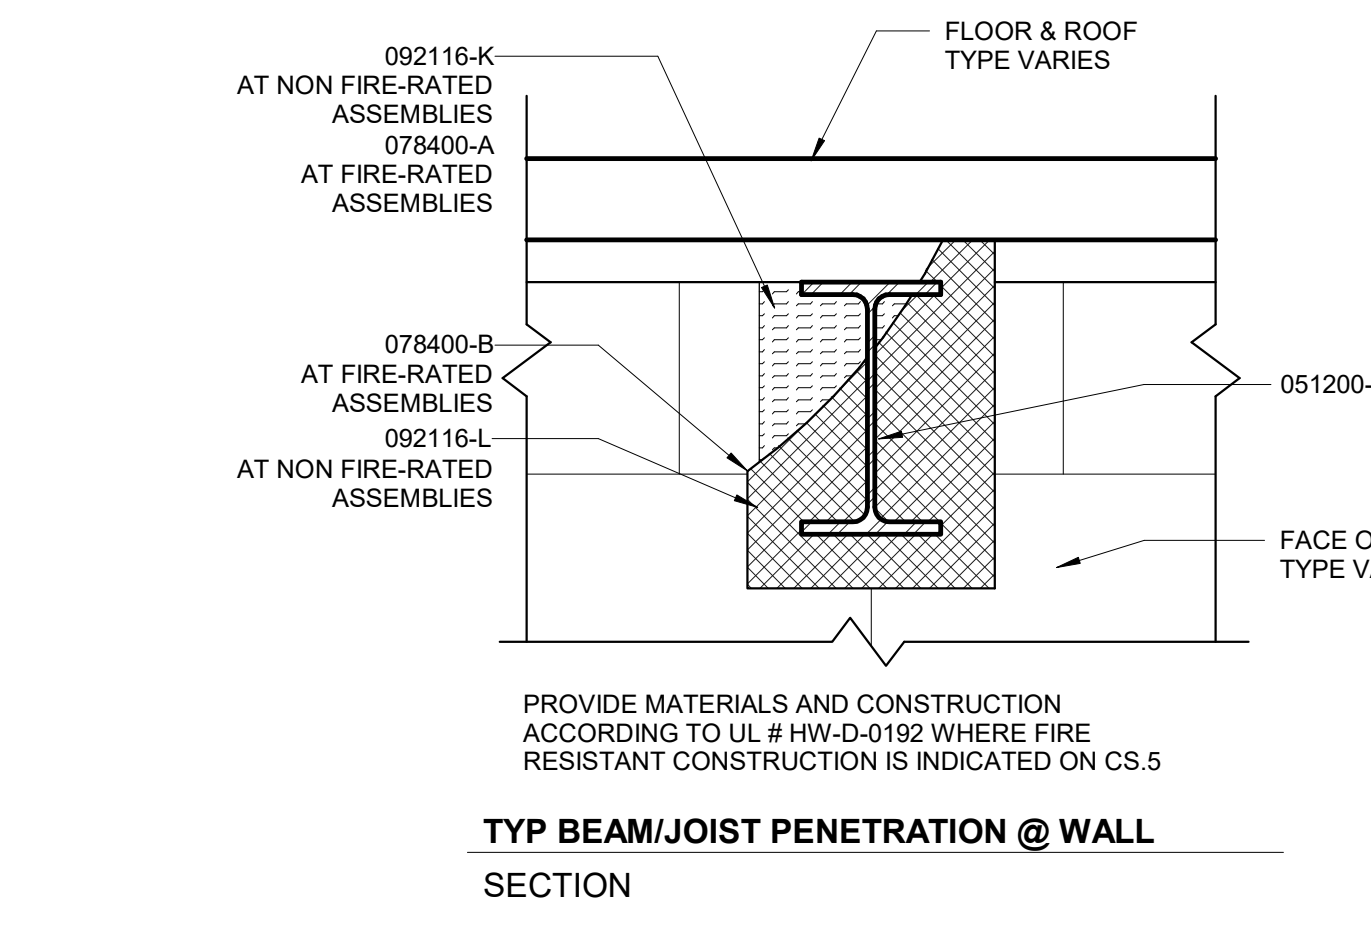






1 TYPICAL MASONRY WALL DETAILS
AC.2 1 1/2" = 1'-0"

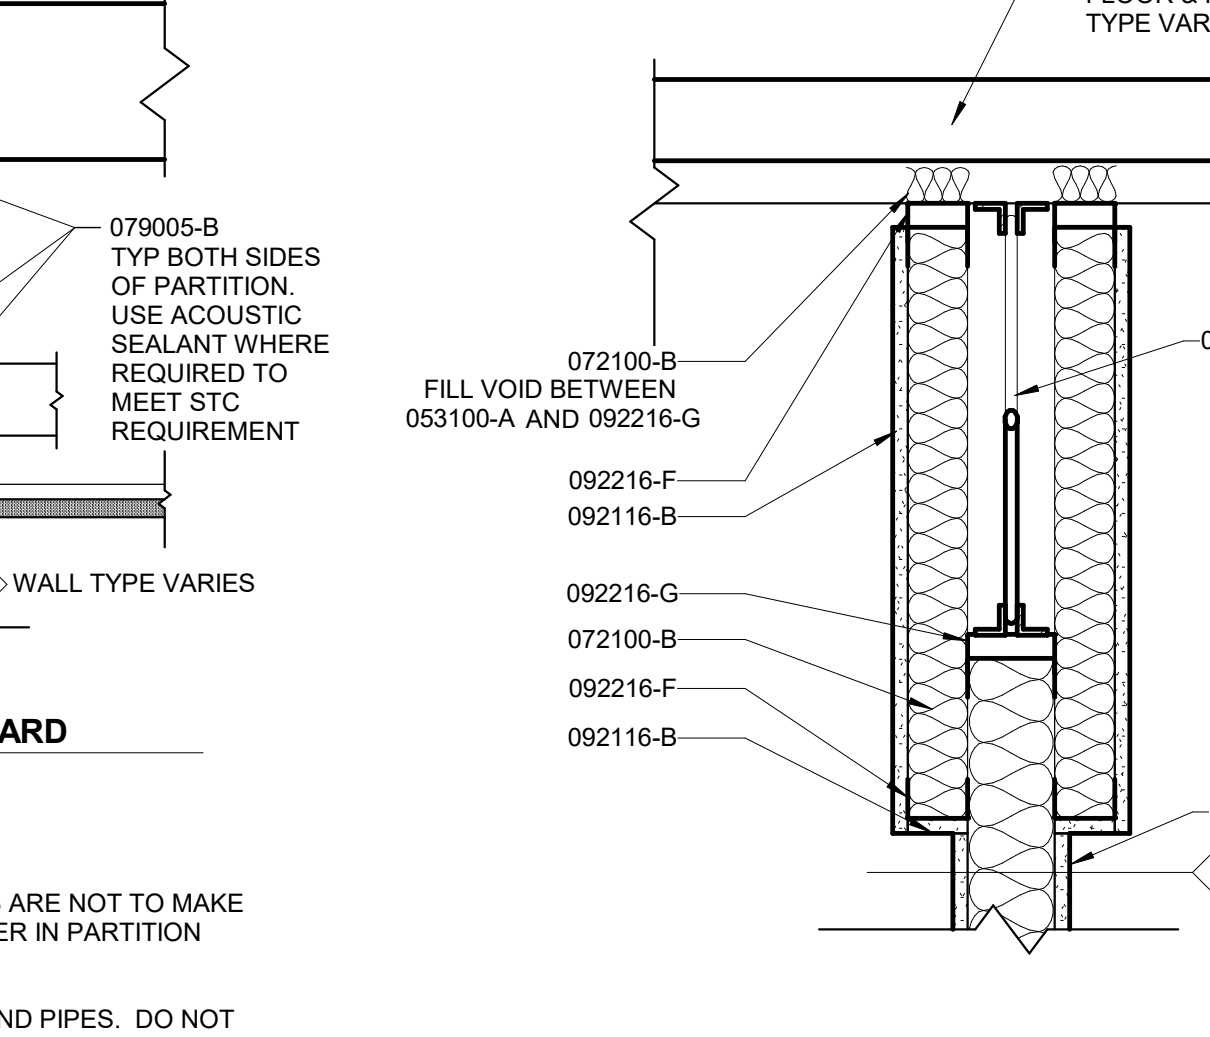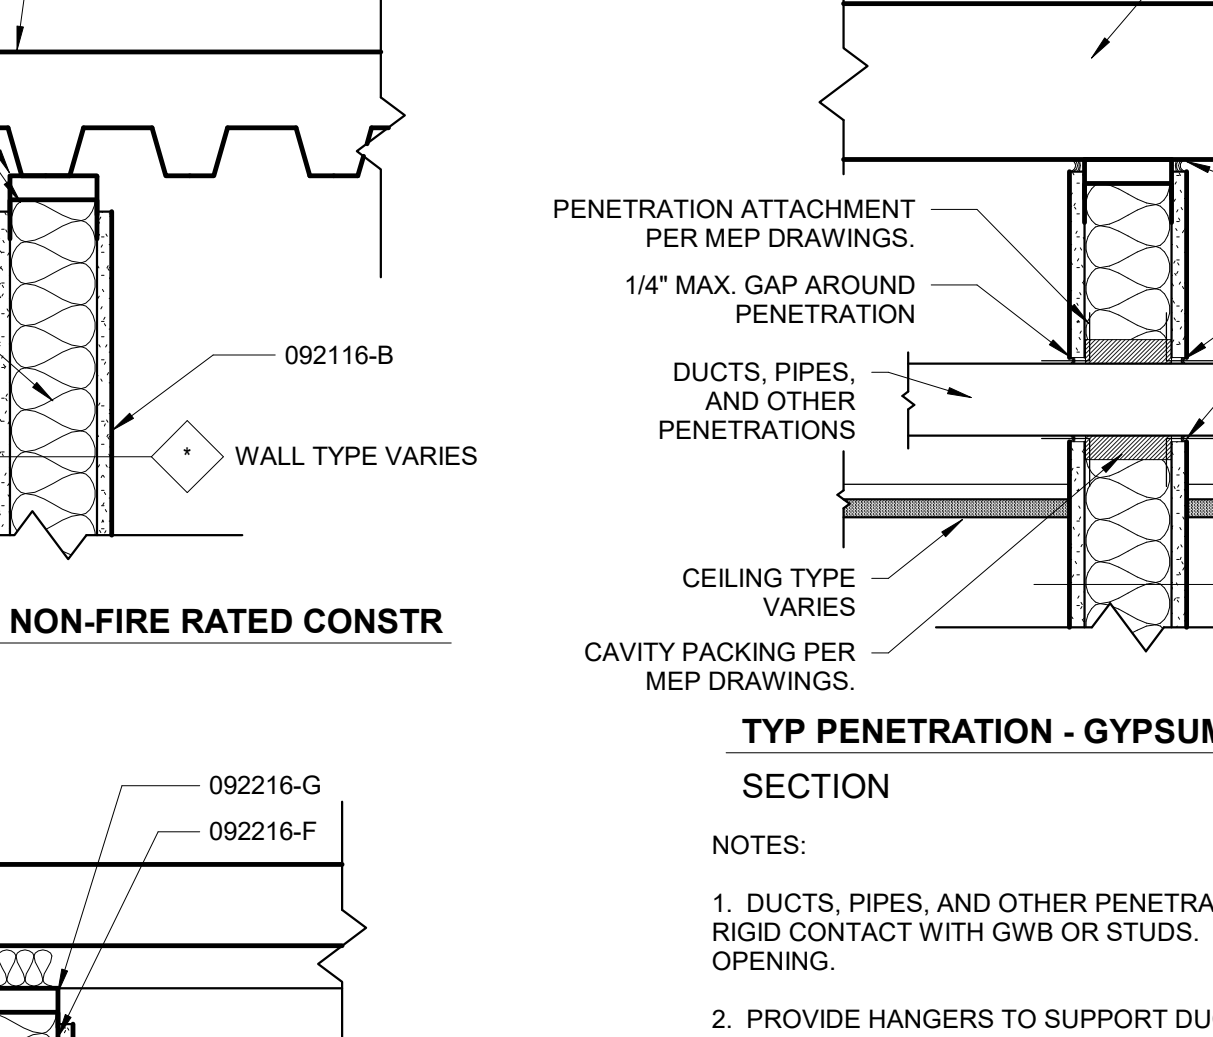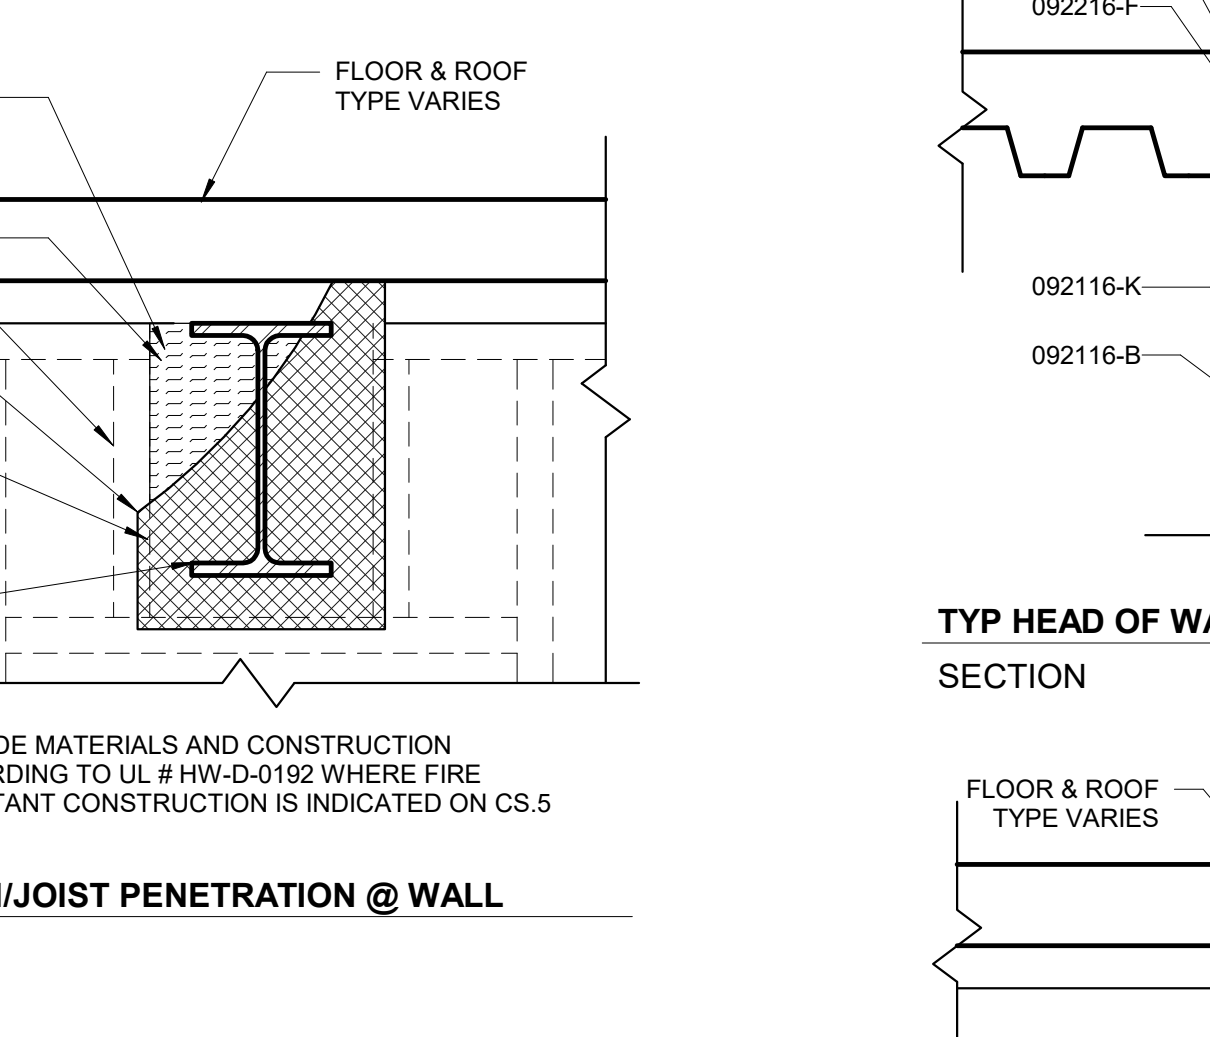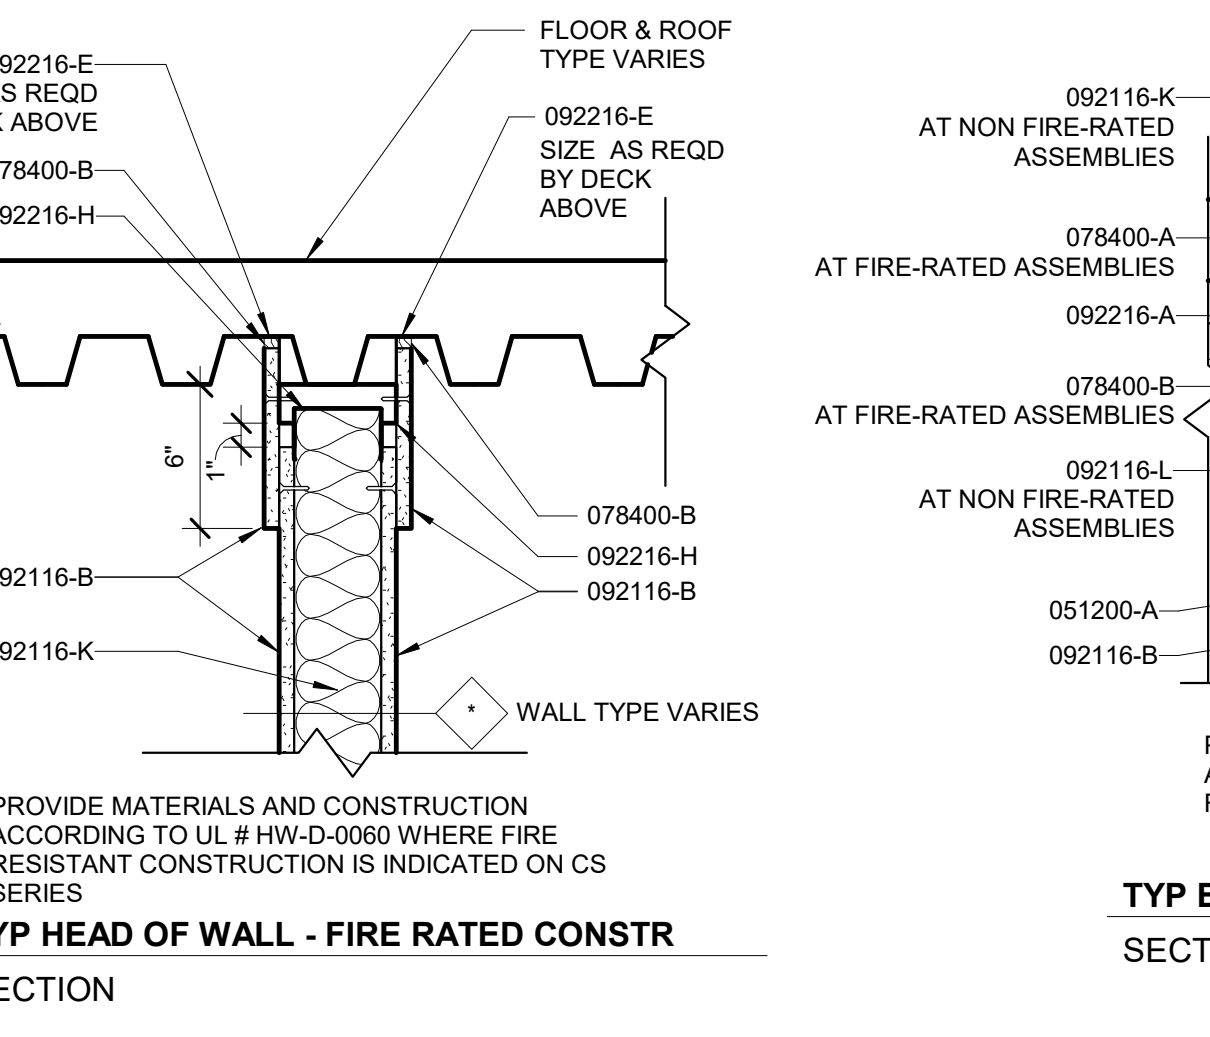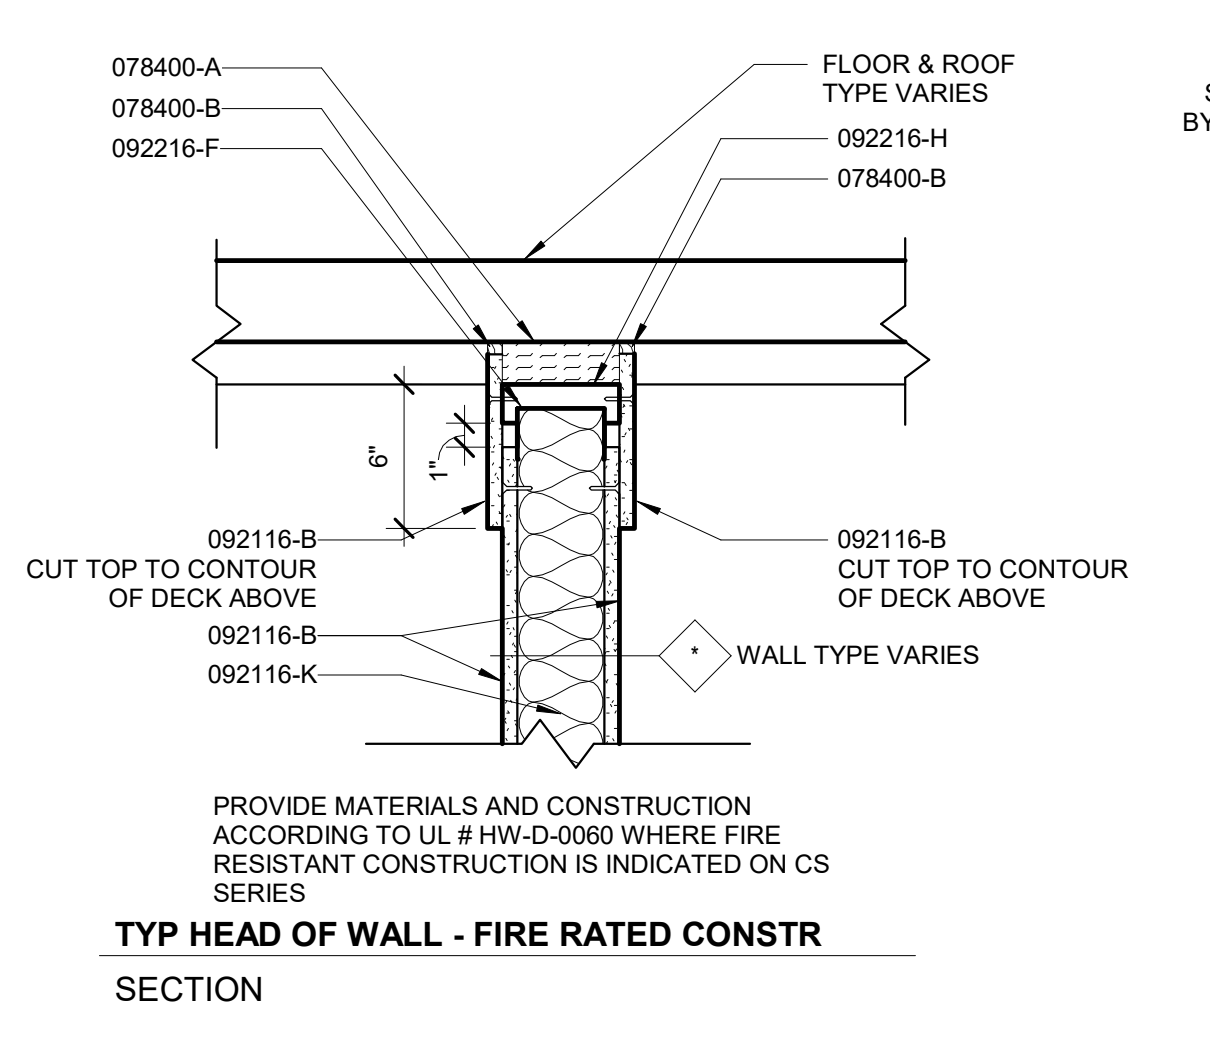





2 TYPICAL WALL DETAILS
AC.2 1 1/2" = 1'-0"

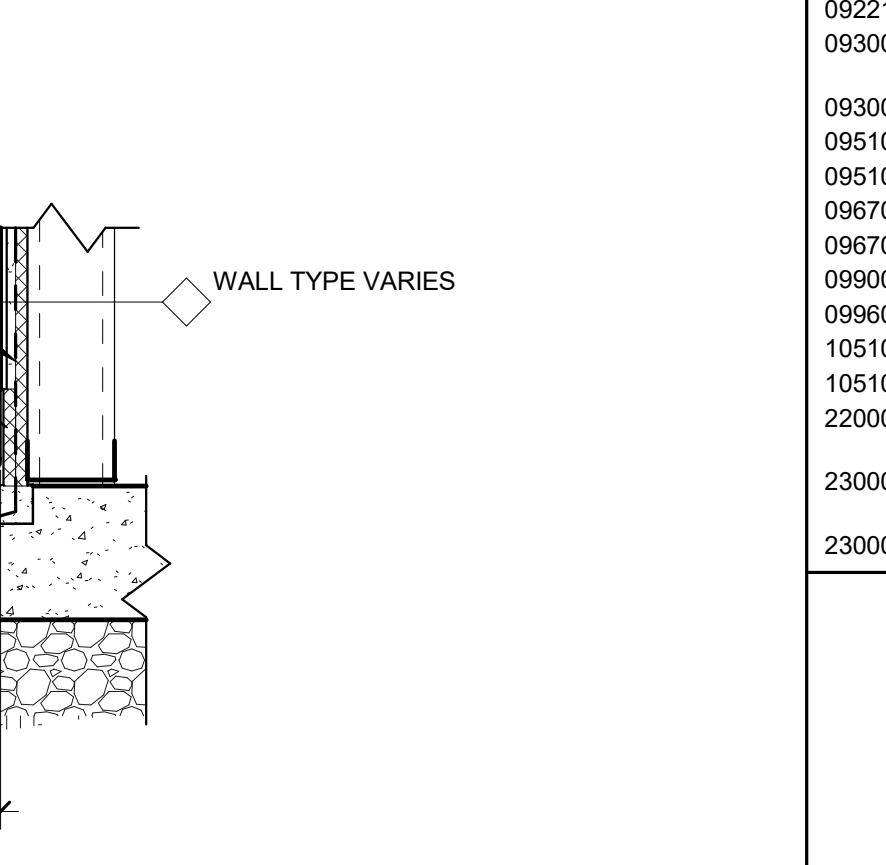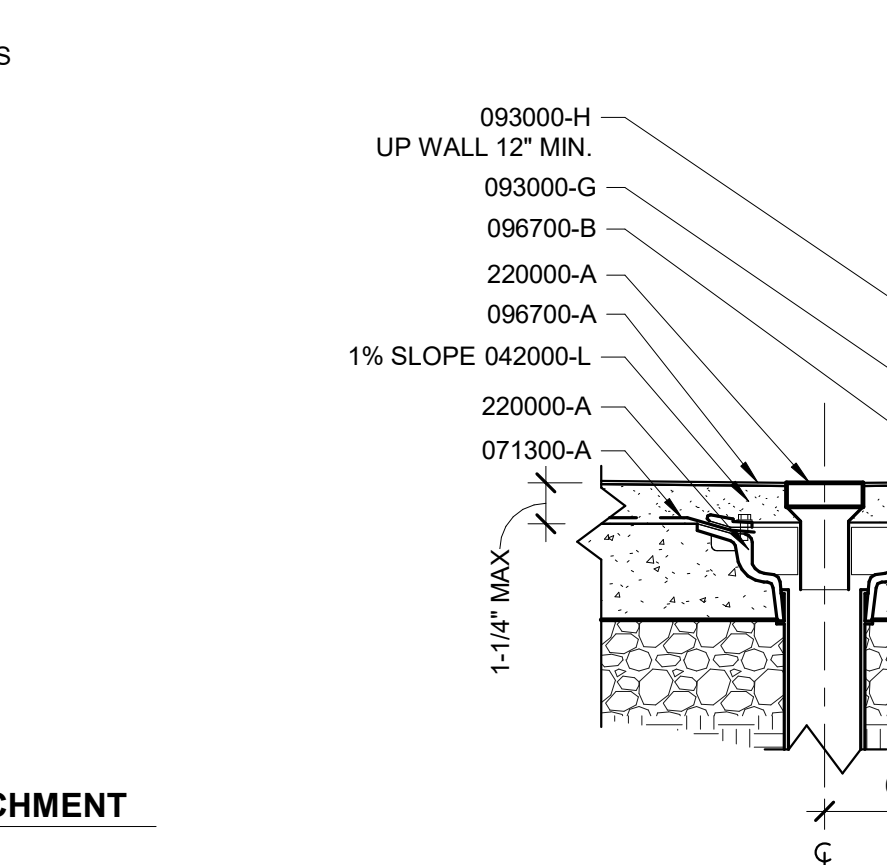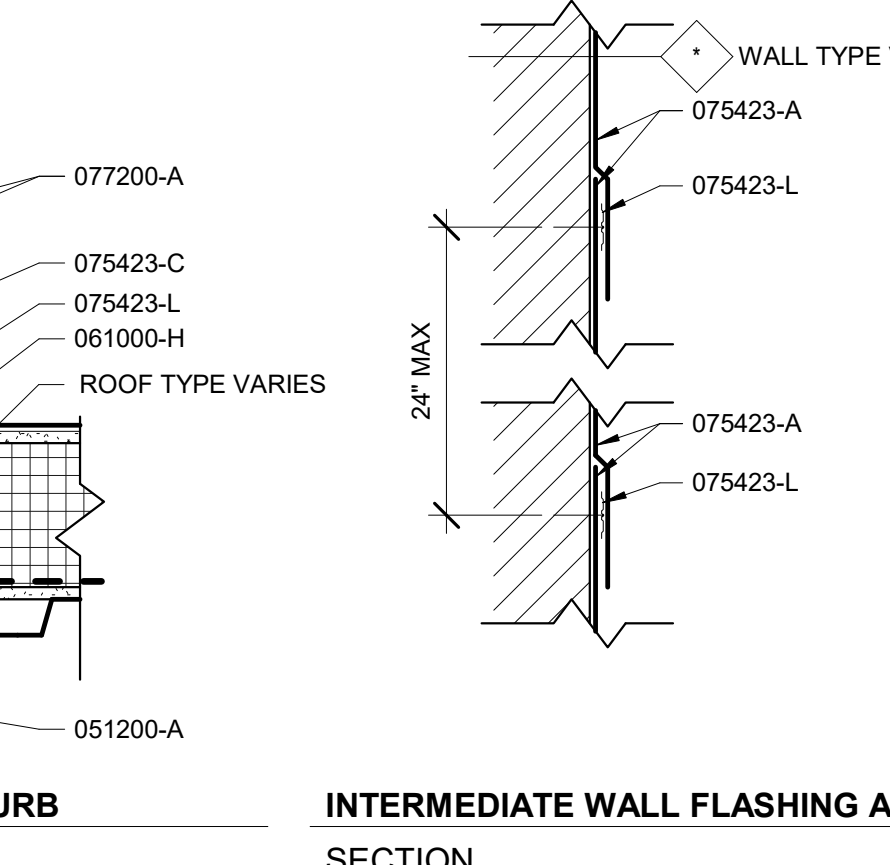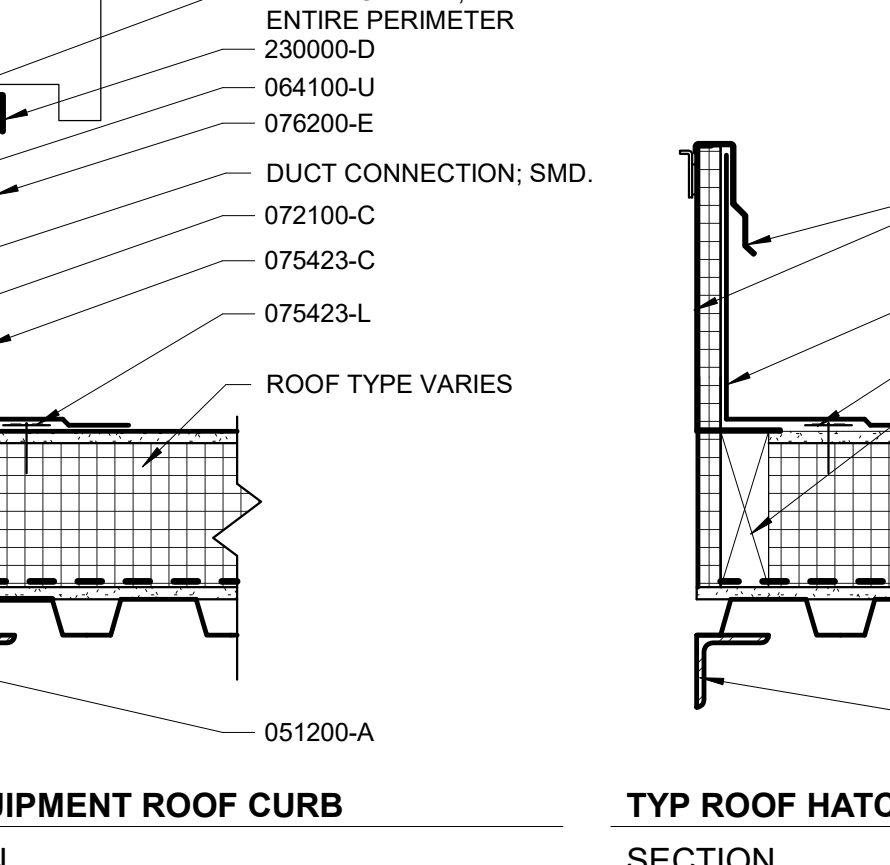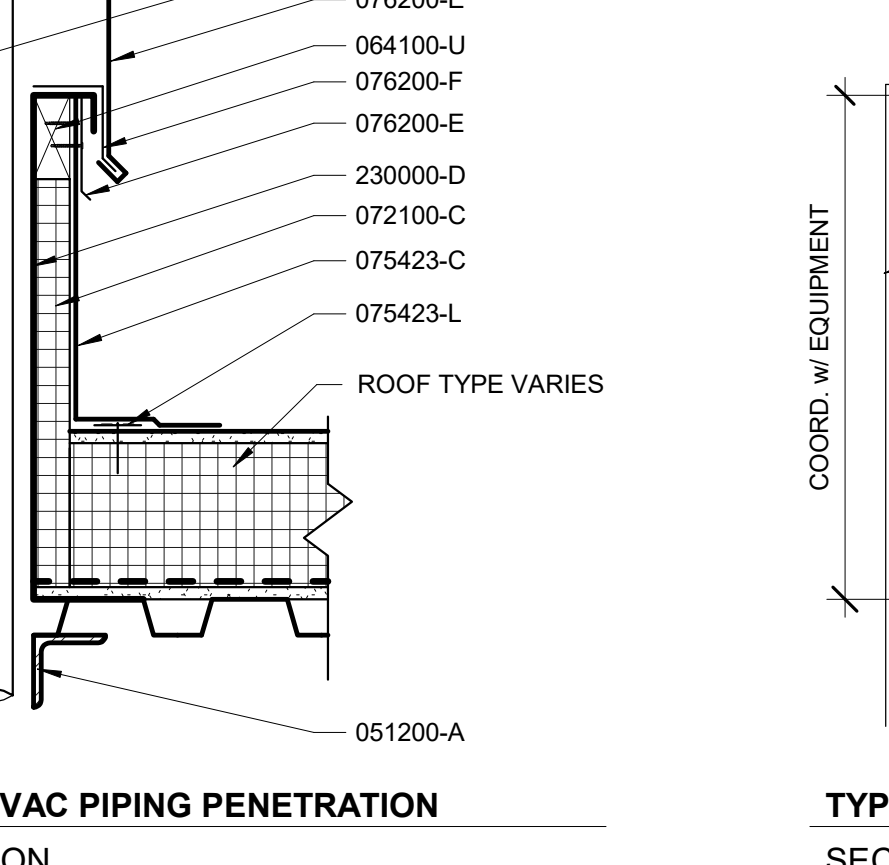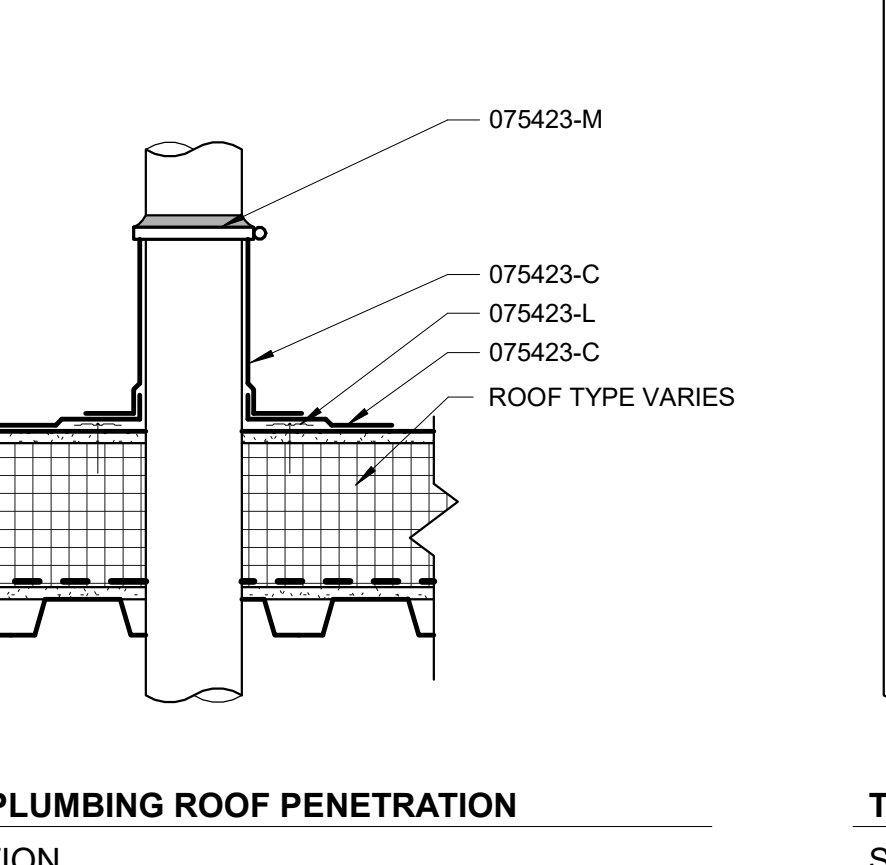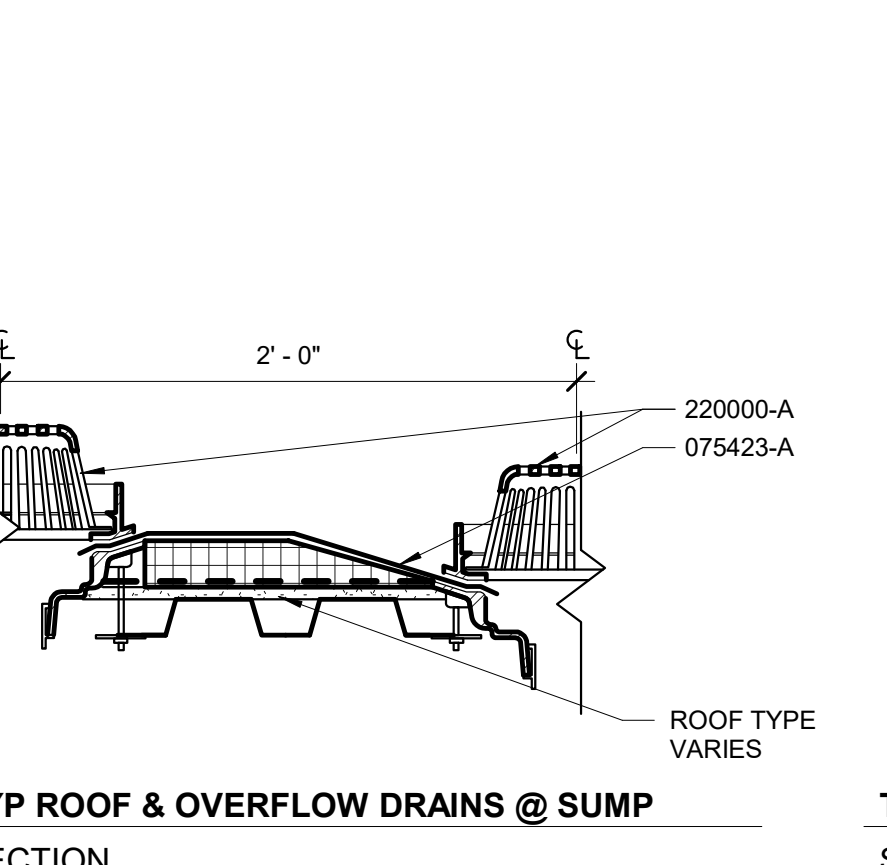

3 TYPICAL ROOF DETAILS
AC.2 1 1/2" = 1'-0"

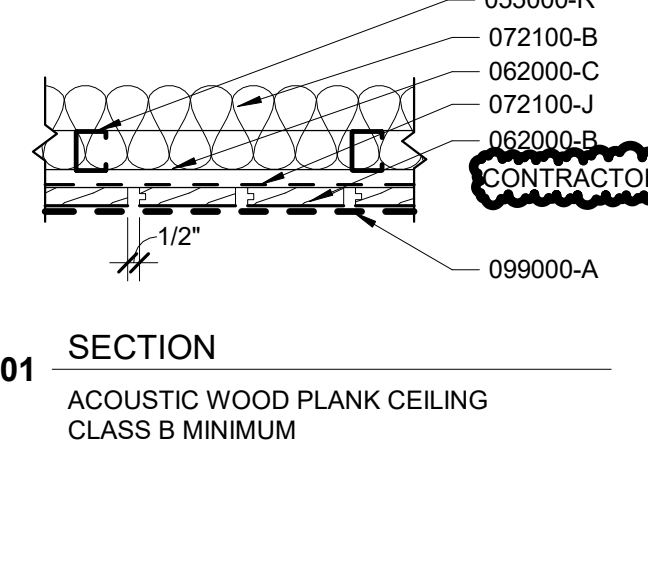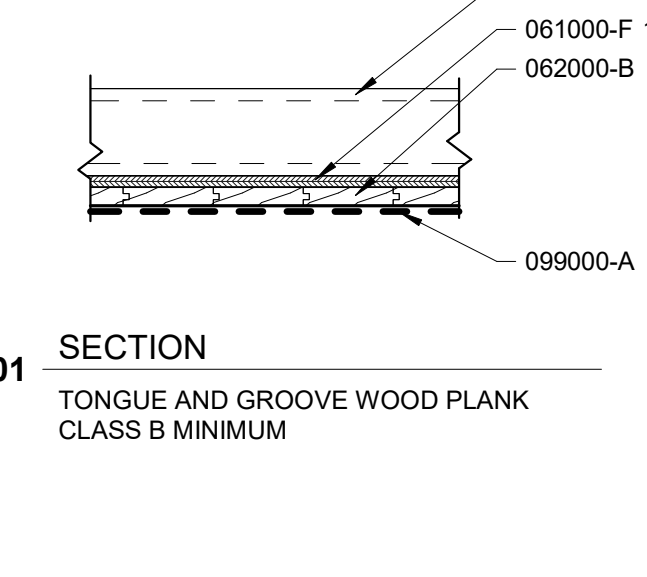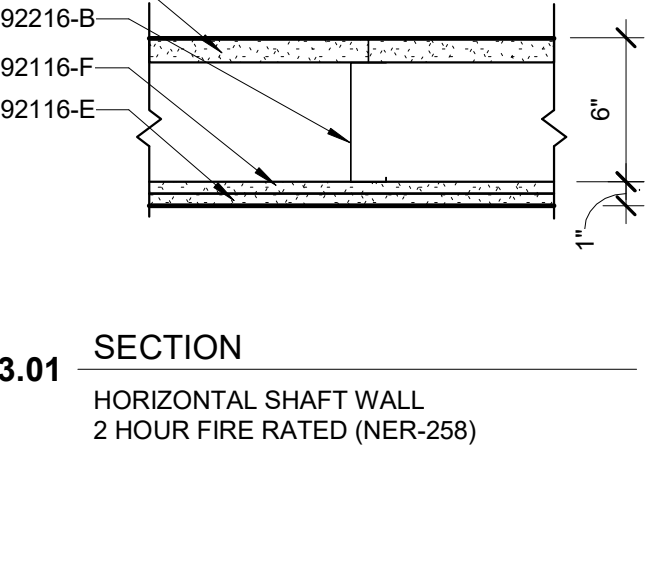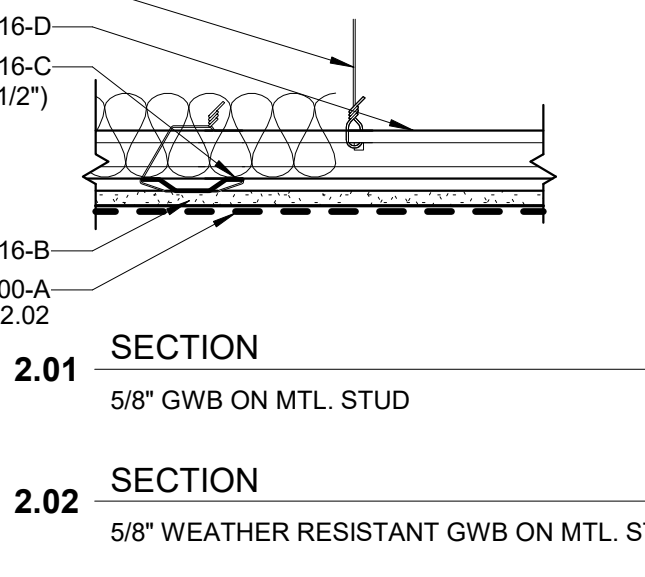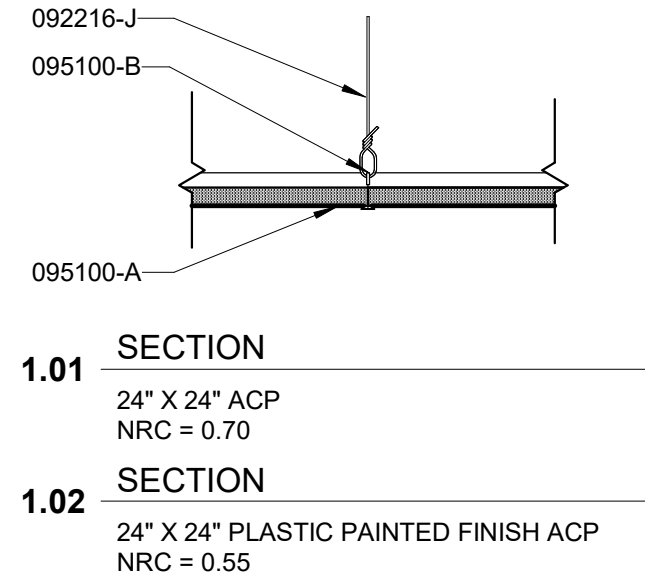



5 CEILING TYPES
AC.2 1 1/2" = 1'-0"

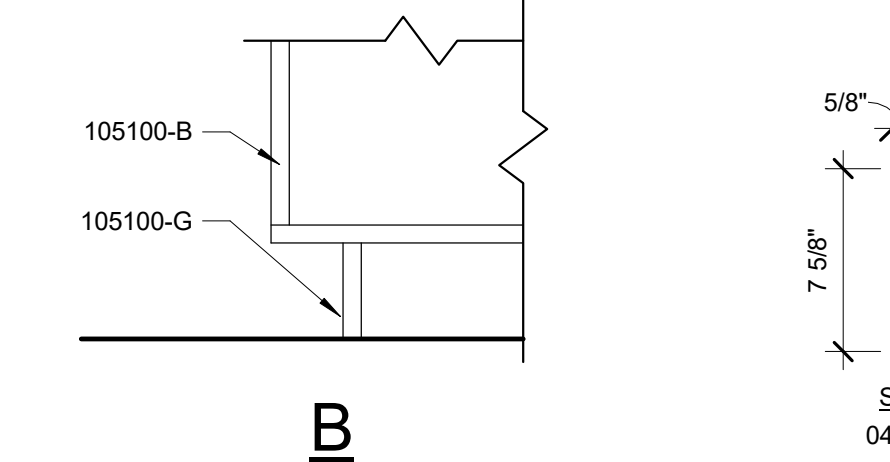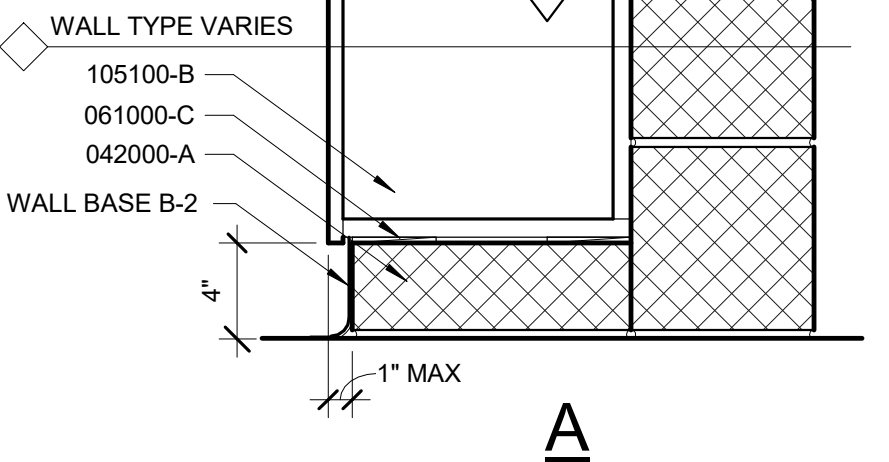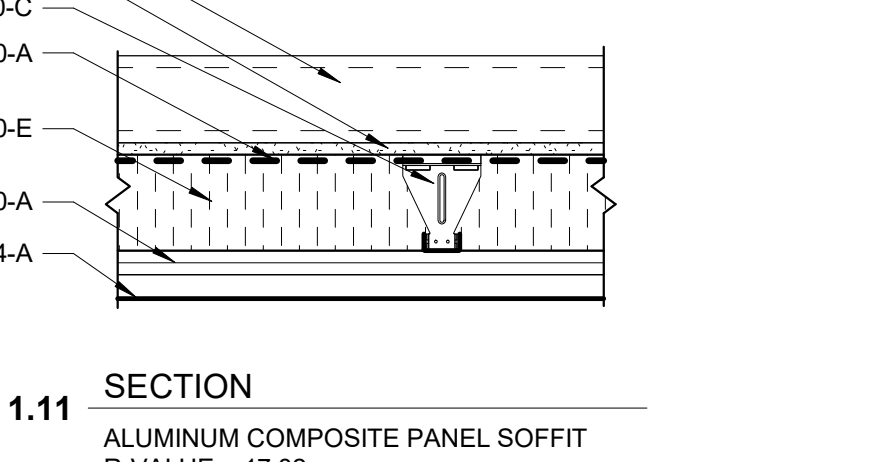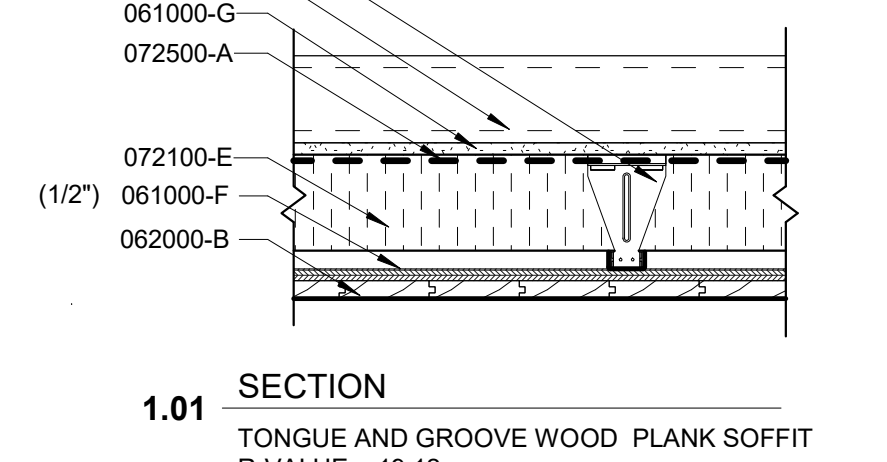

6 SOFFIT TYPES
AC.2 1 1/2" = 1'-0"

7 TYPICAL LOCKER BASE
AC.2 1 1/2" = 1'-0"

8 SPECIAL SHAPES - CMU
AC.2 1 1/2" = 1'-0"

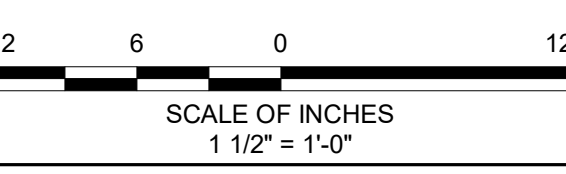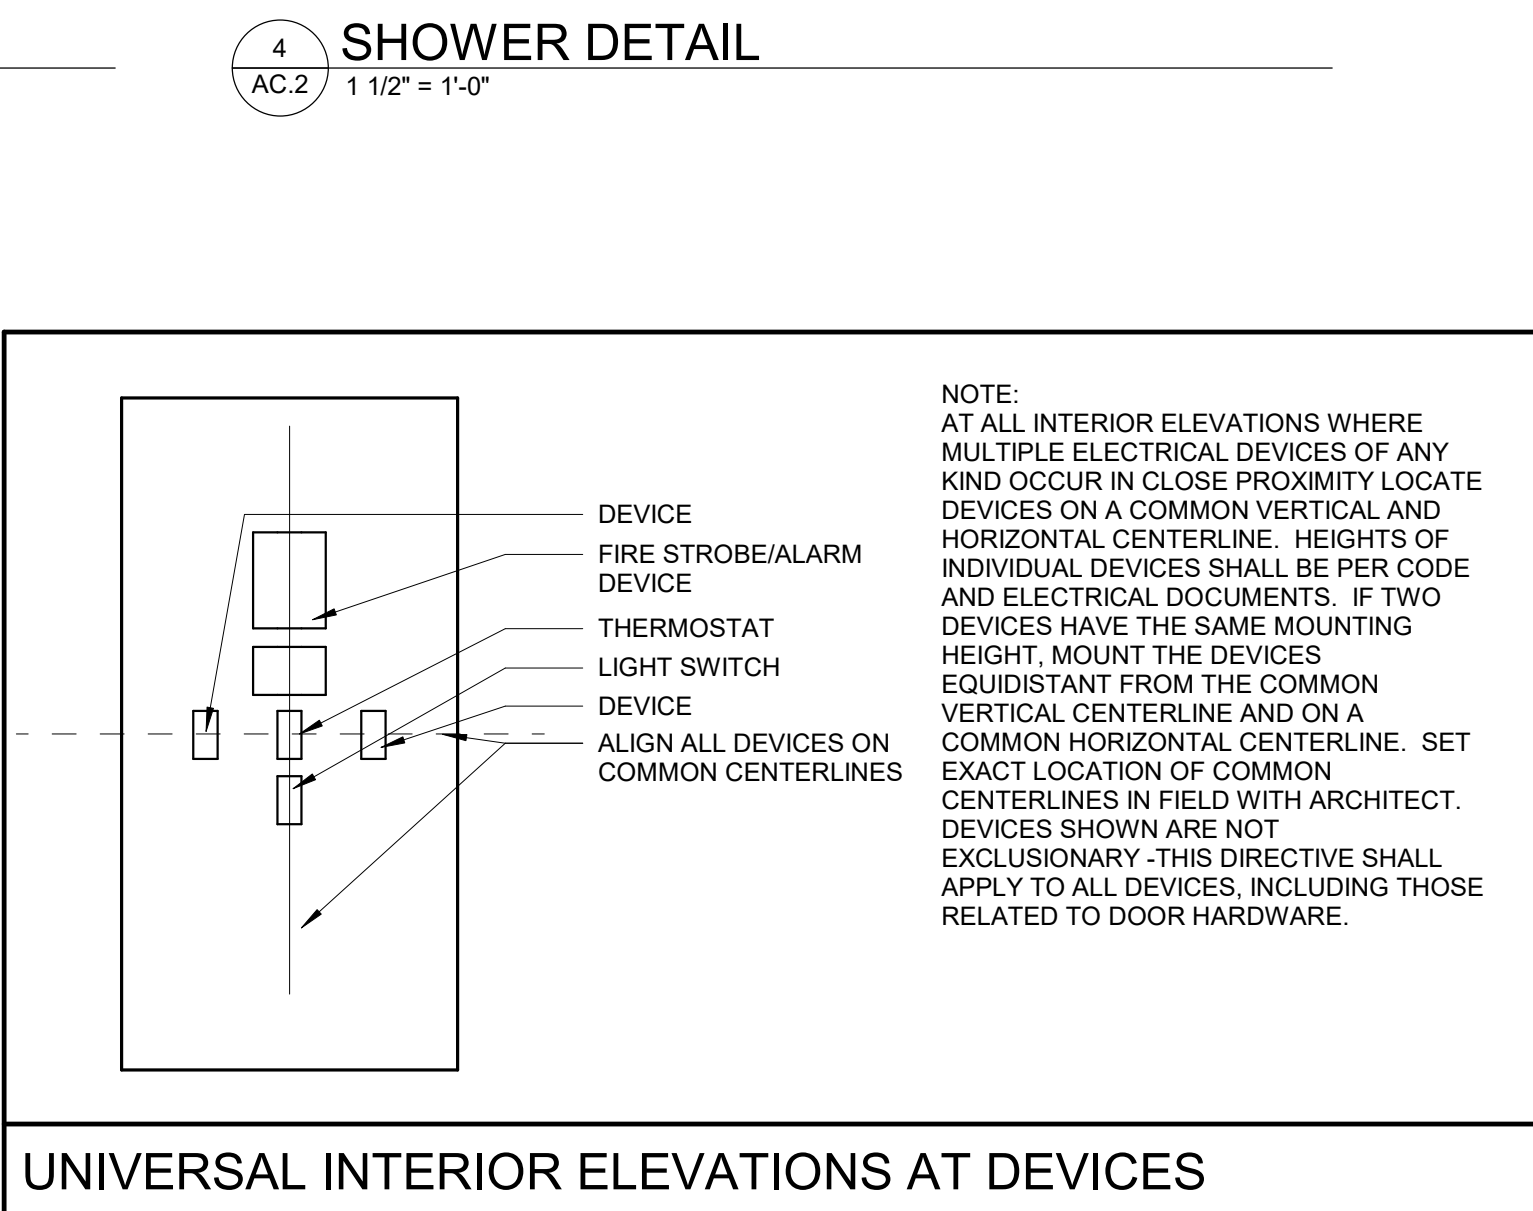

G|W|O

2019 GWWO INC.

800 WYMAN PARK DRIVE, SUITE 300
BALTIMORE, MARYLAND 21211, 410-352-1909

CERTIFY THAT THESE DOCUMENTS WERE PREPARED OR APPROVED BY ME, AND THAT I AM A DULY LICENSED ARCHITECT UNDER THE LAWS OF THE STATE OF MARYLAND. LICENSE NUMBER: 8400, EXPIRATION DATE: 12/31/2020

Revisions:		
No.	Date	Description
2	1/28/2020	ADDENDUM 2

MIDDLE BRANCH FITNESS & WELLNESS CENTER AT CHERRY HILL

BALTIMORE CITY RECREATION & PARKS


Job No.	#18010	AWM	Drawn
Scale	As indicated	KMS	Checked
Date	12/13/2019	AER	Approved

Drawing Title: CONSTRUCTION TYPES, TYPICAL DETAILS, AND DIAGRAMS

Sheet: **AC.2r2**


C:\Autodesk\Local Files\18010-MBFW-Bid-2019-1_amcallister@gwwoinc.com.rvt

1/24/2020 4:05:20 PM

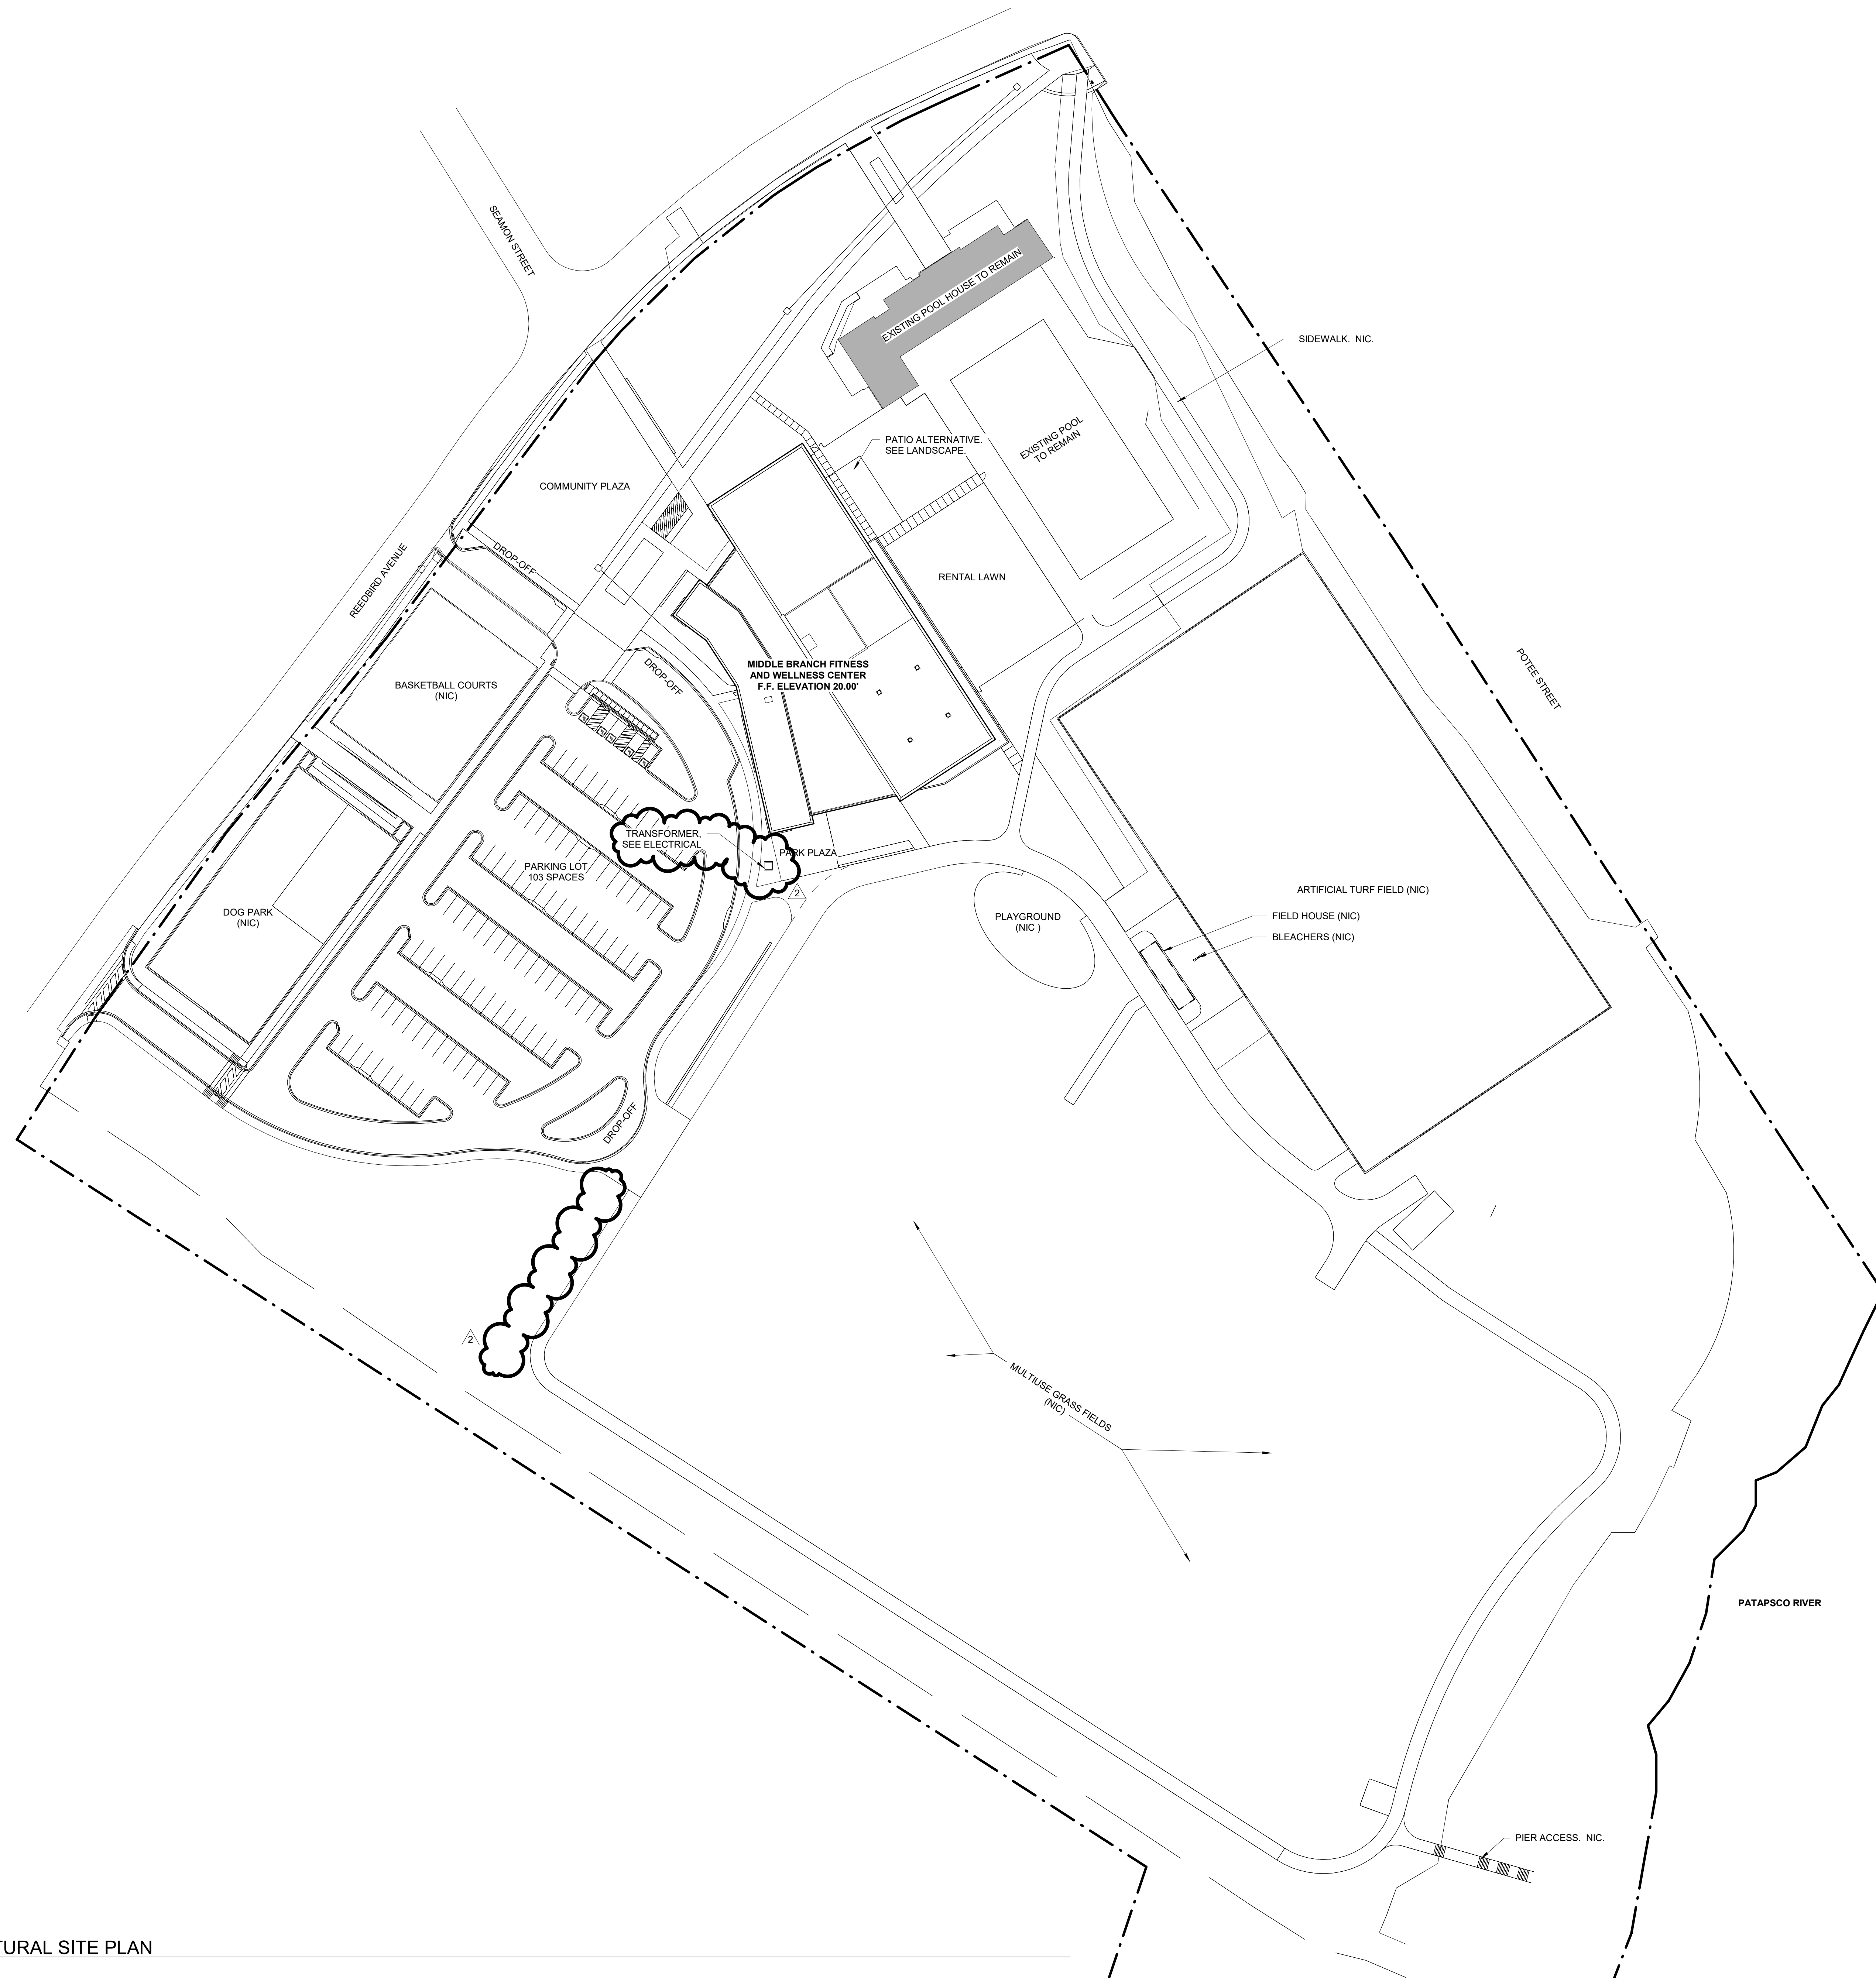

KEY PLAN:

KEYNOTES LISTED ON THIS SHEET ARE FOR CONVENIENCE ONLY. REFER TO SHEET CS.2 FOR COMPLETE LIST

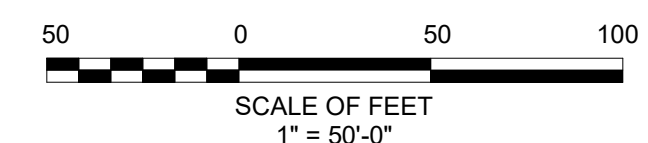

ISSUED FOR BID

Seal:

Seal:

GW
WO
GWWO INC.
800 WYMAN PARK DRIVE, SUITE 300
BALTIMORE, MARYLAND 21211, 410-352-1909
© 2019 GWWO INC.


I CERTIFY THAT THESE DOCUMENTS WERE PREPARED OR APPROVED BY ME, AND THAT I AM A DULY LICENSED ARCHITECT UNDER THE LAWS OF THE STATE OF MARYLAND. LICENSE NUMBER: 8400, EXPIRATION DATE: 12/31/2020



Revisions:		
No.	Date	Description
2	1/28/2020	ADDENDUM 2

MIDDLE BRANCH FITNESS & WELLNESS CENTER AT CHERRY HILL
BALTIMORE CITY RECREATION & PARKS


Job No.	#18010	KMS	Drawn
Scale	1" = 50'-0"	KMS	Checked
Date	12/13/2019	AER	Approved
Drawing Title	ARCHITECTURAL SITE PLAN		
Sheet	AS.1r2	Of	

1 ARCHITECTURAL SITE PLAN
AS.1 1" = 50'-0"

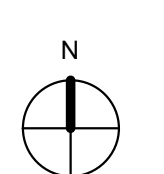

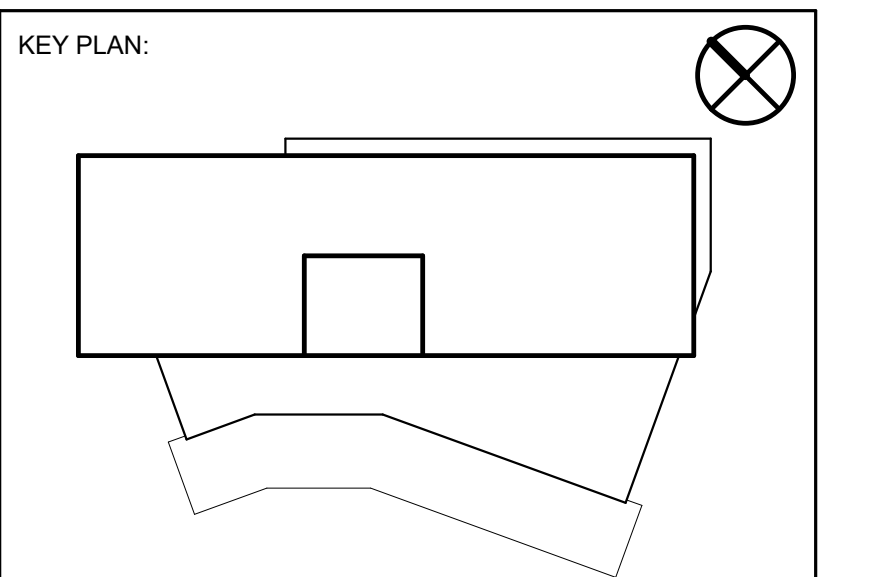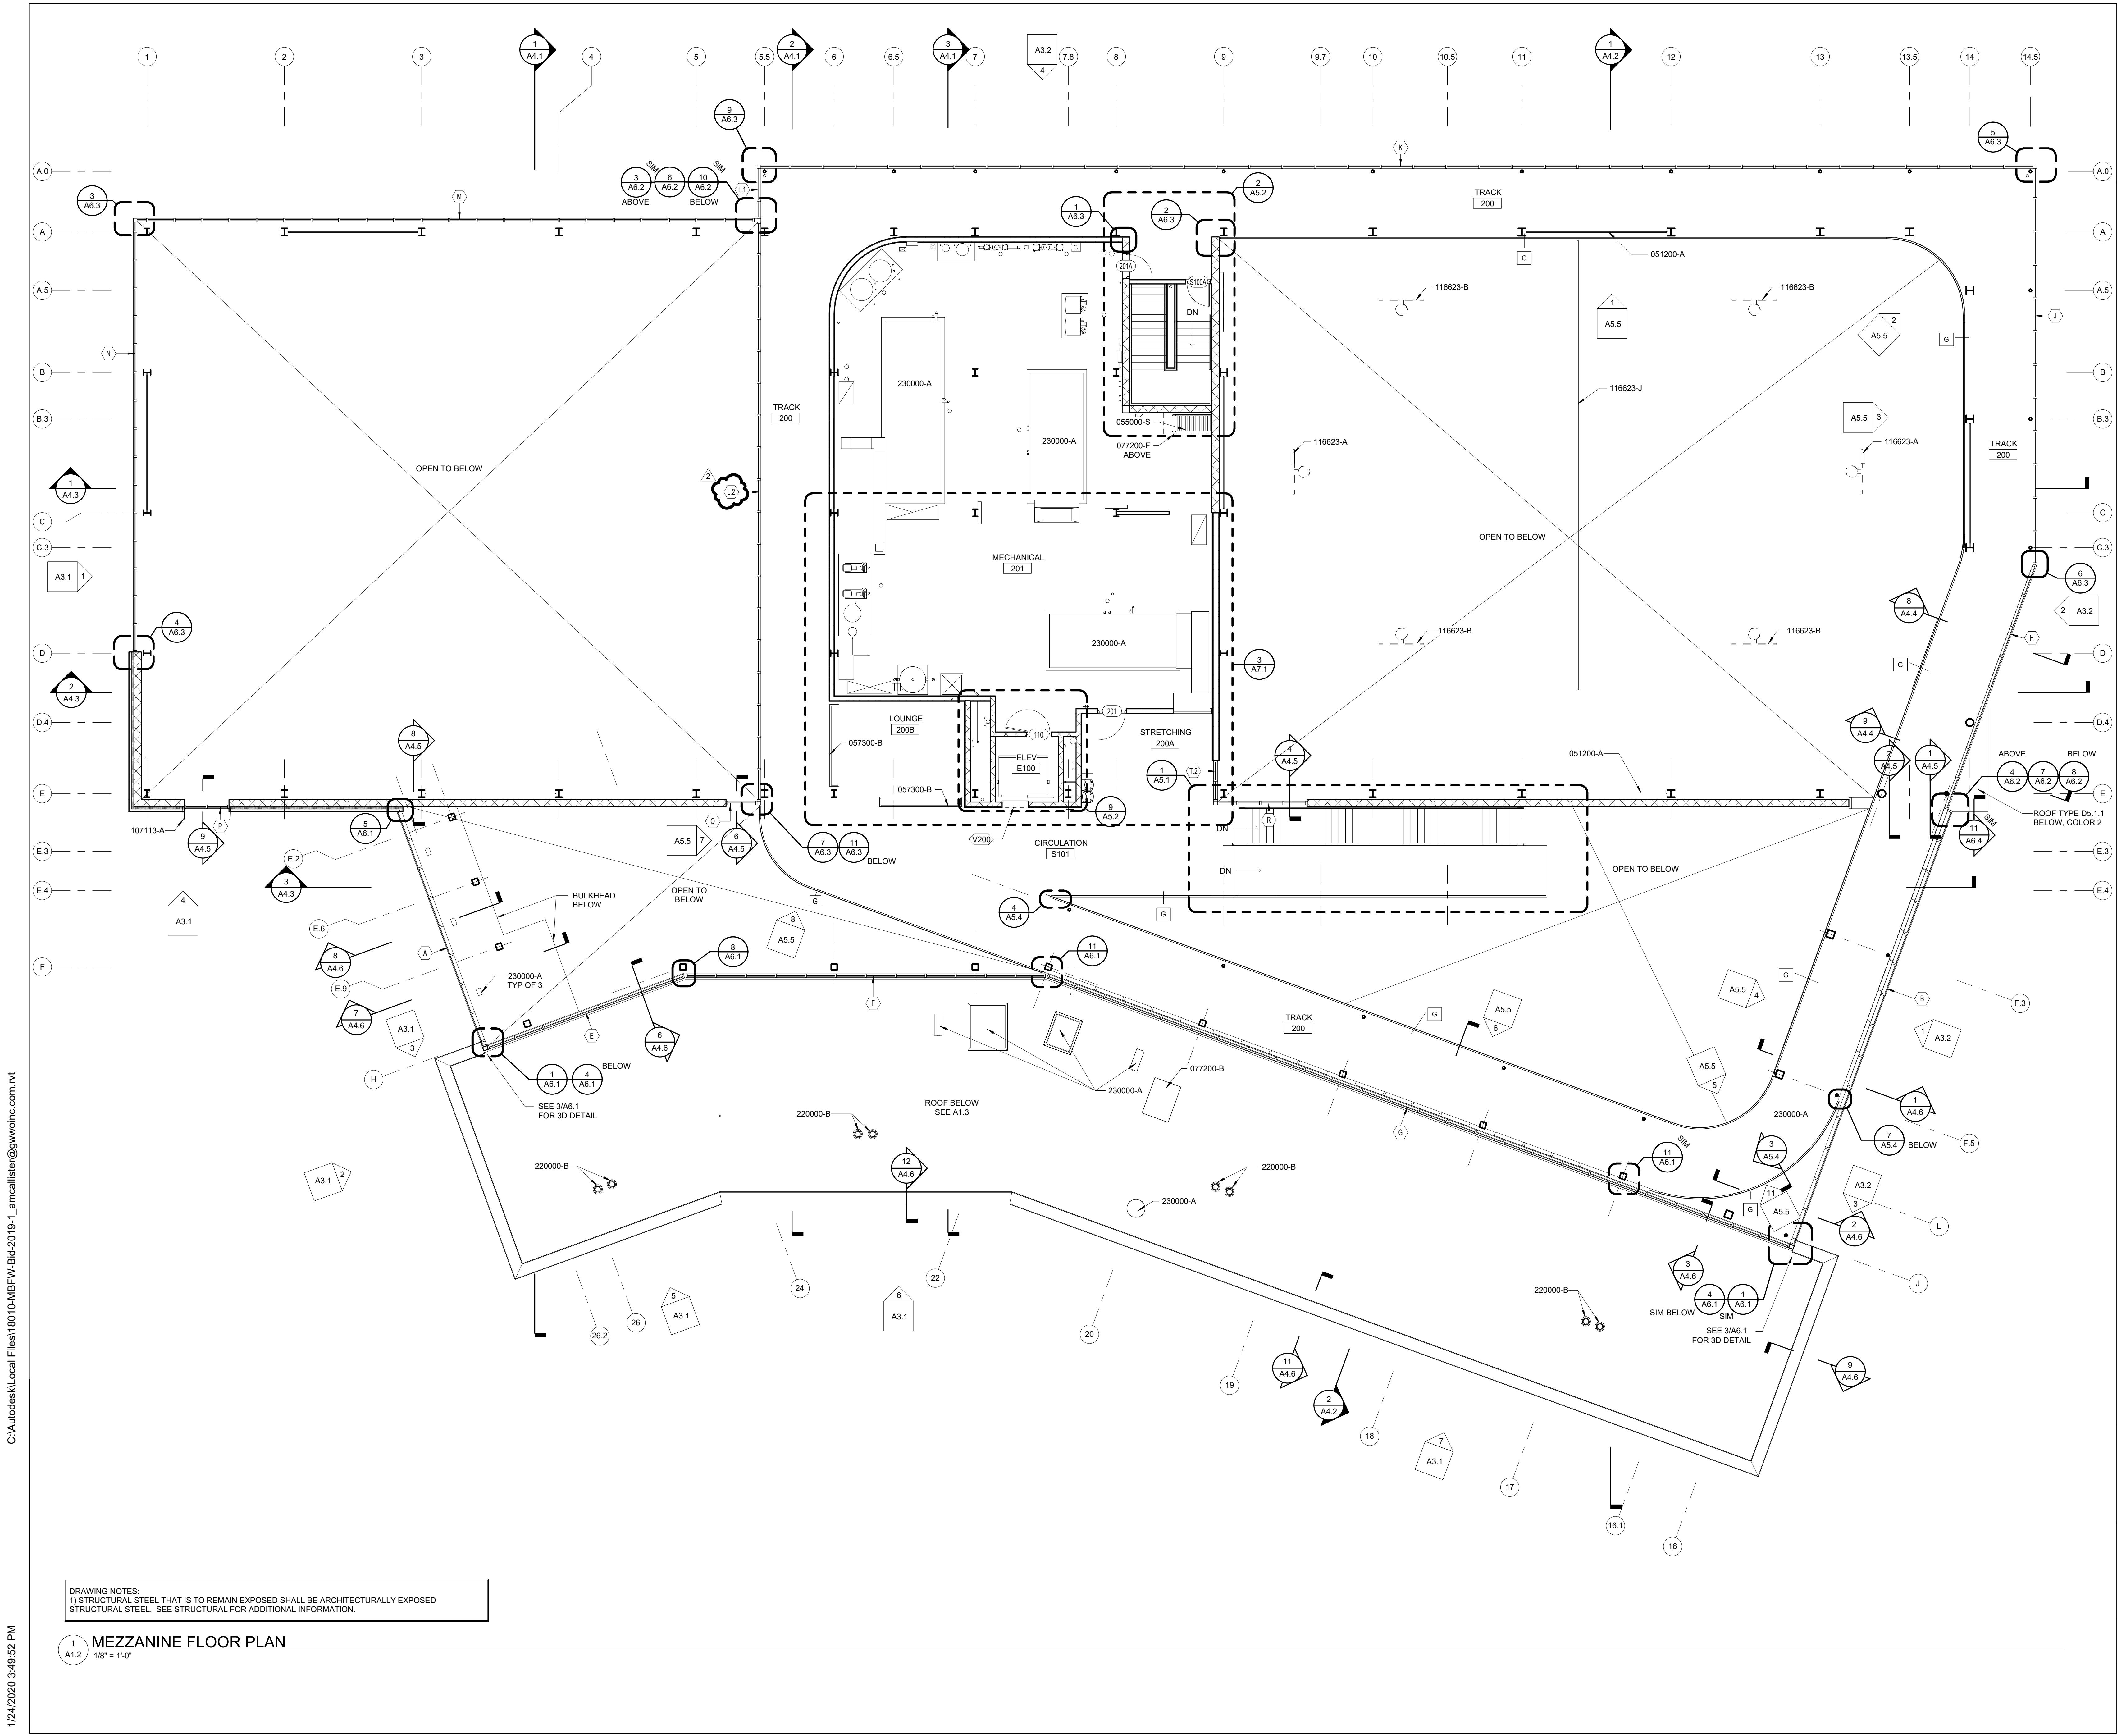

- KEYNOTES LISTED ON THIS SHEET ARE FOR CONVENIENCE ONLY. REFER TO SHEET CS.2 FOR COMPLETE LIST**
- 051200-A STRUCTURAL STEEL (REFER TO STRUCTURAL FOR MORE INFORMATION)
 - 055000-S PREFABRICATED ALUMINUM SHIPS LADDER
 - 057300-B PERFORATED STEEL PANEL, PAINTED PT-3
 - 077200-B ROOF HATCH, LADDER ACCESS
 - 077200-F ROOF HATCH, SHIPS LADDER ACCESS
 - 107113-A ALUMINUM PLATE, 1/8" THICK, 3-COAT FLOURPOLYMER FINISH - COLOR 3 UNG
 - 116623-A FORWARD FOLDING BASKETBALL BACKSTOP
 - 116623-B SIDE FOLDING BASKETBALL BACKSTOP
 - 116623-J GYMNASIUM DIVIDER CURTAIN, ALTERNATE NO.5
 - 220000-B ROOF DRAIN, SEE DETAIL 3/A.2, REFER TO PLUMBING DOCUMENTS
 - 230000-A MECHANICAL (REFER TO MECHANICAL FOR MORE INFORMATION)

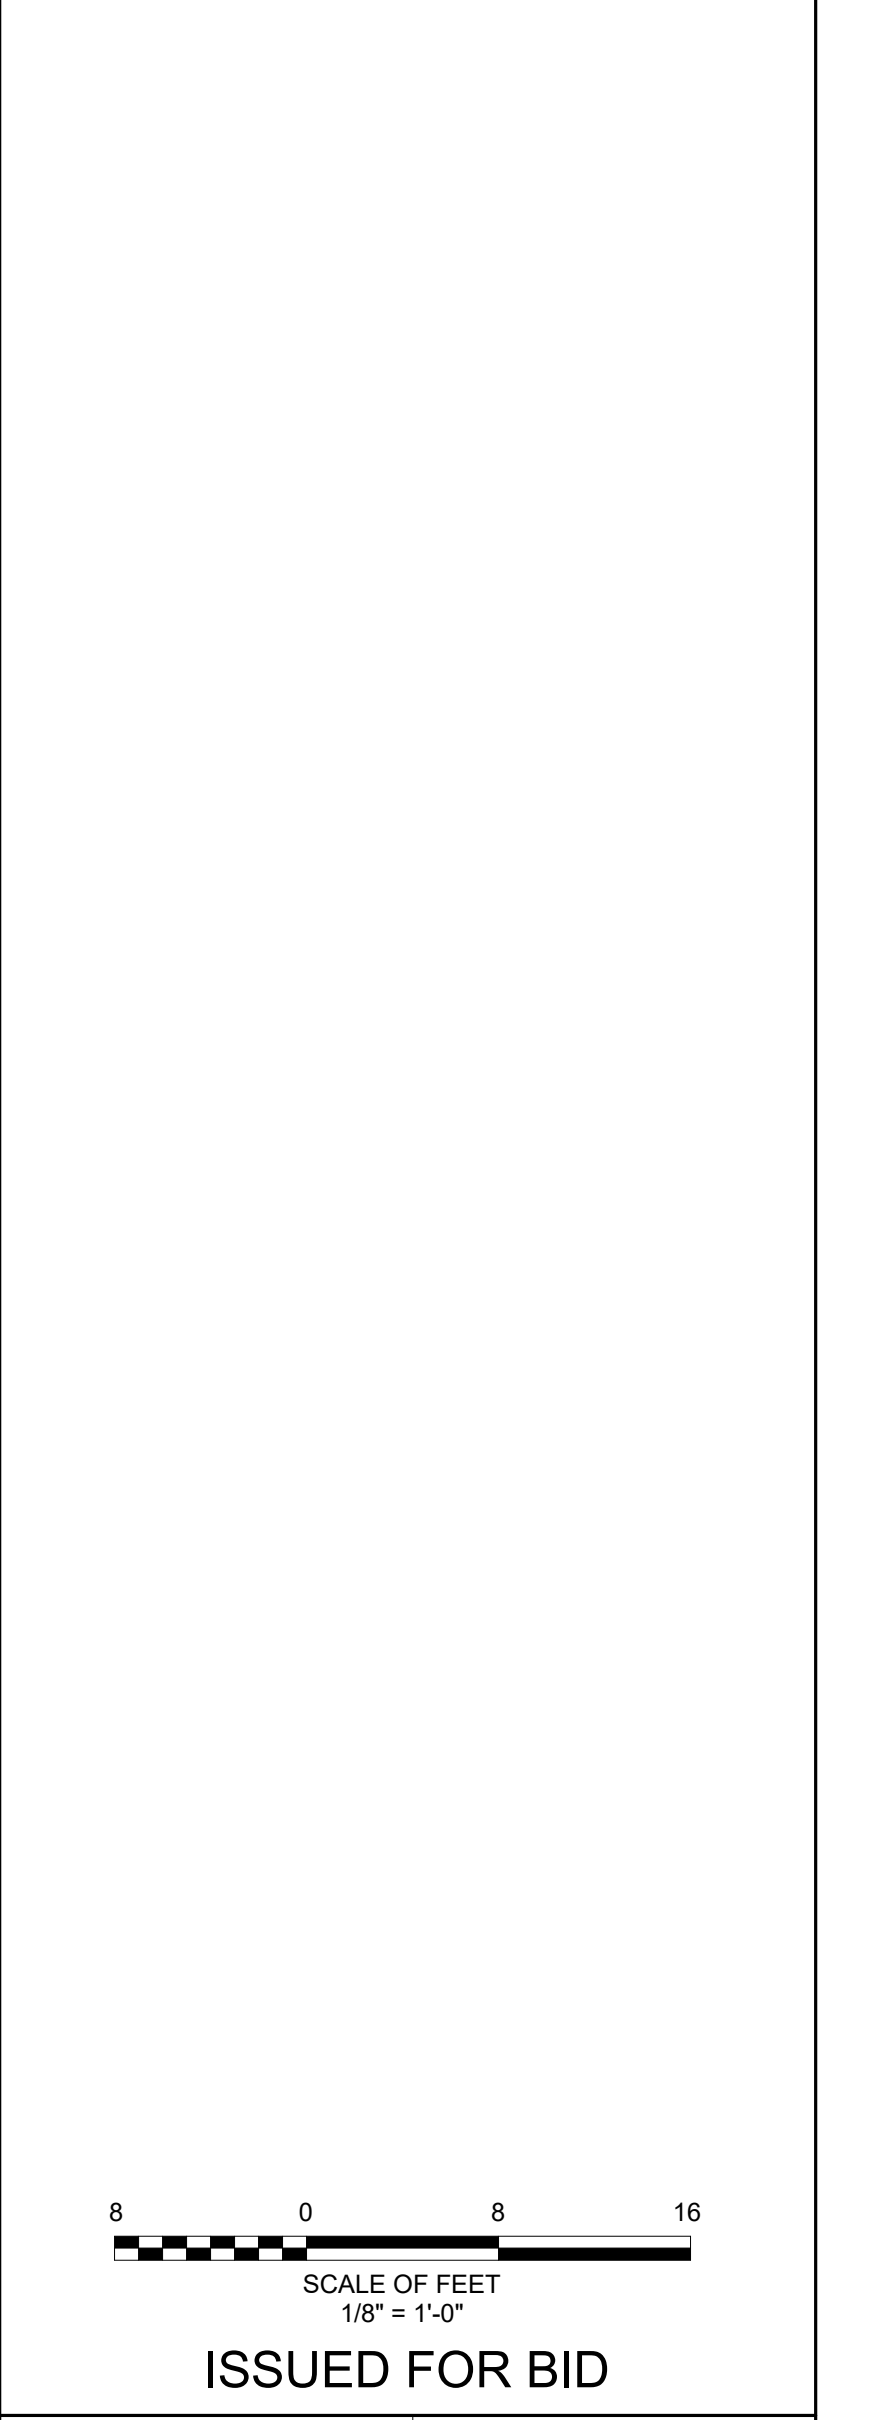

ISSUED FOR BID

Seal:

G|W|O INC.
802 WYMAN PARK DRIVE, SUITE 300
BALTIMORE, MARYLAND 21211, 410-352-1909

© 2019 GWWO INC.

I CERTIFY THAT THESE DOCUMENTS WERE PREPARED OR APPROVED BY ME, AND THAT I AM A DULY LICENSED ARCHITECT UNDER THE LAWS OF THE STATE OF MARYLAND.
LICENSE NUMBER: 8400, EXPIRATION DATE: 12/31/2020

Seal:

Revisions:		
No.	Date	Description
2	1/28/2020	ADDENDUM 2

DRAWING NOTES:
 1) STRUCTURAL STEEL THAT IS TO REMAIN EXPOSED SHALL BE ARCHITECTURALLY EXPOSED STRUCTURAL STEEL. SEE STRUCTURAL FOR ADDITIONAL INFORMATION.

1 MEZZANINE FLOOR PLAN
 A1.2 1/8" = 1'-0"

MIDDLE BRANCH FITNESS & WELLNESS CENTER AT CHERRY HILL


BALTIMORE CITY RECREATION & PARKS

Job No.	#18010	AWM	Drawn
Scale	1/8" = 1'-0"	KMS	Checked
Date	12/13/2019	AER	Approved
Drawing Title	MEZZANINE FLOOR PLAN		Drawing Number
			A1.2r2
Sheet			Of

C:\Autodesk\Local Files\18010-MBFW-Bid-2019-1_amcallister@gwwoinc.com.rvt 1/24/2020 3:49:52 PM


C:\Autodesk\Local Files\18010-MBFW-Bid-2019-1_amcallister@gwwinc.com.rvt

1/24/2020 3:49:57 PM

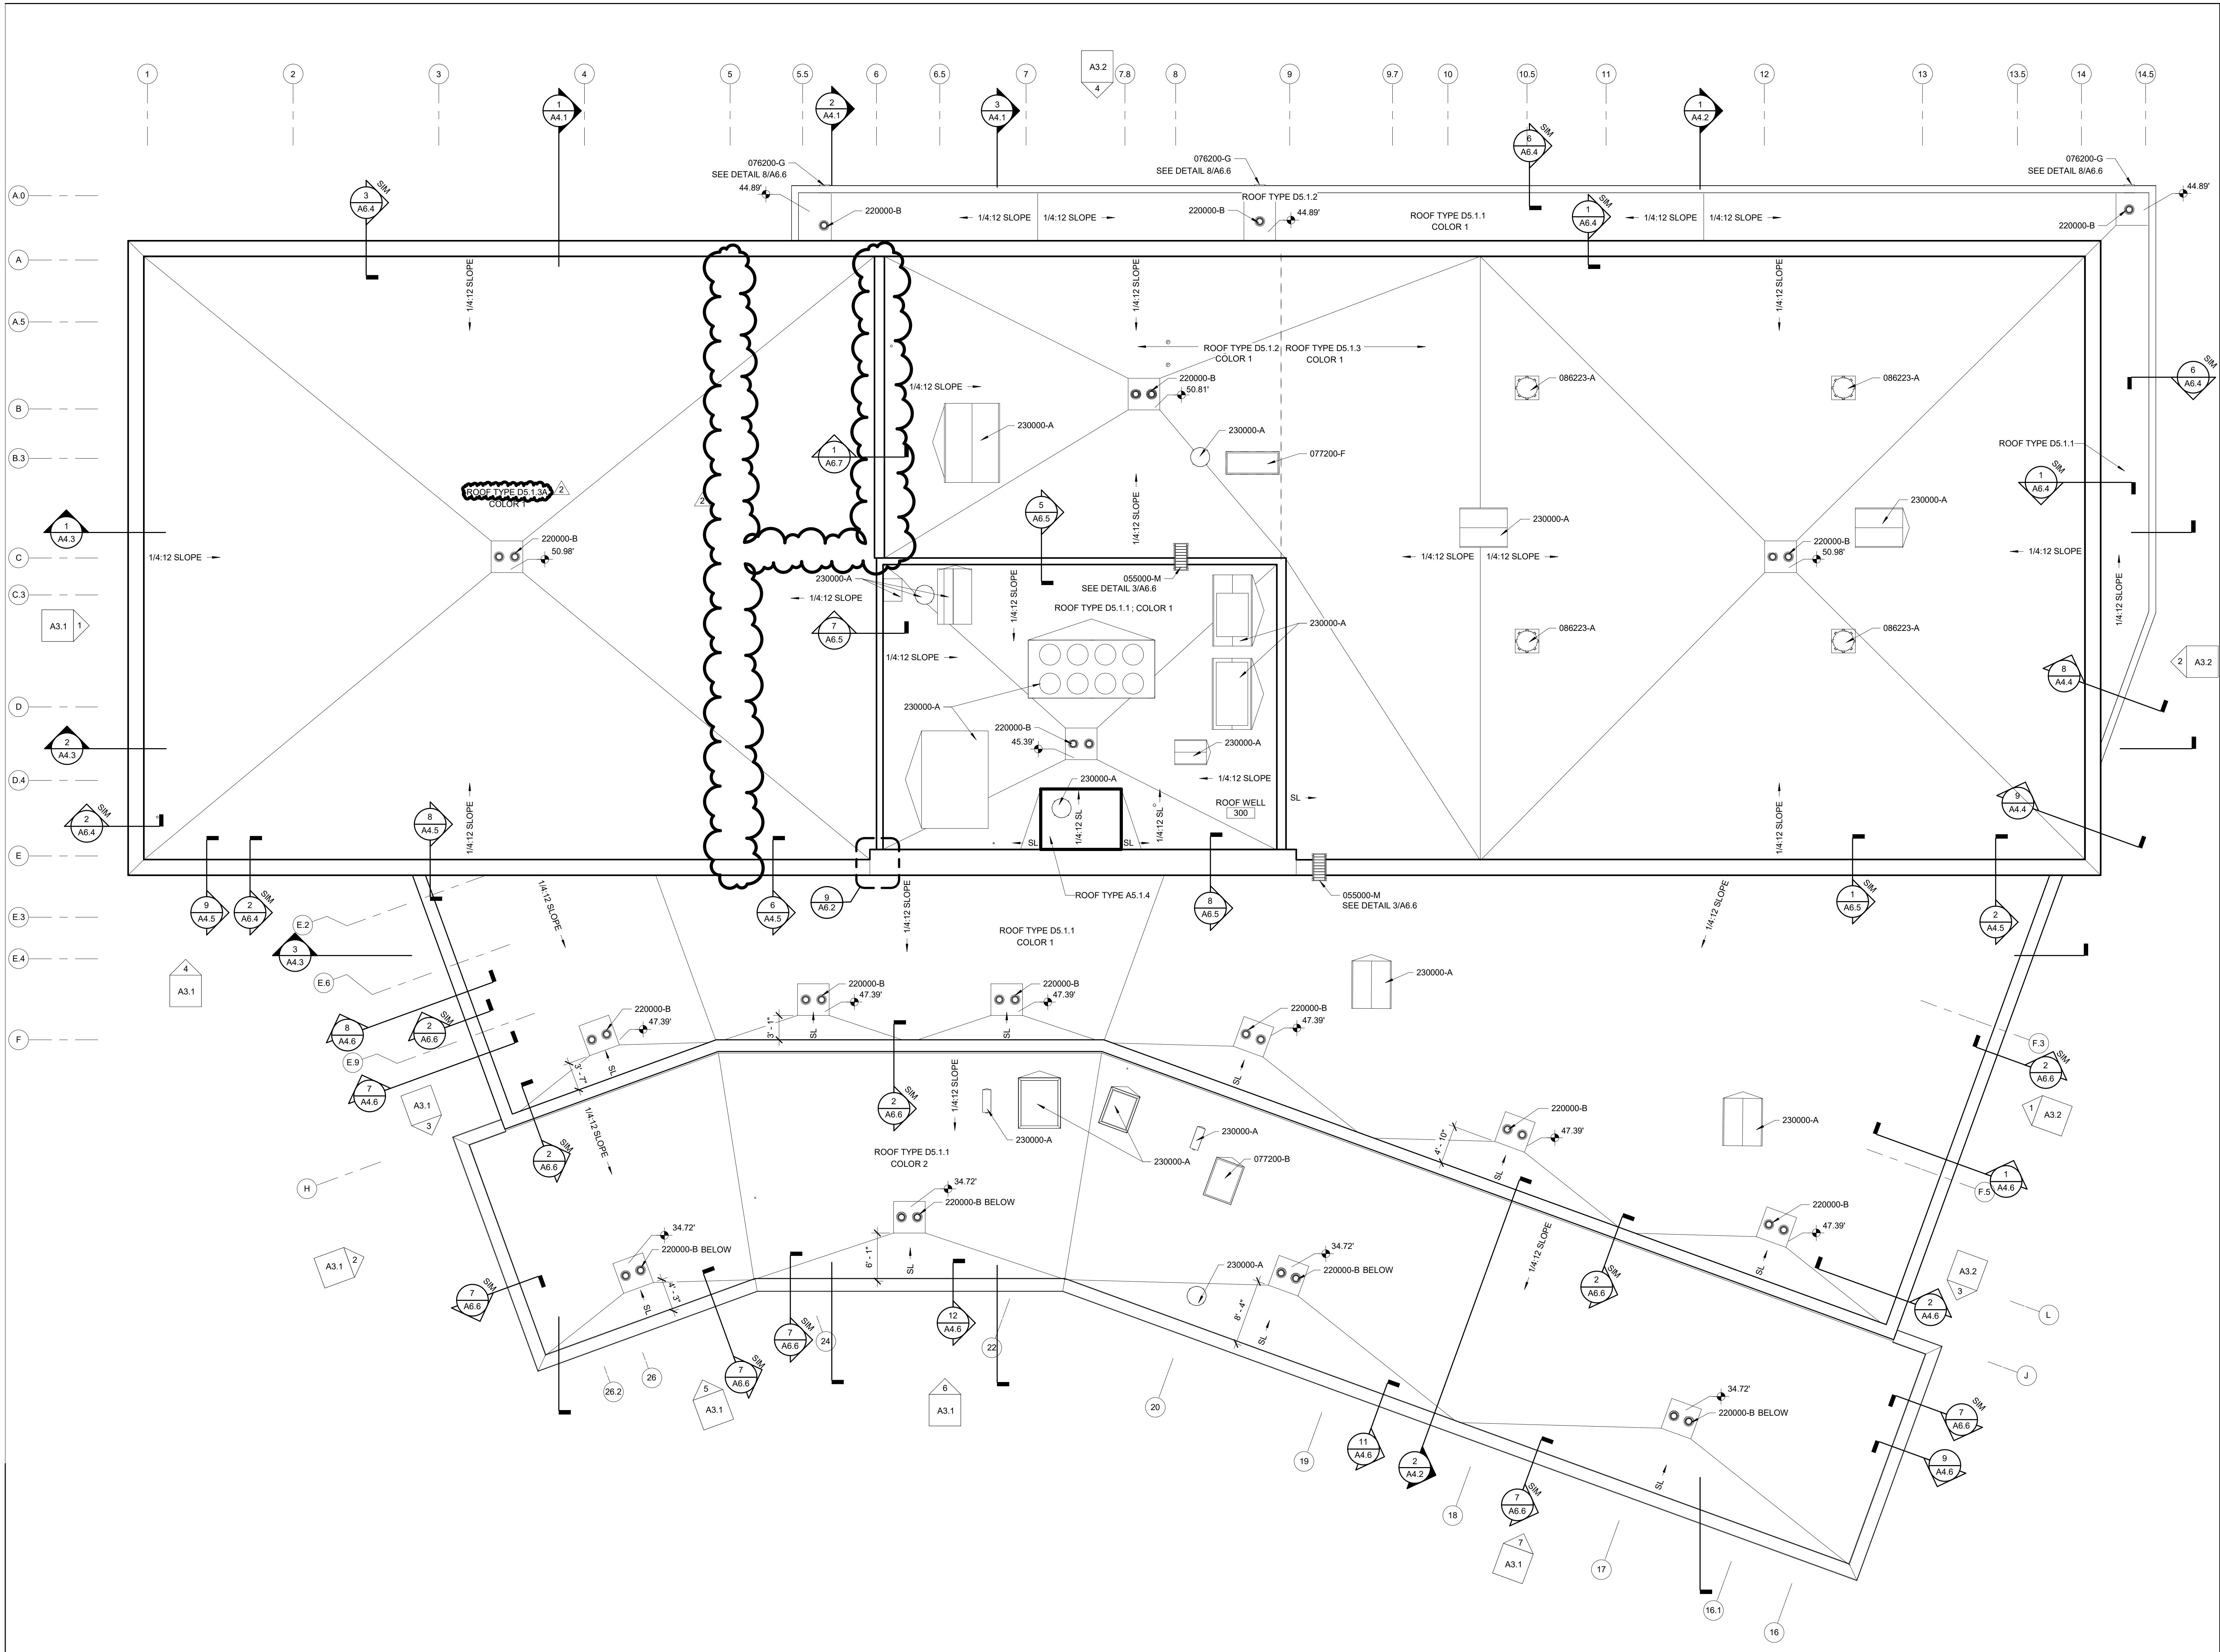


1
A1.3
ROOF PLAN
1/8" = 1'-0"

KEY PLAN:

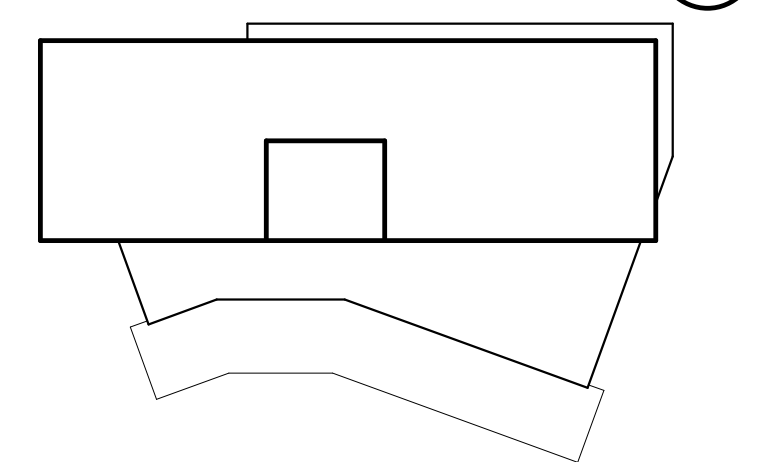


KEYNOTES LISTED ON THIS SHEET ARE FOR CONVENIENCE ONLY. REFER TO SHEET CS.2 FOR COMPLETE LIST

- 055000-M PREFABRICATED ALUMINUM LADDER
- 076200-G THROUGH WALL METAL SCUPPER OVERFLOW, WELDED WATER TIGHT
- 077200-B ROOF HATCH, LADDER ACCESS
- 077200-F ROOF HATCH, SHIPS LADDER ACCESS
- 086223-A TUBULAR SKYLIGHT
- 220000-B ROOF DRAIN, SEE DETAIL 3/A.C.2, REFER TO PLUMBING DOCUMENTS
- 230000-A MECHANICAL (REFER TO MECHANICAL FOR MORE INFORMATION)

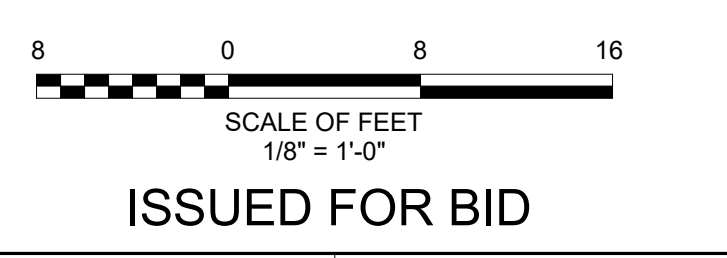

ISSUED FOR BID

Seal:

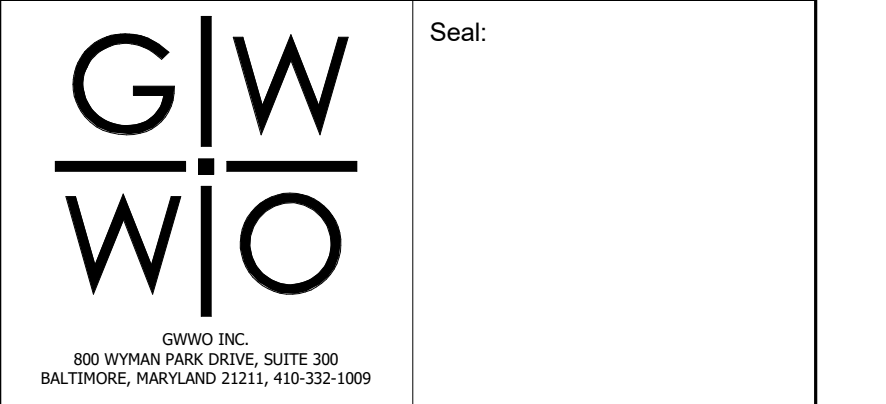

© 2019 GWWO INC.
I CERTIFY THAT THESE DOCUMENTS WERE PREPARED OR APPROVED BY ME, AND THAT I AM A DULY LICENSED ARCHITECT UNDER THE LAWS OF THE STATE OF MARYLAND. LICENSE NUMBER: 8400, EXPIRATION DATE: 12/31/2020


Revisions:		
No.	Date	Description
2	1/28/2020	ADDENDUM 2

MIDDLE BRANCH FITNESS & WELLNESS CENTER AT CHERRY HILL


BALTIMORE CITY RECREATION & PARKS

Job No.	#18010	AWM	Drawn
Scale	1/8" = 1'-0"	KMS	Checked
Date	12/13/2019	AER	Approved
Drawing Title	ROOF PLAN		
Drawing Number	A1.3r2		


Sheet

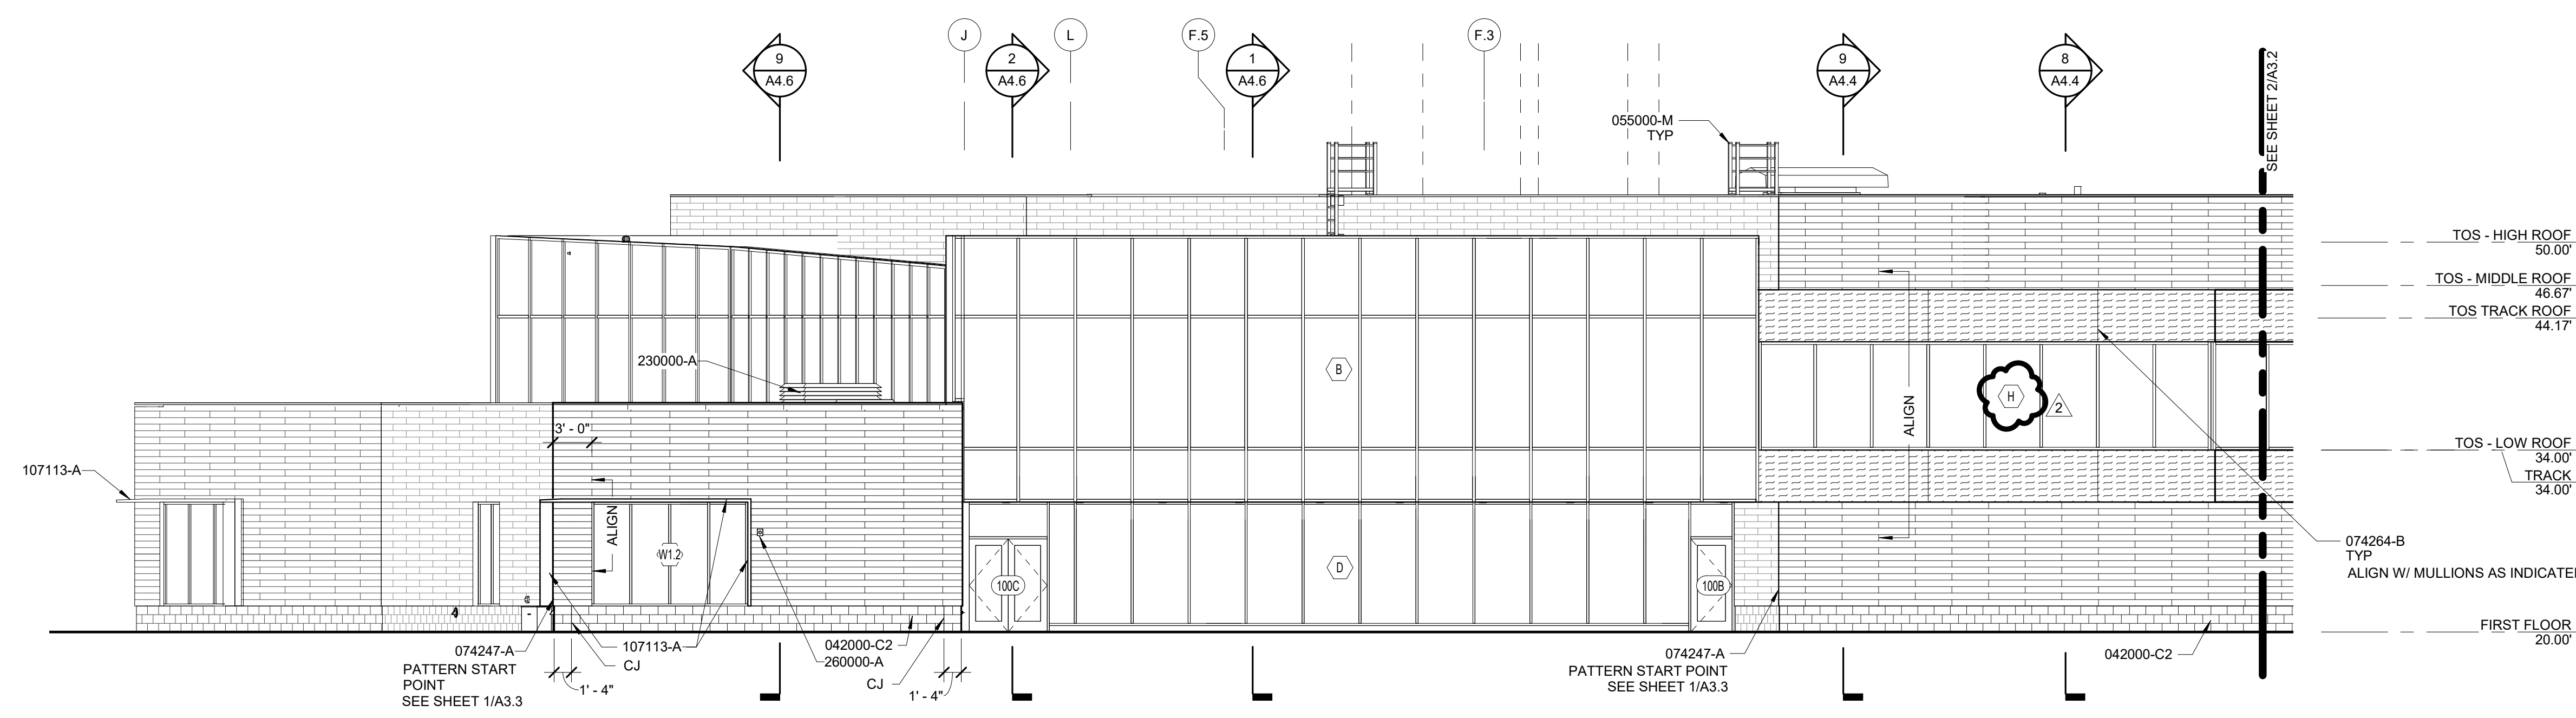

1 BUILDING ELEVATION
A3.2 1/8" = 1'-0"
FROM 1 / A1.1

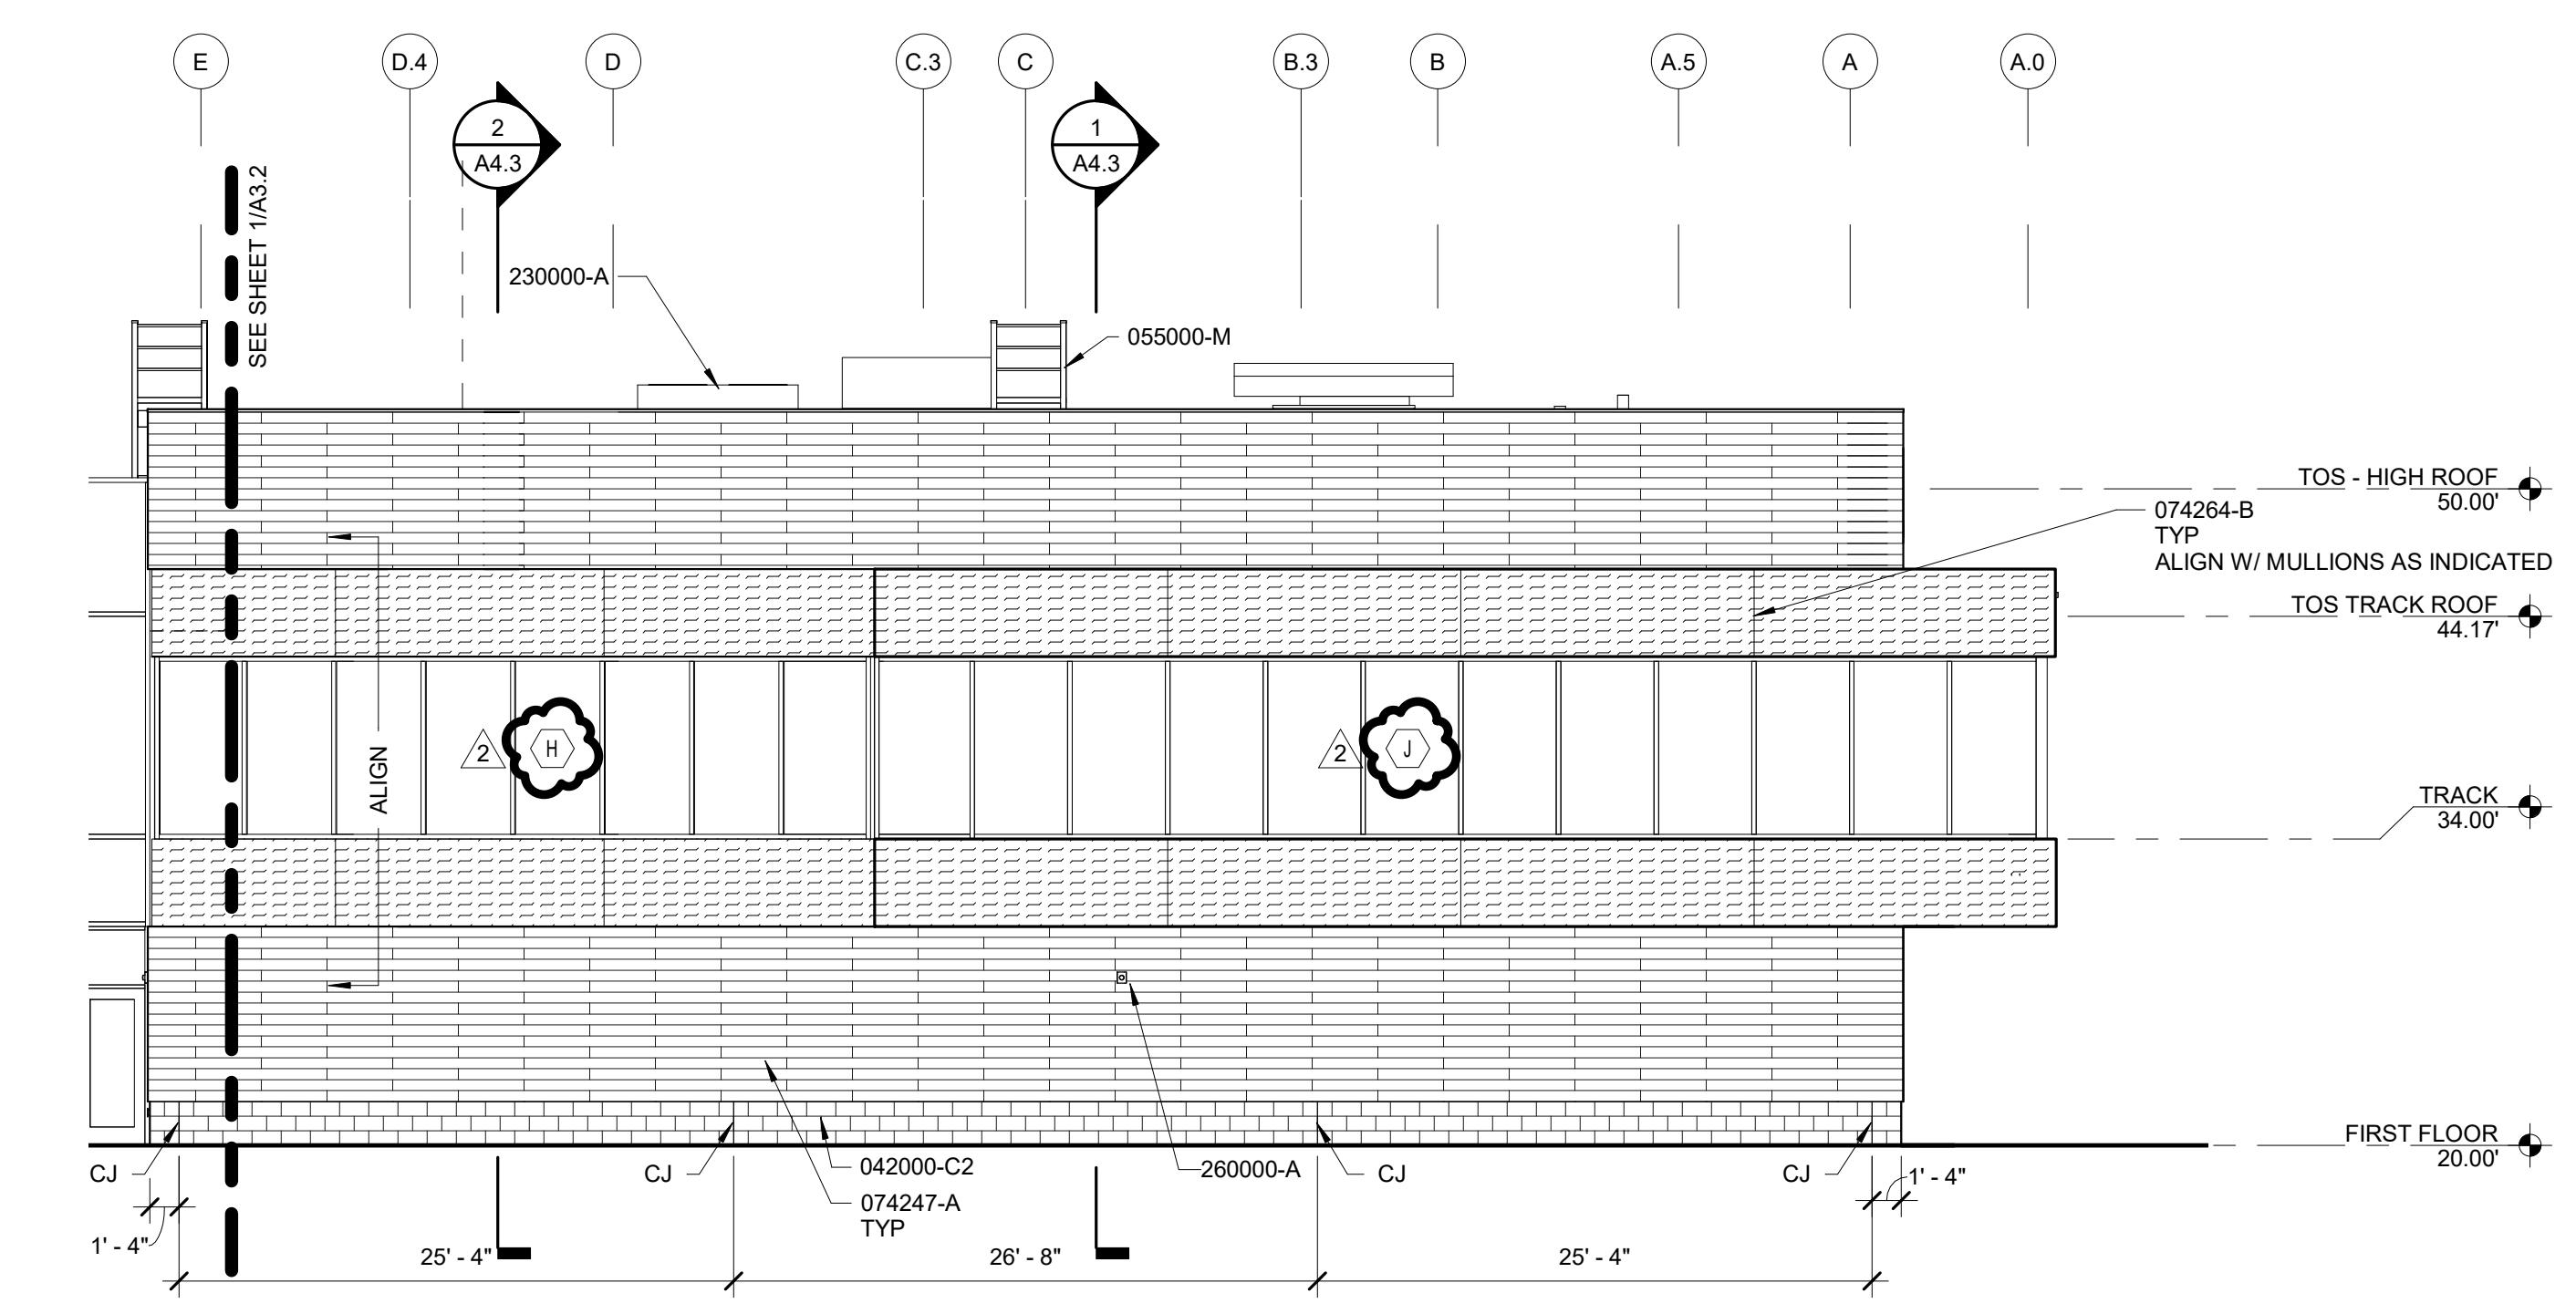


2 BUILDING ELEVATION
A3.2 1/8" = 1'-0"
FROM 1 / A1.1

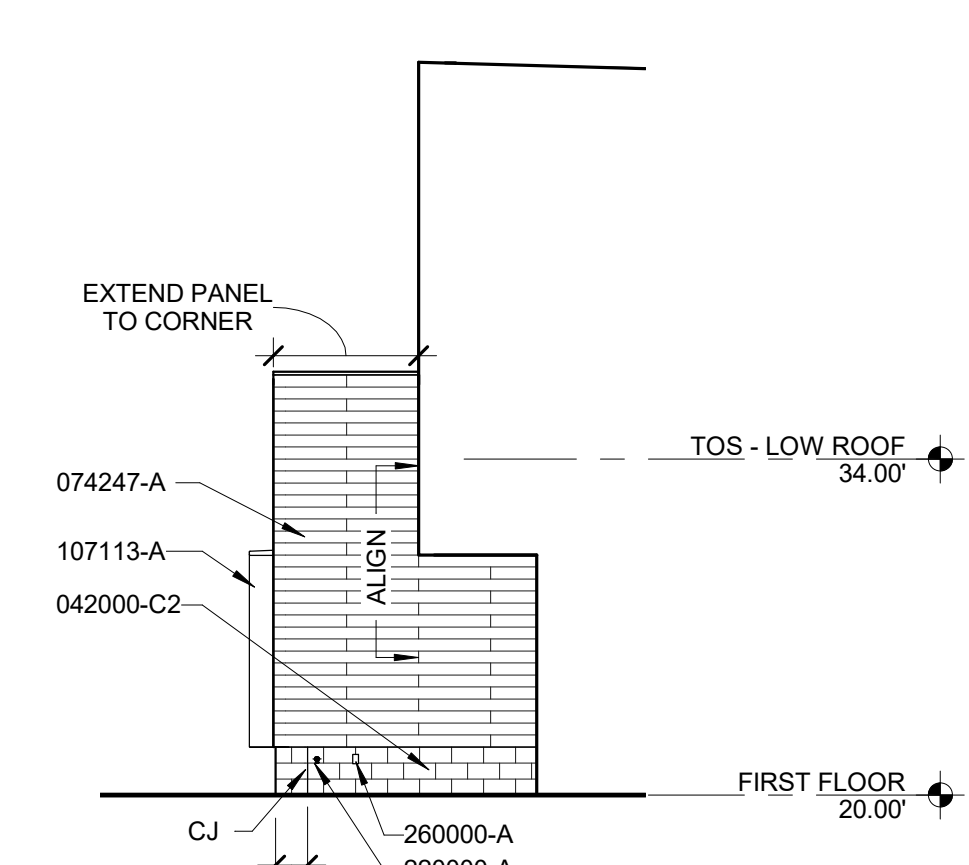


3 BUILDING ELEVATION
A3.2 1/8" = 1'-0"
FROM 1 / A1.1

EXTERIOR MATERIALS LEGEND			
FINISH TYPES			
HATCH	MATERIAL DESCRIPTION	MFR/STYLE/COLOR	SECTION
	HIGH PERFORMANCE CONCRETE PANELS	TAKTL SELECT, SEE DETAIL 1/A3.3 FOR PATTERN & COLORS	074247-A
	GROUND FACE CMU	3X16X4 WESTBROOK / GROUND FACE / GF 315 SHOULDRICE / TAPESTRY (WITHOUT BEVEL)/COLBY YORK / GEMSTONE / CUSTOM COLOR	042000-C2
	ALUMINUM COMPOSITE PANEL	ALUO2BOND, CUSTOM COLOR TO MATCH DRYLAC BENGAL RED	074264-A

NOTE: HATCHES ARE SPECIFIC TO A3 SHEETS ONLY.

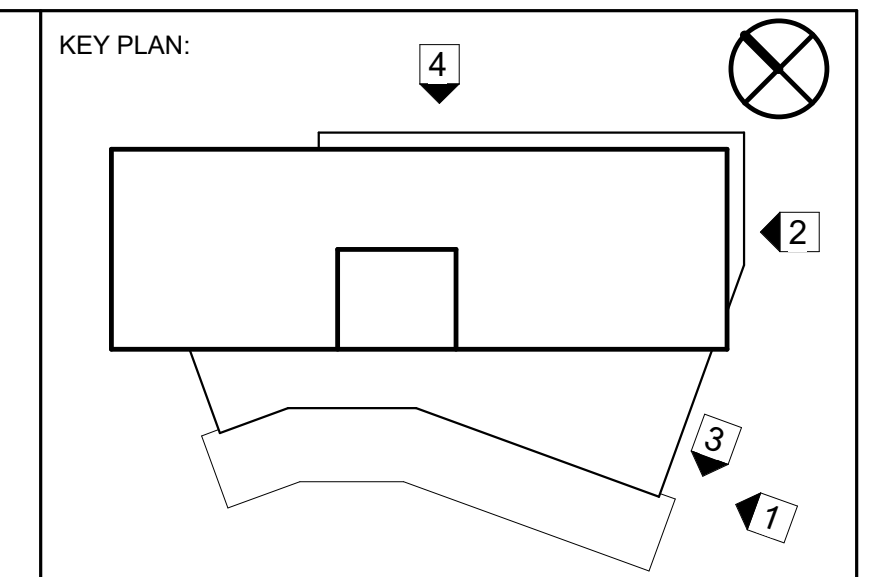

- KEYNOTES LISTED ON THIS SHEET ARE FOR CONVENIENCE ONLY. REFER TO SHEET CS.2 FOR COMPLETE LIST
- 042000-C2 GROUND FACE CMU 2, SIZE AND COLOR AS INDICATED
 - 055000-M PREFABRICATED ALUMINUM LADDER
 - 074247-A CONCRETE PANEL
 - 074264-A ALUMINUM COMPOSITE PANEL
 - 074264-B ALUMINUM COMPOSITE PANEL REVEAL
 - 076200-G THROUGH WALL METAL SCUPPER OVERFLOW, WELDED WATER TIGHT
 - 107113-A ALUMINUM PLATE, 1/8" THICK, 3-COAT FLUOROPOLYMER FINISH - COLOR 3 UNO
 - 220000-A PLUMBING (REFER TO PLUMBING FOR MORE INFORMATION)
 - 220000-C OVERFLOW ROOF DRAIN, REFER TO PLUMBING DOCUMENTS
 - 220000-D THROUGH WALL DOWNSPOUT NOZZLE, REFER TO PLUMBING DOCUMENTS
 - 230000-A MECHANICAL (REFER TO MECHANICAL FOR MORE INFORMATION)
 - 260000-A ELECTRICAL (REFER TO ELECTRICAL FOR MORE INFORMATION)

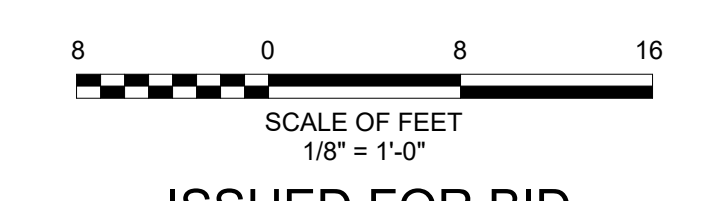

ISSUED FOR BID

Seal: _____

G|W|O

GW INC.
802 WYMAN PARK DRIVE, SUITE 300
BALTIMORE, MARYLAND 21211, 410-352-1909

© 2019 GWWO INC.

I CERTIFY THAT THESE DOCUMENTS WERE PREPARED OR APPROVED BY ME, AND THAT I AM A DULY LICENSED ARCHITECT UNDER THE LAWS OF THE STATE OF MARYLAND.
LICENSE NUMBER: 8400, EXPIRATION DATE: 12/31/2020

Revisions:


No.	Date	Description
2	1/28/2020	ADDENDUM 2

MIDDLE BRANCH FITNESS & WELLNESS CENTER AT CHERRY HILL


BALTIMORE CITY RECREATION & PARKS

Job No.	#18010	EMG	Drawn
Scale	As indicated	KMS	Checked
Date	12/13/2019	AER	Approved
Drawing Title	Drawing Number		
EXTERIOR ELEVATIONS	A3.2r2		
Sheet	Of		


1/24/2020 4:05:04 PM C:\Autodesk\Local Files\18010-MBFW-Bid-2019-1_amcallister@gwwoinc.com.rvt

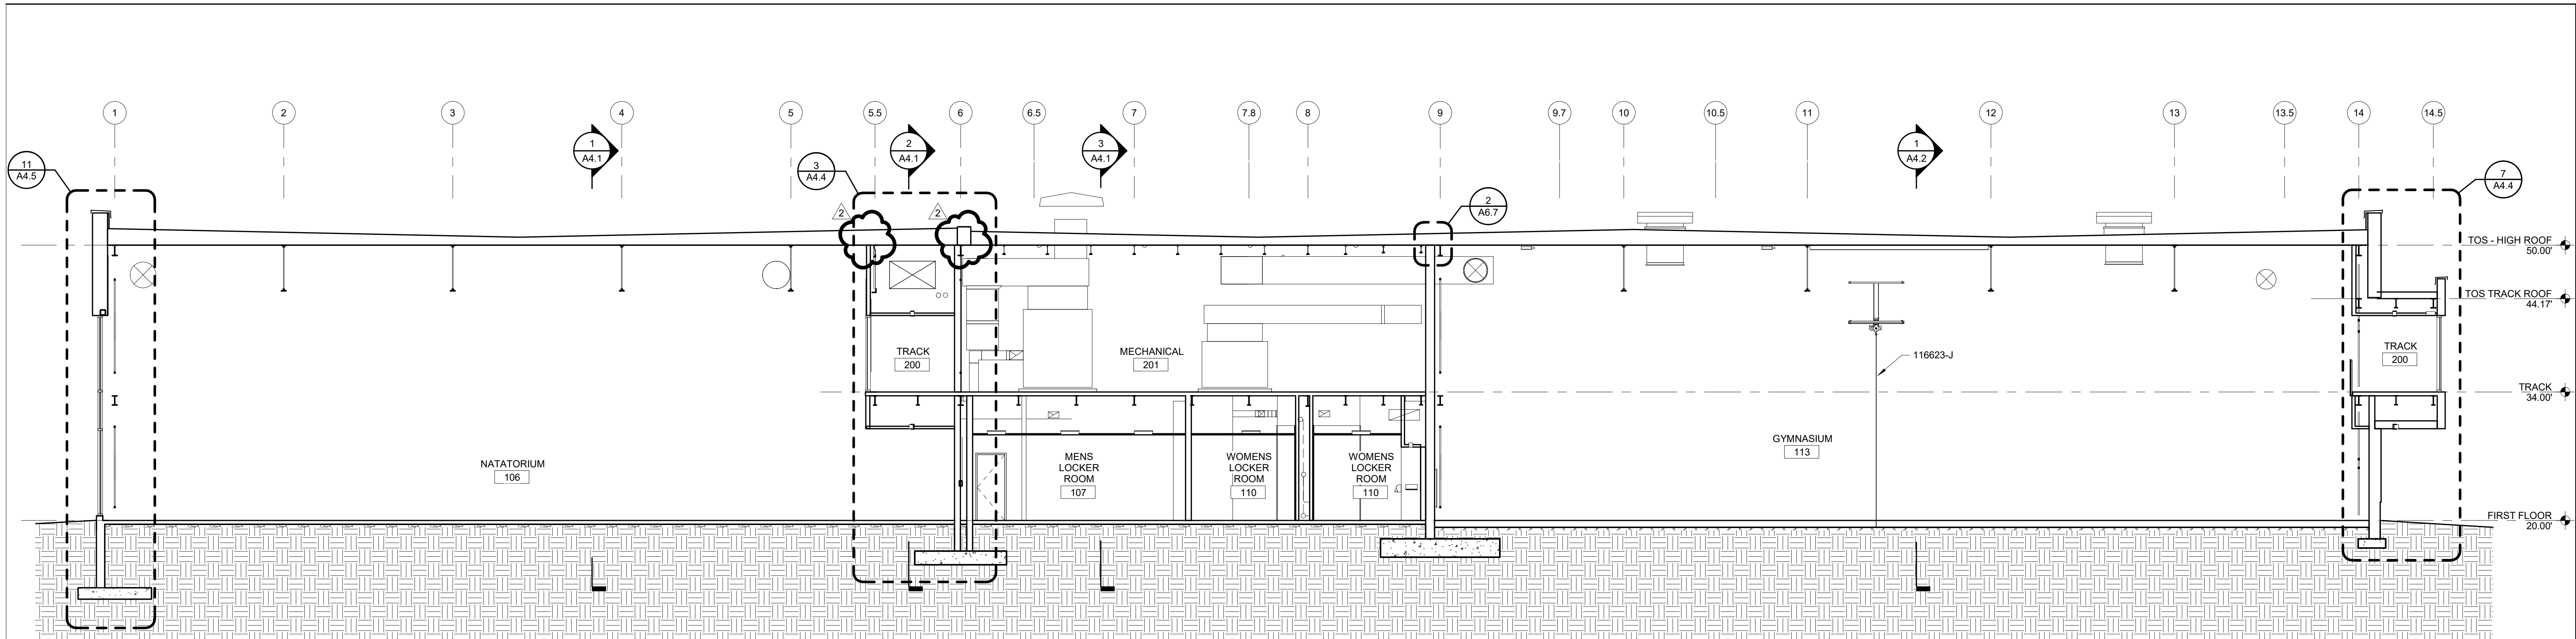


1 BUILDING SECTION
 1/8" = 1'-0"
 FROM 1 / A1.1

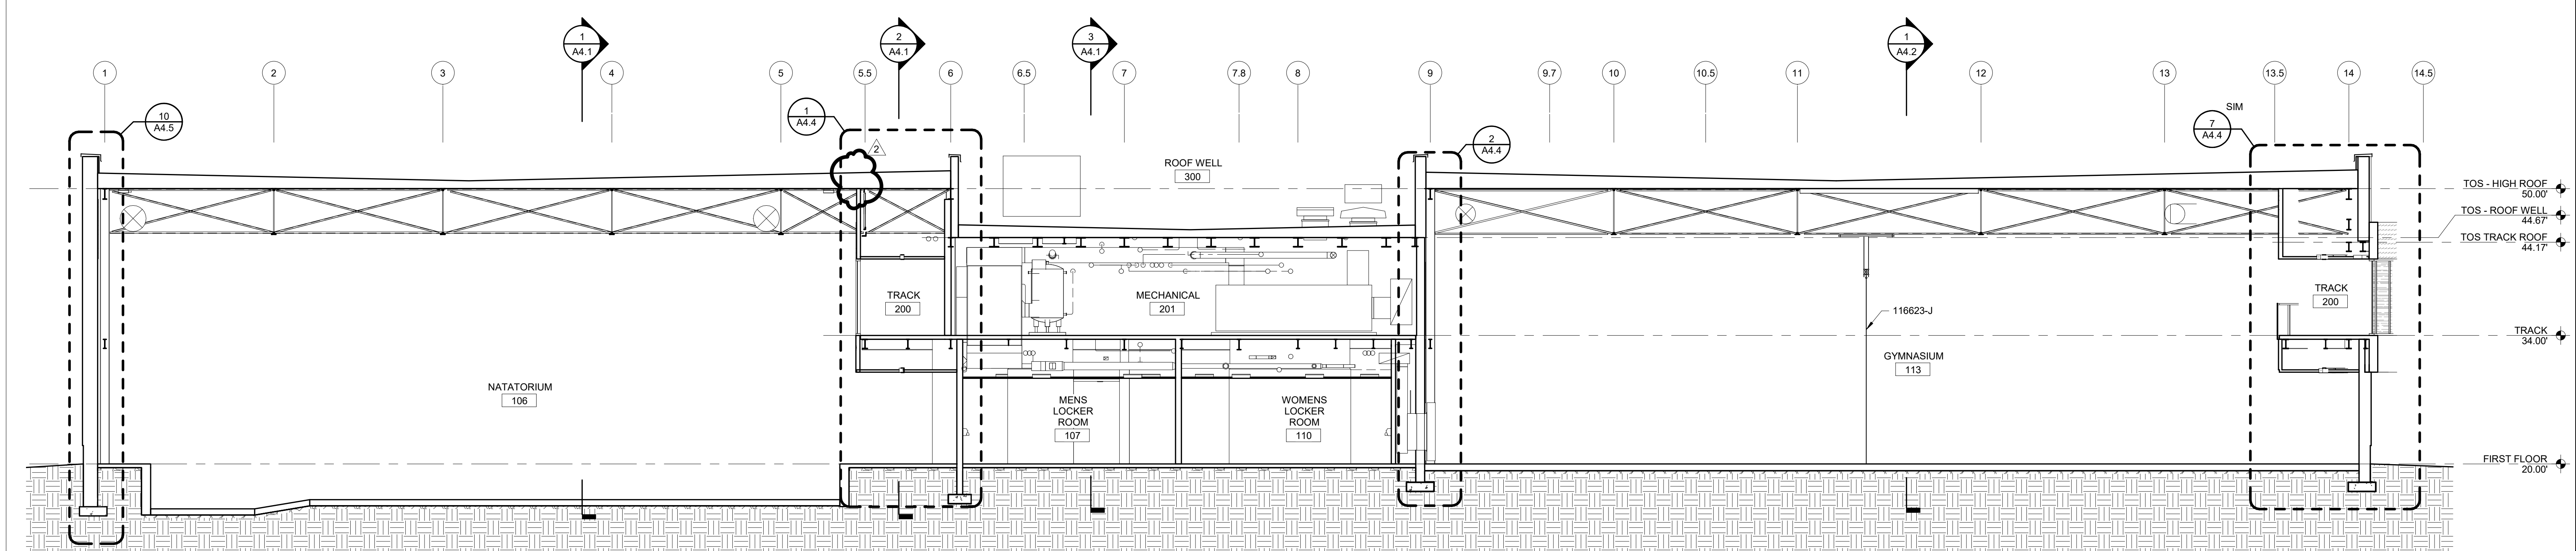


2 BUILDING SECTION
 1/8" = 1'-0"
 FROM 1 / A1.1

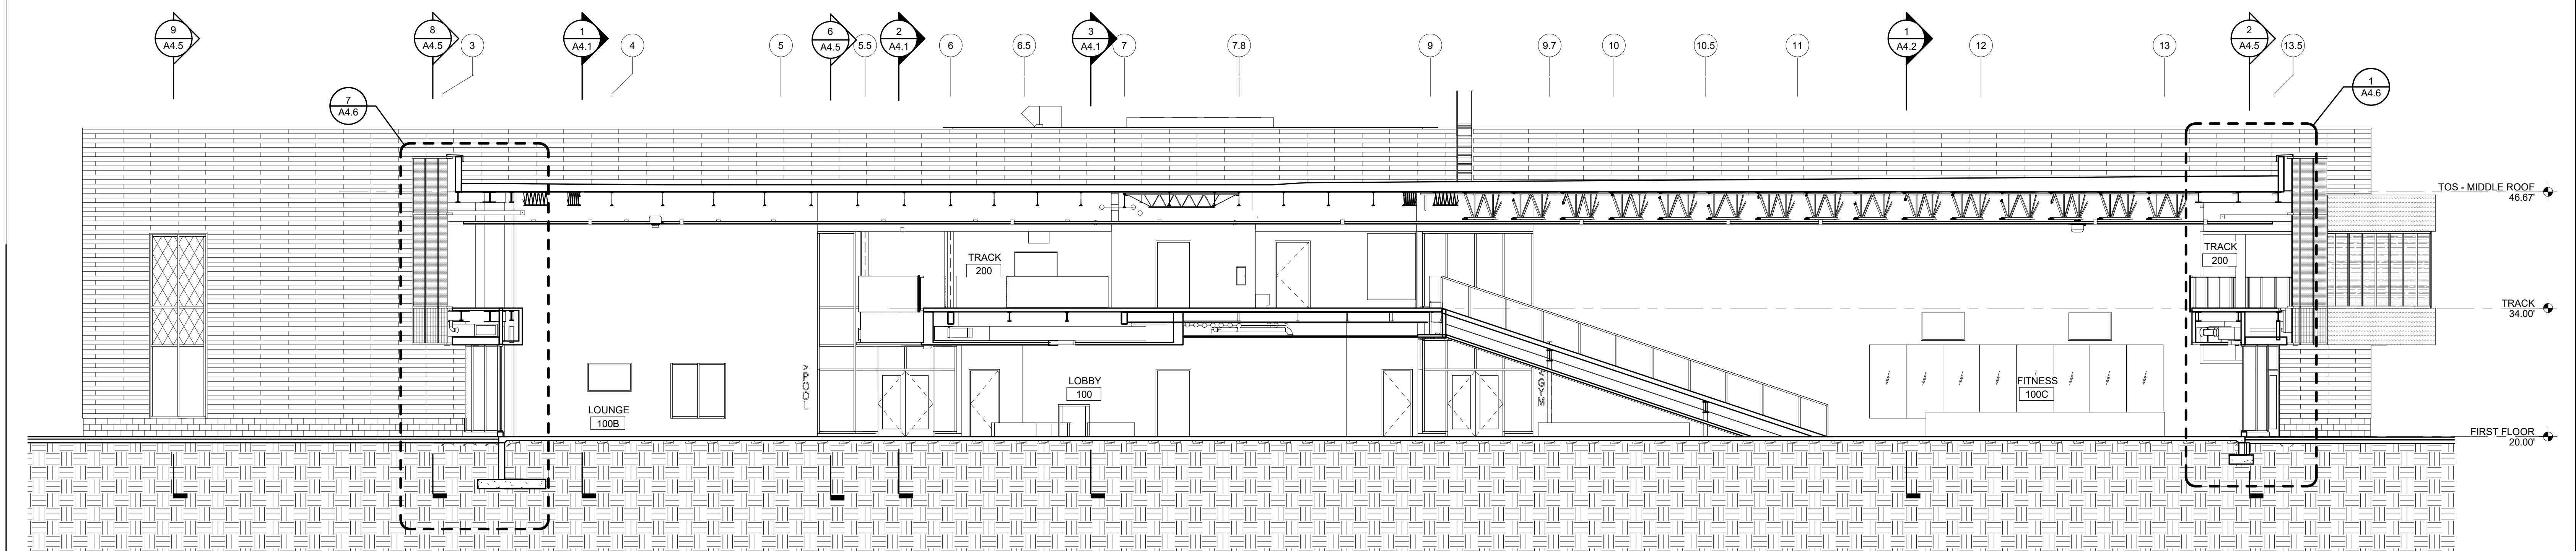

3 BUILDING SECTION
 1/8" = 1'-0"
 FROM 1 / A1.1

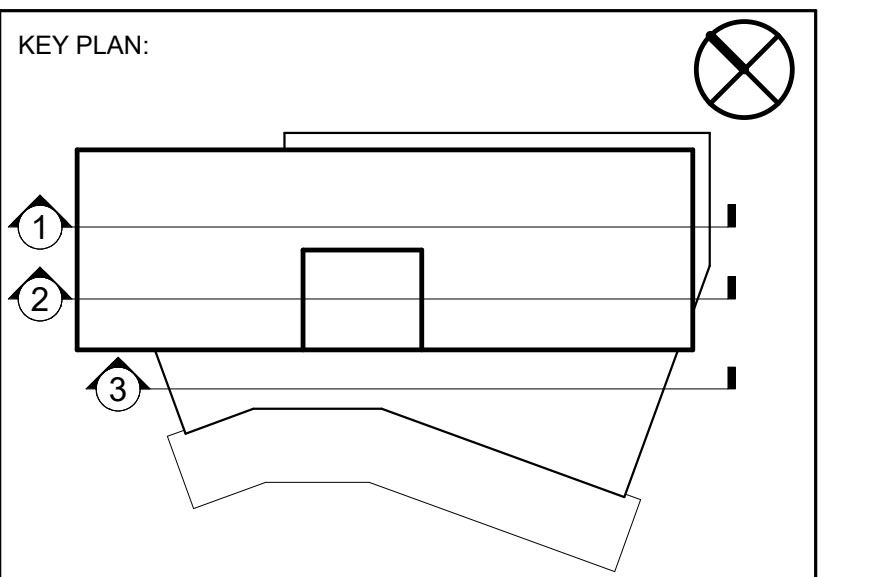

KEYNOTES LISTED ON THIS SHEET ARE FOR CONVENIENCE ONLY. REFER TO SHEET CS.2 FOR COMPLETE LIST
 116623-J GYMNASIUM DIVIDER CURTAIN, ALTERNATE NO.5

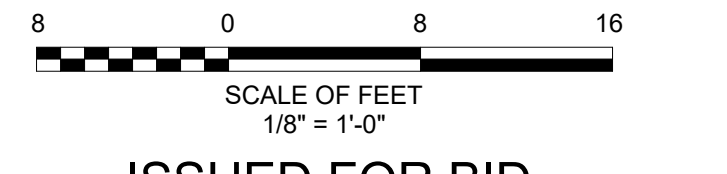

ISSUED FOR BID

Seal: _____
 Seal: _____

G|W|O
GW INC.
 800 WYMAN PARK DRIVE, SUITE 300
 BALTIMORE, MARYLAND 21211, 410-352-1909
 © 2019 GWWO INC.

I CERTIFY THAT THESE DOCUMENTS WERE PREPARED OR APPROVED BY ME, AND THAT I AM A DULY LICENSED ARCHITECT UNDER THE LAWS OF THE STATE OF MARYLAND. LICENSE NUMBER: 8400, EXPIRATION DATE: 12/31/2020.






Revisions:	No.	Date	Description
	2	1/28/2020	ADDENDUM 2

MIDDLE BRANCH FITNESS & WELLNESS CENTER AT CHERRY HILL
 BALTIMORE CITY RECREATION & PARKS

Job No.	#18010	AWM	Drawn
Scale	As indicated	KMS	Checked
Date	12/13/2019	AER	Approved
Drawing Title	BUILDING SECTIONS		
Drawing Number	A4.3r2		

Sheet _____ Of _____

1/24/2020 3:50:01 PM C:\Autodesk\Local Files\18010-MBFW-Bid-2019-1_amcallister@gwwoinc.com.rvt

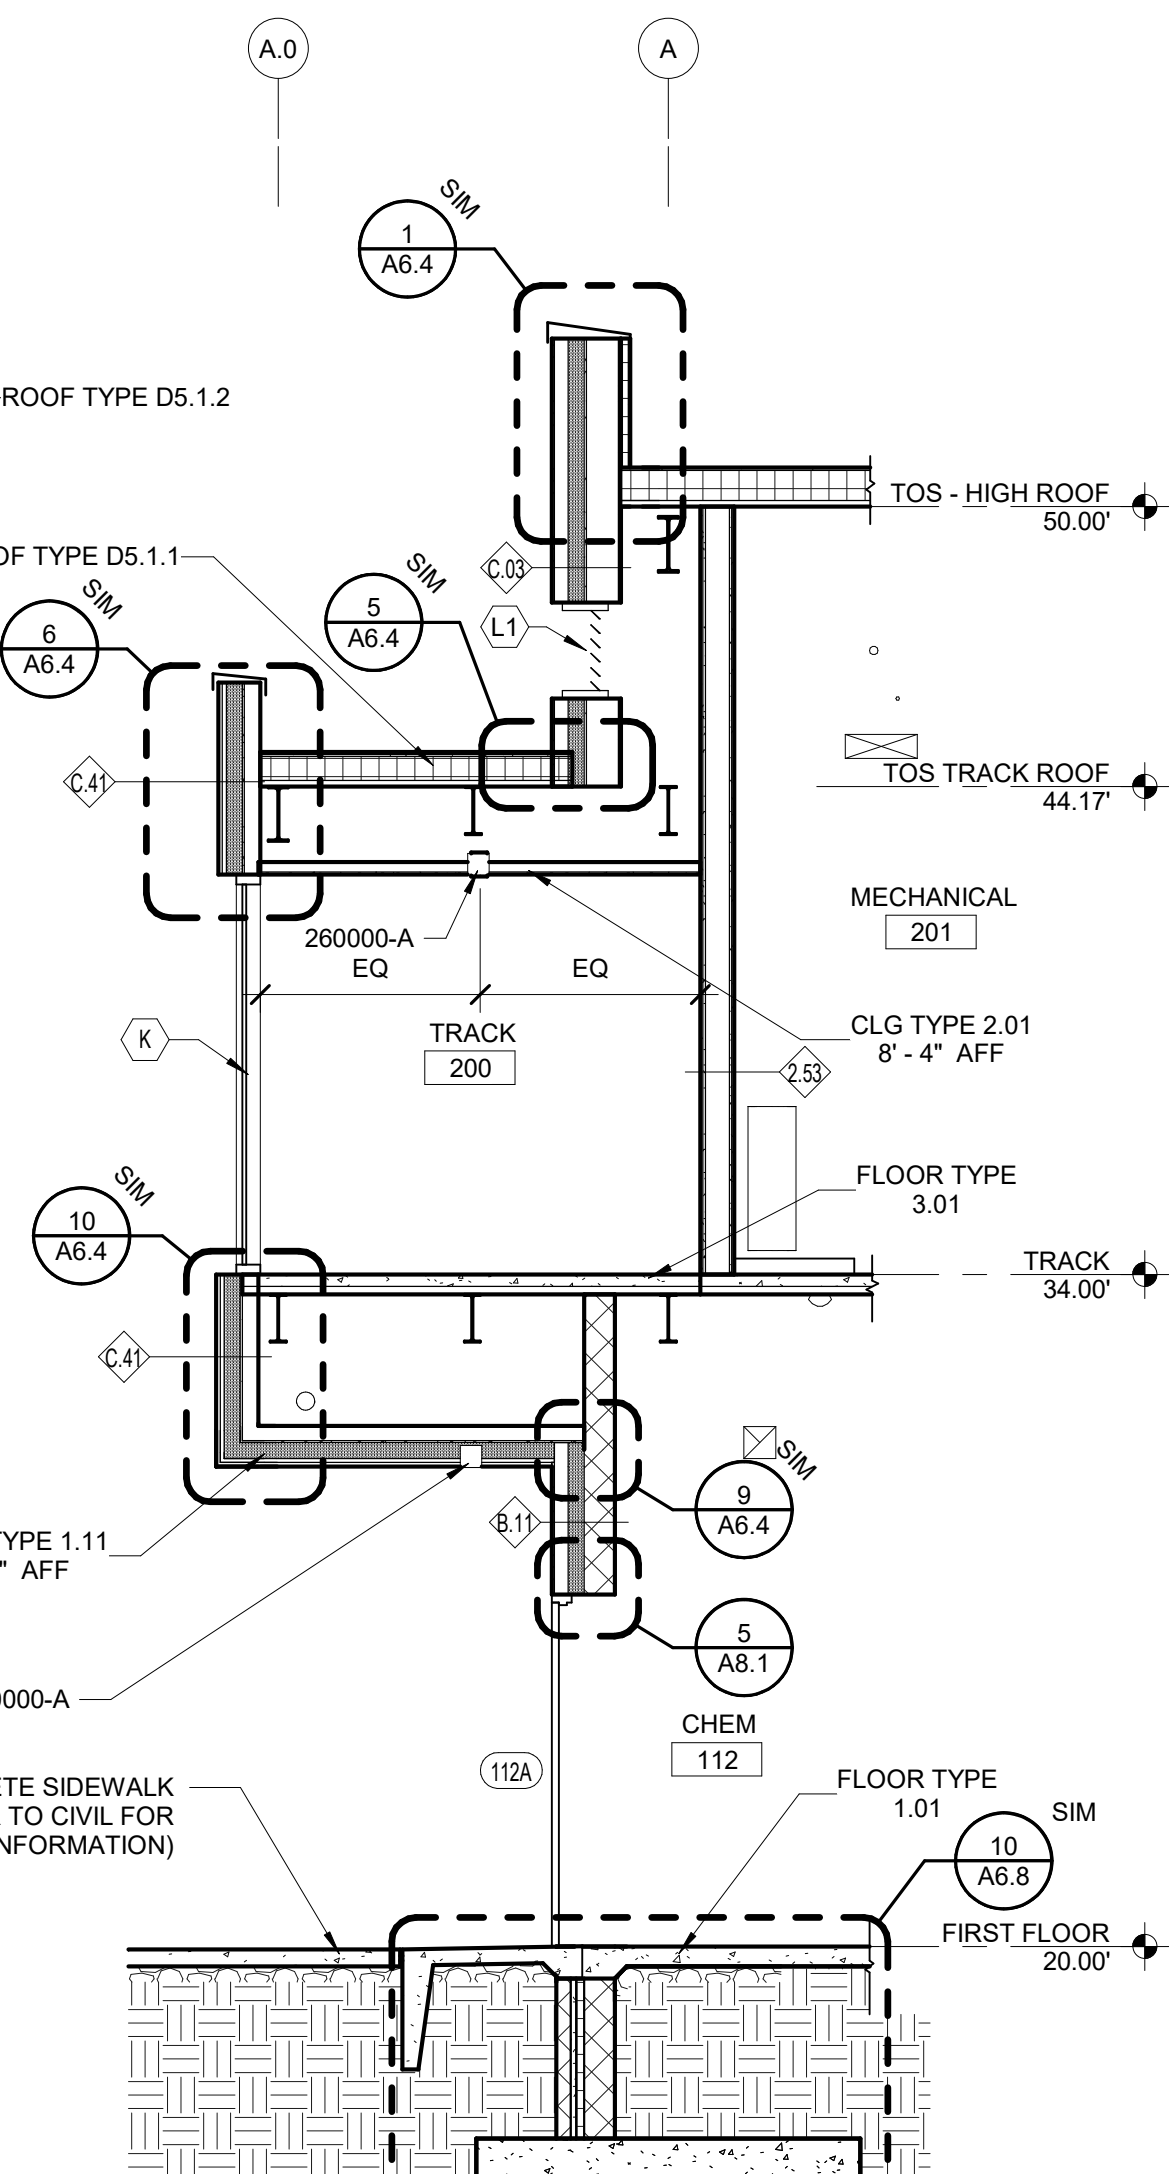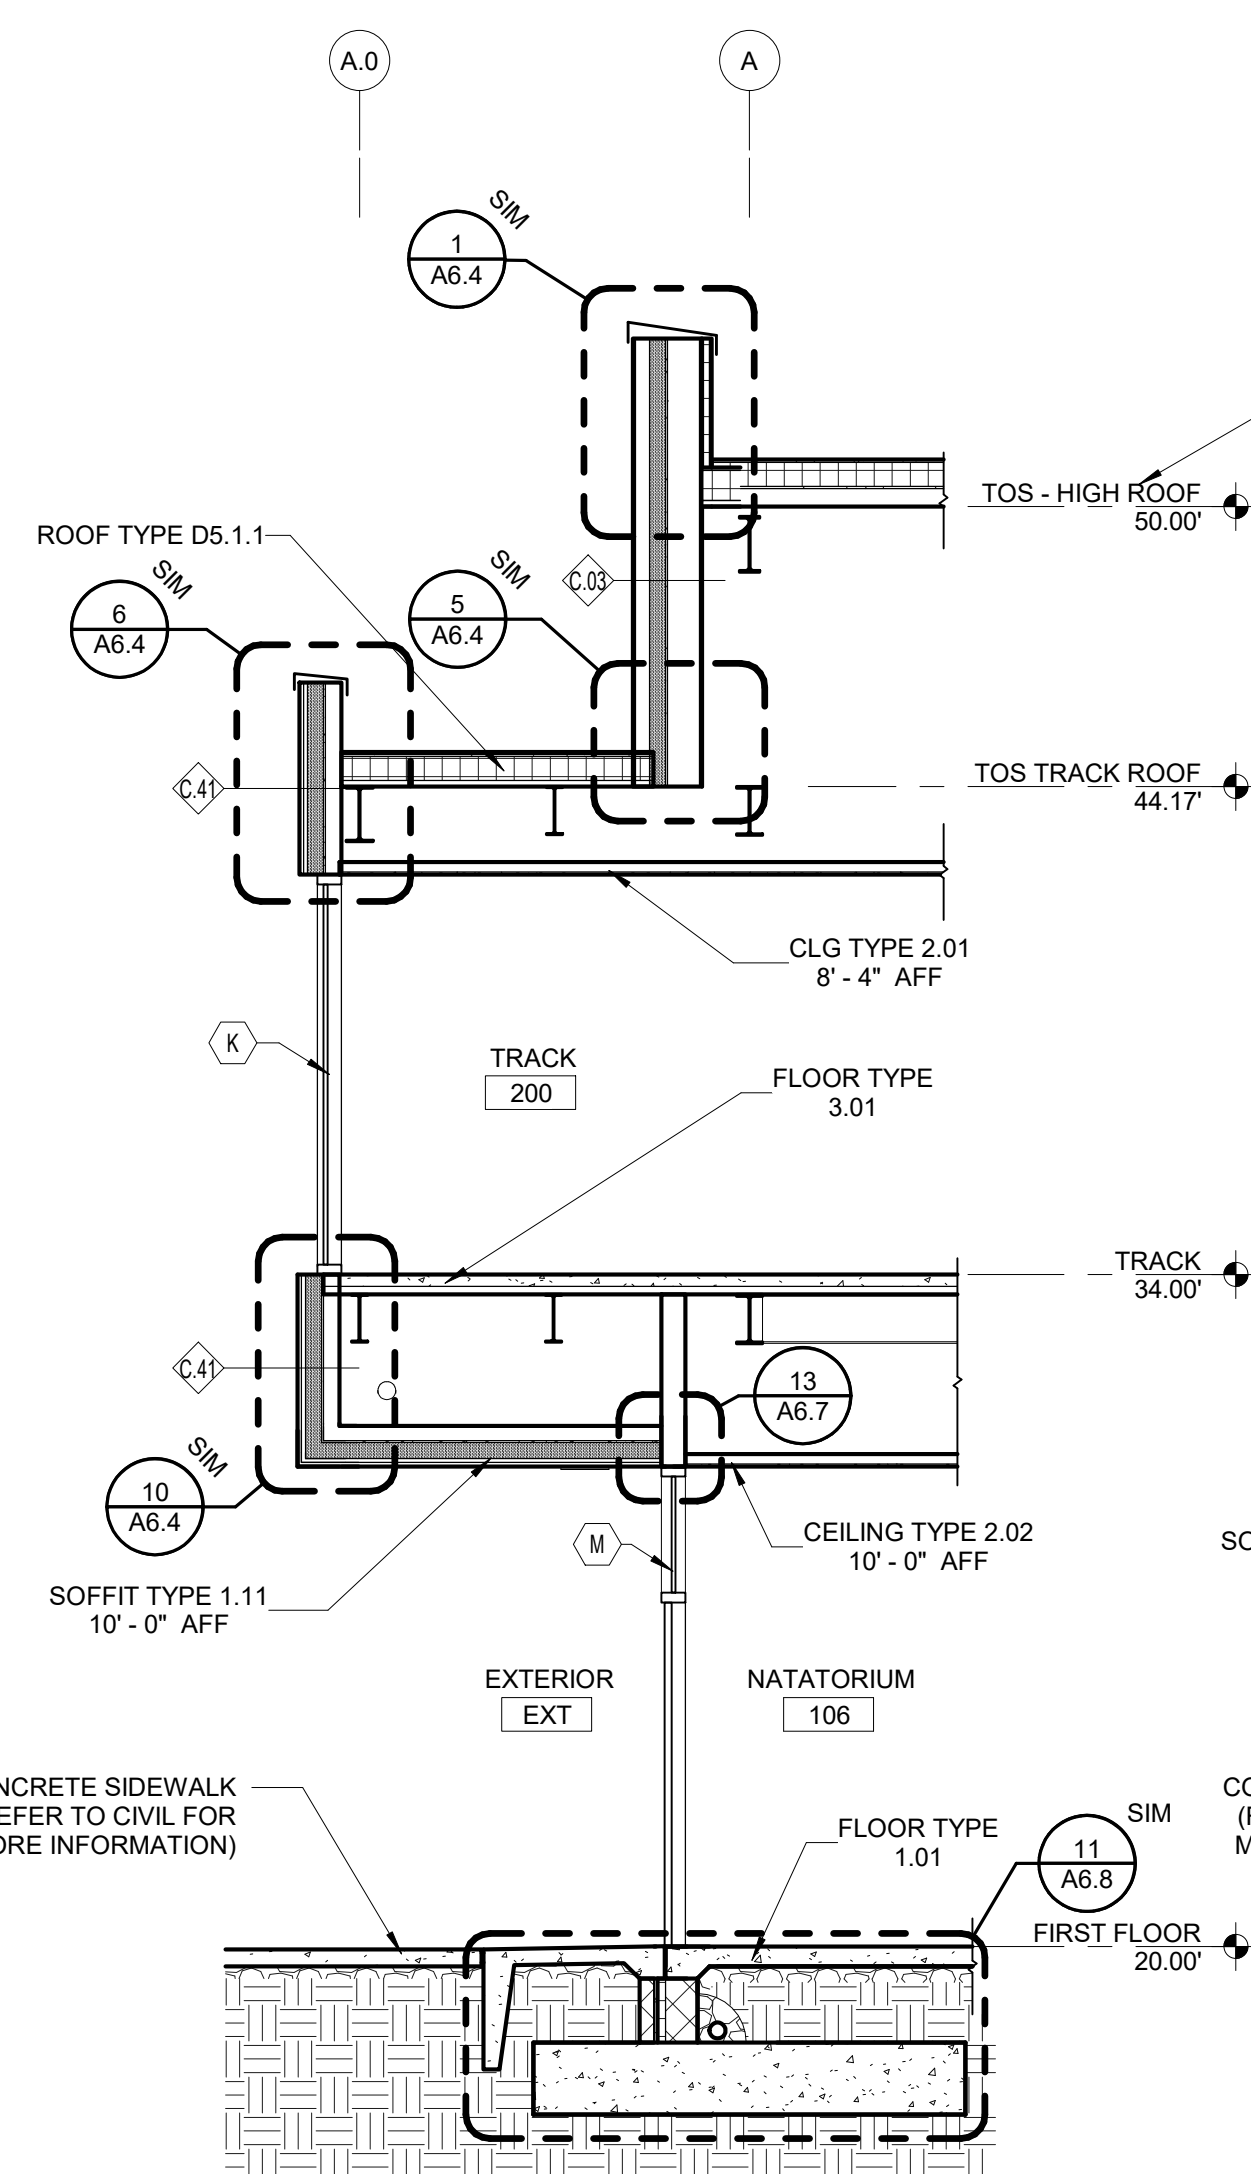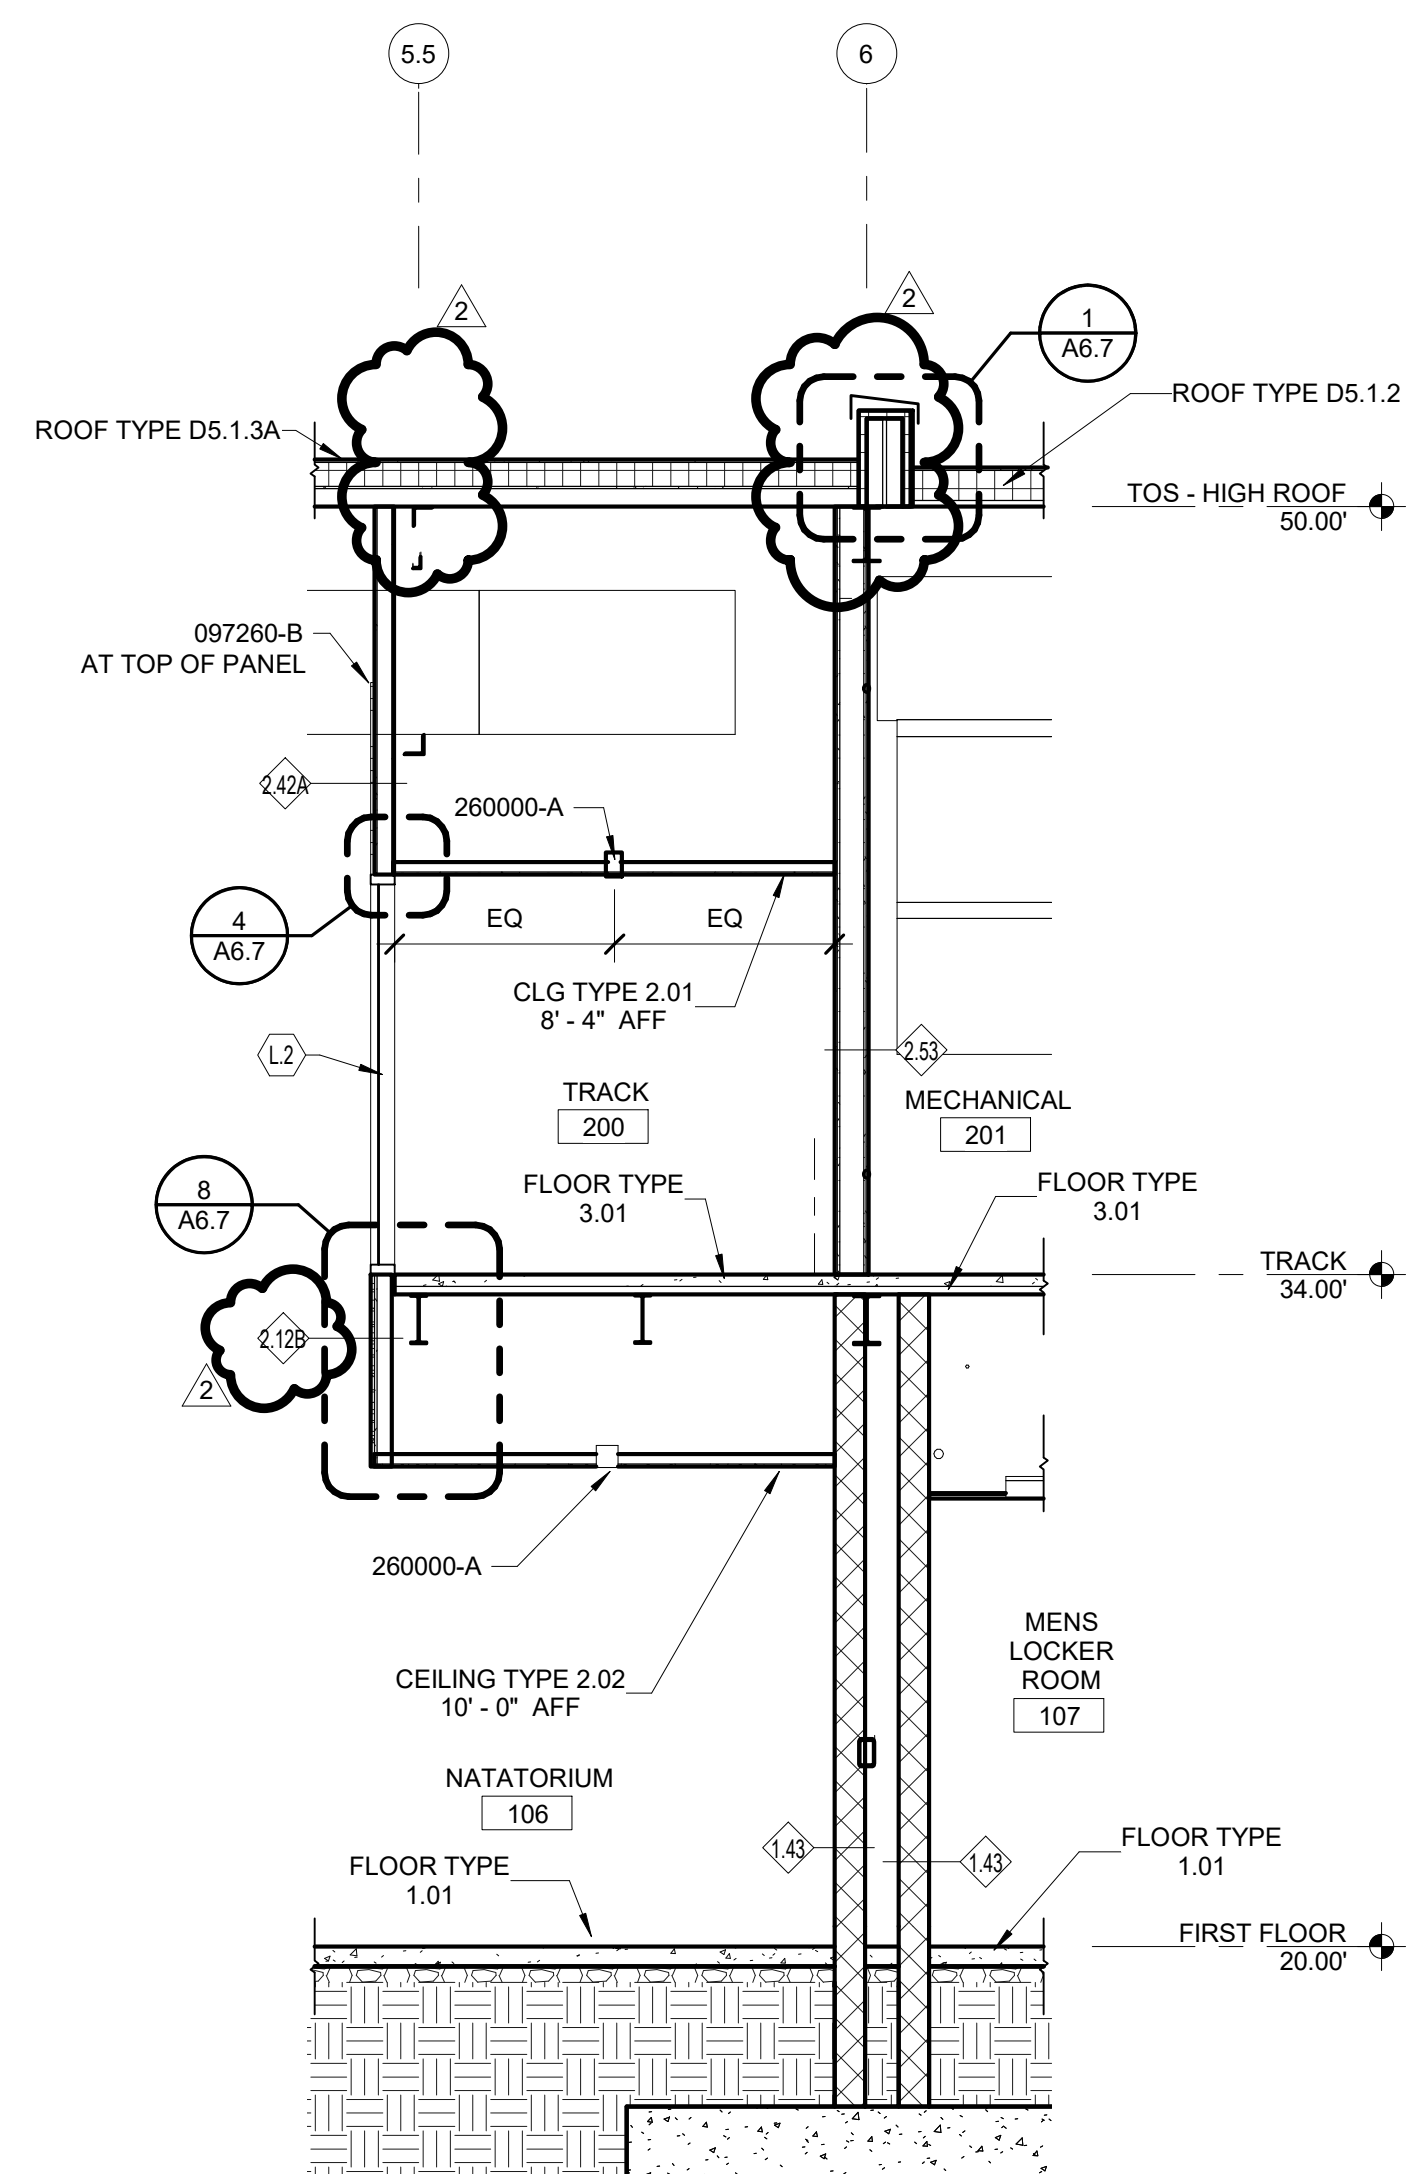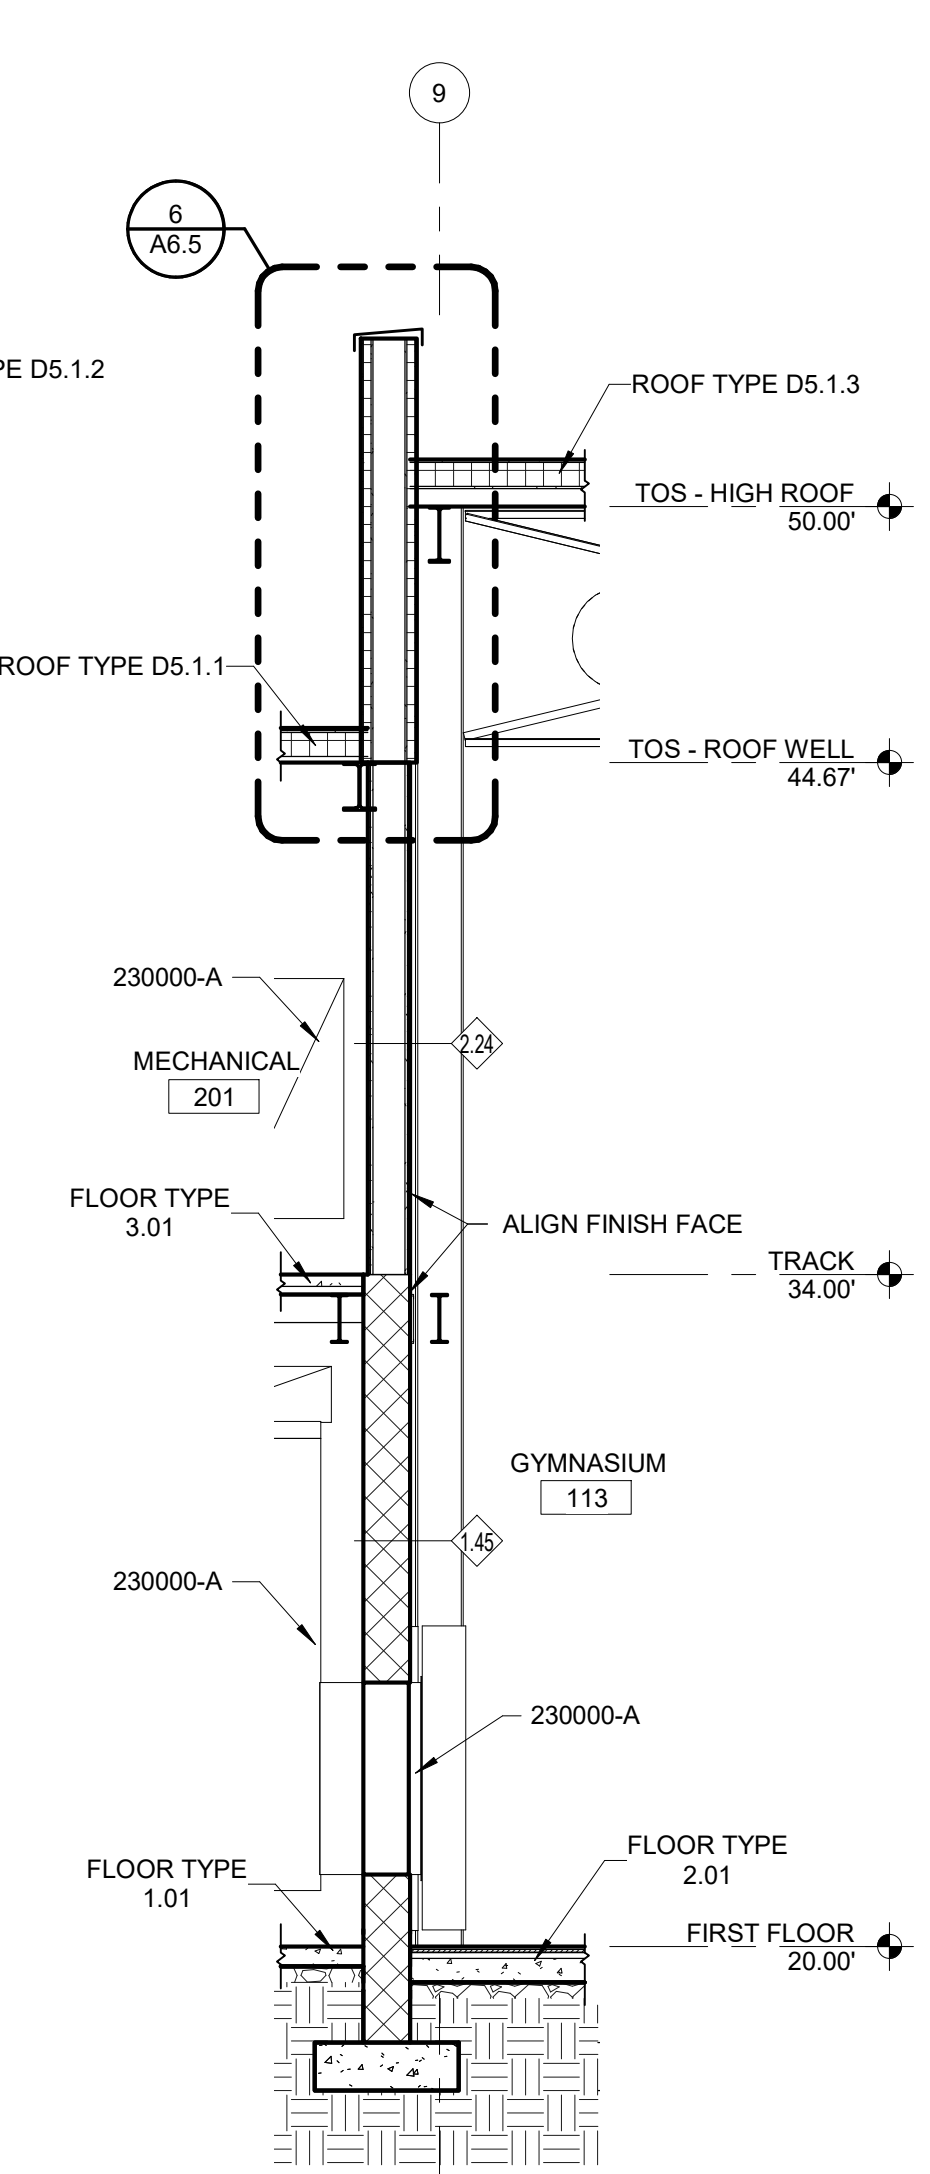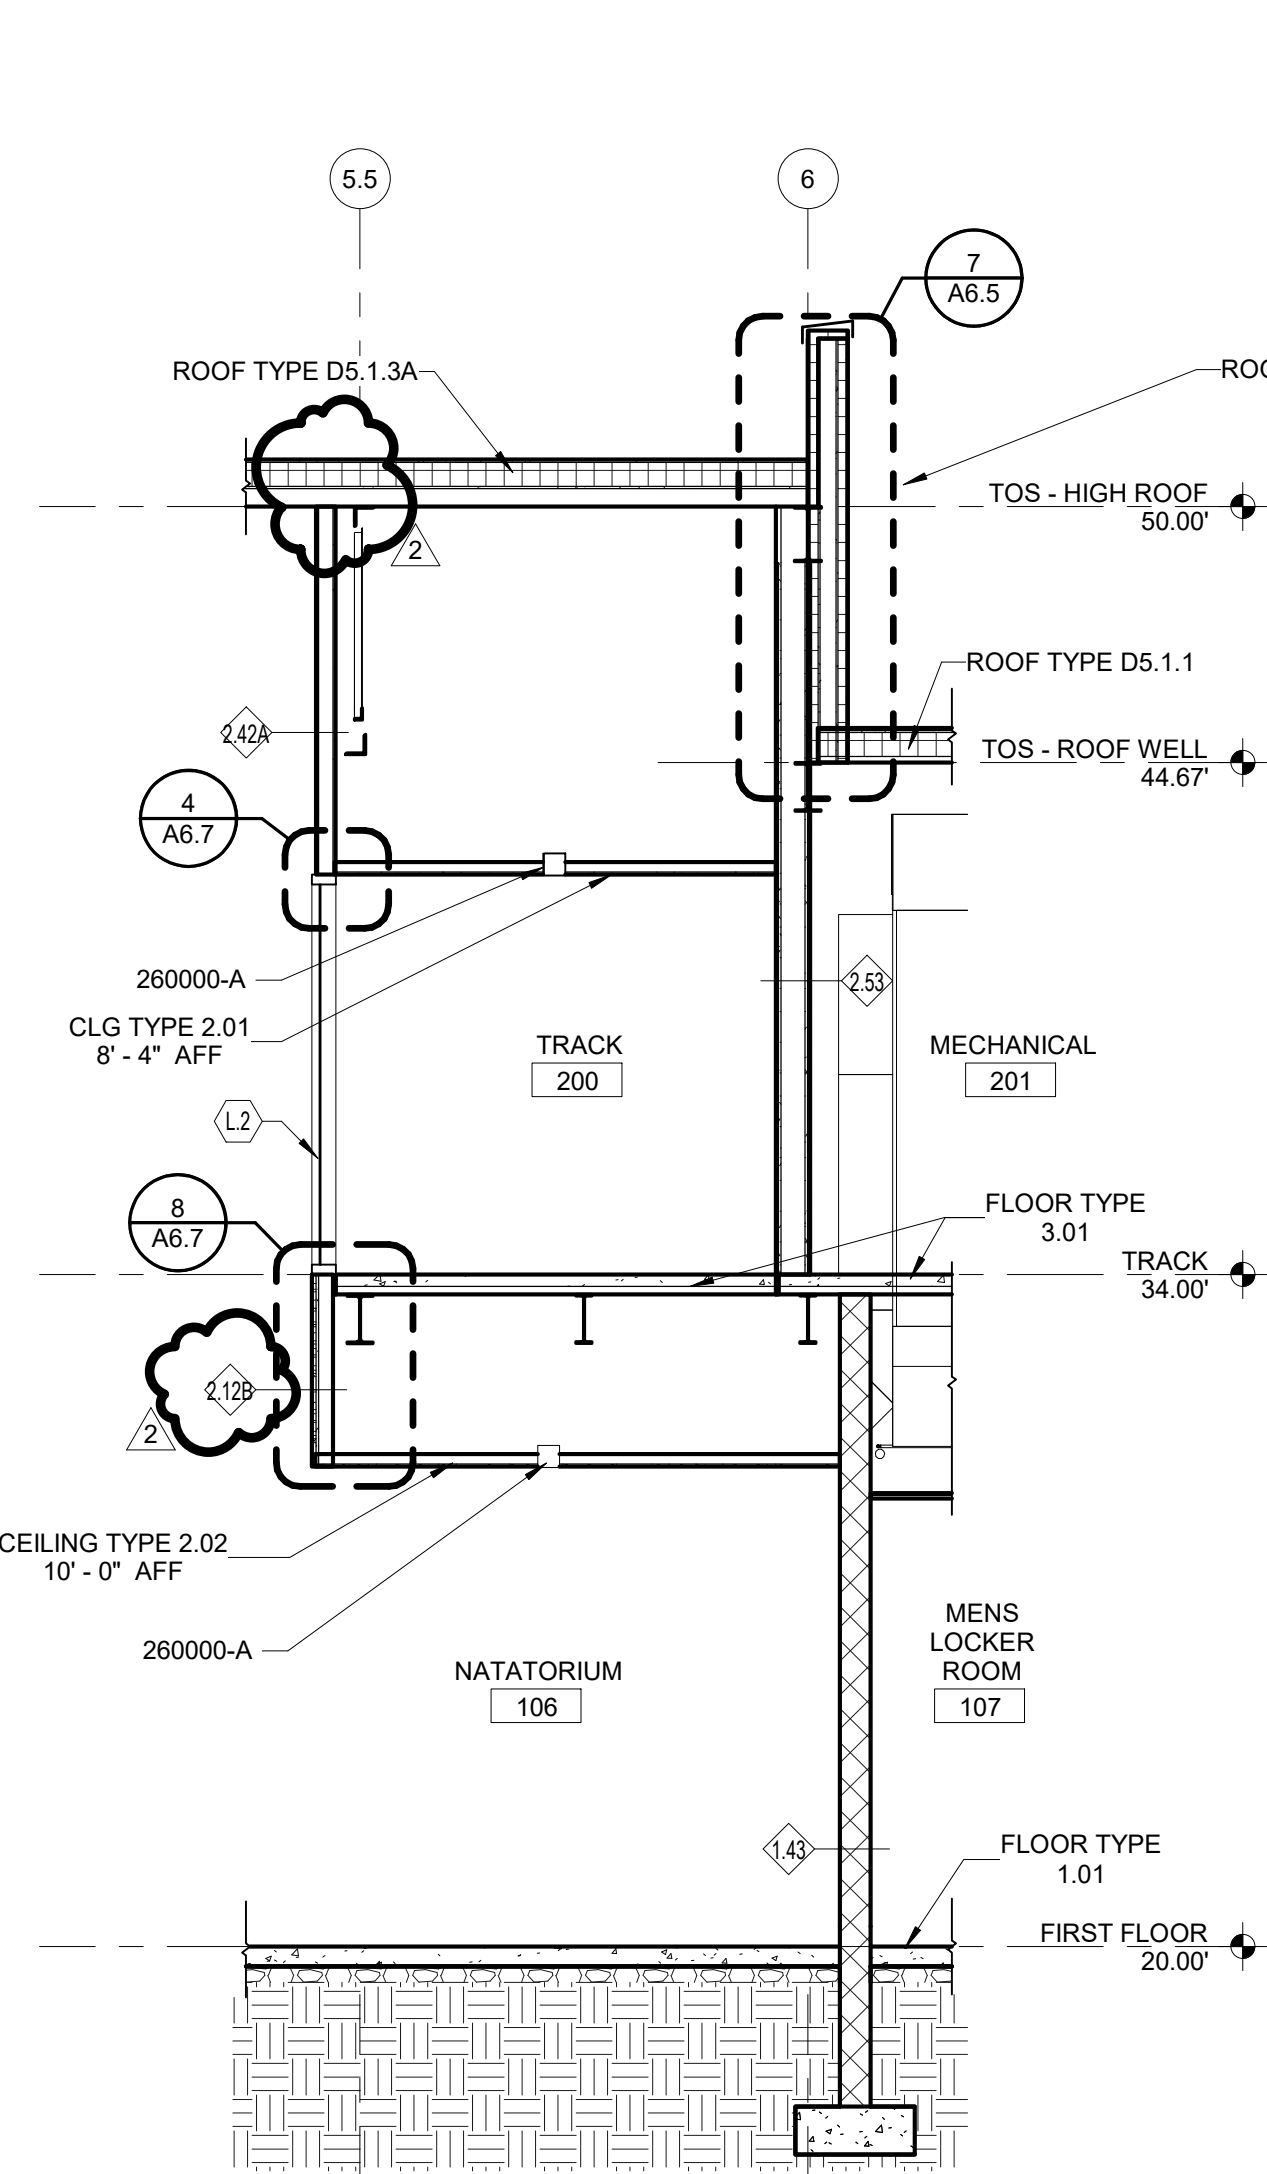





1 WALL SECTION
A4.4 1/4" = 1'-0"
FROM 2 / A4.3

2 WALL SECTION
A4.4 1/4" = 1'-0"
FROM 2 / A4.3

3 WALL SECTION
A4.4 1/4" = 1'-0"
FROM 1 / A4.3

4 WALL SECTION
A4.4 1/4" = 1'-0"
FROM 2 / A4.1

5 WALL SECTION
A4.4 1/4" = 1'-0"
FROM 3 / A4.1

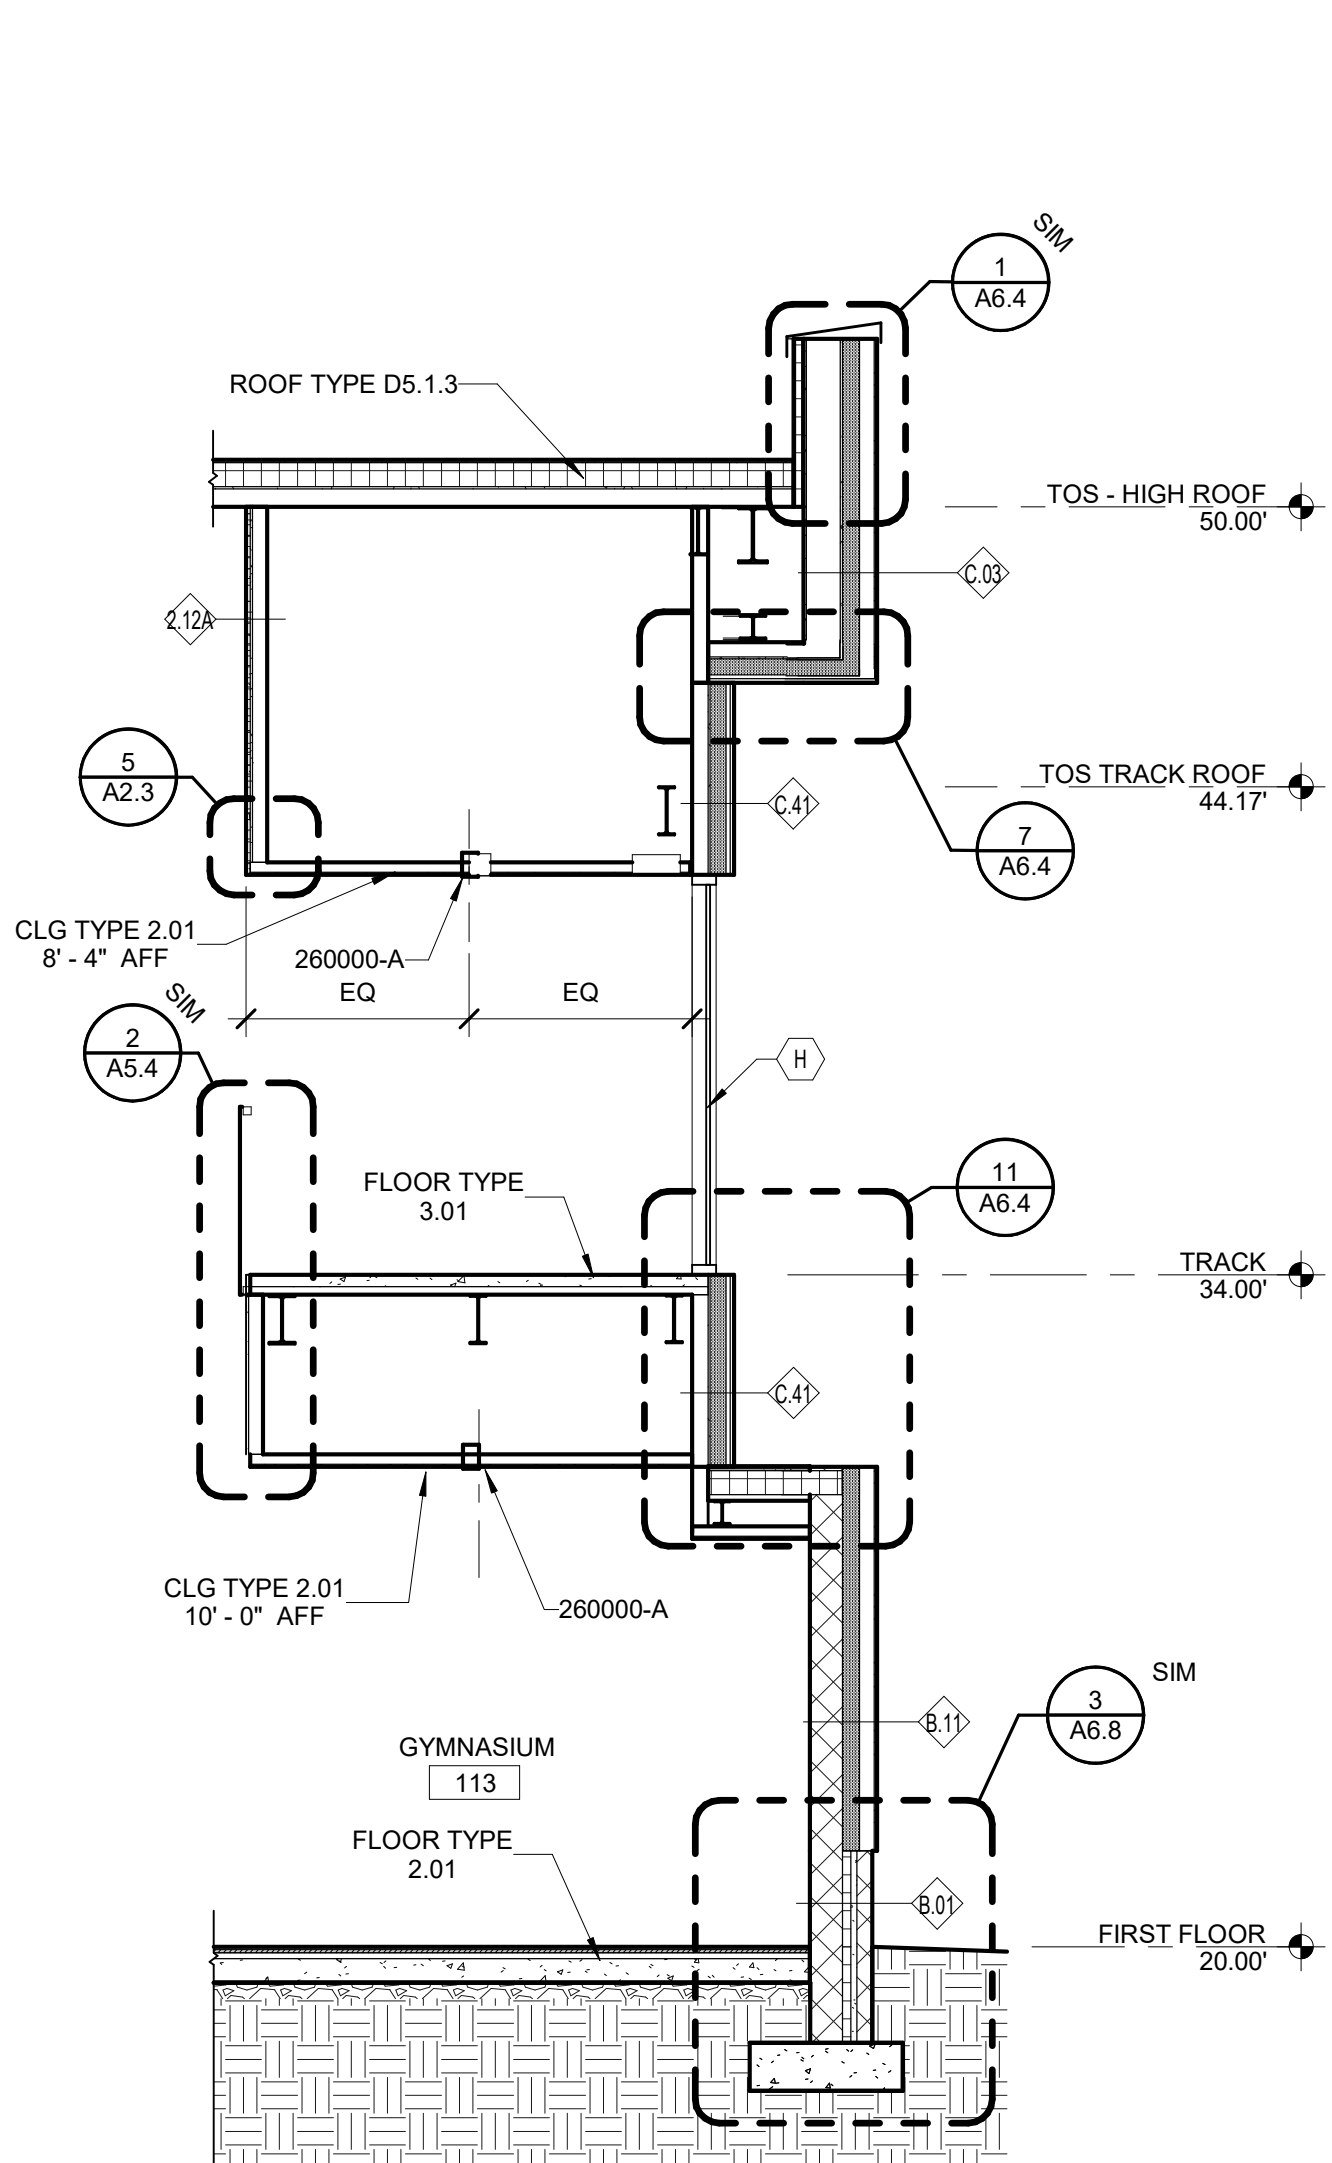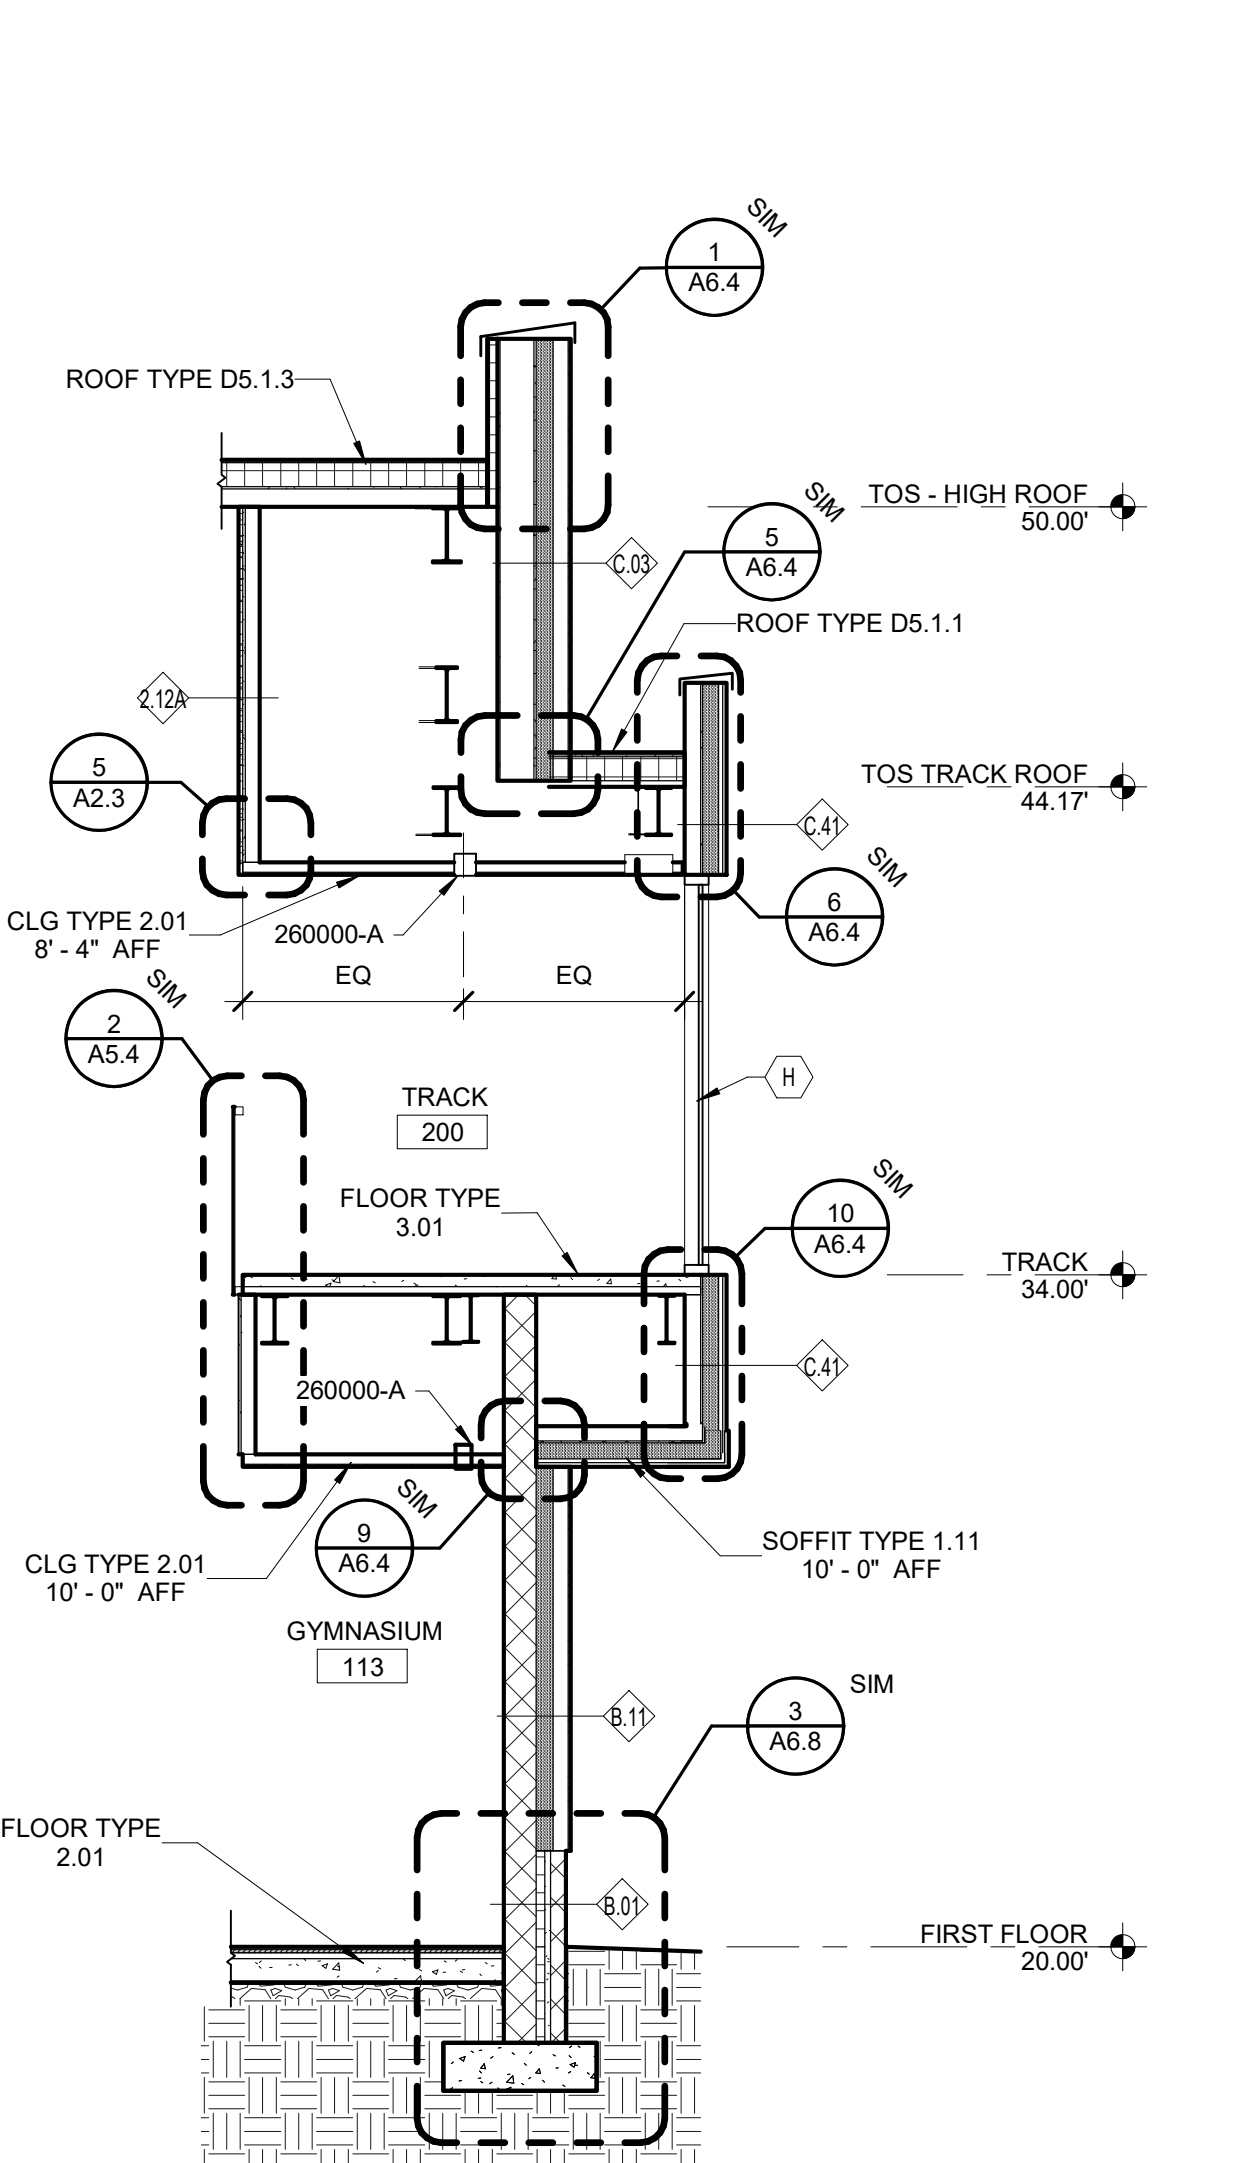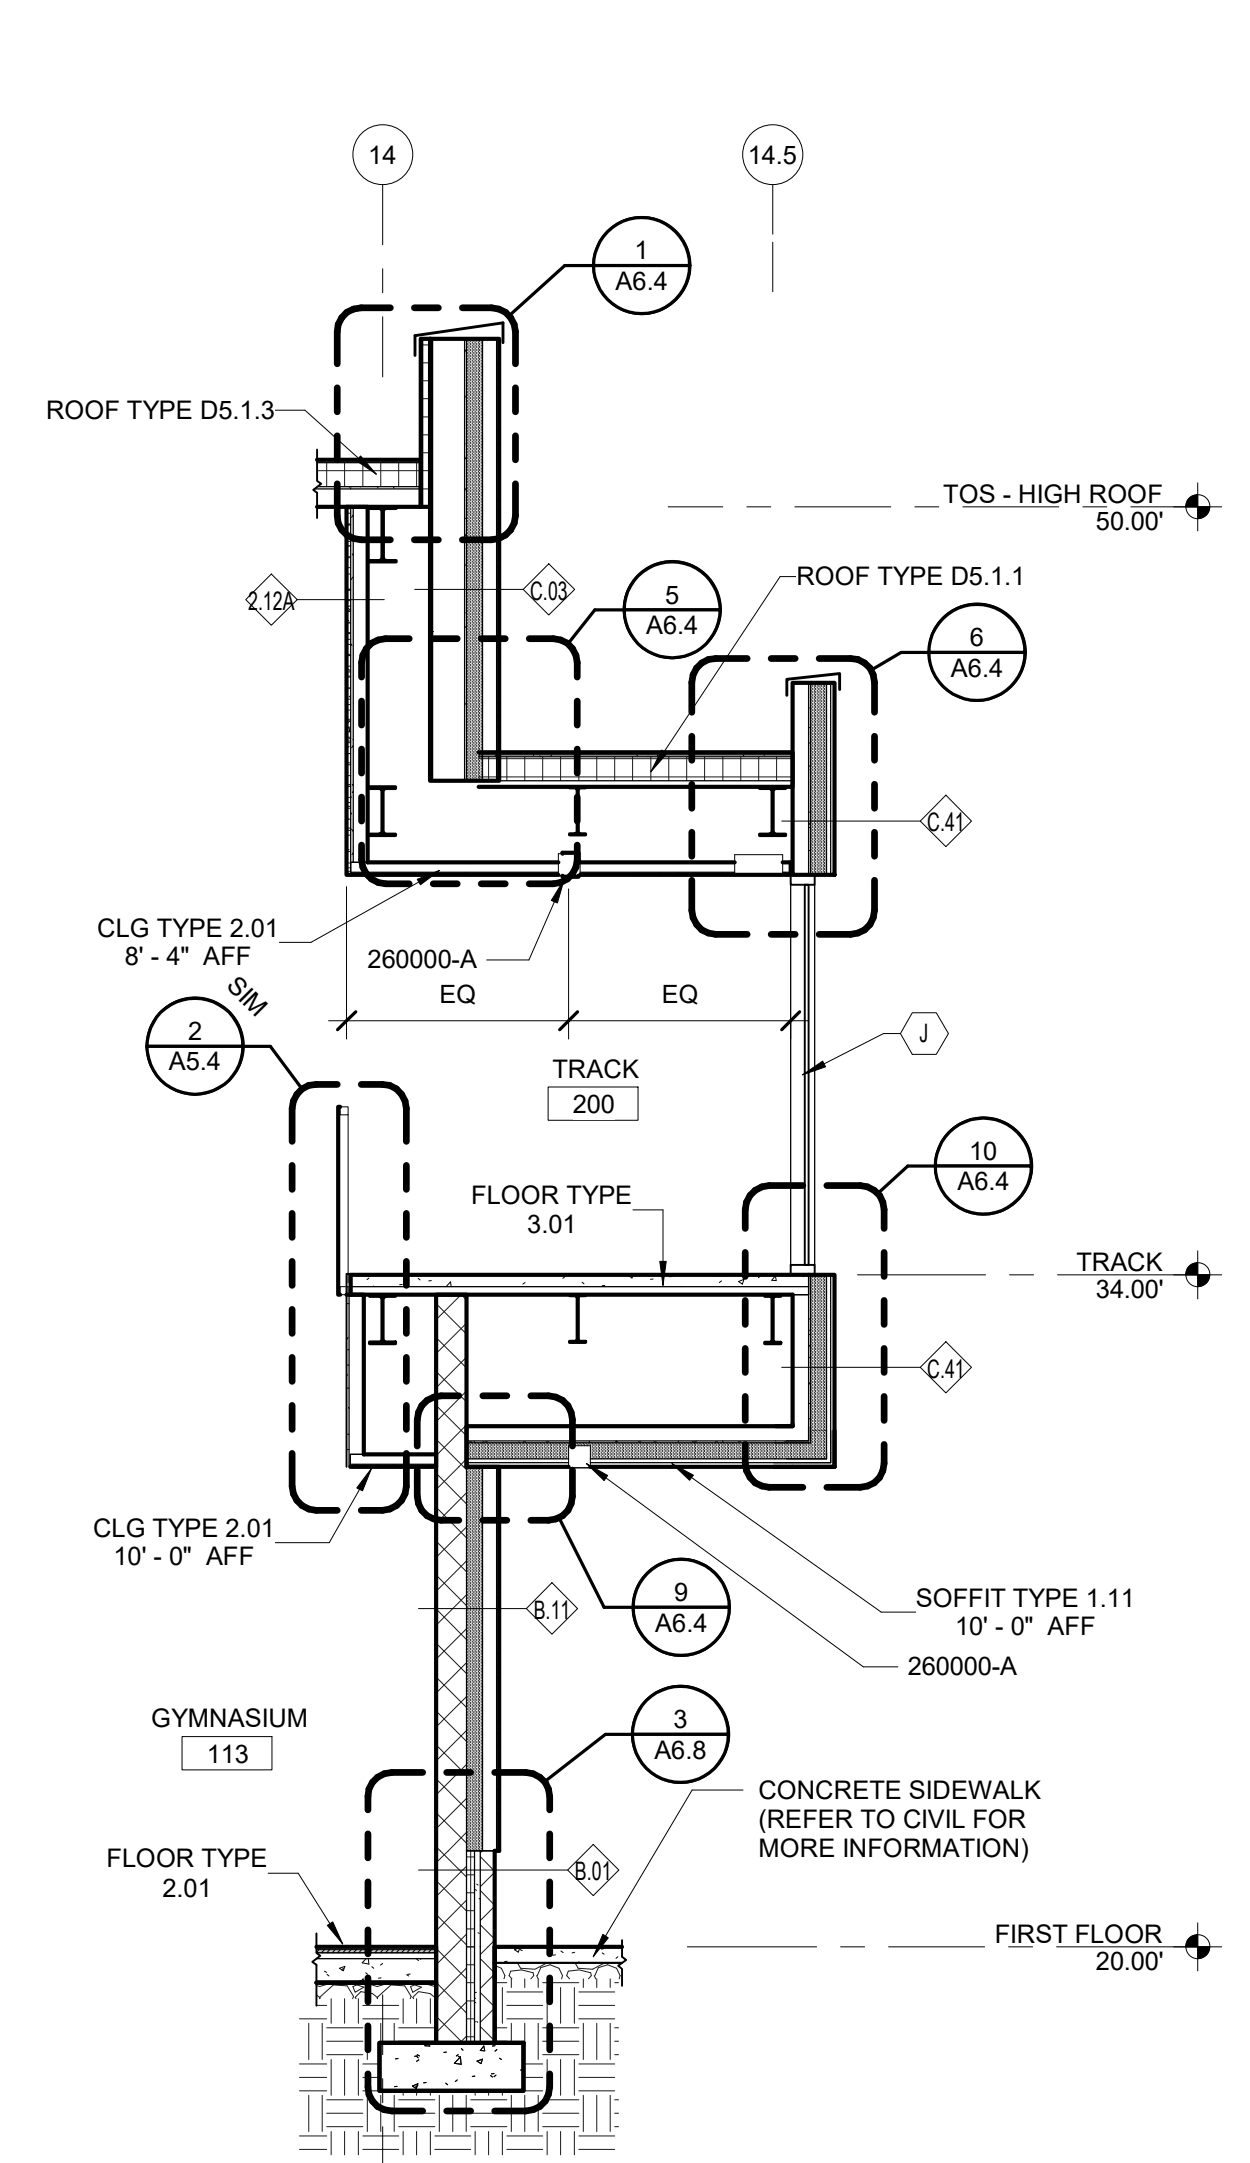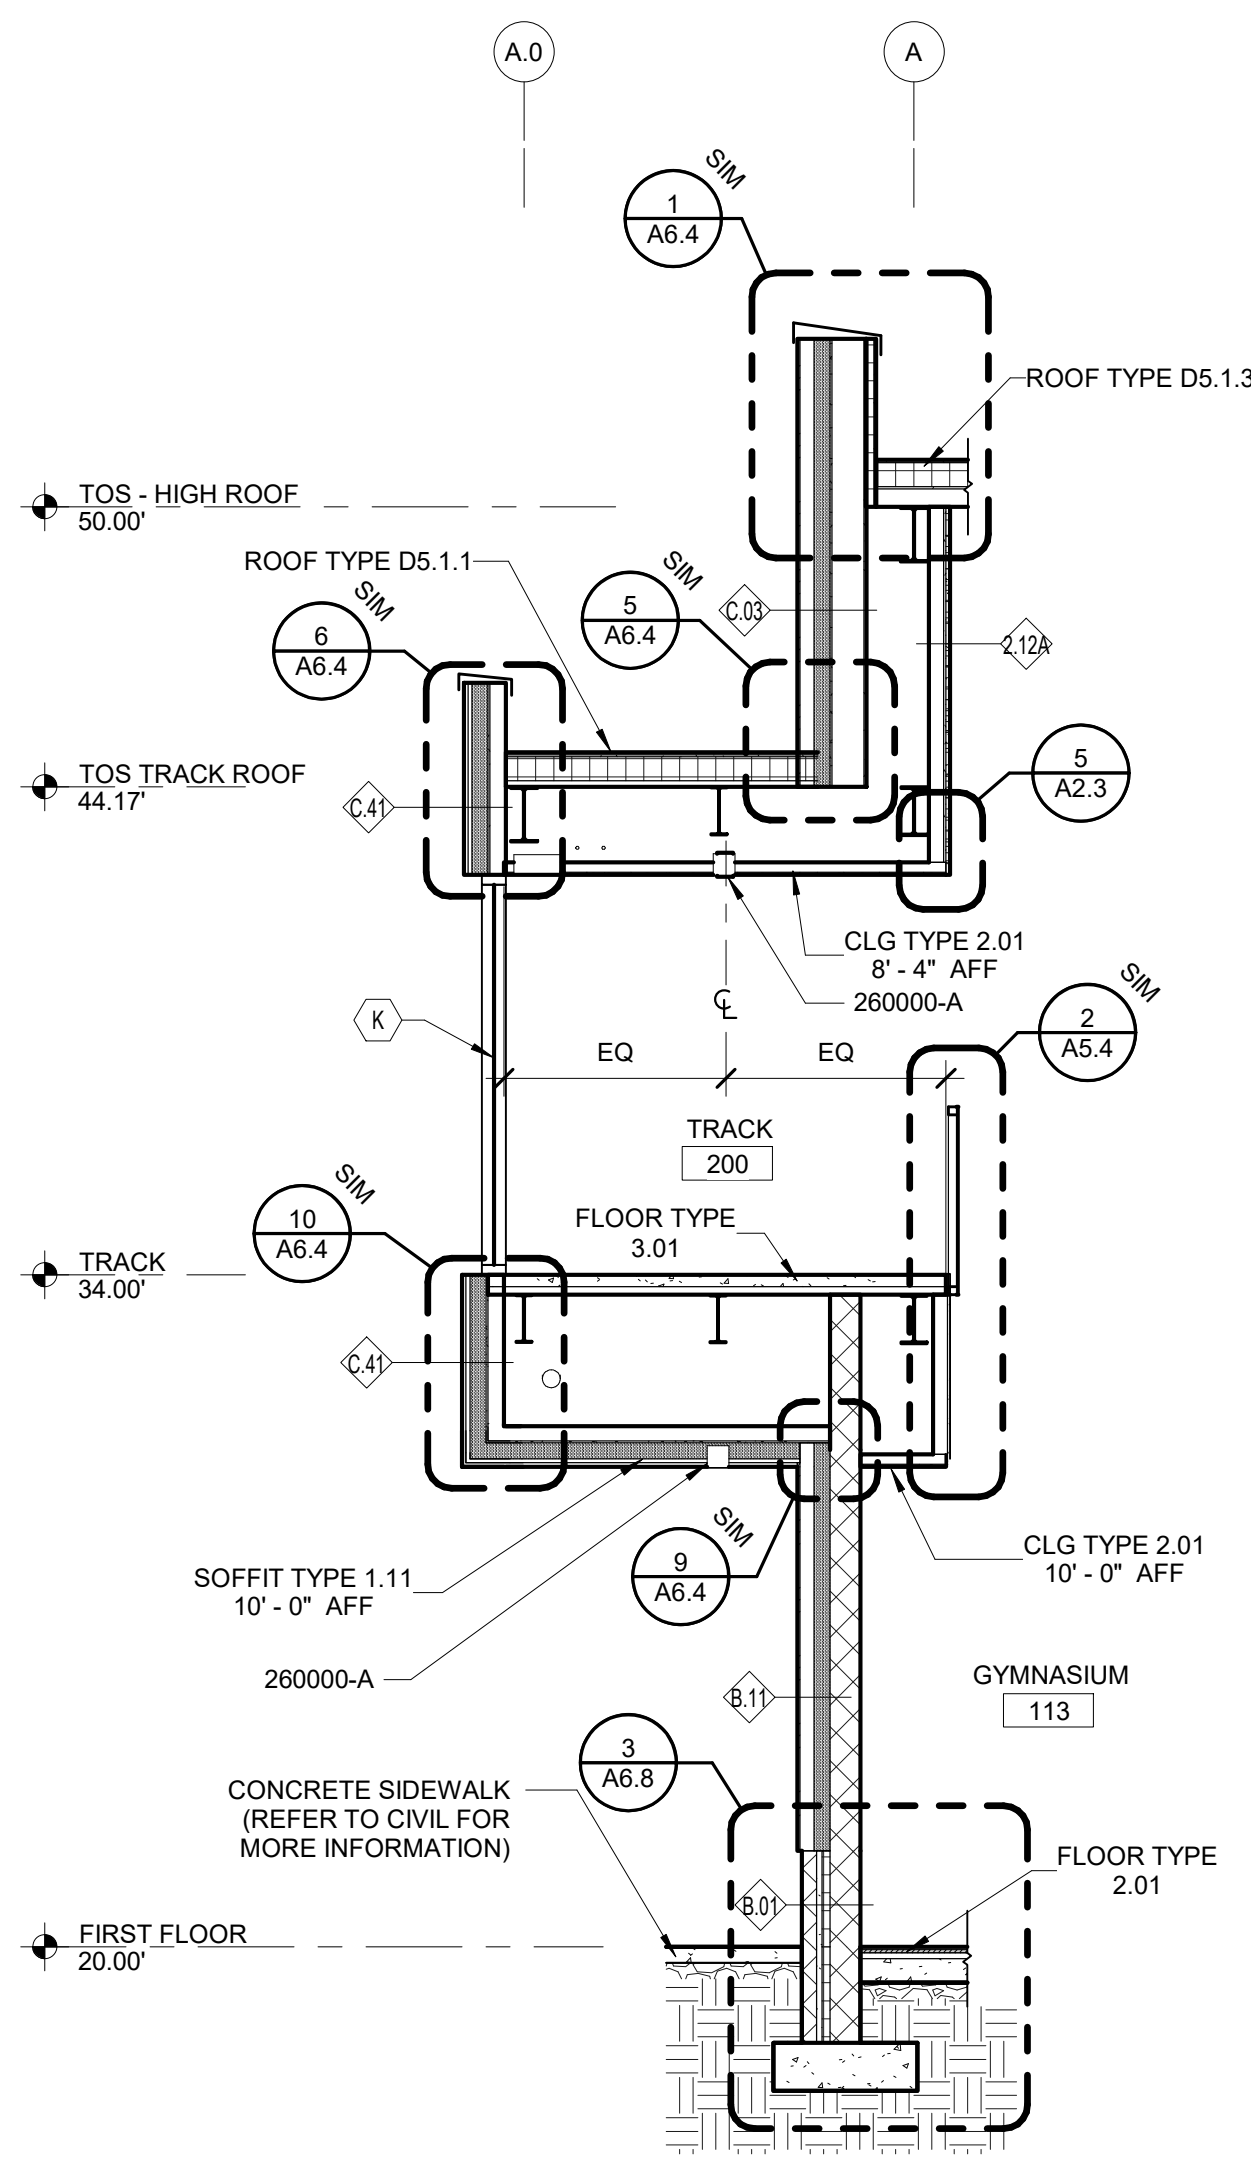


6 WALL SECTION
A4.4 1/4" = 1'-0"
FROM 1 / A4.2

7 WALL SECTION
A4.4 1/4" = 1'-0"
FROM 1 / A4.3


8 WALL SECTION
A4.4 1/4" = 1'-0"
FROM 1 / A1.1

9 WALL SECTION
A4.4 1/4" = 1'-0"
FROM 1 / A1.1

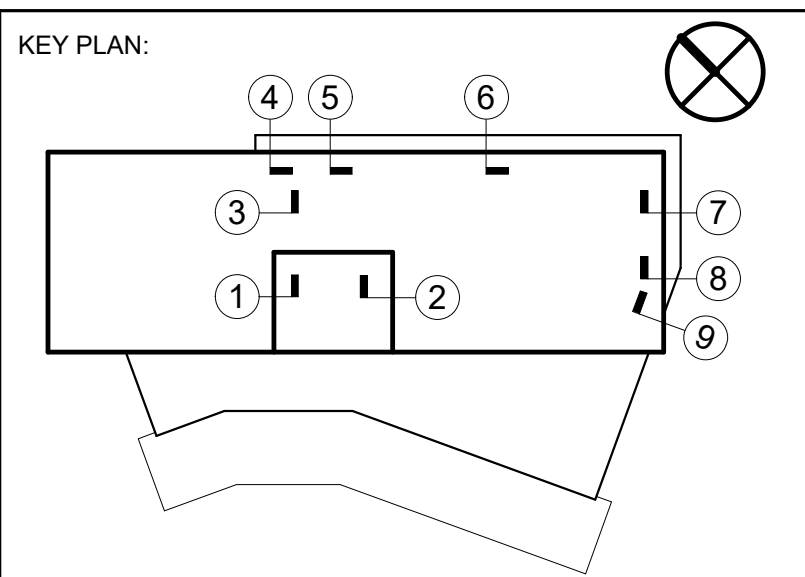

KEYNOTES LISTED ON THIS SHEET ARE FOR CONVENIENCE ONLY. REFER TO SHEET CS.2 FOR COMPLETE LIST

097260-B ALUMINUM TRIM
230000-A MECHANICAL (REFER TO MECHANICAL FOR MORE INFORMATION)
260000-A ELECTRICAL (REFER TO ELECTRICAL FOR MORE INFORMATION)

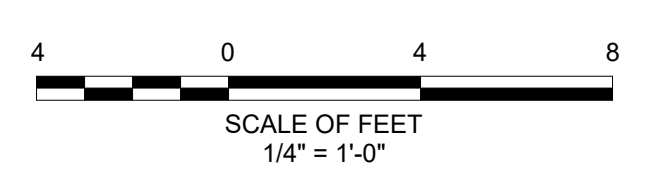

ISSUED FOR BID

Seal: _____



© 2019 GWIO INC.
I CERTIFY THAT THESE DOCUMENTS WERE PREPARED OR APPROVED BY ME, AND THAT I AM A DULY LICENSED ARCHITECT UNDER THE LAWS OF THE STATE OF MARYLAND. LICENSE NUMBER: 8400, EXPIRATION DATE: 12/31/2020

Revisions:	No.	Date	Description
	2	1/28/2020	ADDENDUM 2


MIDDLE BRANCH FITNESS & WELLNESS CENTER AT CHERRY HILL

BALTIMORE CITY RECREATION & PARKS


Job No.	#18010	AWM	Drawn
Scale	As indicated	KMS	Checked
Date	12/13/2019	AER	Approved
Drawing Title	WALL SECTIONS		
Drawing Number	A4.4r2		

Sheet _____


1/24/2020 3:50:07 PM C:\Autodesk\Local Files\18010-MBFW-Bid-2019-1_amcallister@gwinc.com.rvt

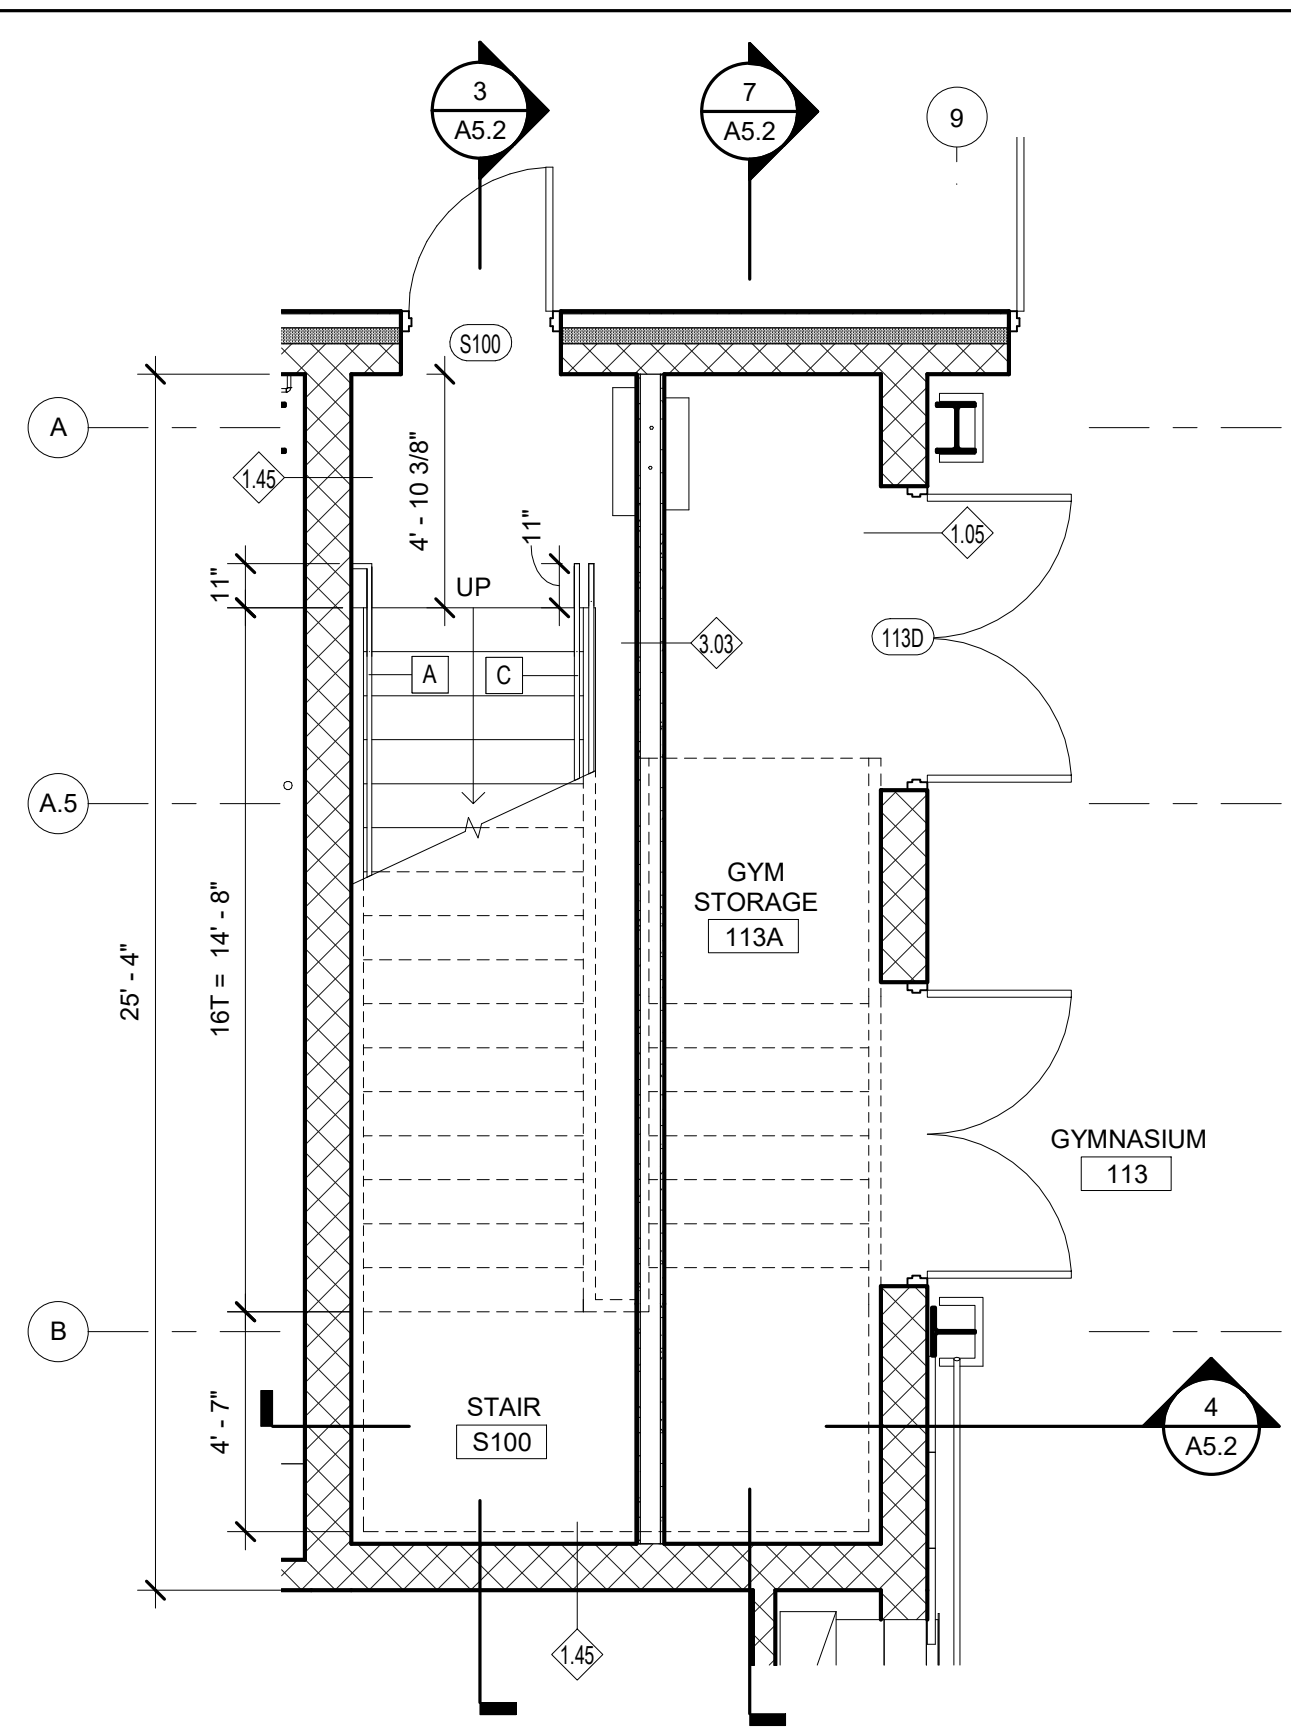


1 STAIR 1 - FIRST FLOOR PLAN
 1/4" = 1'-0"
 FROM 1 / A1.1

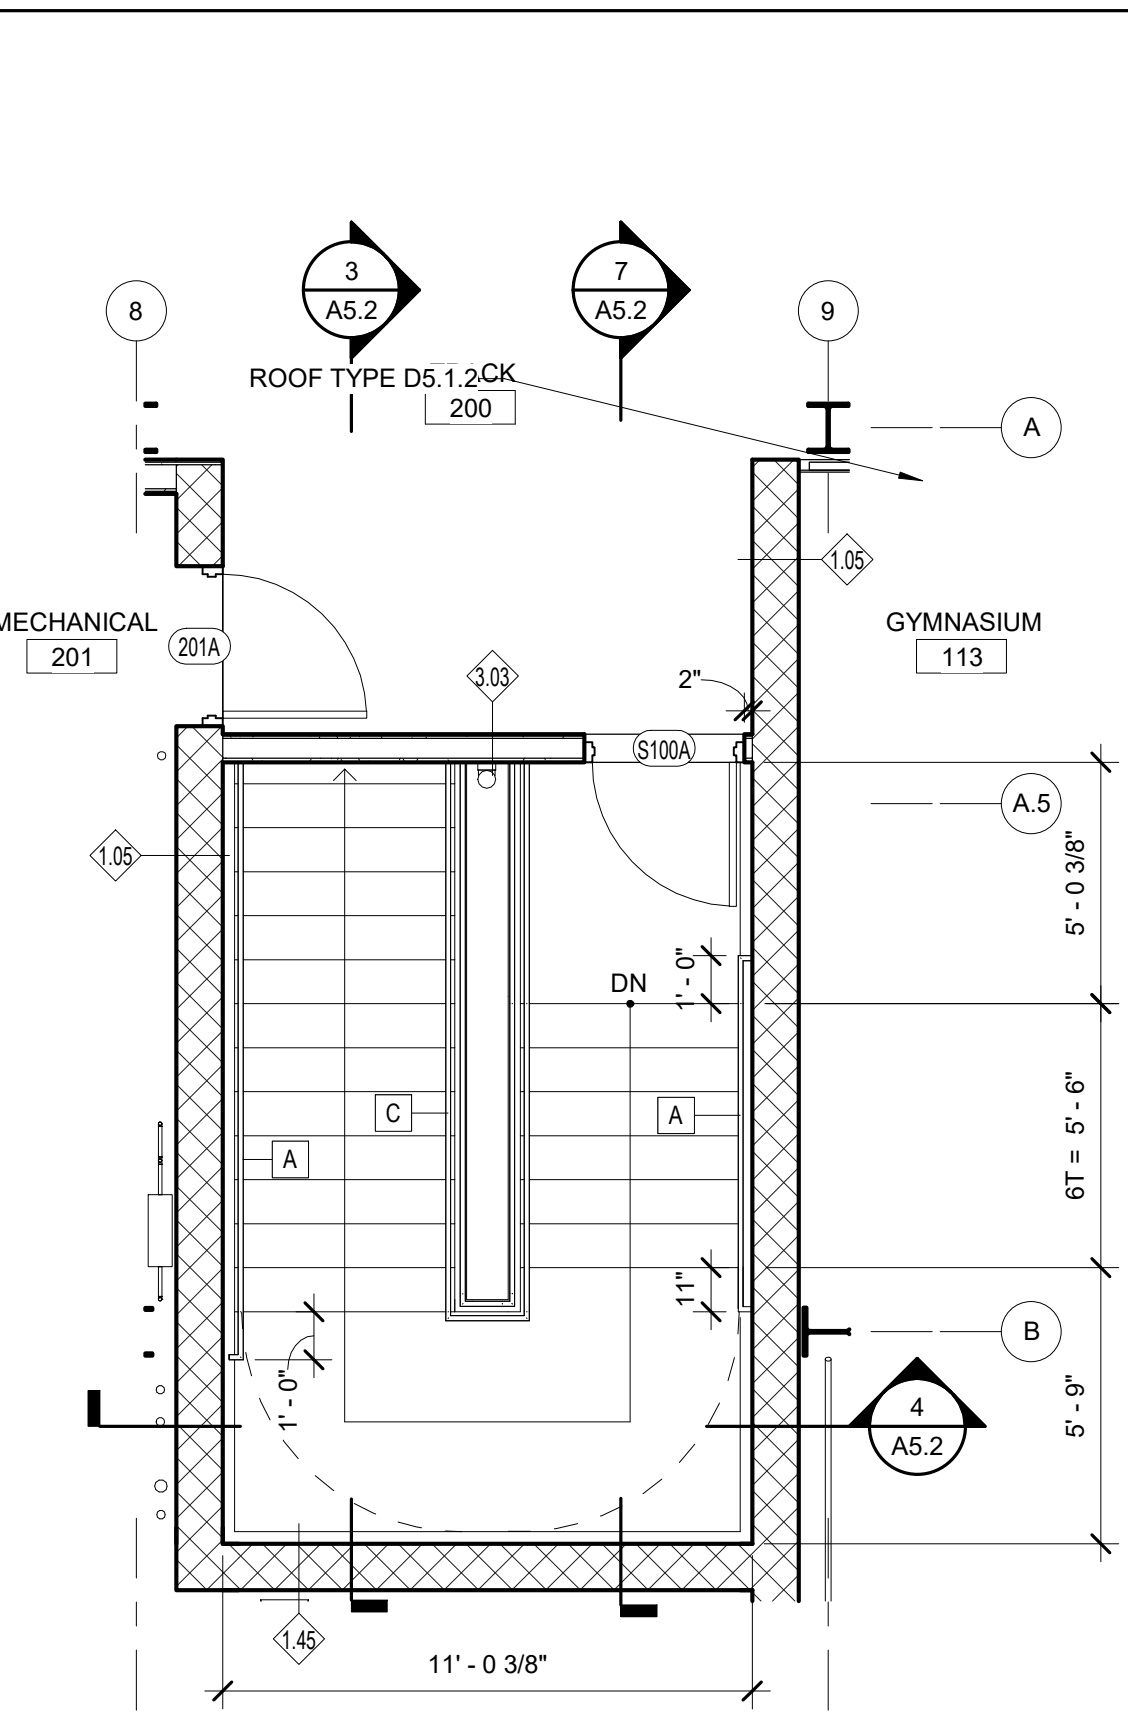


2 STAIR 1 - MEZZANINE FLOOR PLAN
 1/4" = 1'-0"
 FROM 1 / A1.2

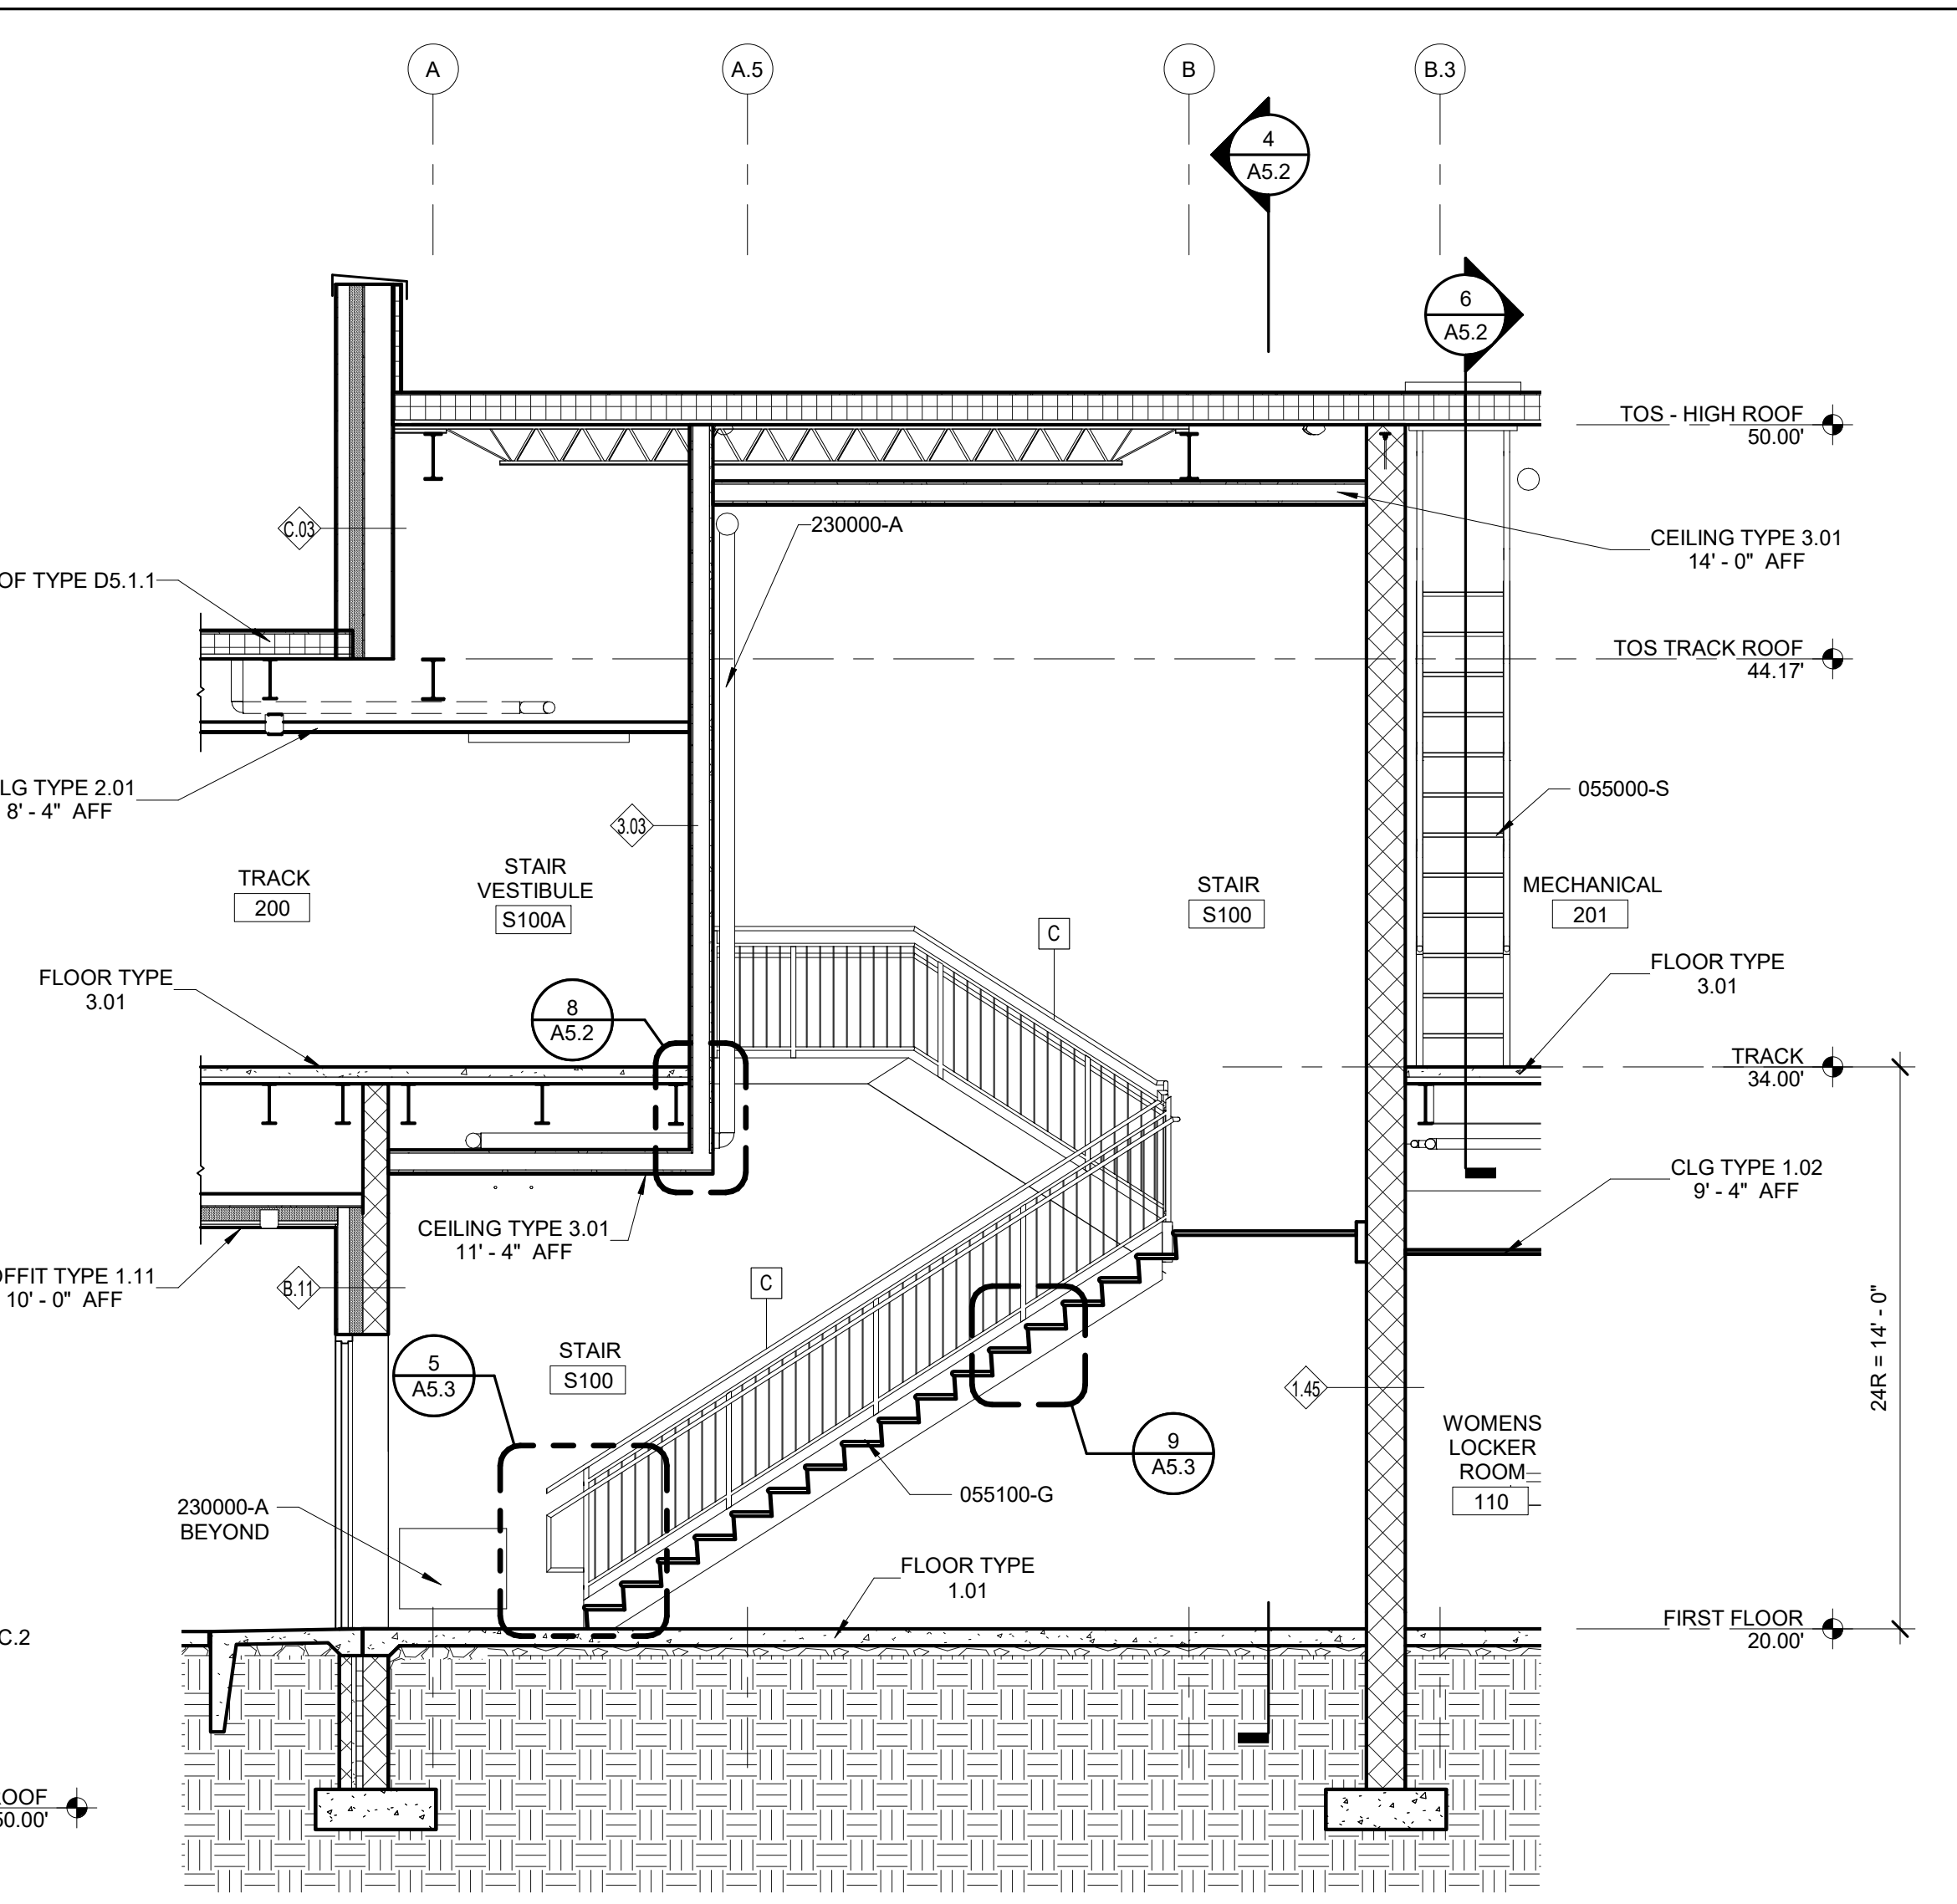


3 STAIR SECTION
 1/4" = 1'-0"
 FROM 1 / A5.2

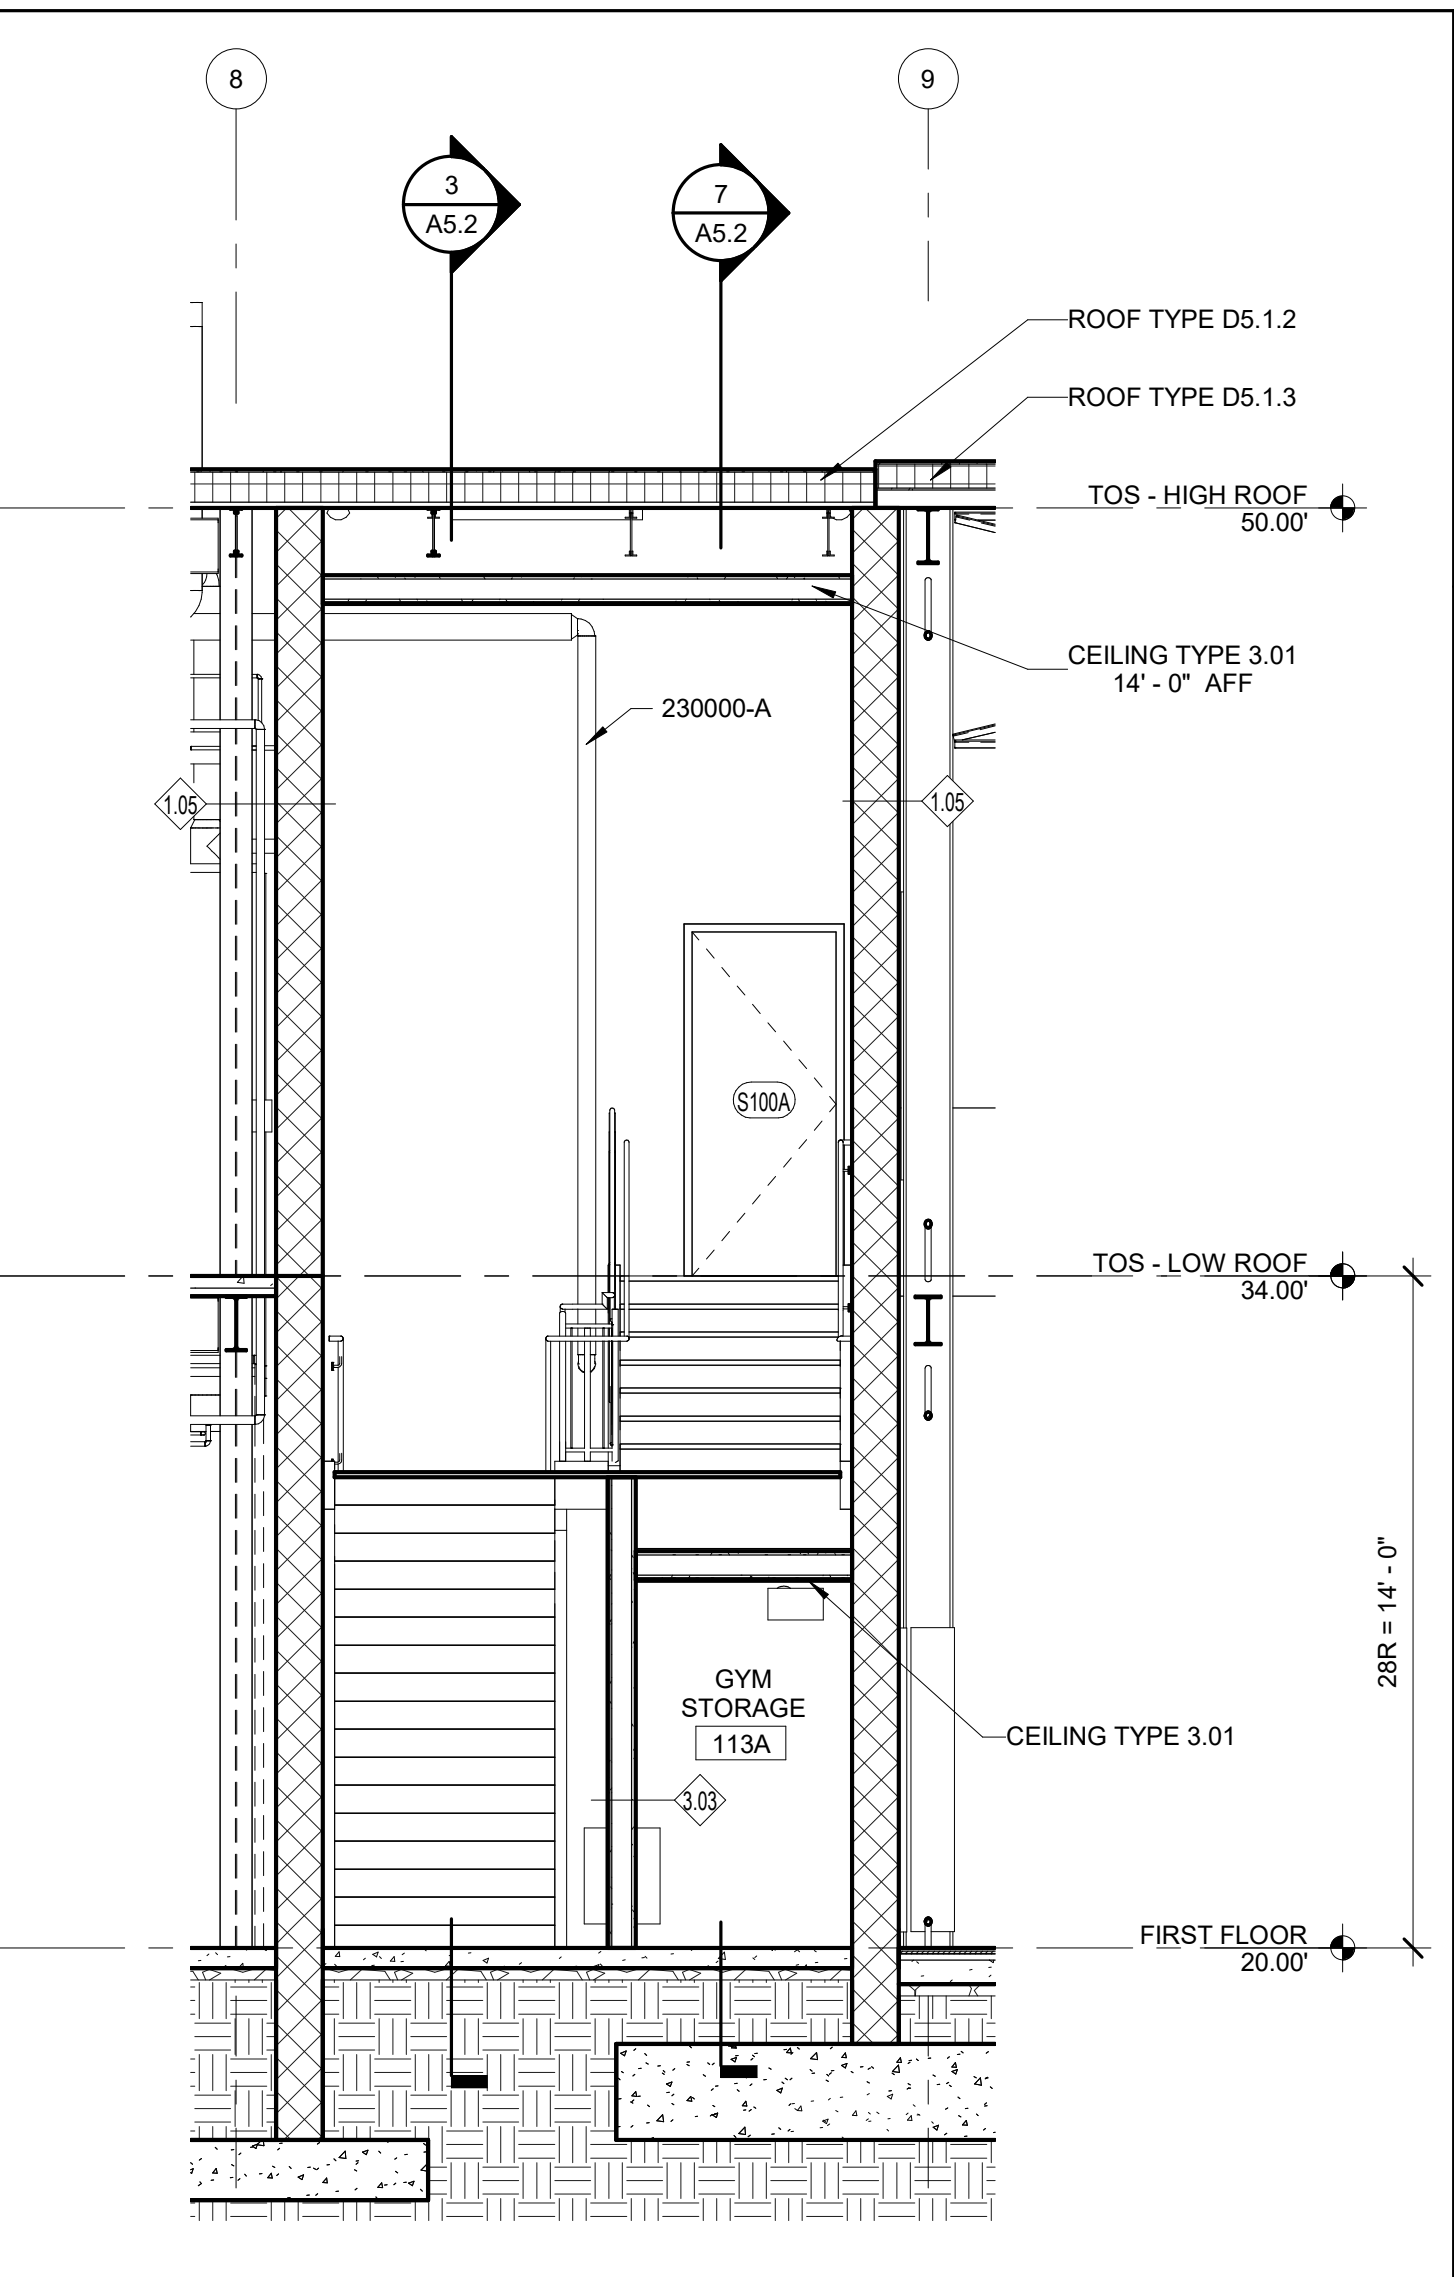


4 STAIR SECTION
 1/4" = 1'-0"
 FROM 1 / A5.2

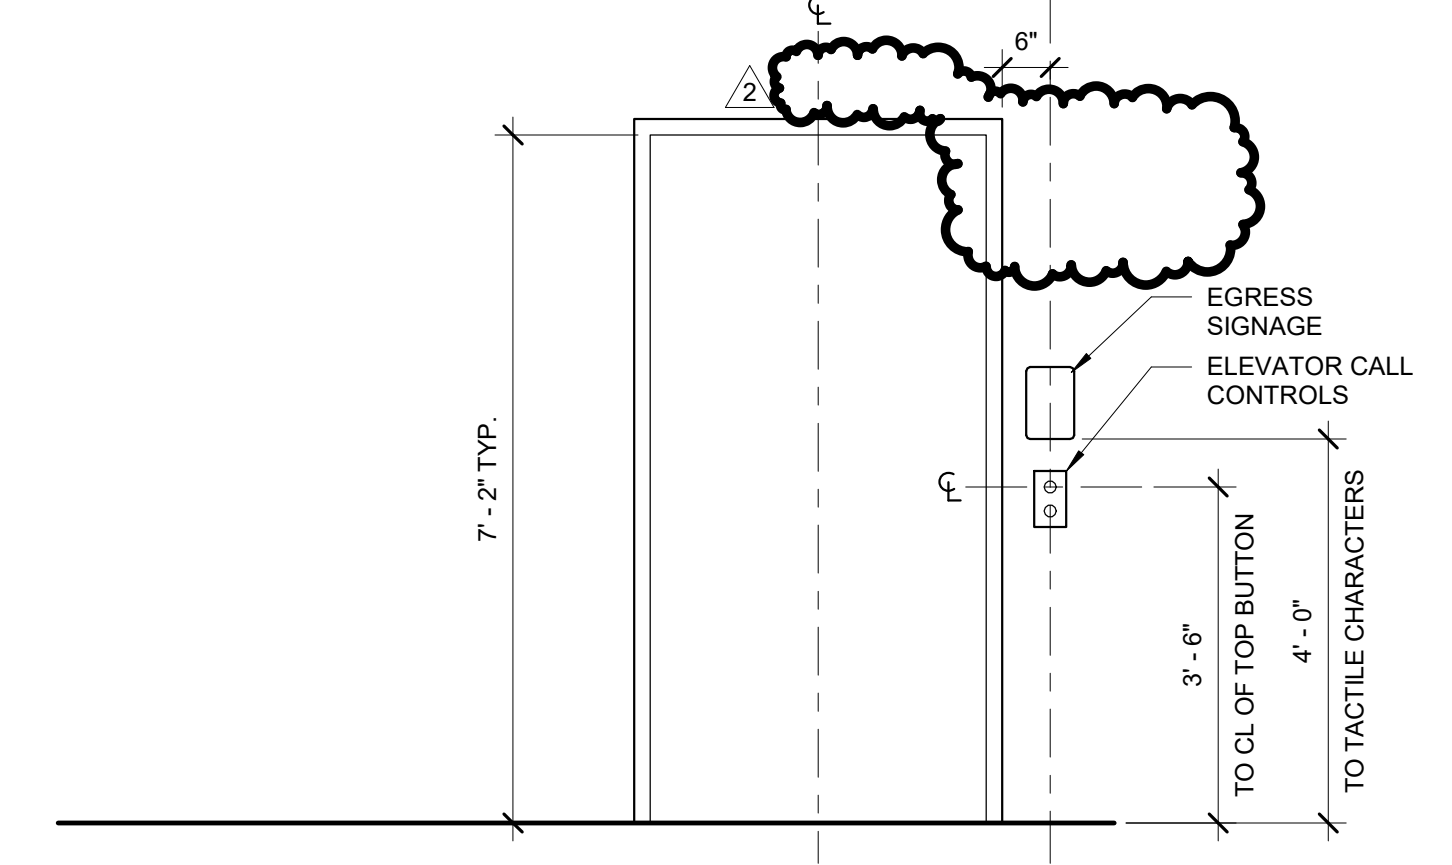


5 TYPICAL ELEVATOR LOBBY ELEVATION
 1/2" = 1'-0"
 FROM 9 / A5.2

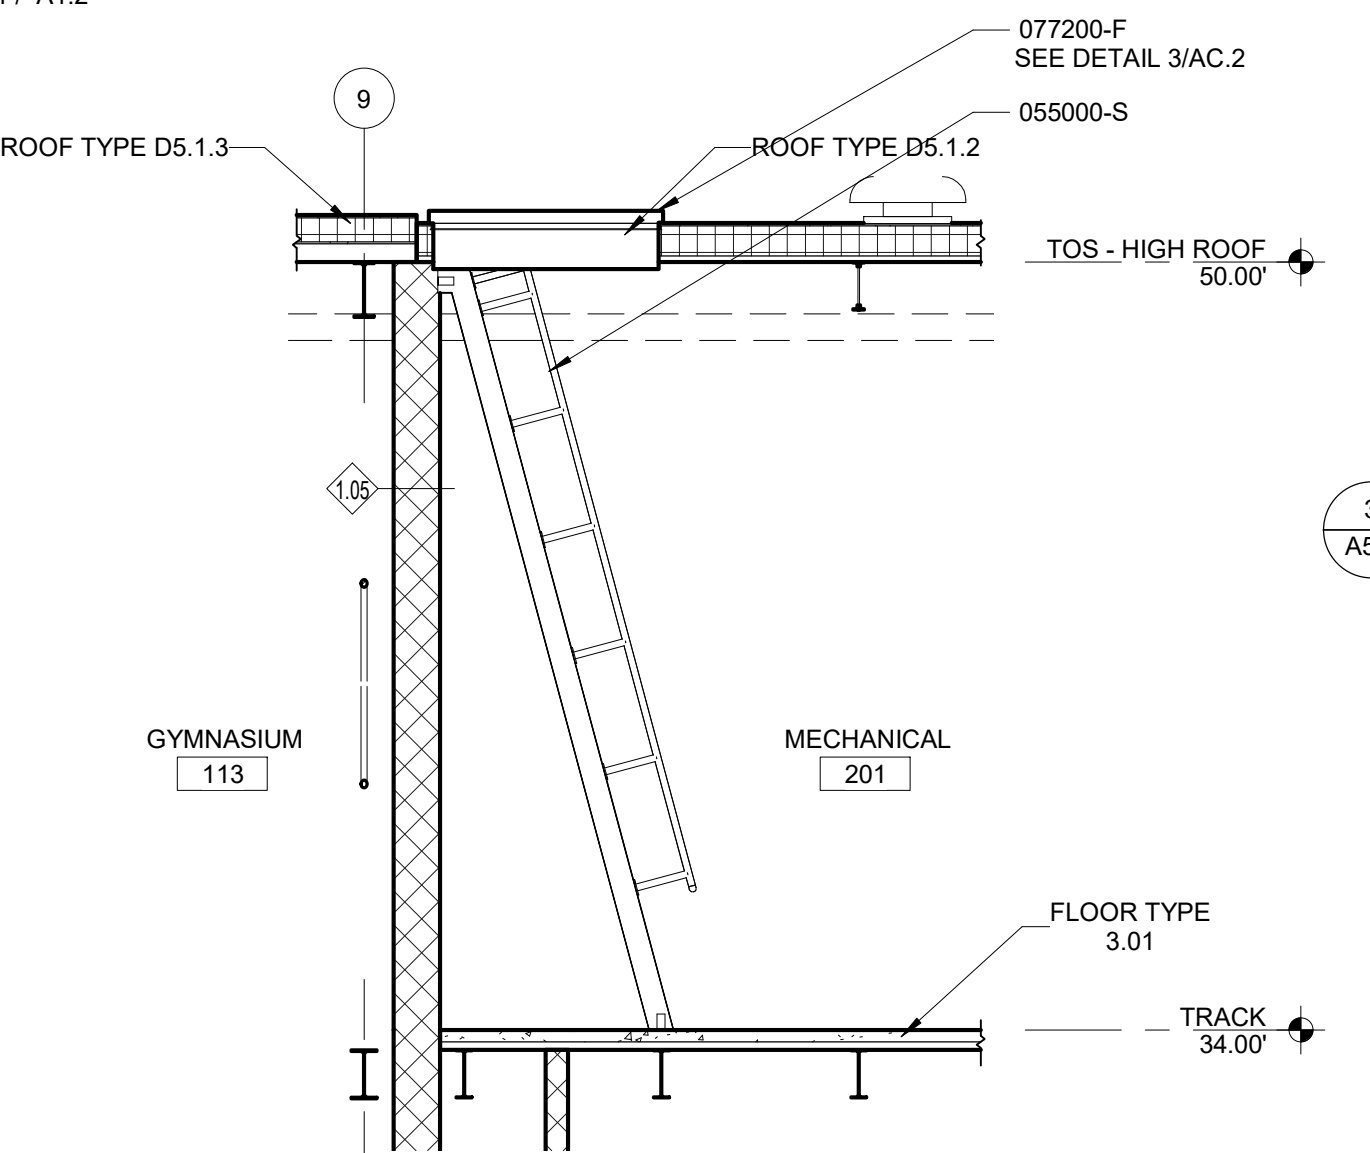


6 SHIPS LADDER STAIR @ MECH ROOM
 1/4" = 1'-0"
 FROM 3 / A5.2

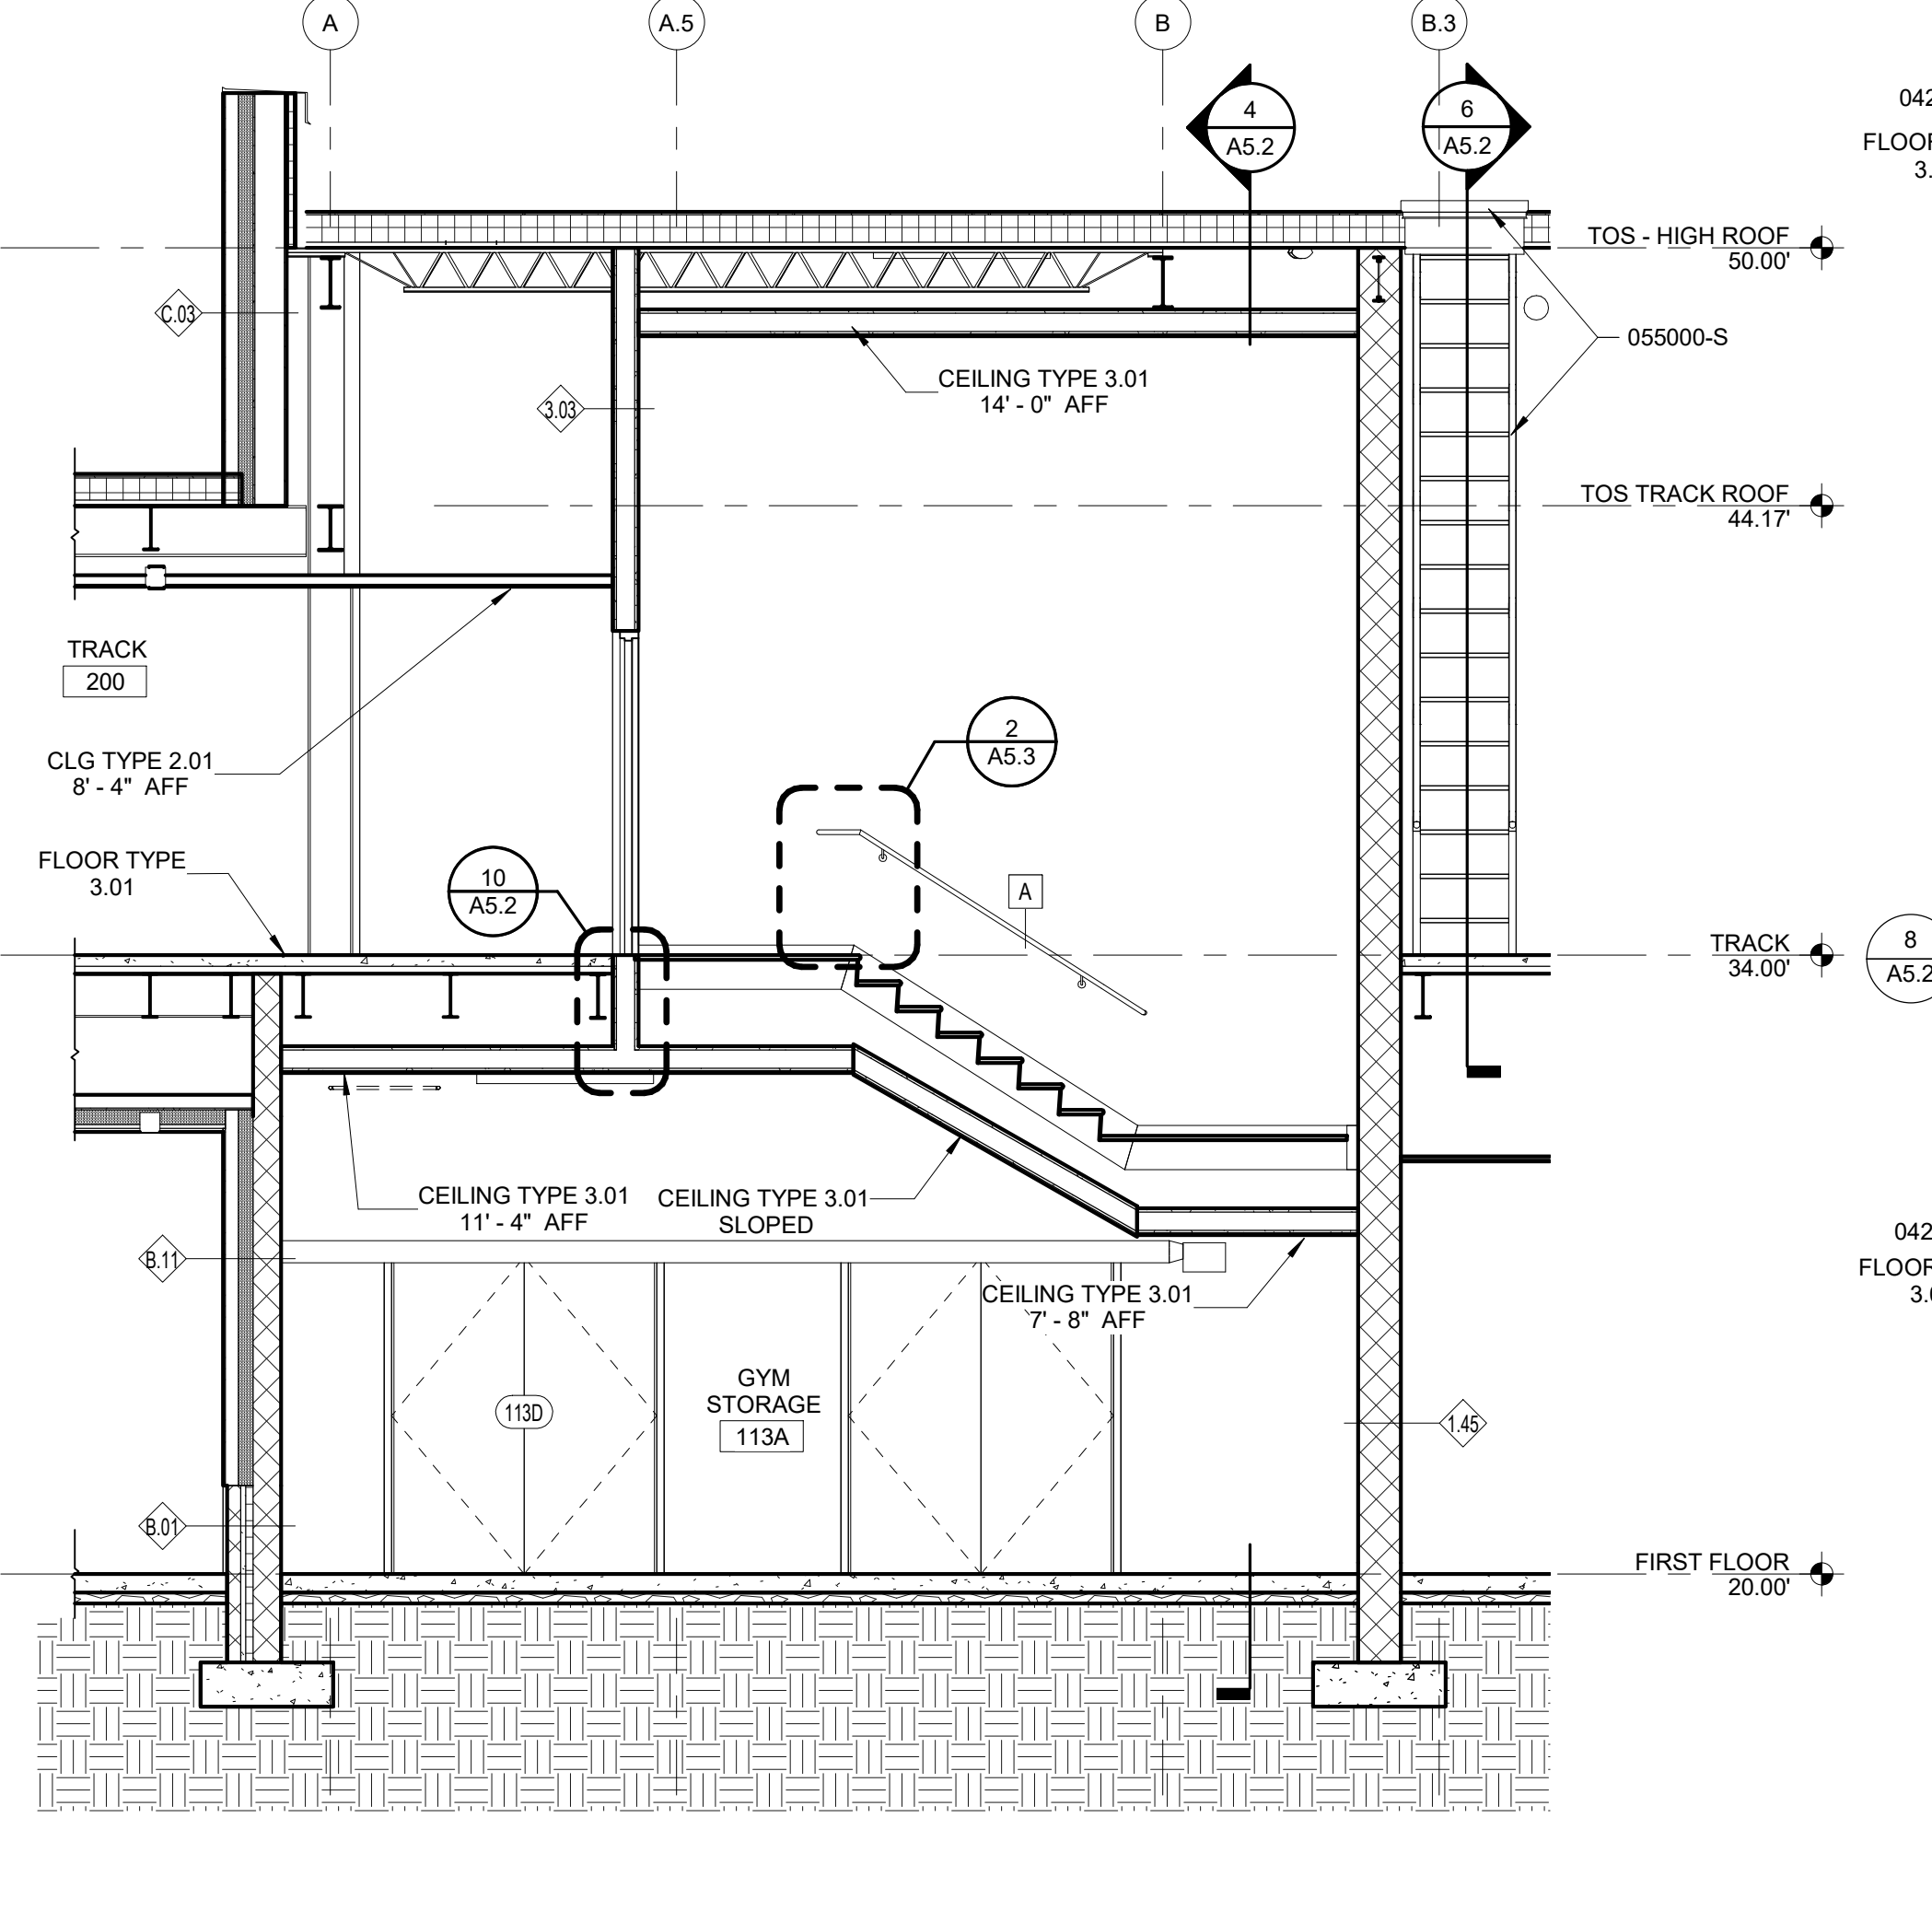


7 STAIR SECTION
 1/4" = 1'-0"
 FROM 1 / A5.2

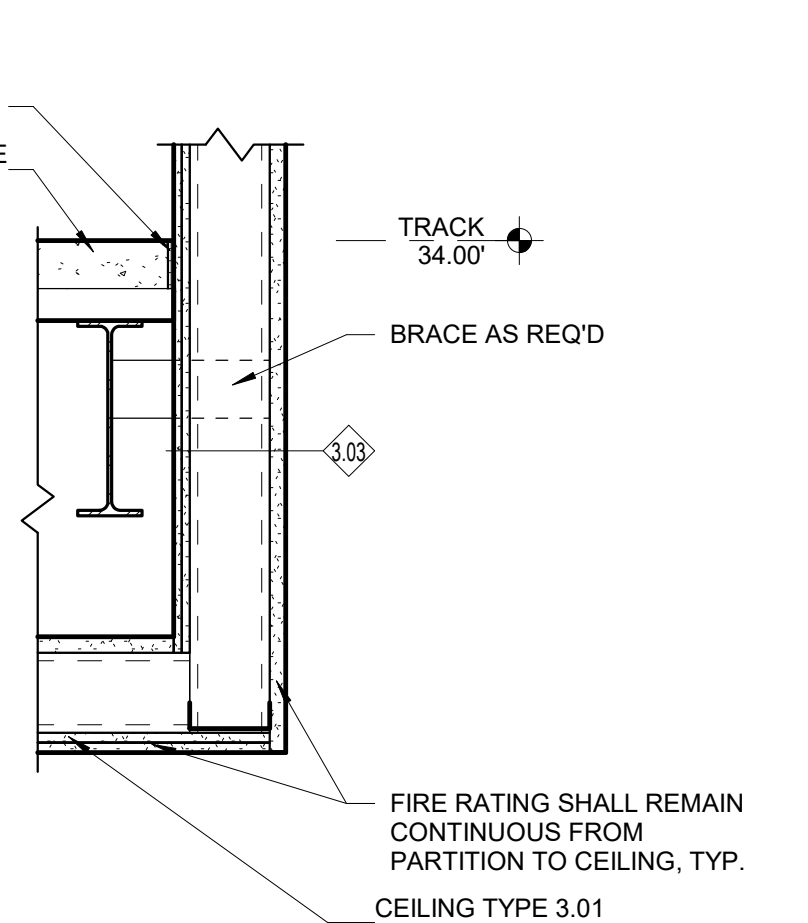


8 SECTION DETAIL
 1" = 1'-0"
 FROM 3 / A5.2

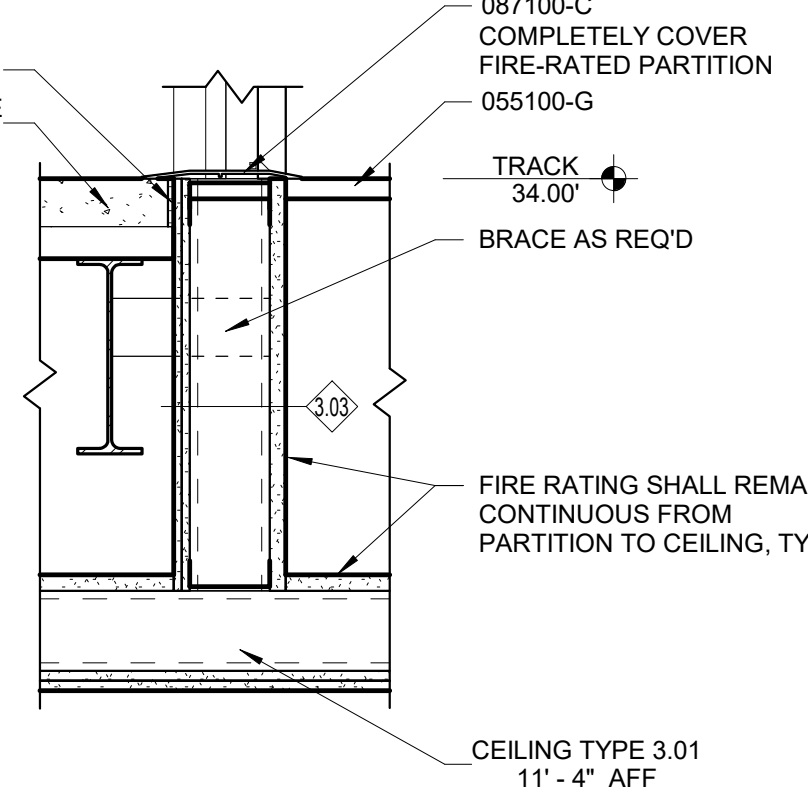


10 SECTION DETAIL
 1" = 1'-0"
 FROM 7 / A5.2

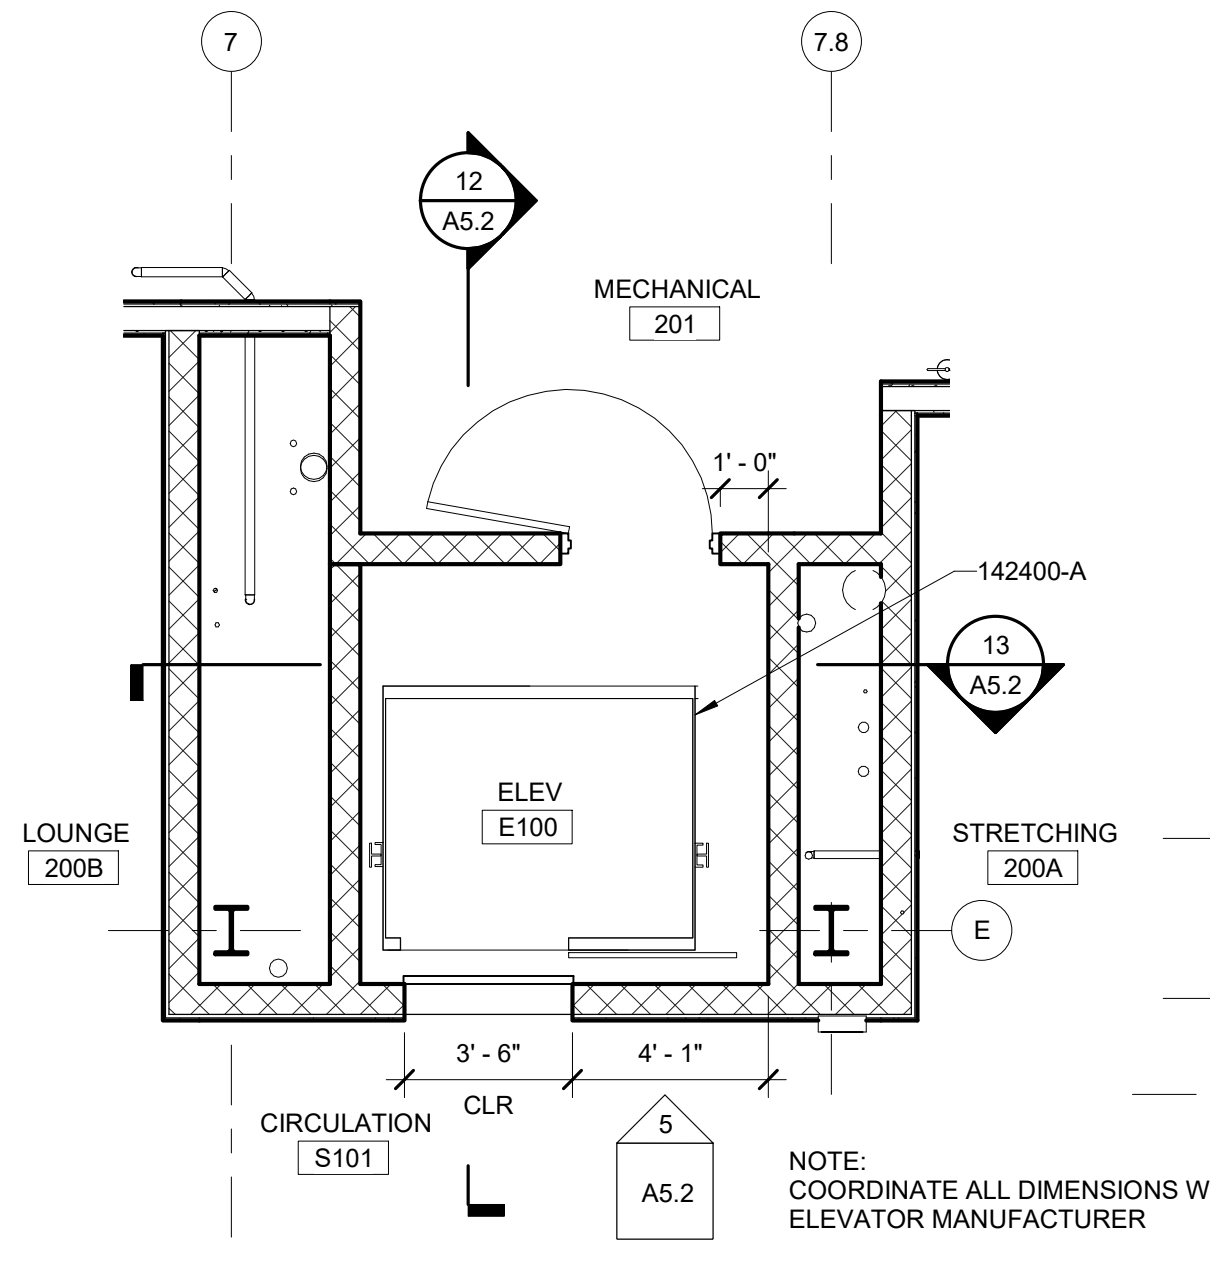


9 ELEVATOR - MEZZANINE FLOOR PLAN
 1/4" = 1'-0"
 FROM 1 / A1.2

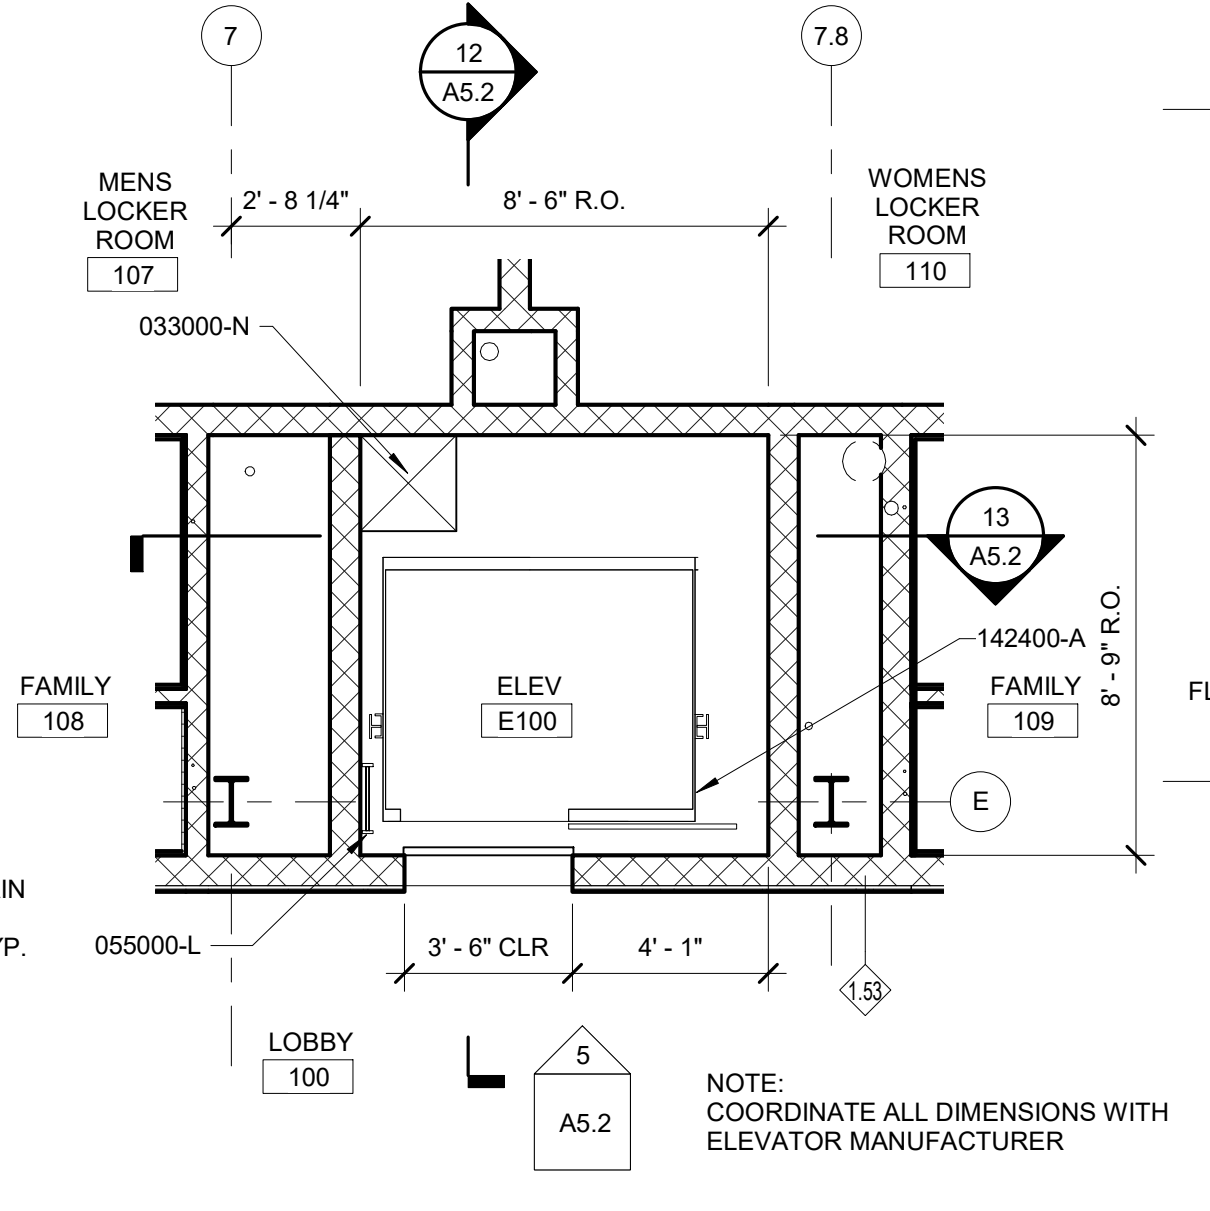

11 ELEVATOR - FIRST FLOOR PLAN
 1/4" = 1'-0"
 FROM 1 / A1.1

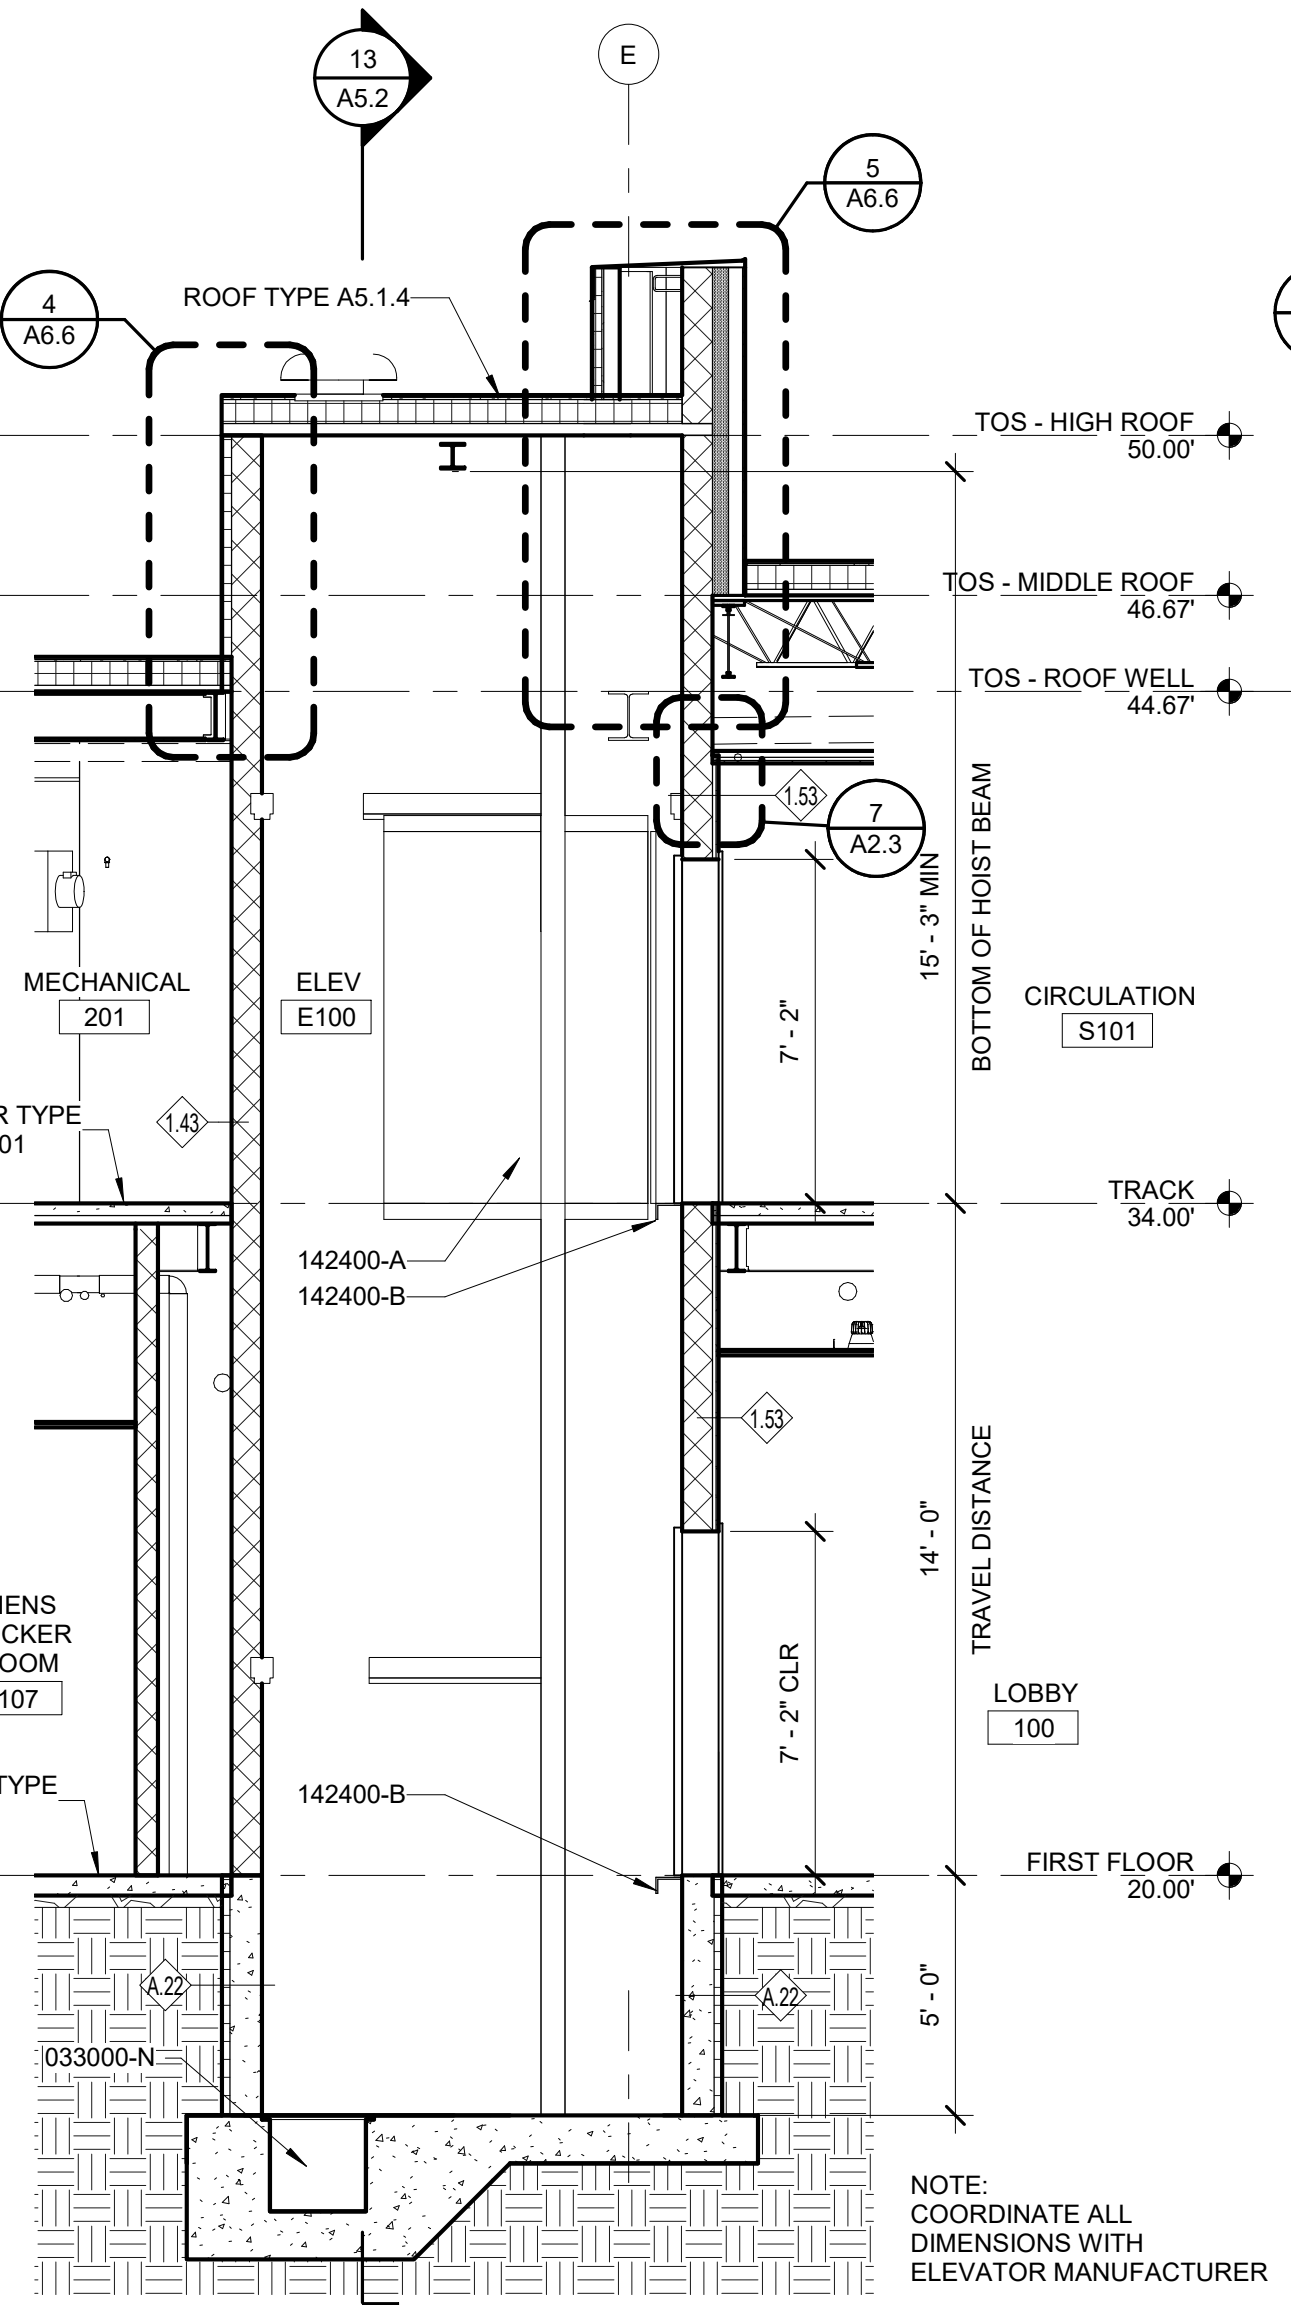

12 ELEVATOR SECTION
 1/4" = 1'-0"
 FROM 9 / A5.2

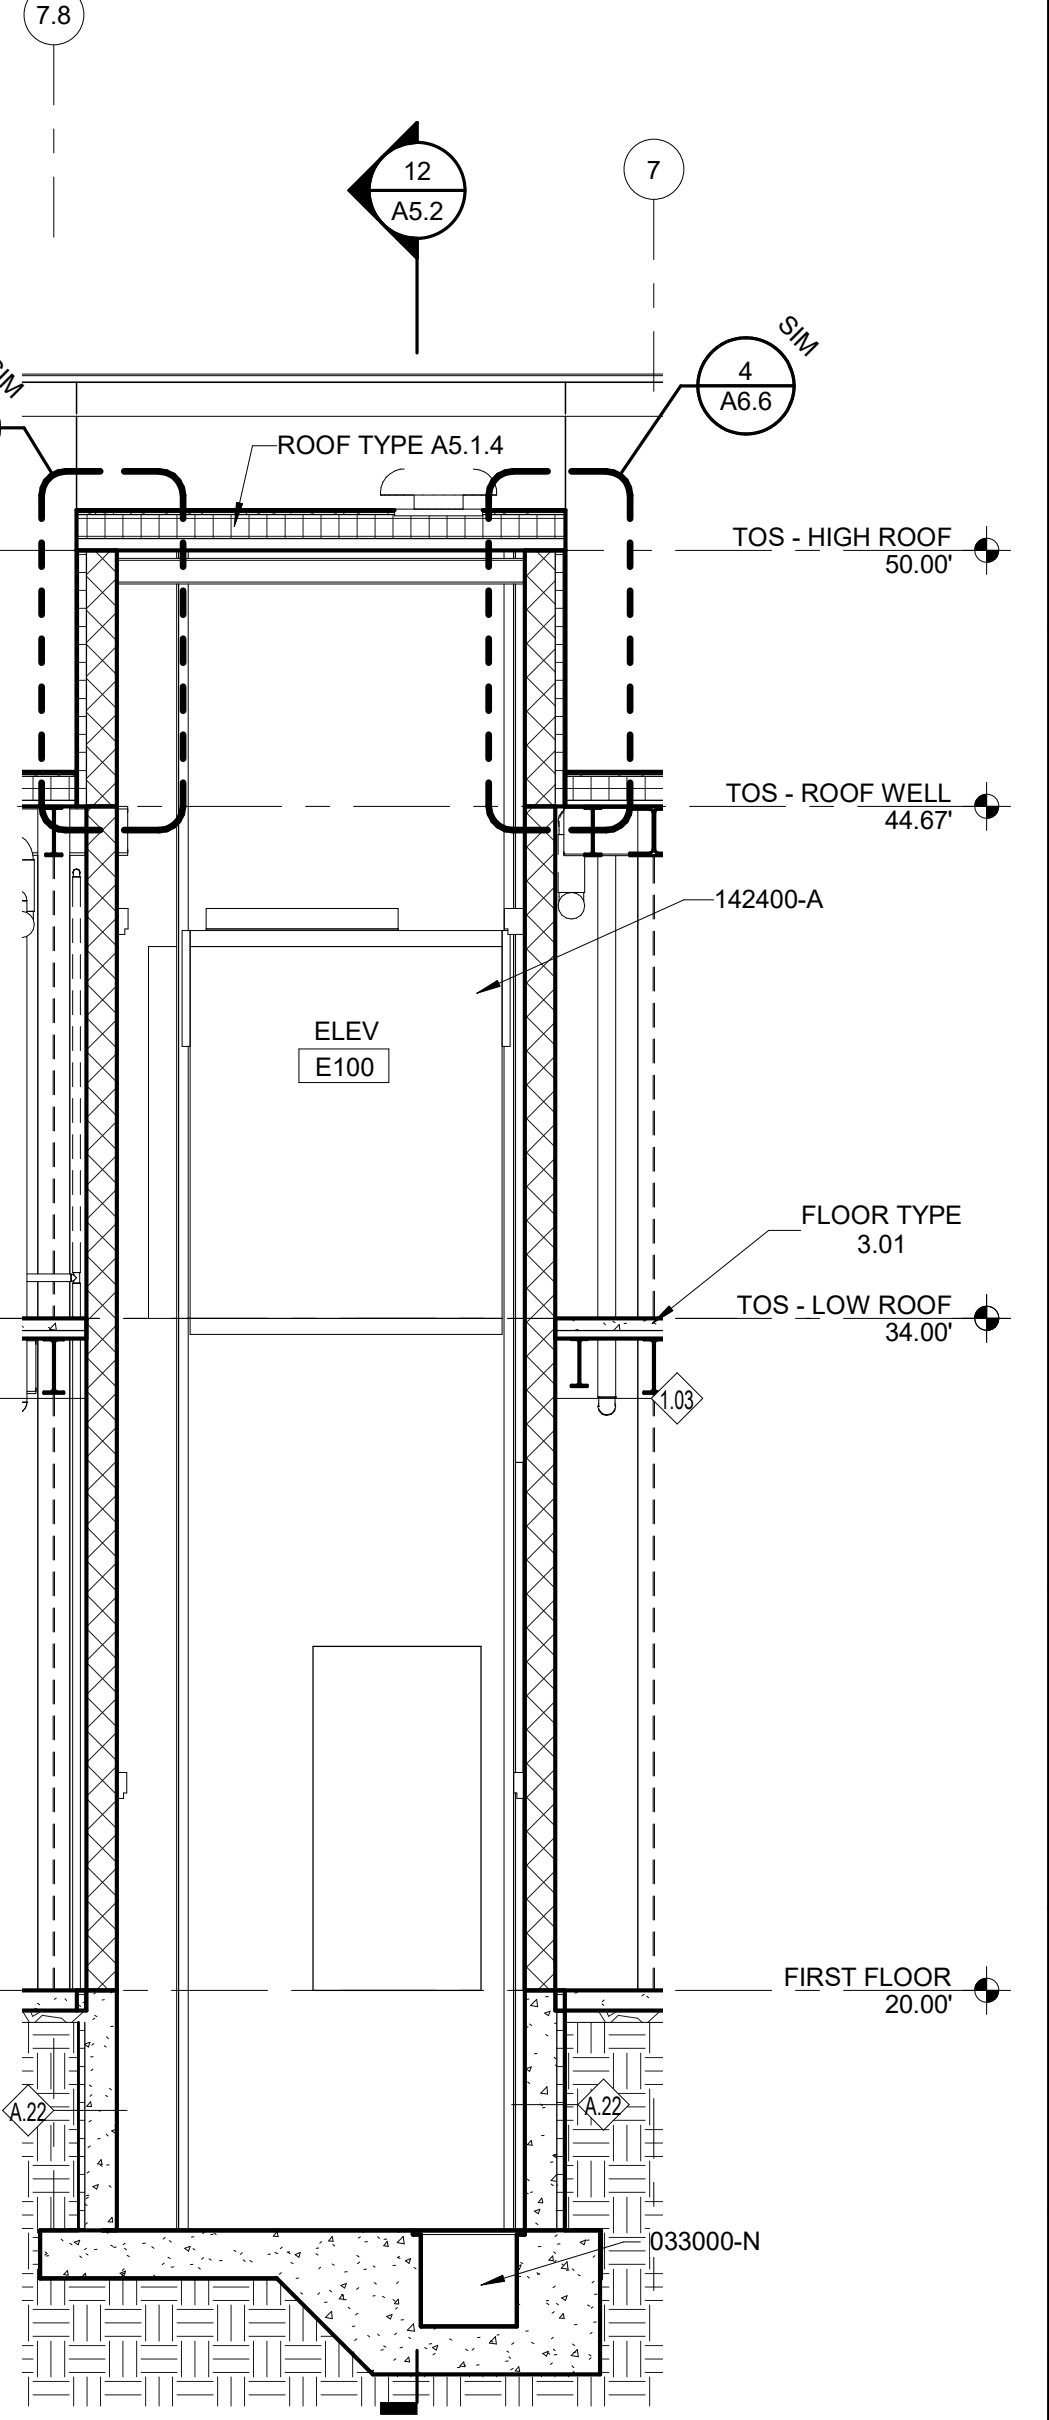

13 ELEVATOR SECTION
 1/4" = 1'-0"
 FROM 9 / A5.2

KEY PLAN:
 033000-N SUMP PIT (REFER TO STRUCTURAL FOR MORE INFORMATION)
 042000-Q COMPRESSIBLE FILLER
 055000-S ELEVATOR PIT LADDER
 055000-S PREFABRICATED ALUMINUM SHIPS LADDER
 055100-G PERFORATED STEEL RISER, PAINTED
 077200-F ROOF HATCH, SHIPS LADDER ACCESS
 087100-C THRESHOLD
 142400-A HYDRAULIC ELEVATOR
 142400-B SILL ANGLE
 230000-A MECHANICAL (REFER TO MECHANICAL FOR MORE INFORMATION)

KEYNOTES LISTED ON THIS SHEET ARE FOR CONVENIENCE ONLY. REFER TO SHEET CS.2 FOR COMPLETE LIST

SCALE OF FEET
 1/4" = 1'-0"

ISSUED FOR BID

Seal: _____
 Seal: _____

G|W|O
 G|W|O INC.
 800 WYMAN PARK DRIVE, SUITE 300
 BALTIMORE, MARYLAND 21211, 410-352-1909
 © 2019 G|W|O INC.

REVISIONS:
 No. Date Description
 2 1/28/2020 ADDENDUM 2












MIDDLE BRANCH FITNESS & WELLNESS CENTER AT CHERRY HILL
 BALTIMORE CITY RECREATION & PARKS

Job No. #18010 AWM Drawn
 Scale As indicated KMS Checked
 Date 12/13/2019 AER Approved
 Drawing Title Stair and Elevator Plans & Sections Drawing Number


Sheet **A5.2r2** OF

1/24/2020 4:09:13 PM C:\Autodesk\Local Files\18010-MBFW-Bid-2019-1_amcallister@gwinc.com.rvt

C:\Autodesk\Local Files\18010-MBFW-Bid-2019-1_amcallister@gwwoinc.com.rvt 1/27/2020 3:18:44 PM

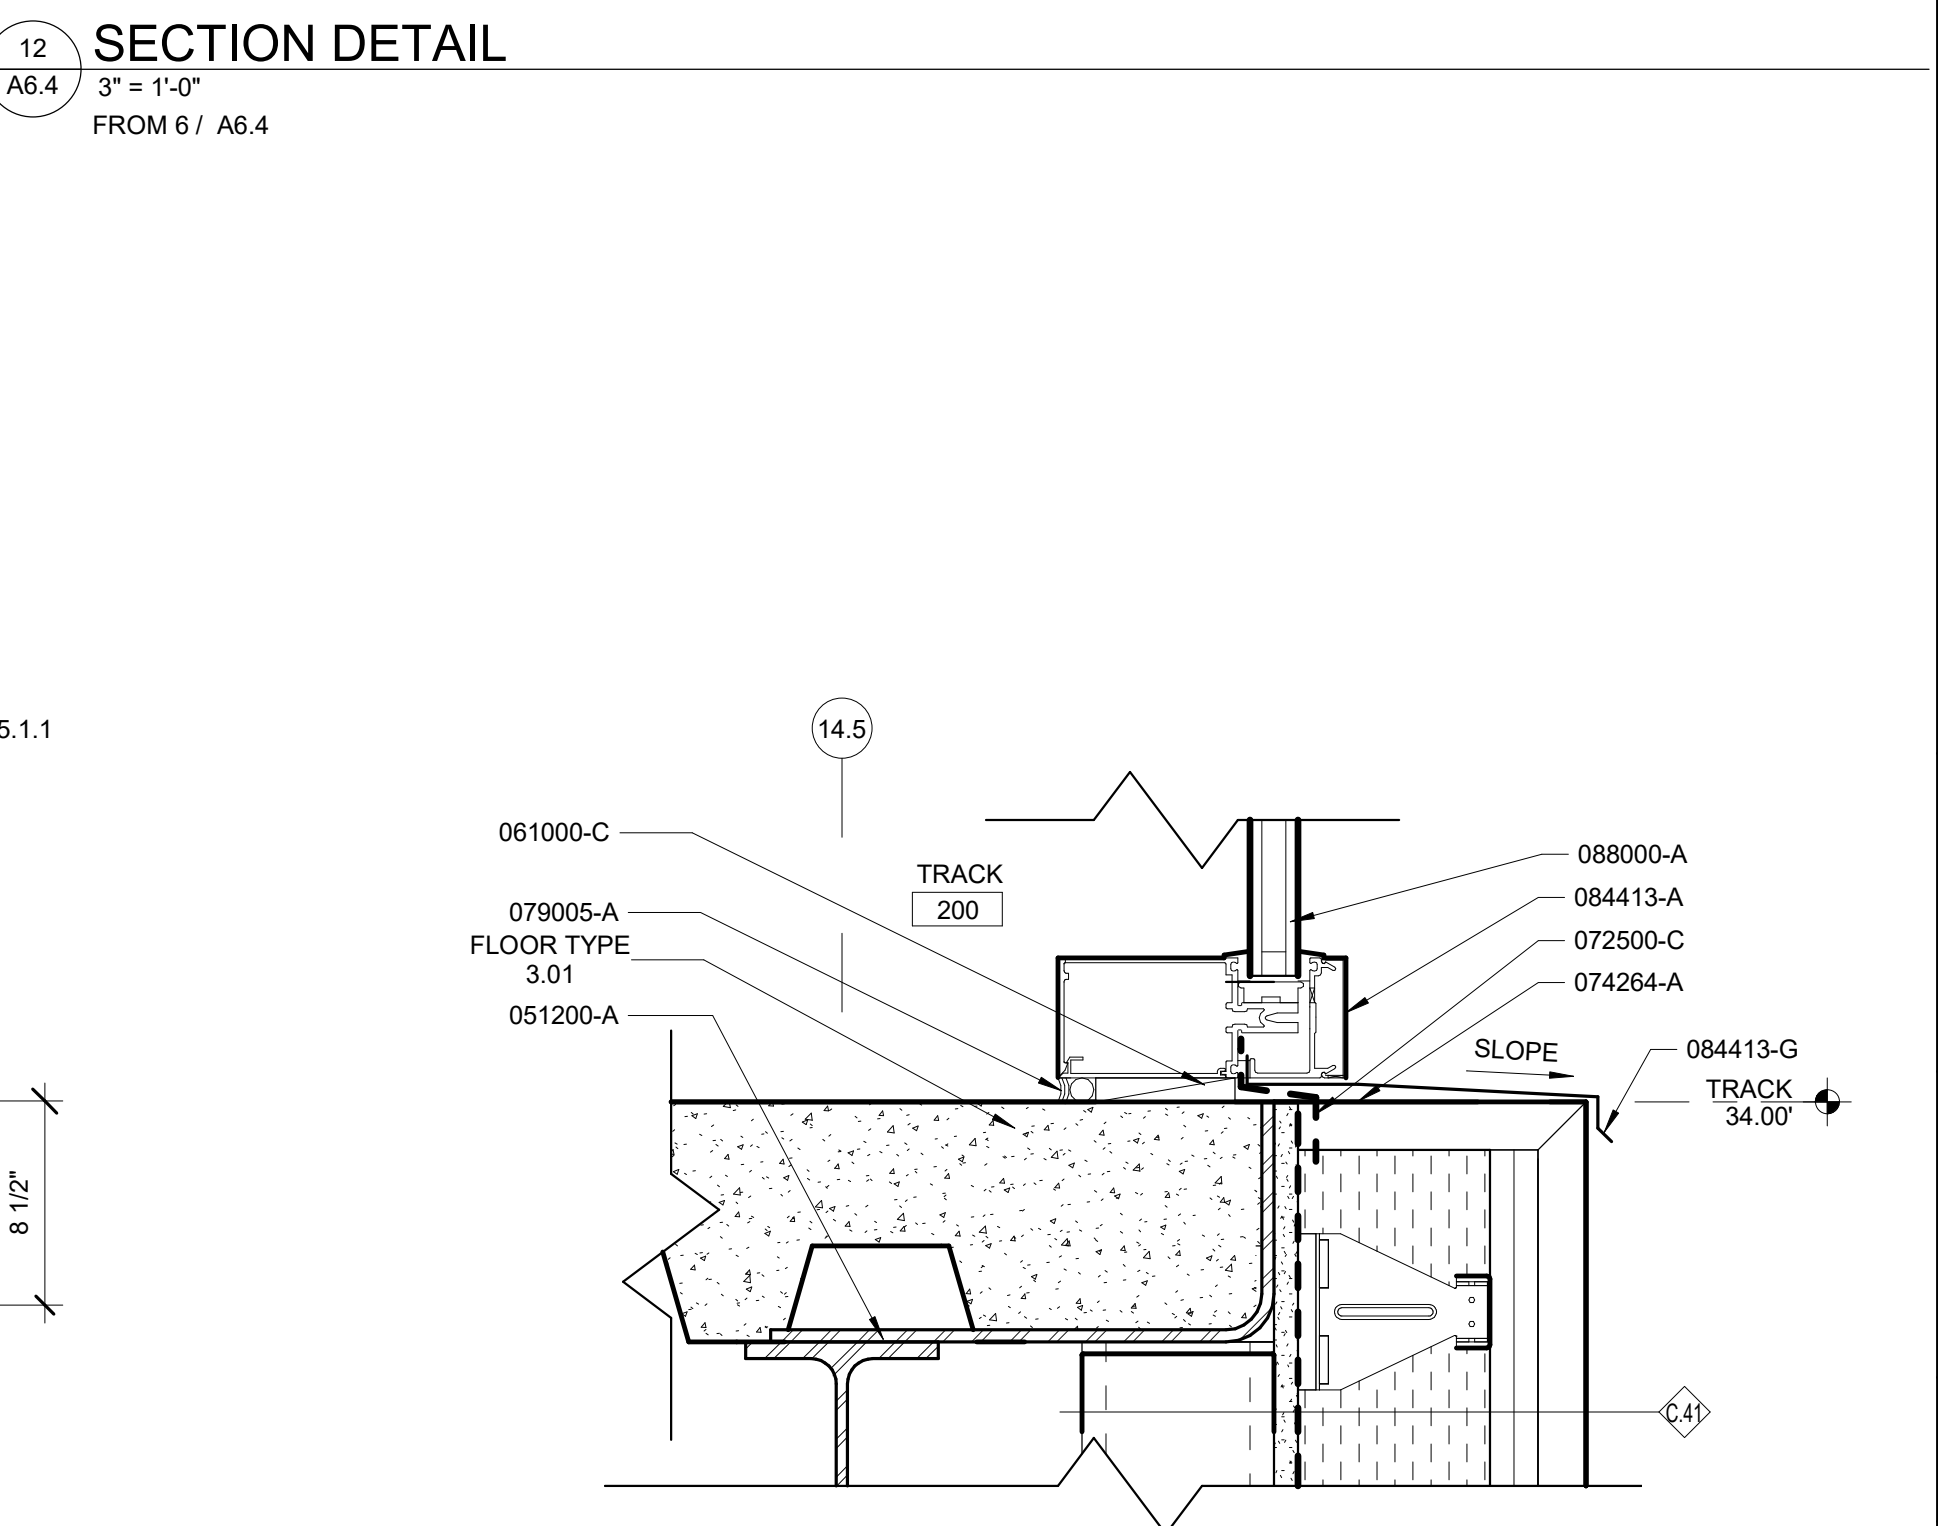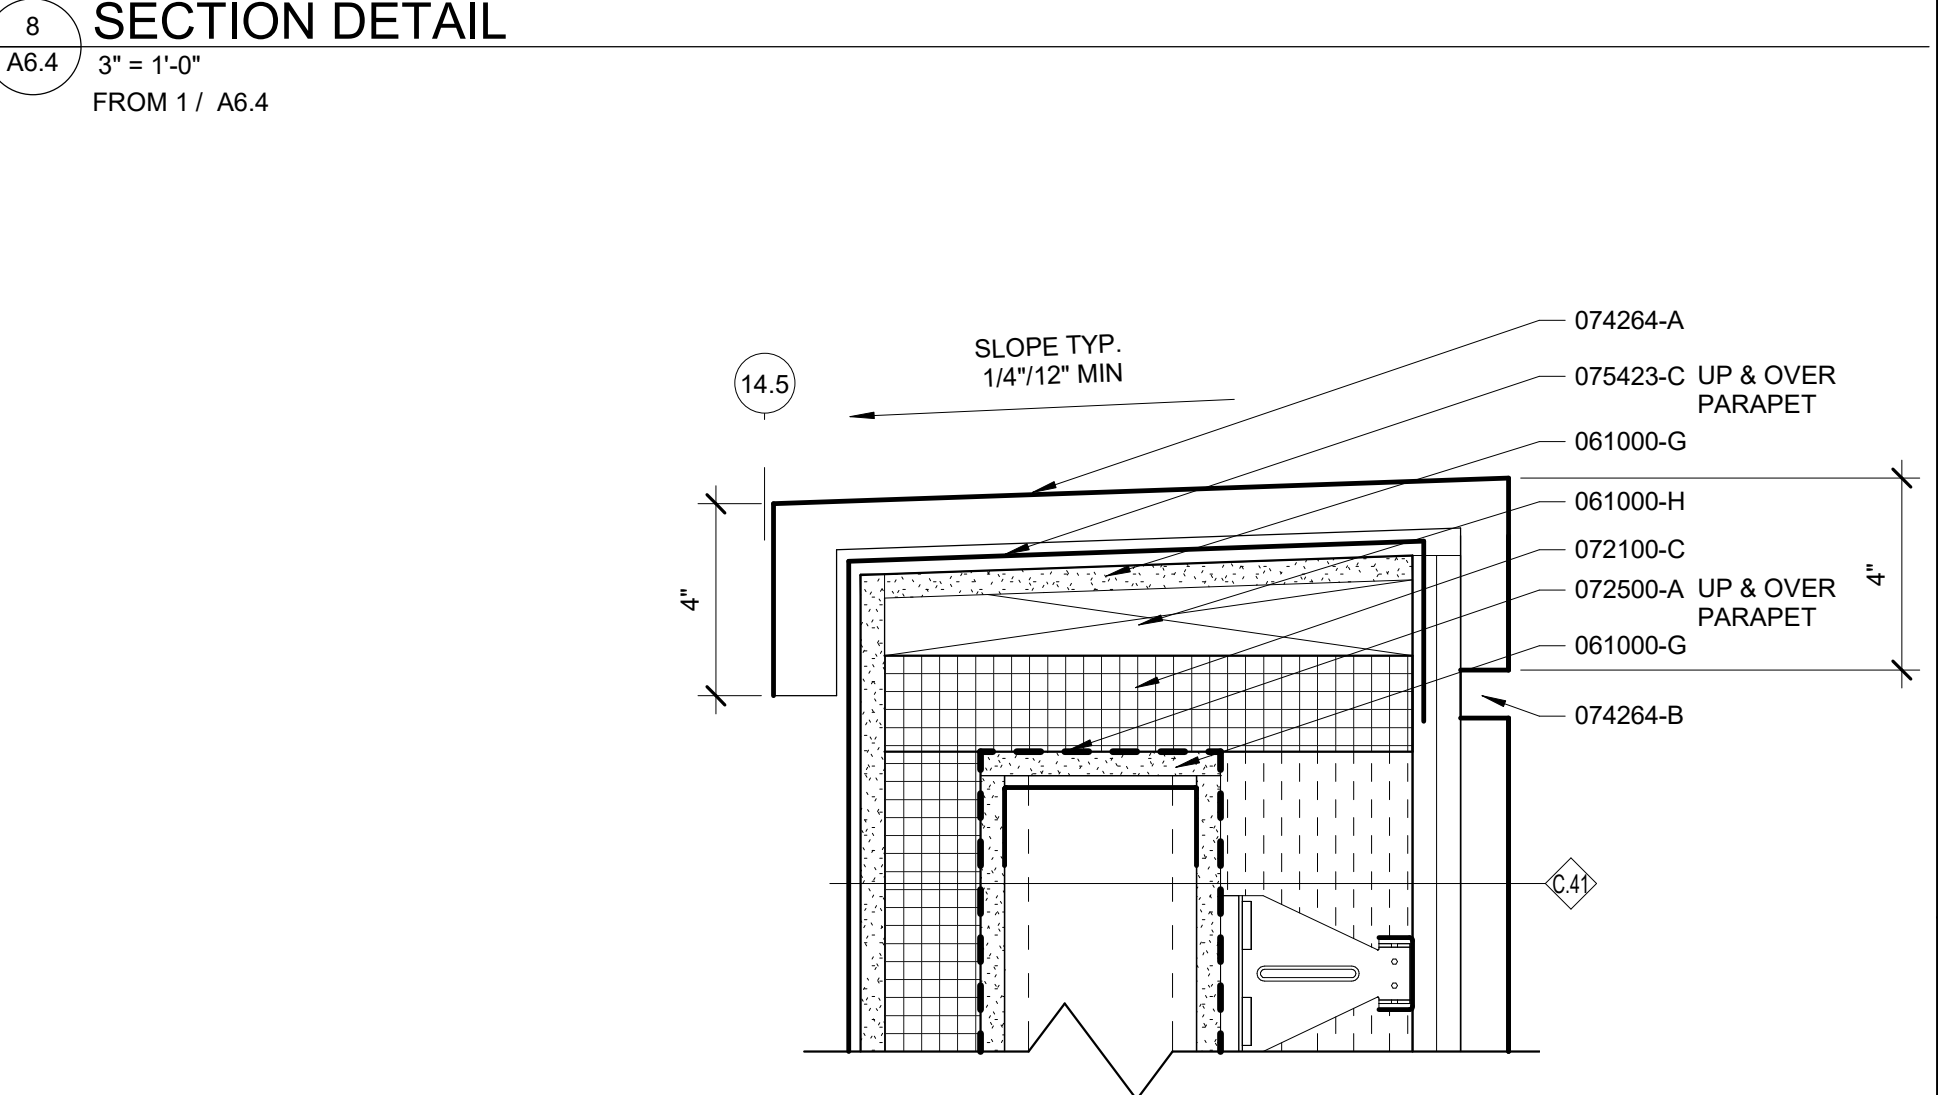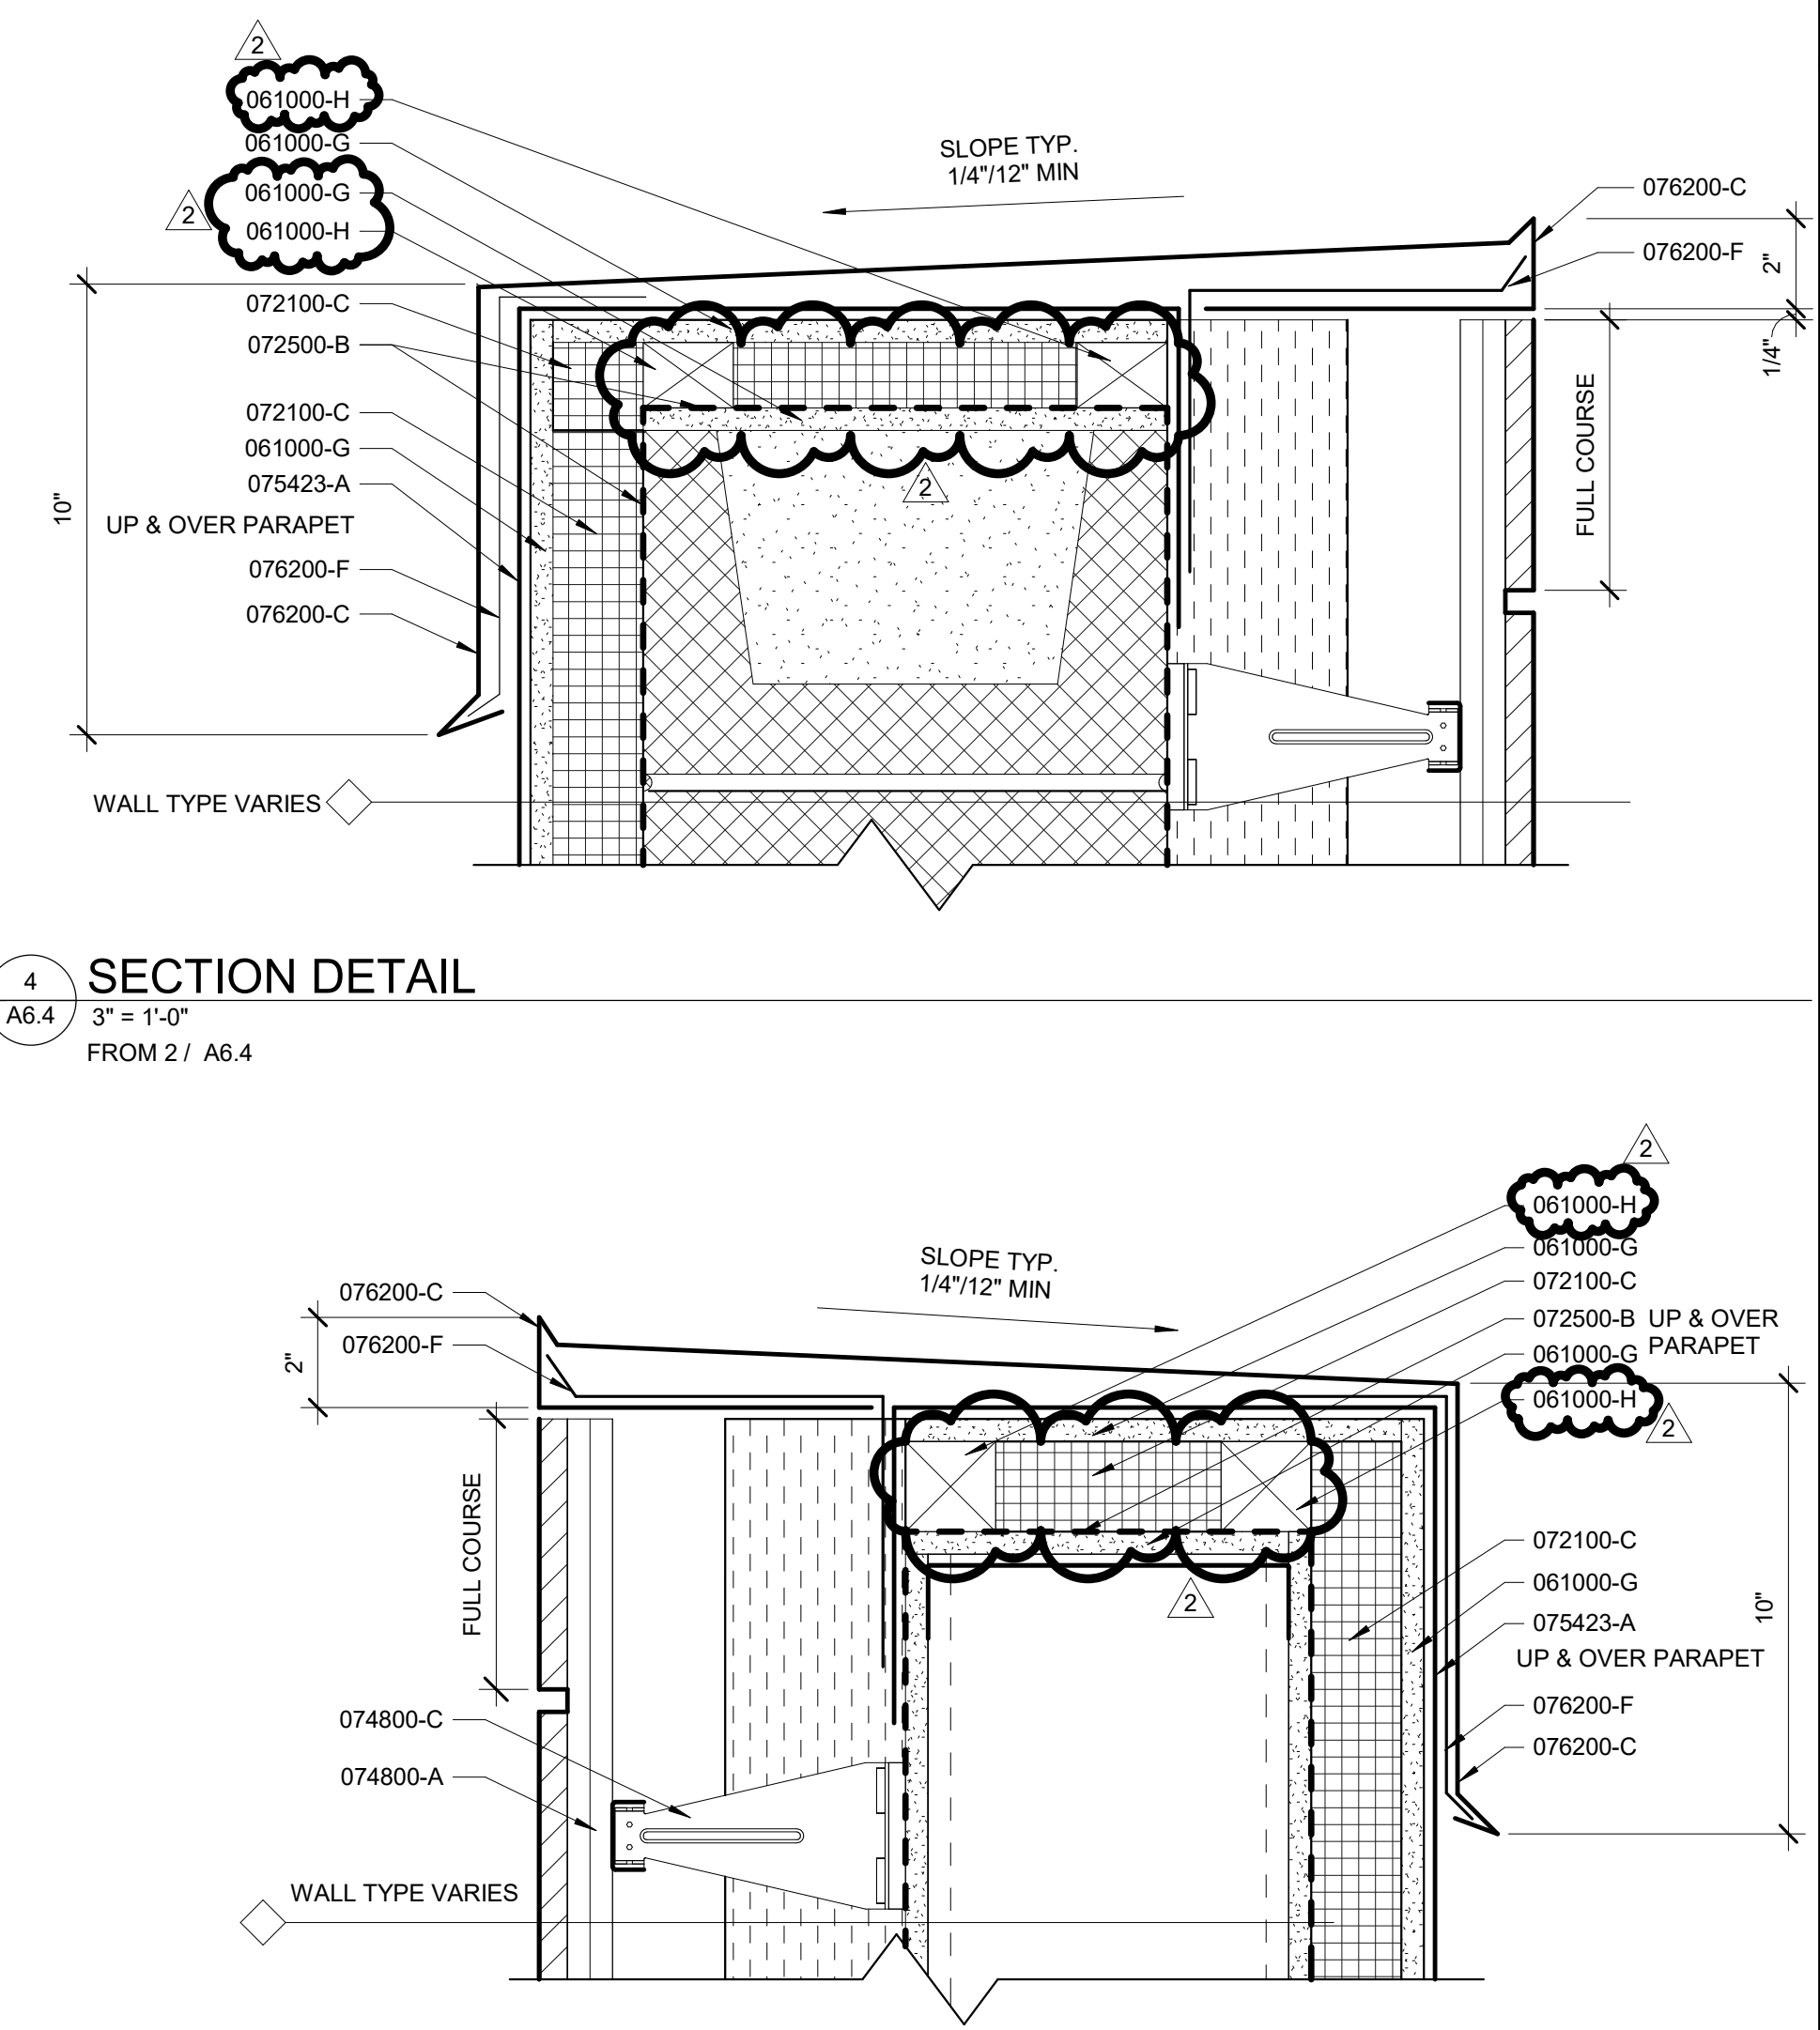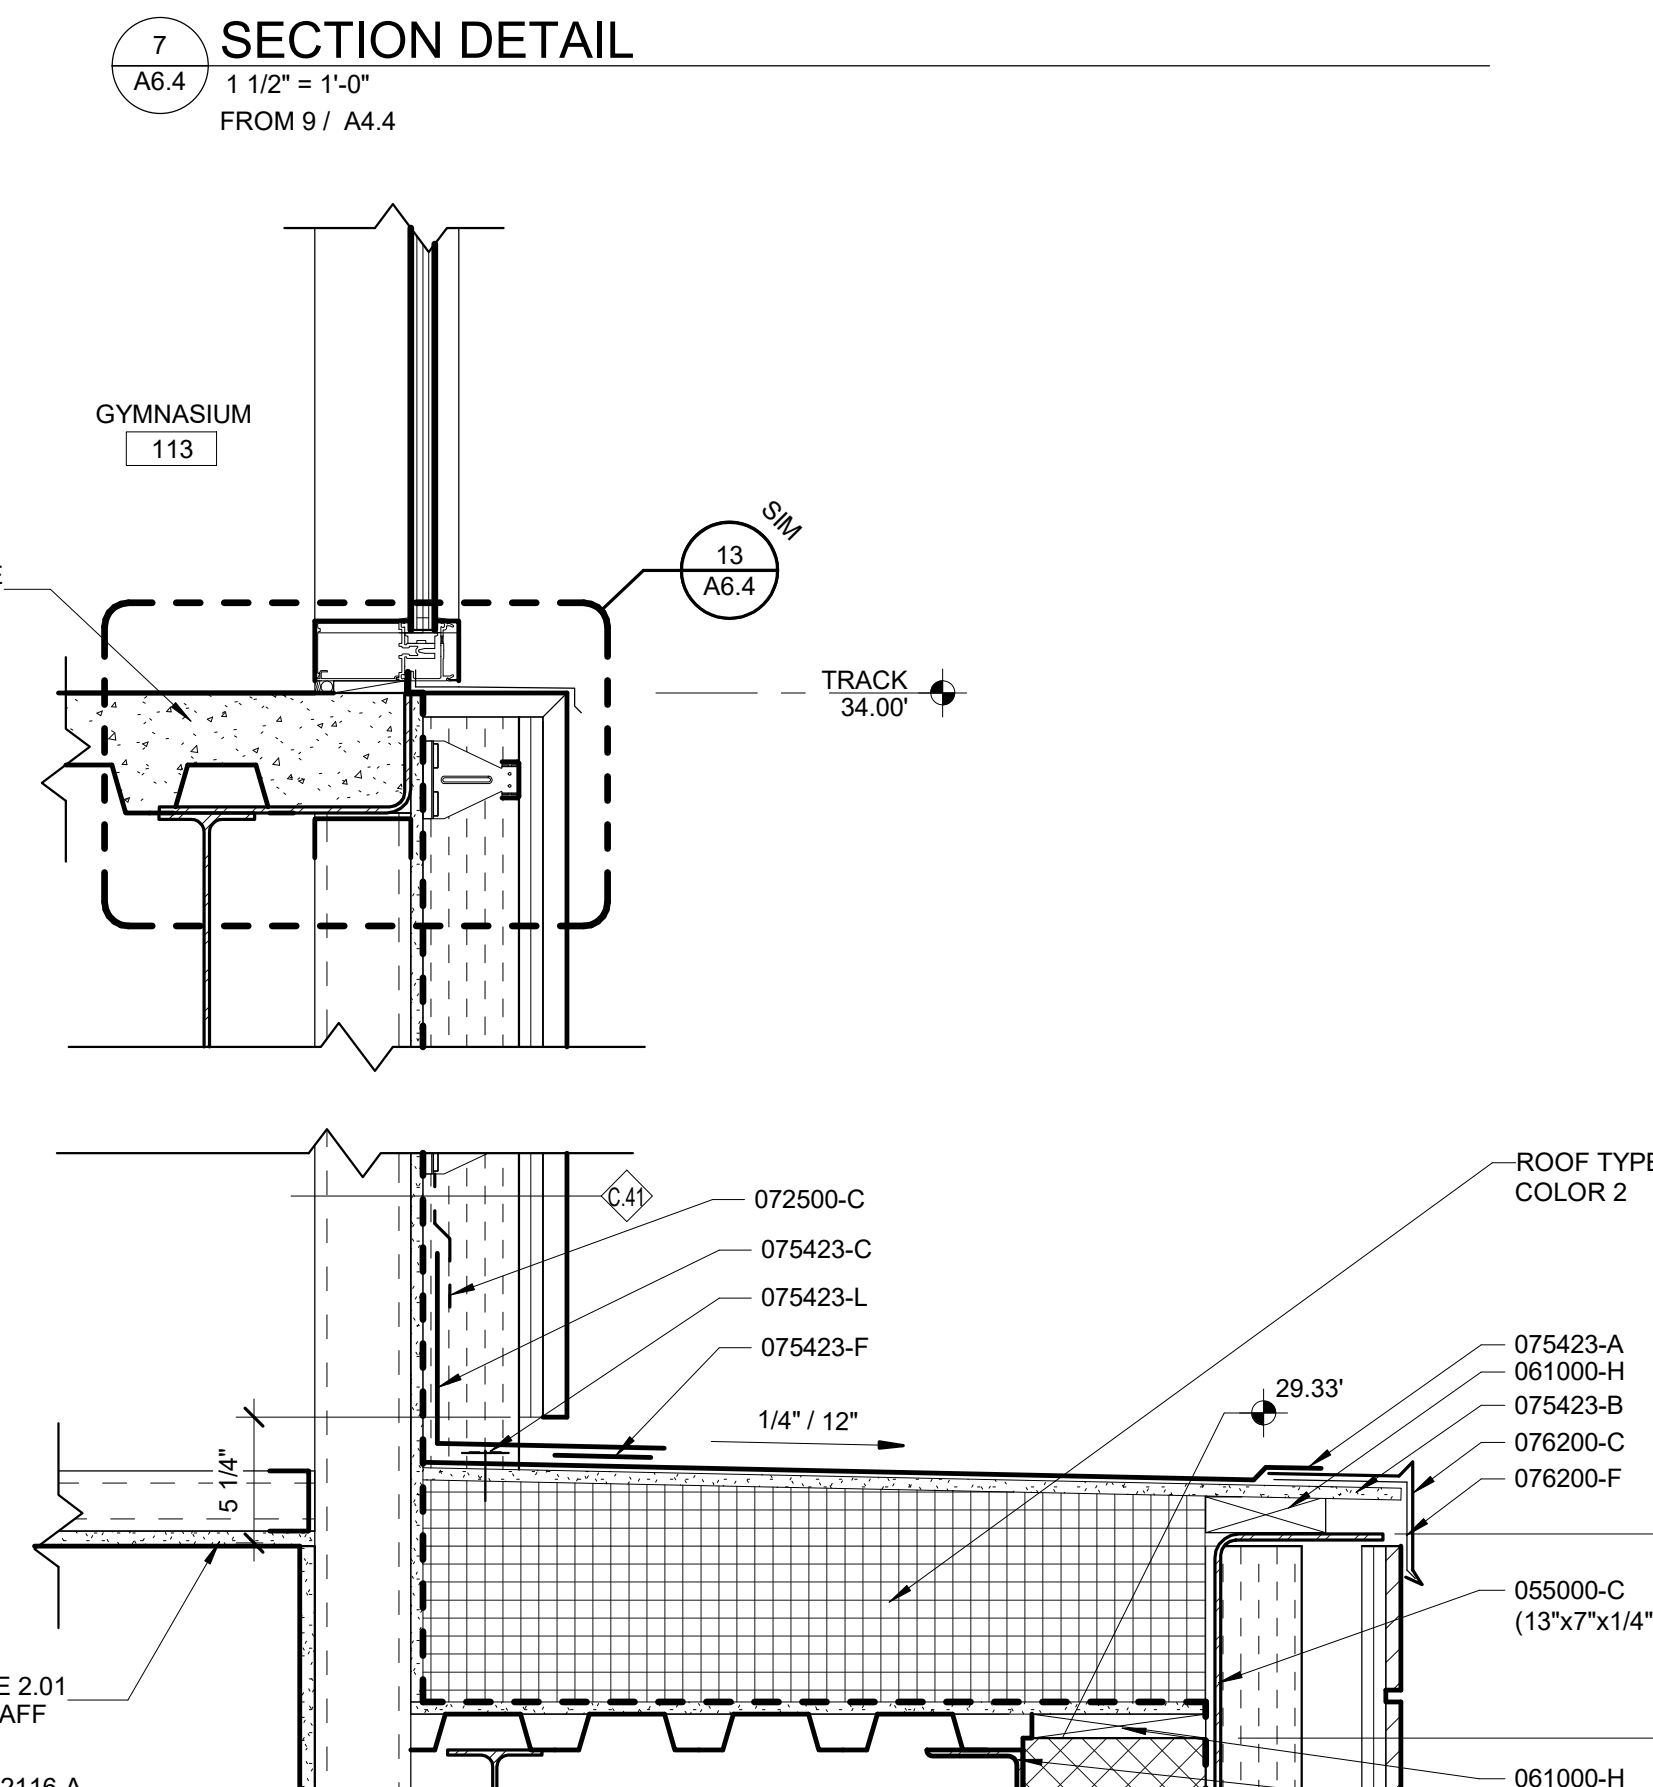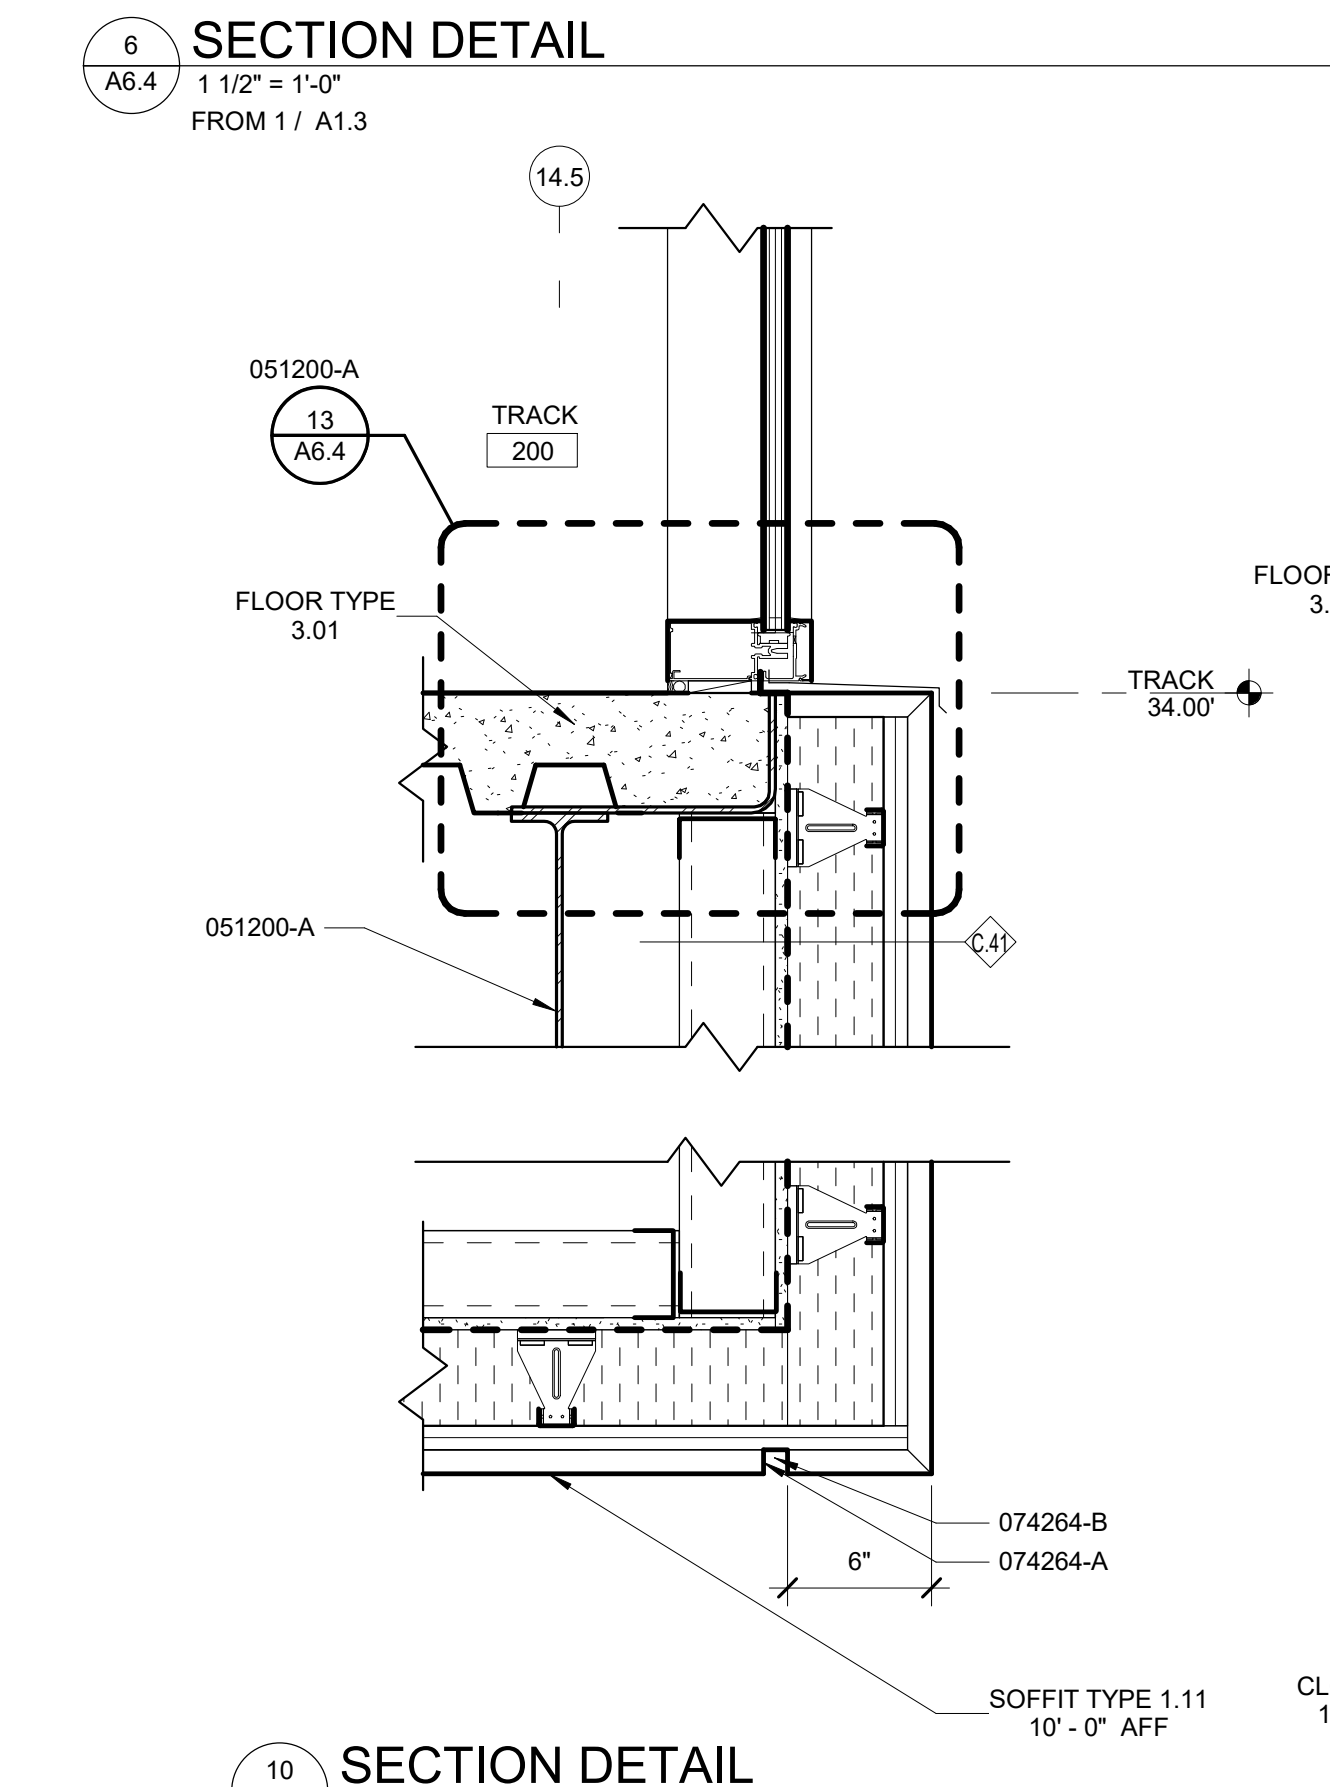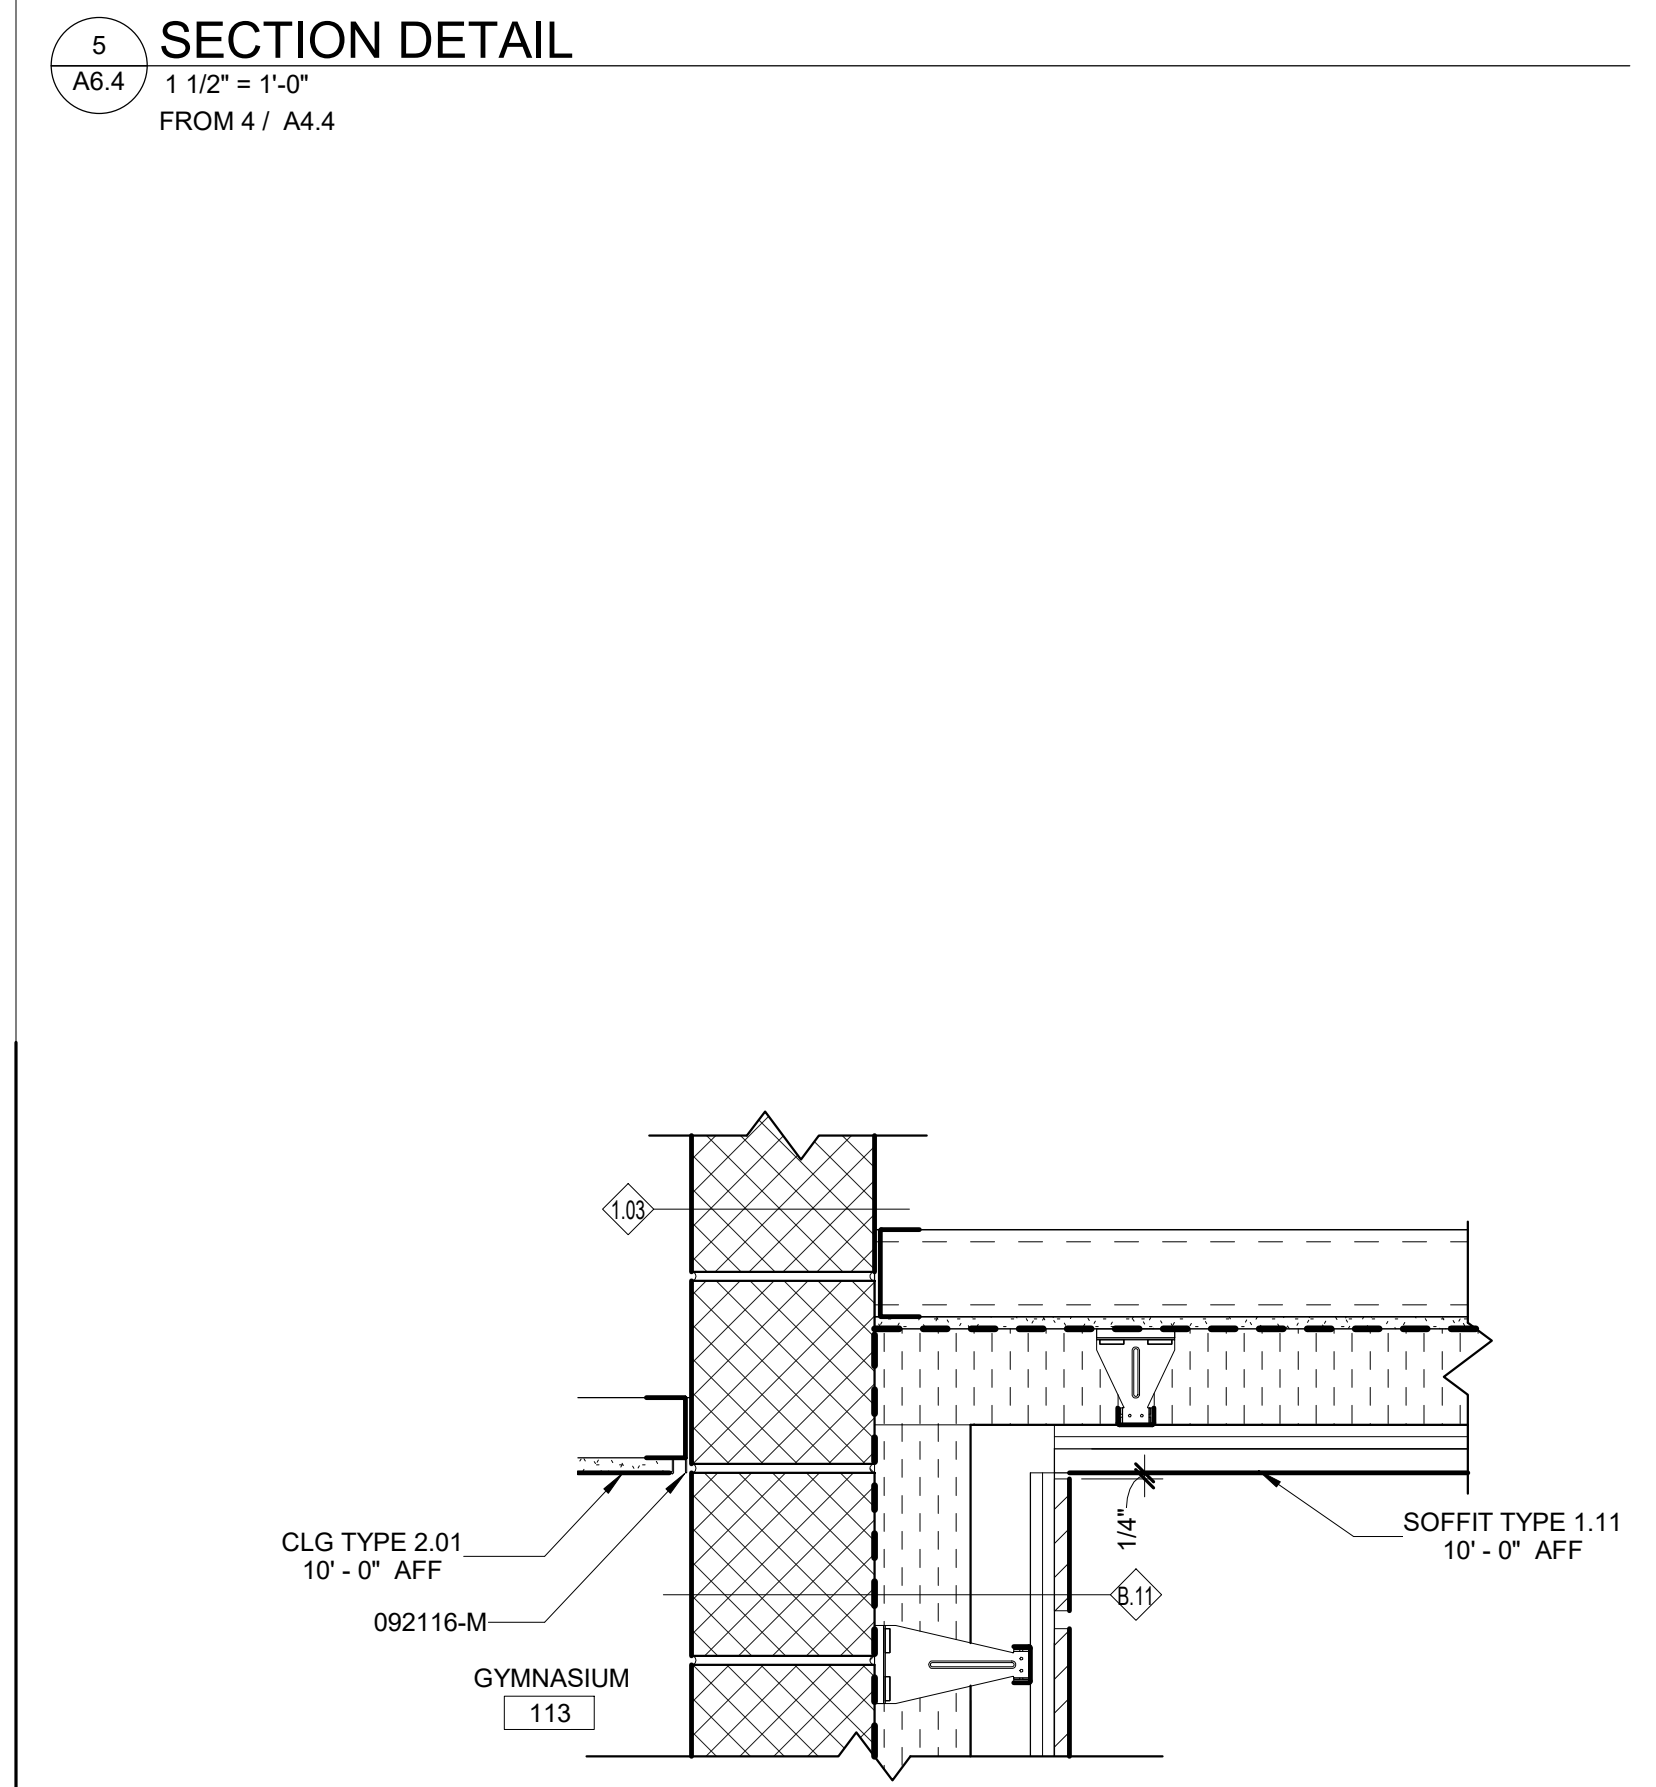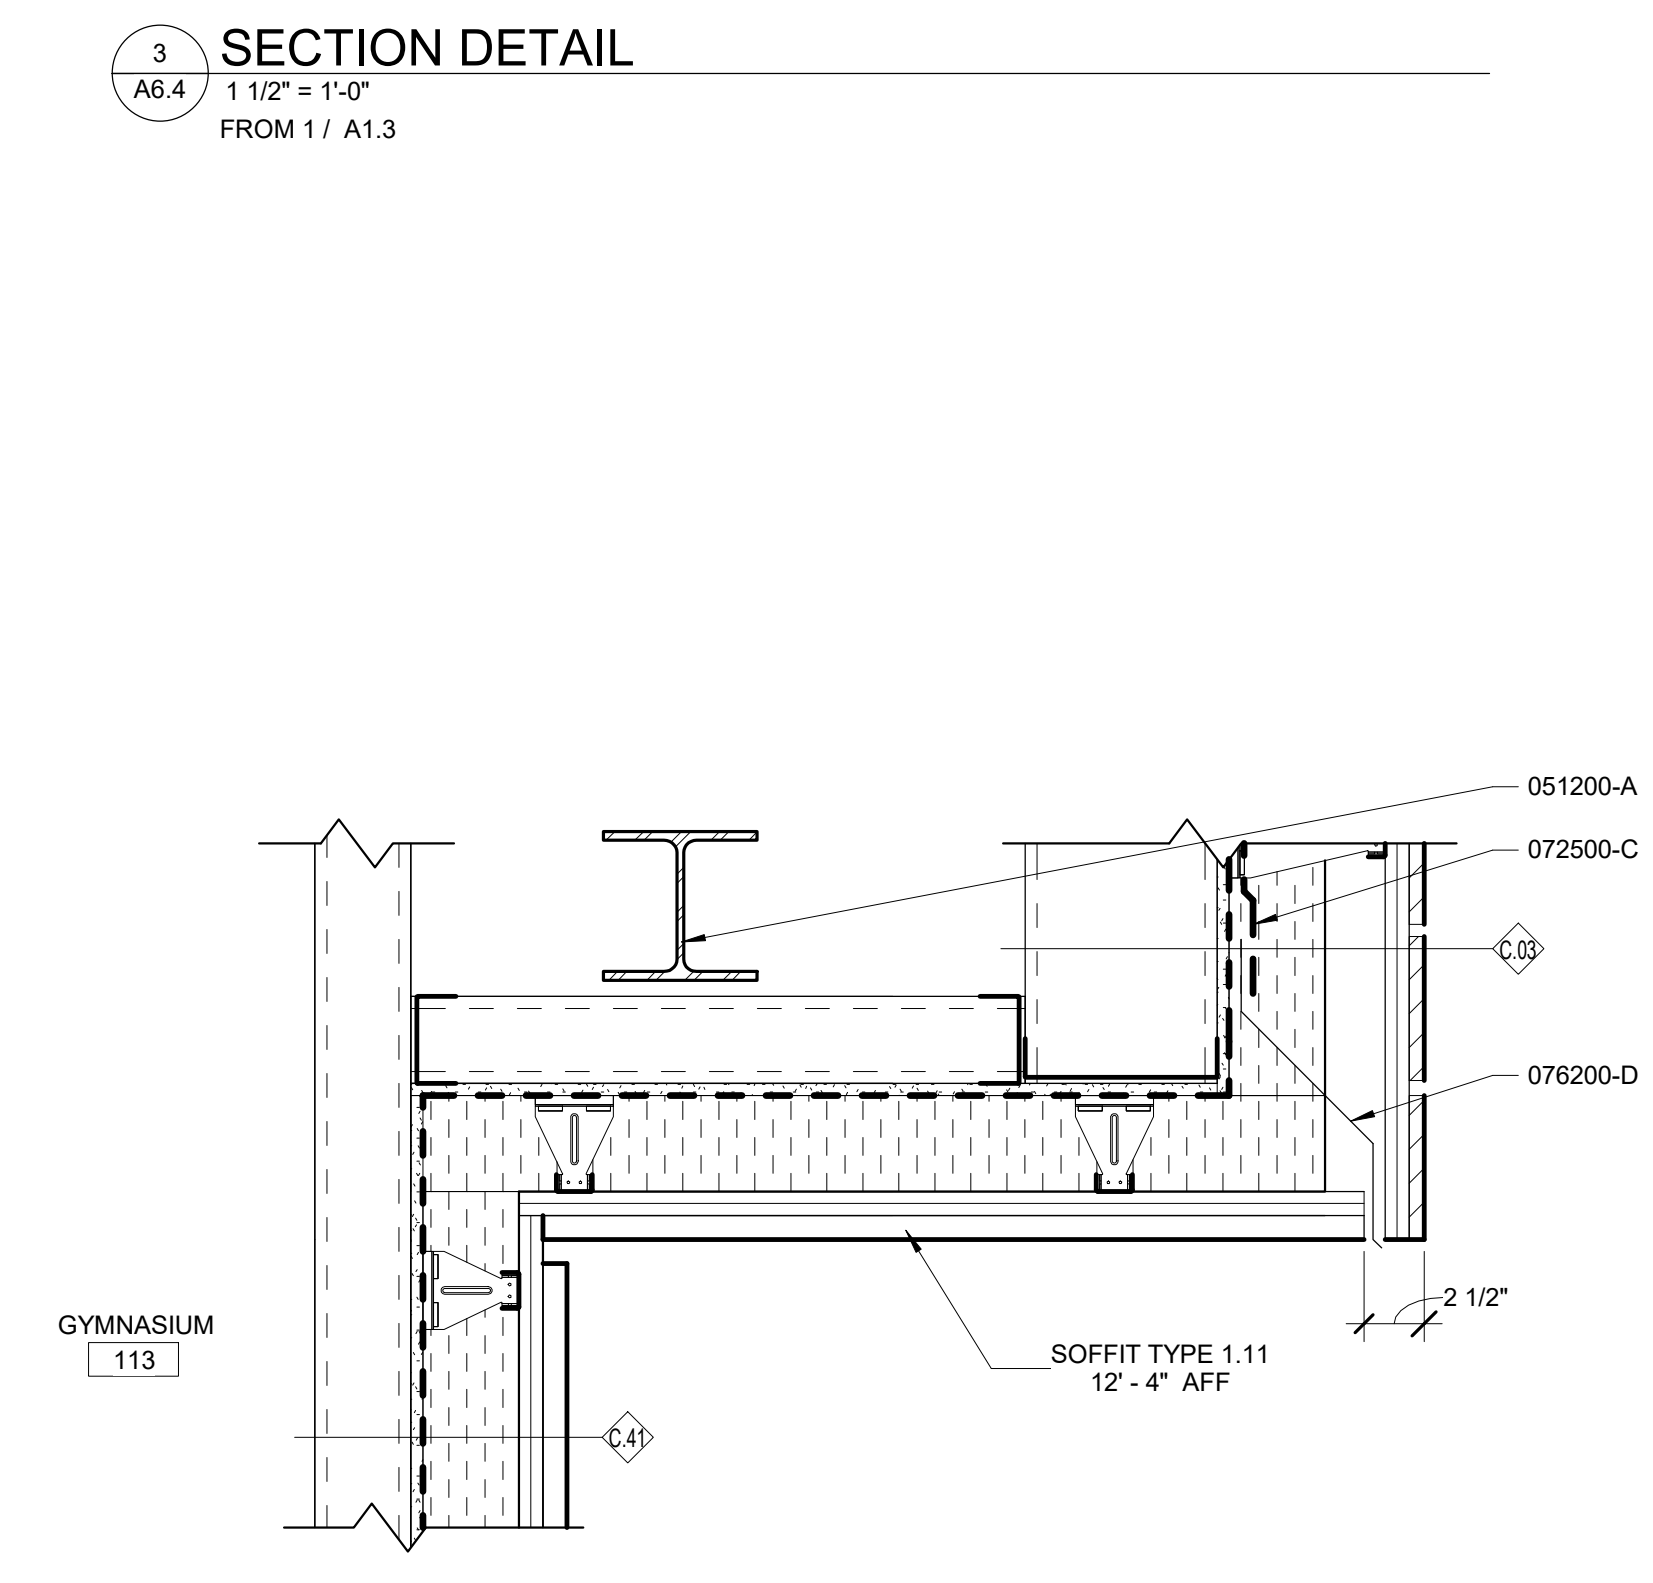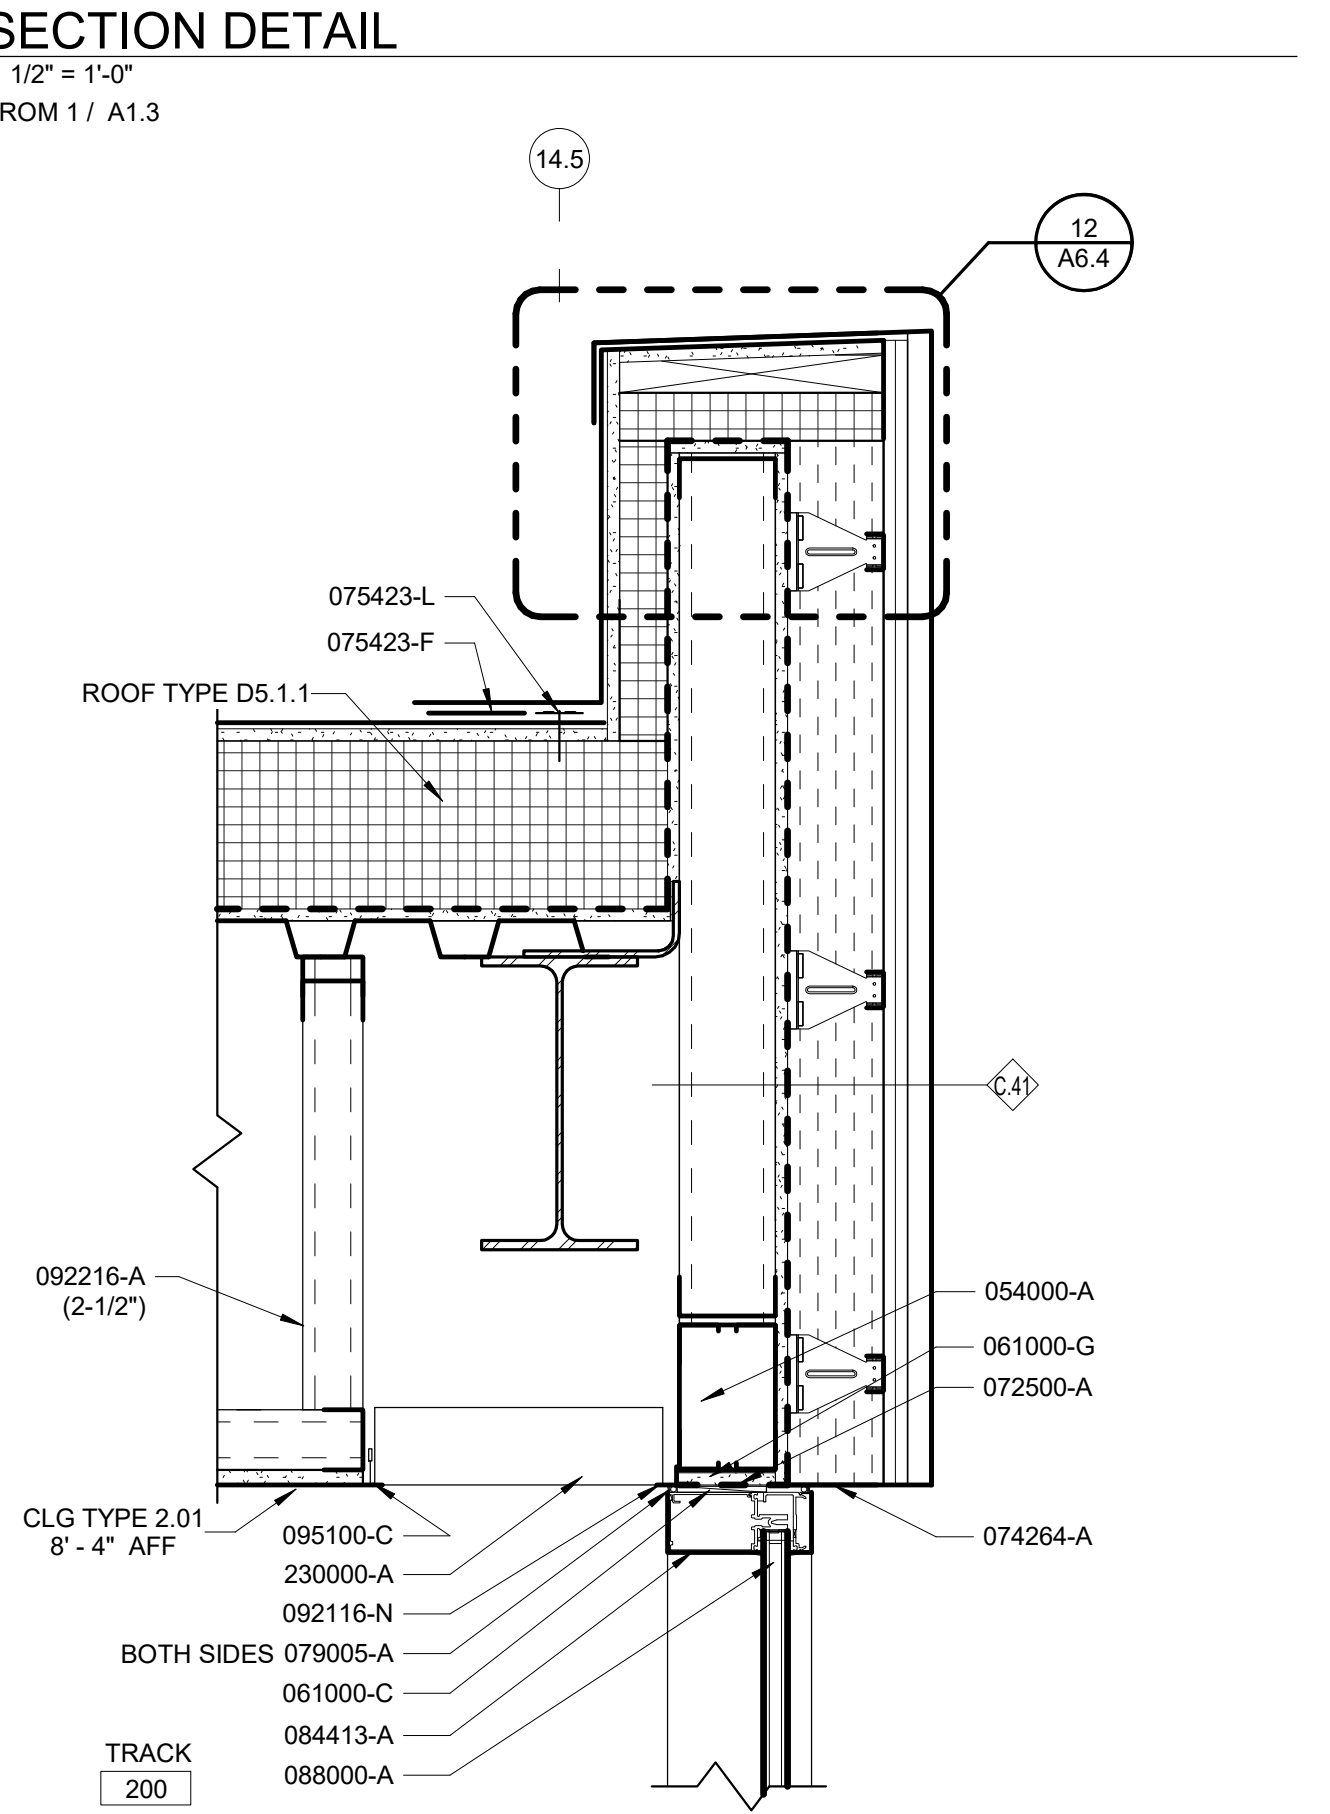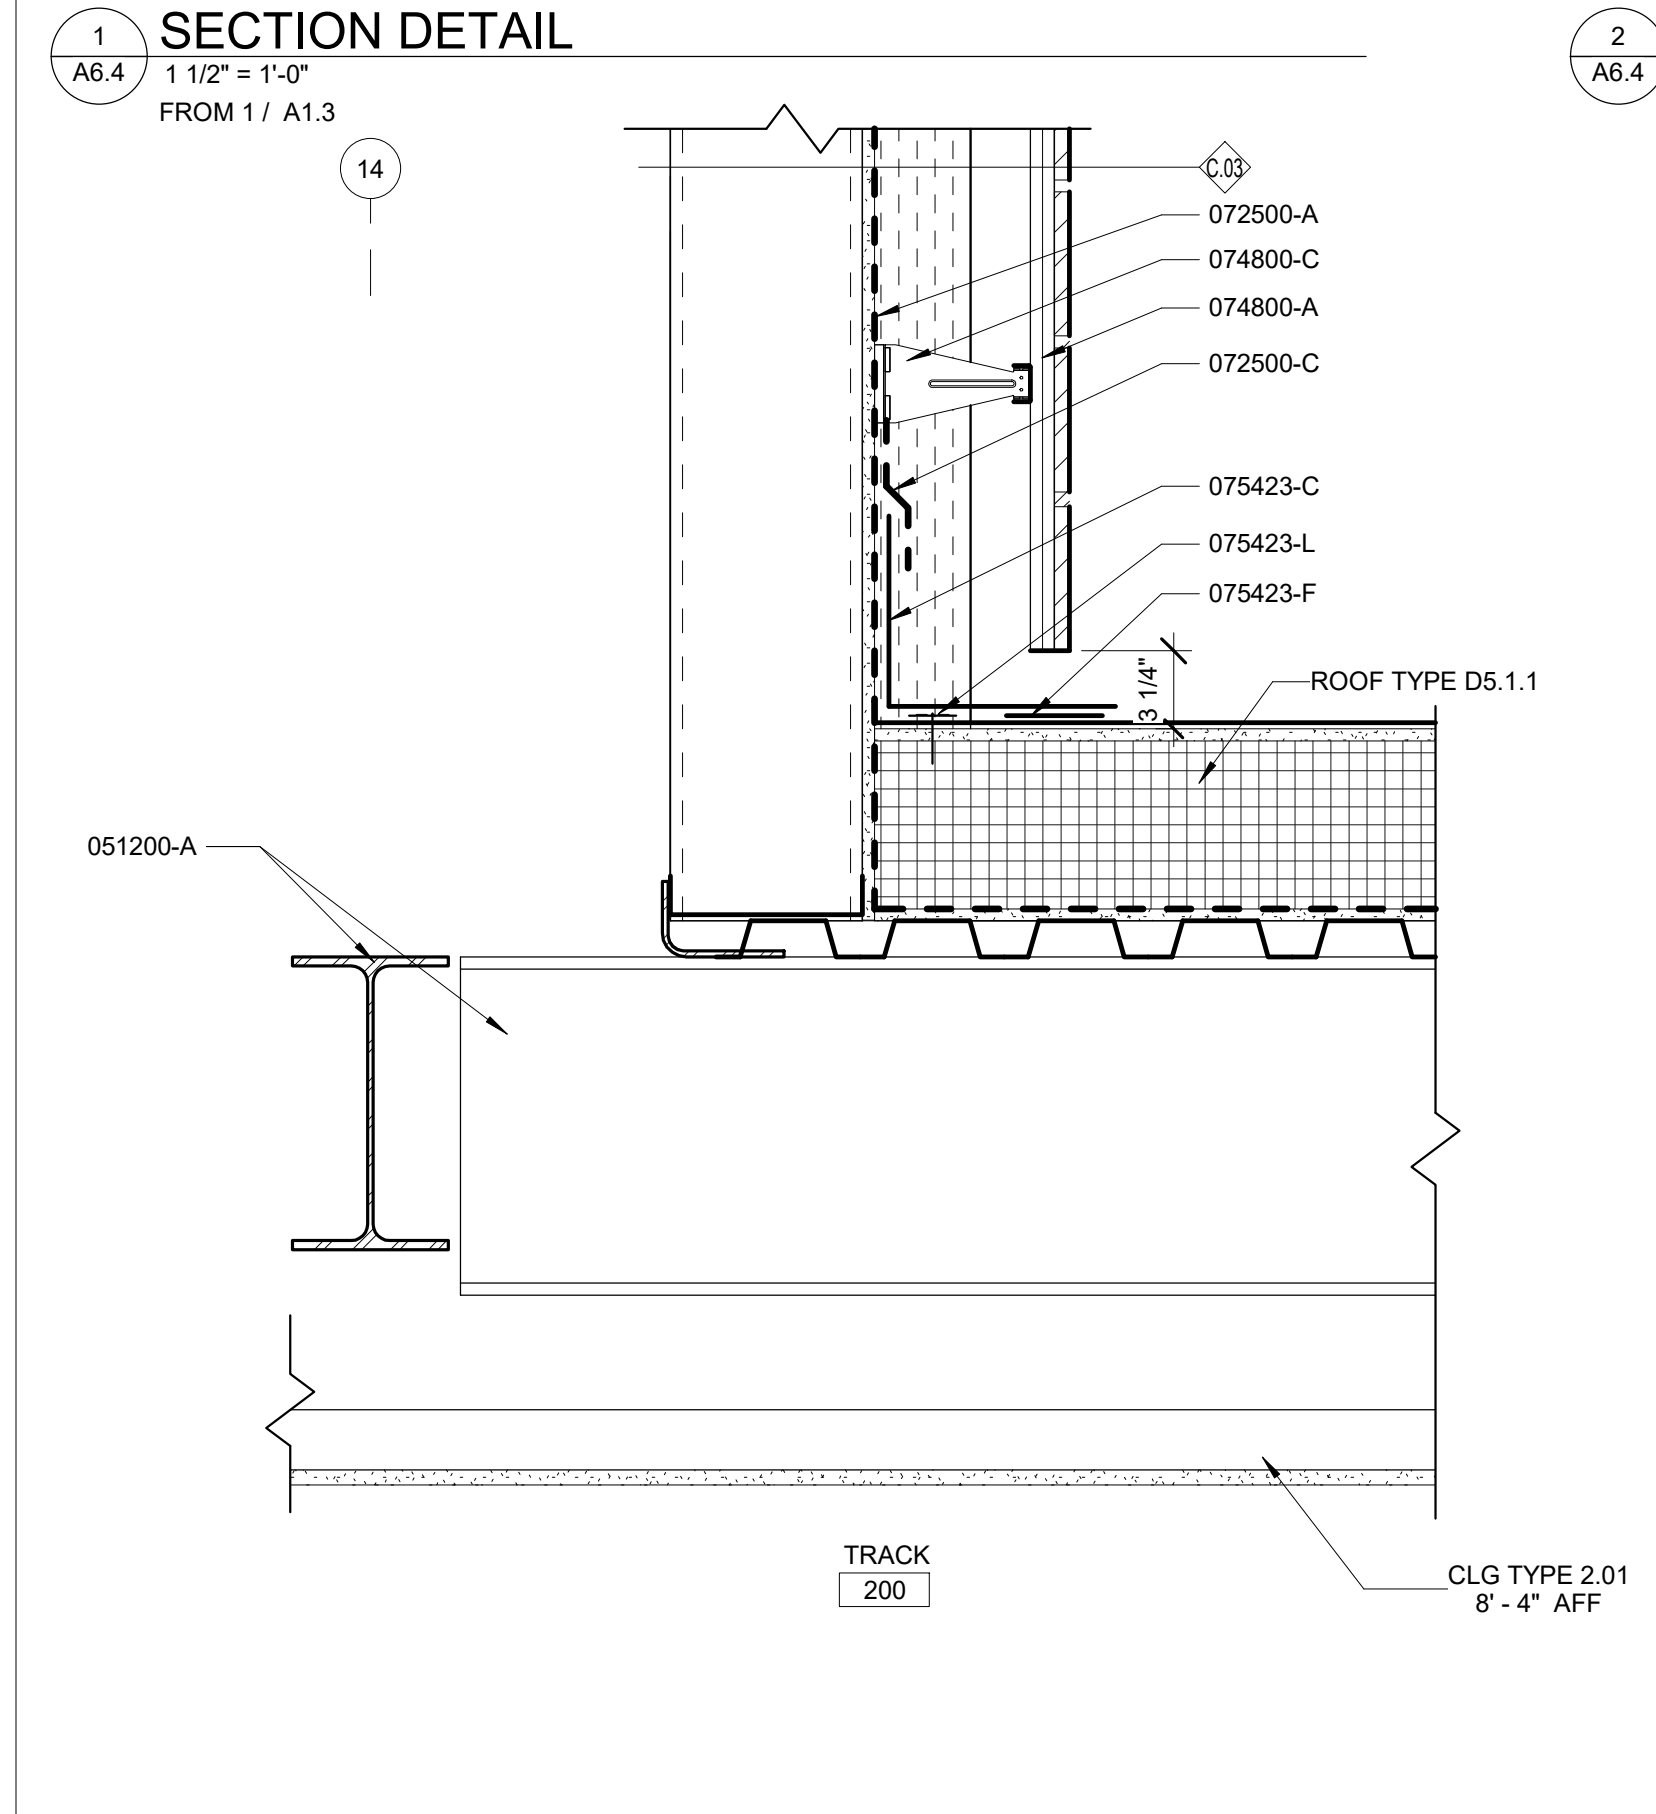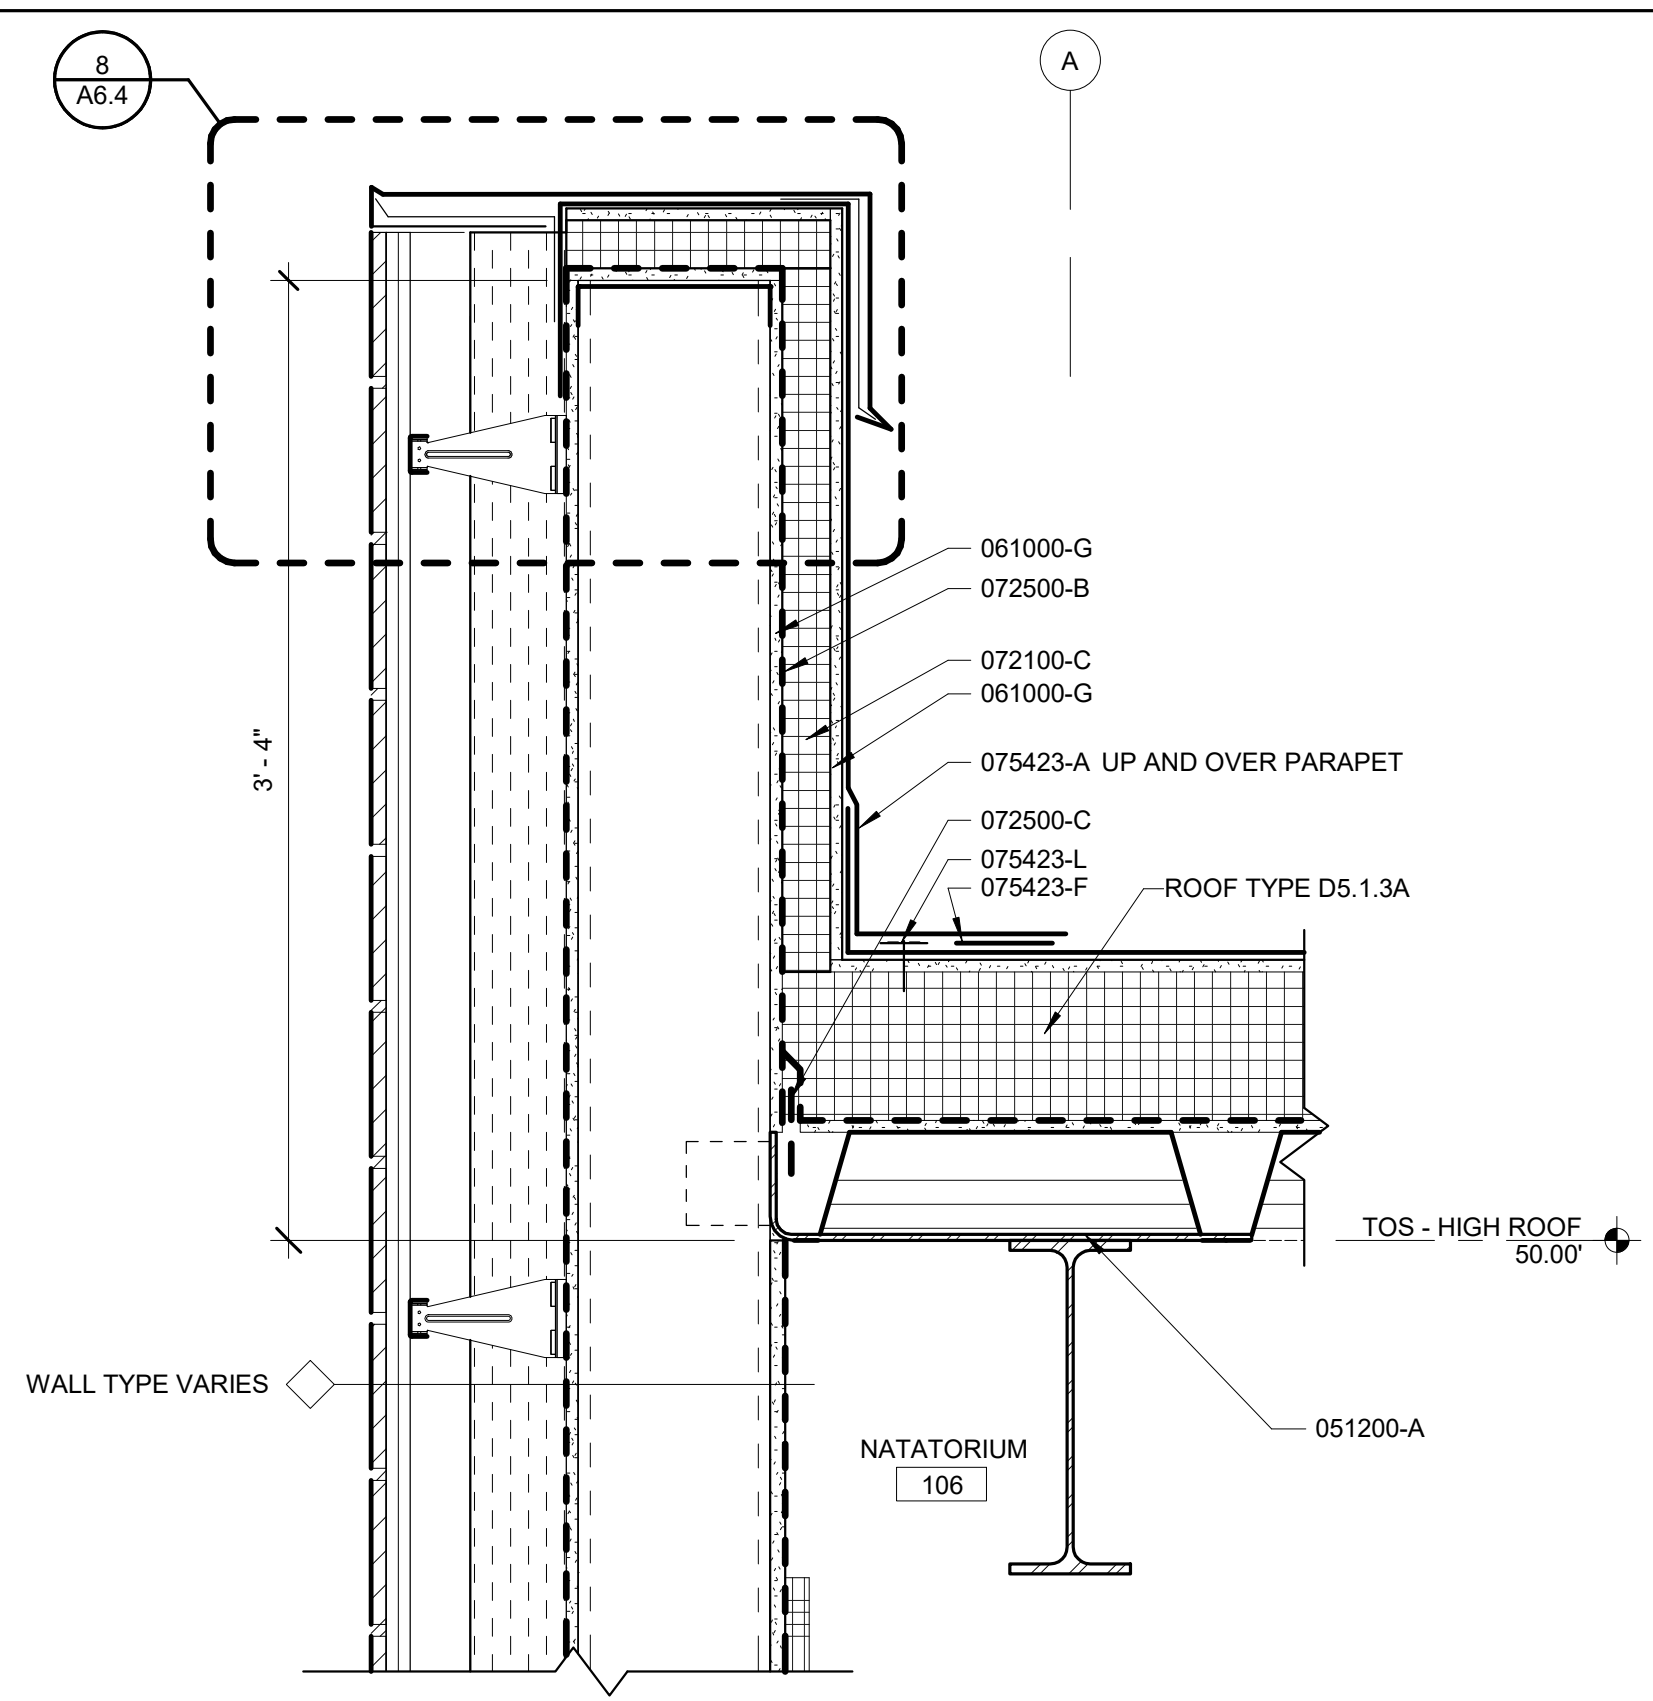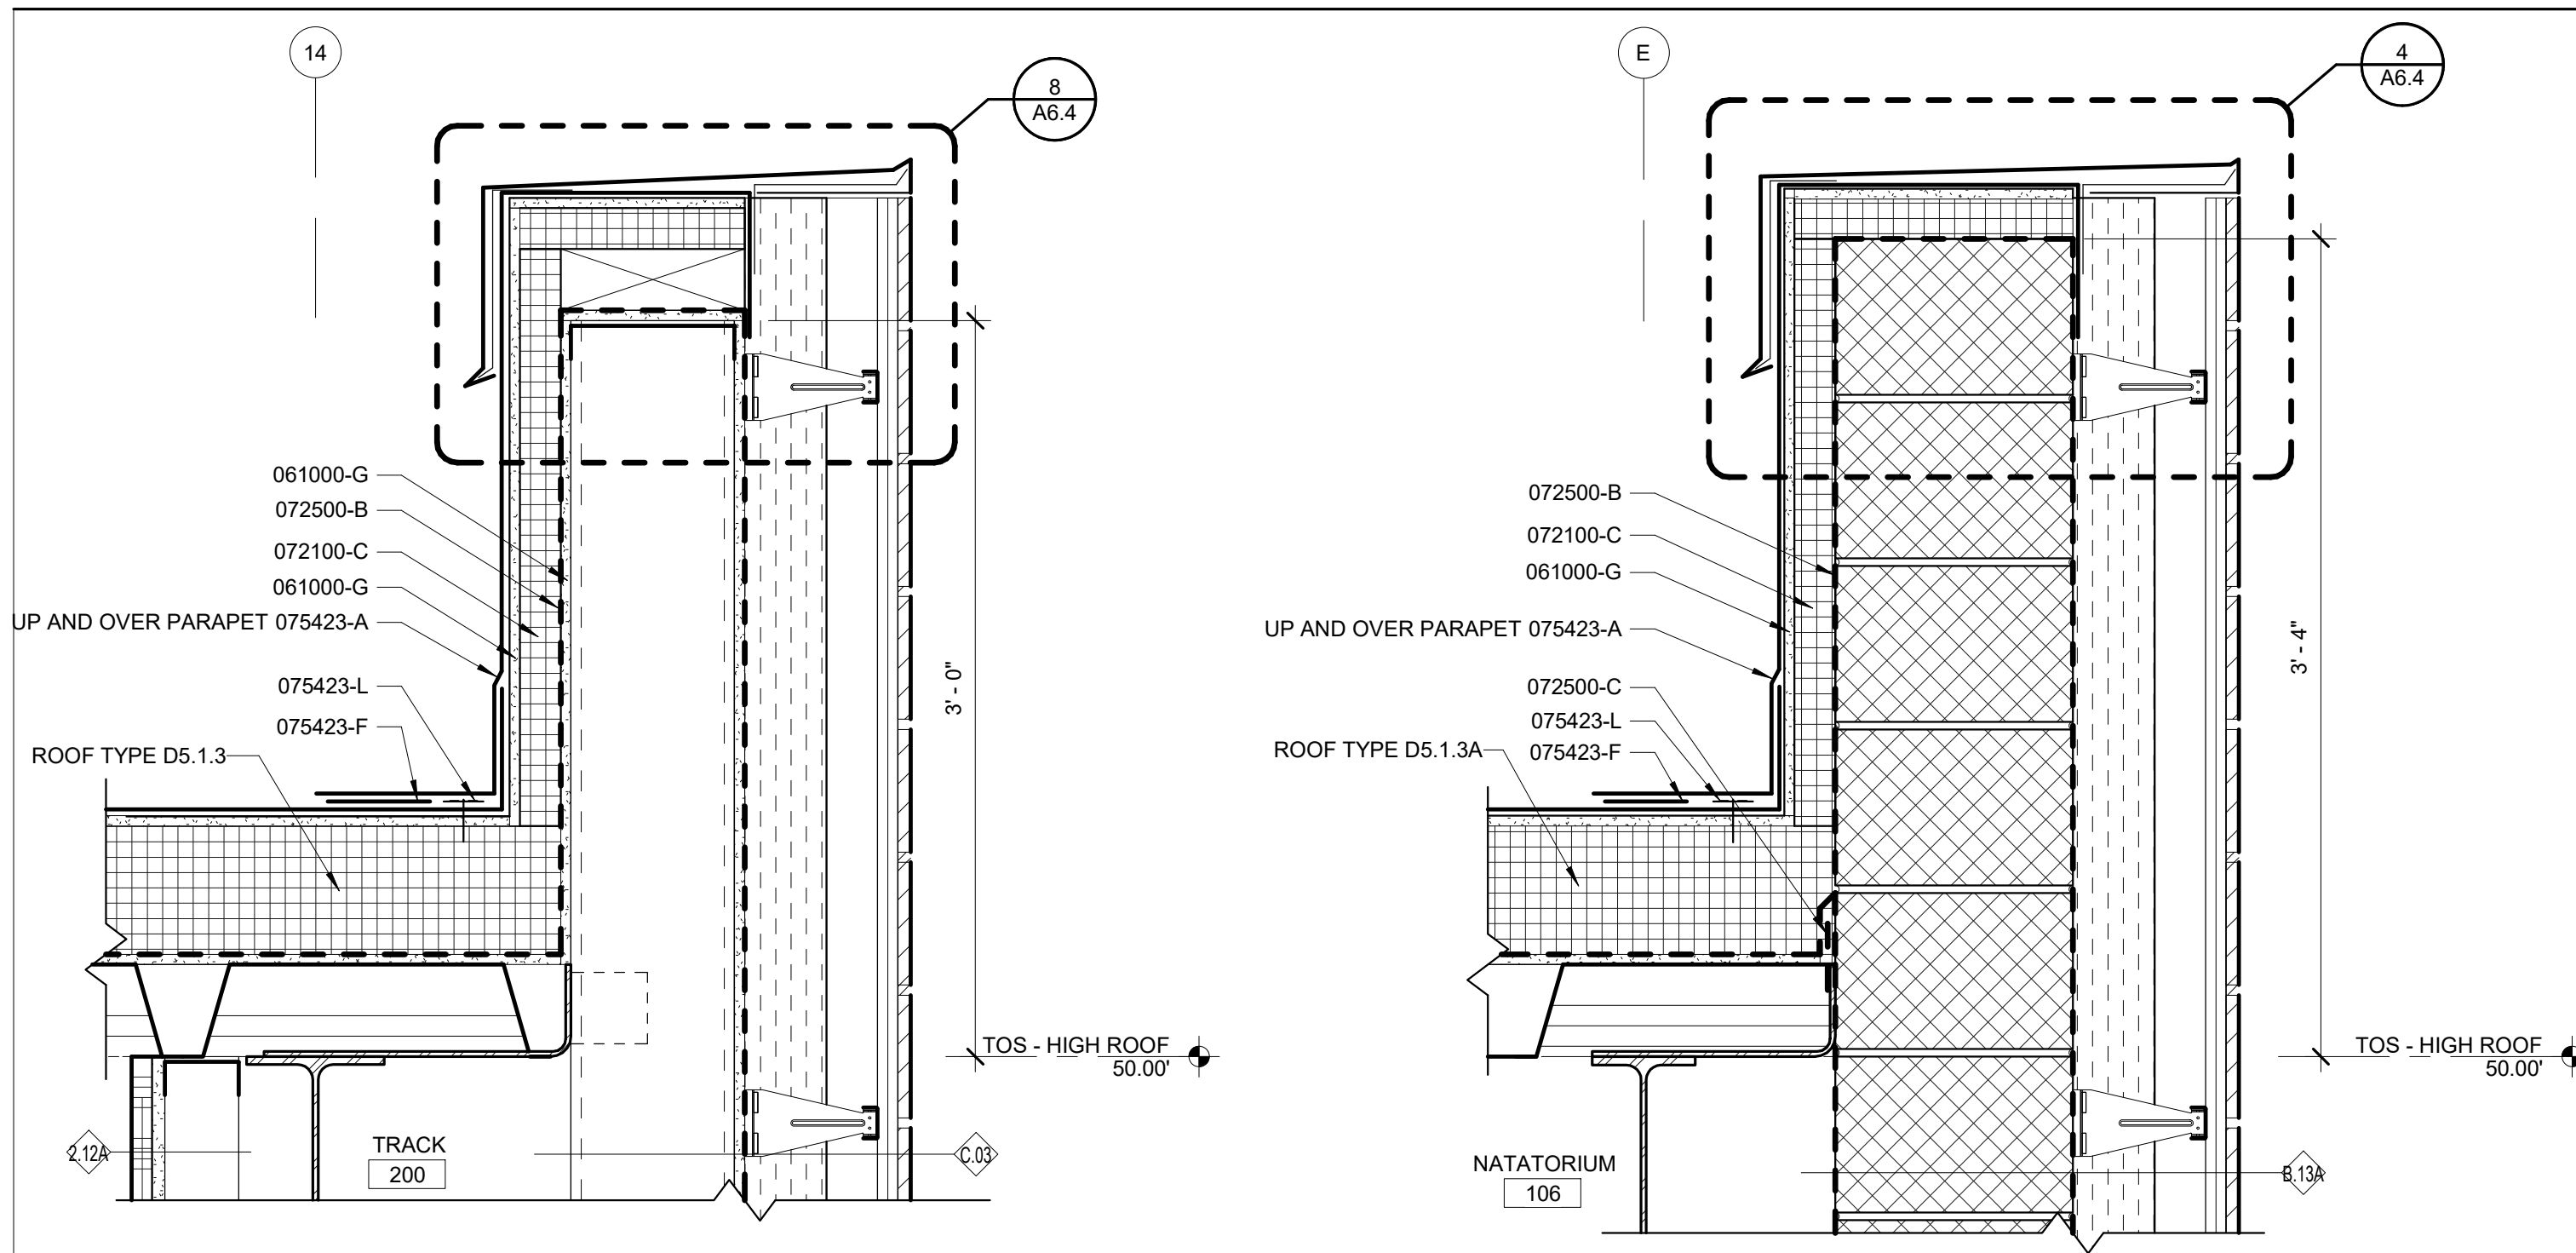


- KEY PLAN:**
- KEYNOTES LISTED ON THIS SHEET ARE FOR CONVENIENCE ONLY. REFER TO SHEET CS.2 FOR COMPLETE LIST**
- 051200-A STRUCTURAL STEEL (REFER TO STRUCTURAL FOR MORE INFORMATION)
 - 054000-A COLD-FORMED STEEL FRAMING, SIZE AS INDICATED
 - 055000-C STEEL BENT PLATE, SIZE AS INDICATED
 - 061000-C SHIM
 - 061000-G EXTERIOR GYPSUM SHEATHING, 1/2" UNO
 - 061000-H FIRE-RETARDANT TREATED BLOCKING
 - 072100-C RIGID INSULATION BOARD, 2" THICK UNO
 - 072500-A VAPOR-PERMEABLE, AIRWATER-RESISTIVE BARRIER
 - 072500-B VAPOR-IMPERMEABLE, AIRWATER-RESISTIVE BARRIER
 - 072500-C TRANSITION MEMBRANE
 - 074264-A ALUMINUM COMPOSITE PANEL
 - 074264-B ALUMINUM COMPOSITE PANEL REVEAL
 - 074800-A VERTICAL RAIL
 - 074800-C THERMAL BRACKET
 - 075423-A TPO ROOFING
 - 075423-B COVER BOARD
 - 075423-C TPO FLASHING
 - 075423-F TPO SPlice TAPE
 - 075423-L FASTENER
 - 076200-C METAL COPING
 - 076200-D METAL FLASHING
 - 076200-F CONTINUOUS LOCKING METAL CLEAT
 - 079005-A JOINT SEALANT AND BACKER ROD
 - 084413-A GLAZED ALUMINUM CURTAIN WALL
 - 084413-G BRAKE METAL, FINISH TO MATCH CURTAIN WALL
 - 088000-A GLAZING, REFER TO A8 SERIES FOR GL TYPE
 - 092116-A GYPSUM BOARD, ABUSE AND MOISTURE RESISTANT, 5/8" THICKNESS UNO
 - 092116-M METAL "F" REVEAL MOLDING, FRY REGLET DRMF 625-50 OR EQUAL
 - 092116-N METAL CORNER BEAD
 - 092216-A NON-STRUCTURAL METAL STUD, SIZE AS INDICATED
 - 095100-C ACOUSTICAL CEILING EDGE TRIM, "L" MOLDING MECHANICAL (REFER TO MECHANICAL FOR MORE INFORMATION)
 - 230000-A MECHANICAL (REFER TO MECHANICAL FOR MORE INFORMATION)
 - 260000-A ELECTRICAL (REFER TO ELECTRICAL FOR MORE INFORMATION)

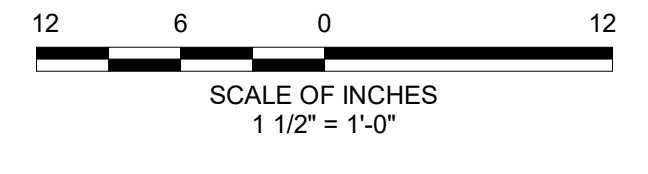

ISSUED FOR BID

Seal: _____

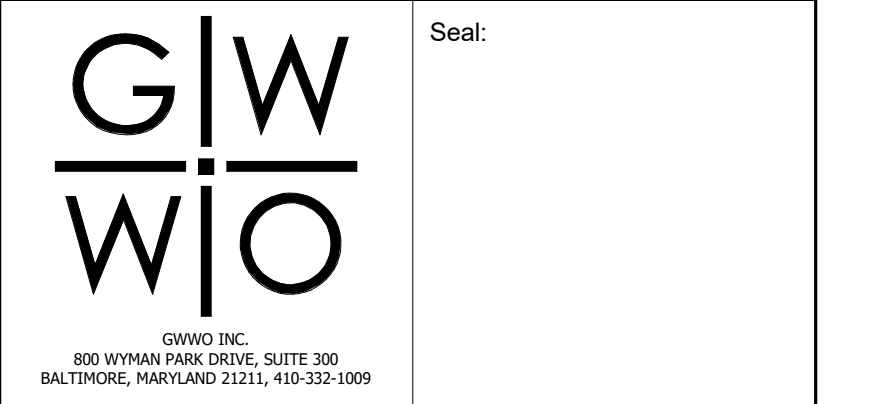


I CERTIFY THAT THESE DOCUMENTS WERE PREPARED OR APPROVED BY ME, AND THAT I AM A DULY LICENSED ARCHITECT UNDER THE LAWS OF THE STATE OF MARYLAND. LICENSE NUMBER: 8400, EXPIRATION DATE: 12/31/2020


Revisions:	No.	Date	Description
	2	1/28/2020	ADDENDUM 2

MIDDLE BRANCH FITNESS & WELLNESS CENTER AT CHERRY HILL
 BALTIMORE CITY RECREATION & PARKS


Job No.	#18010	KMS	Drawn
Scale	As indicated	KMS	Checked
Date	12/13/2019	AER	Approved
Drawing Title	SECTION DETAILS		
Drawing Number	A6.4r2		

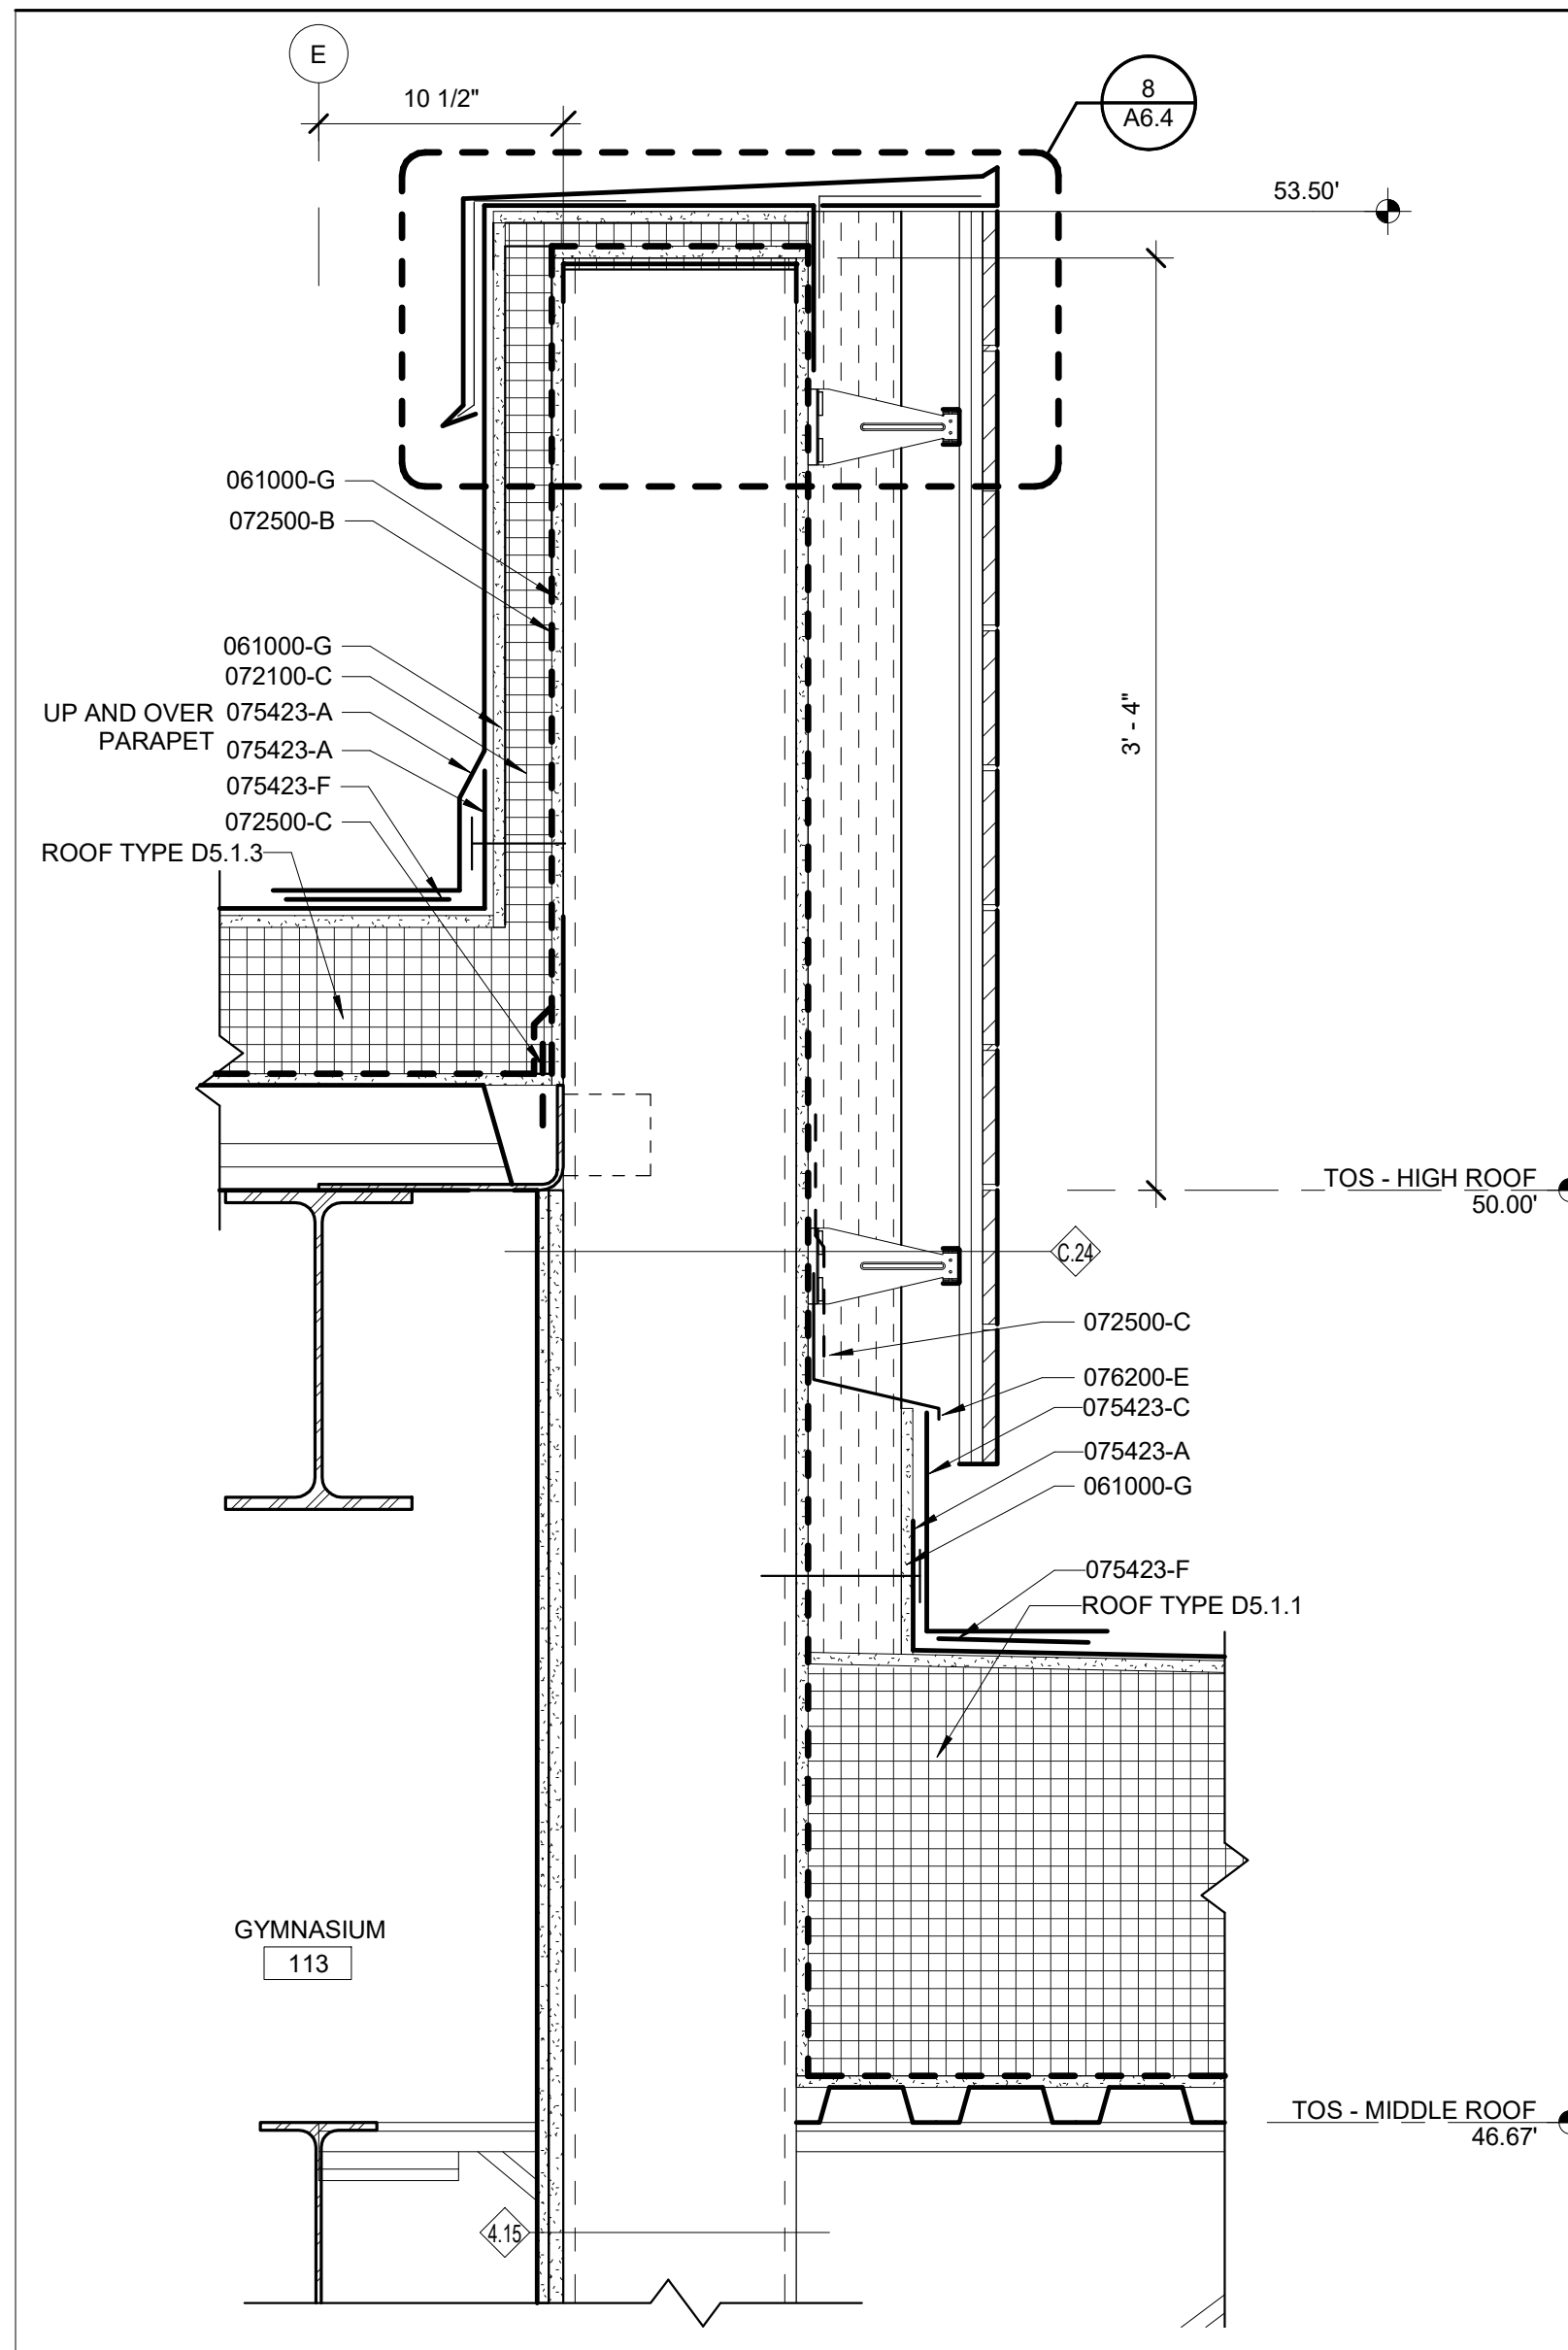


1 SECTION DETAIL
A6.5 1 1/2" = 1'-0"
FROM 1 / A1.3

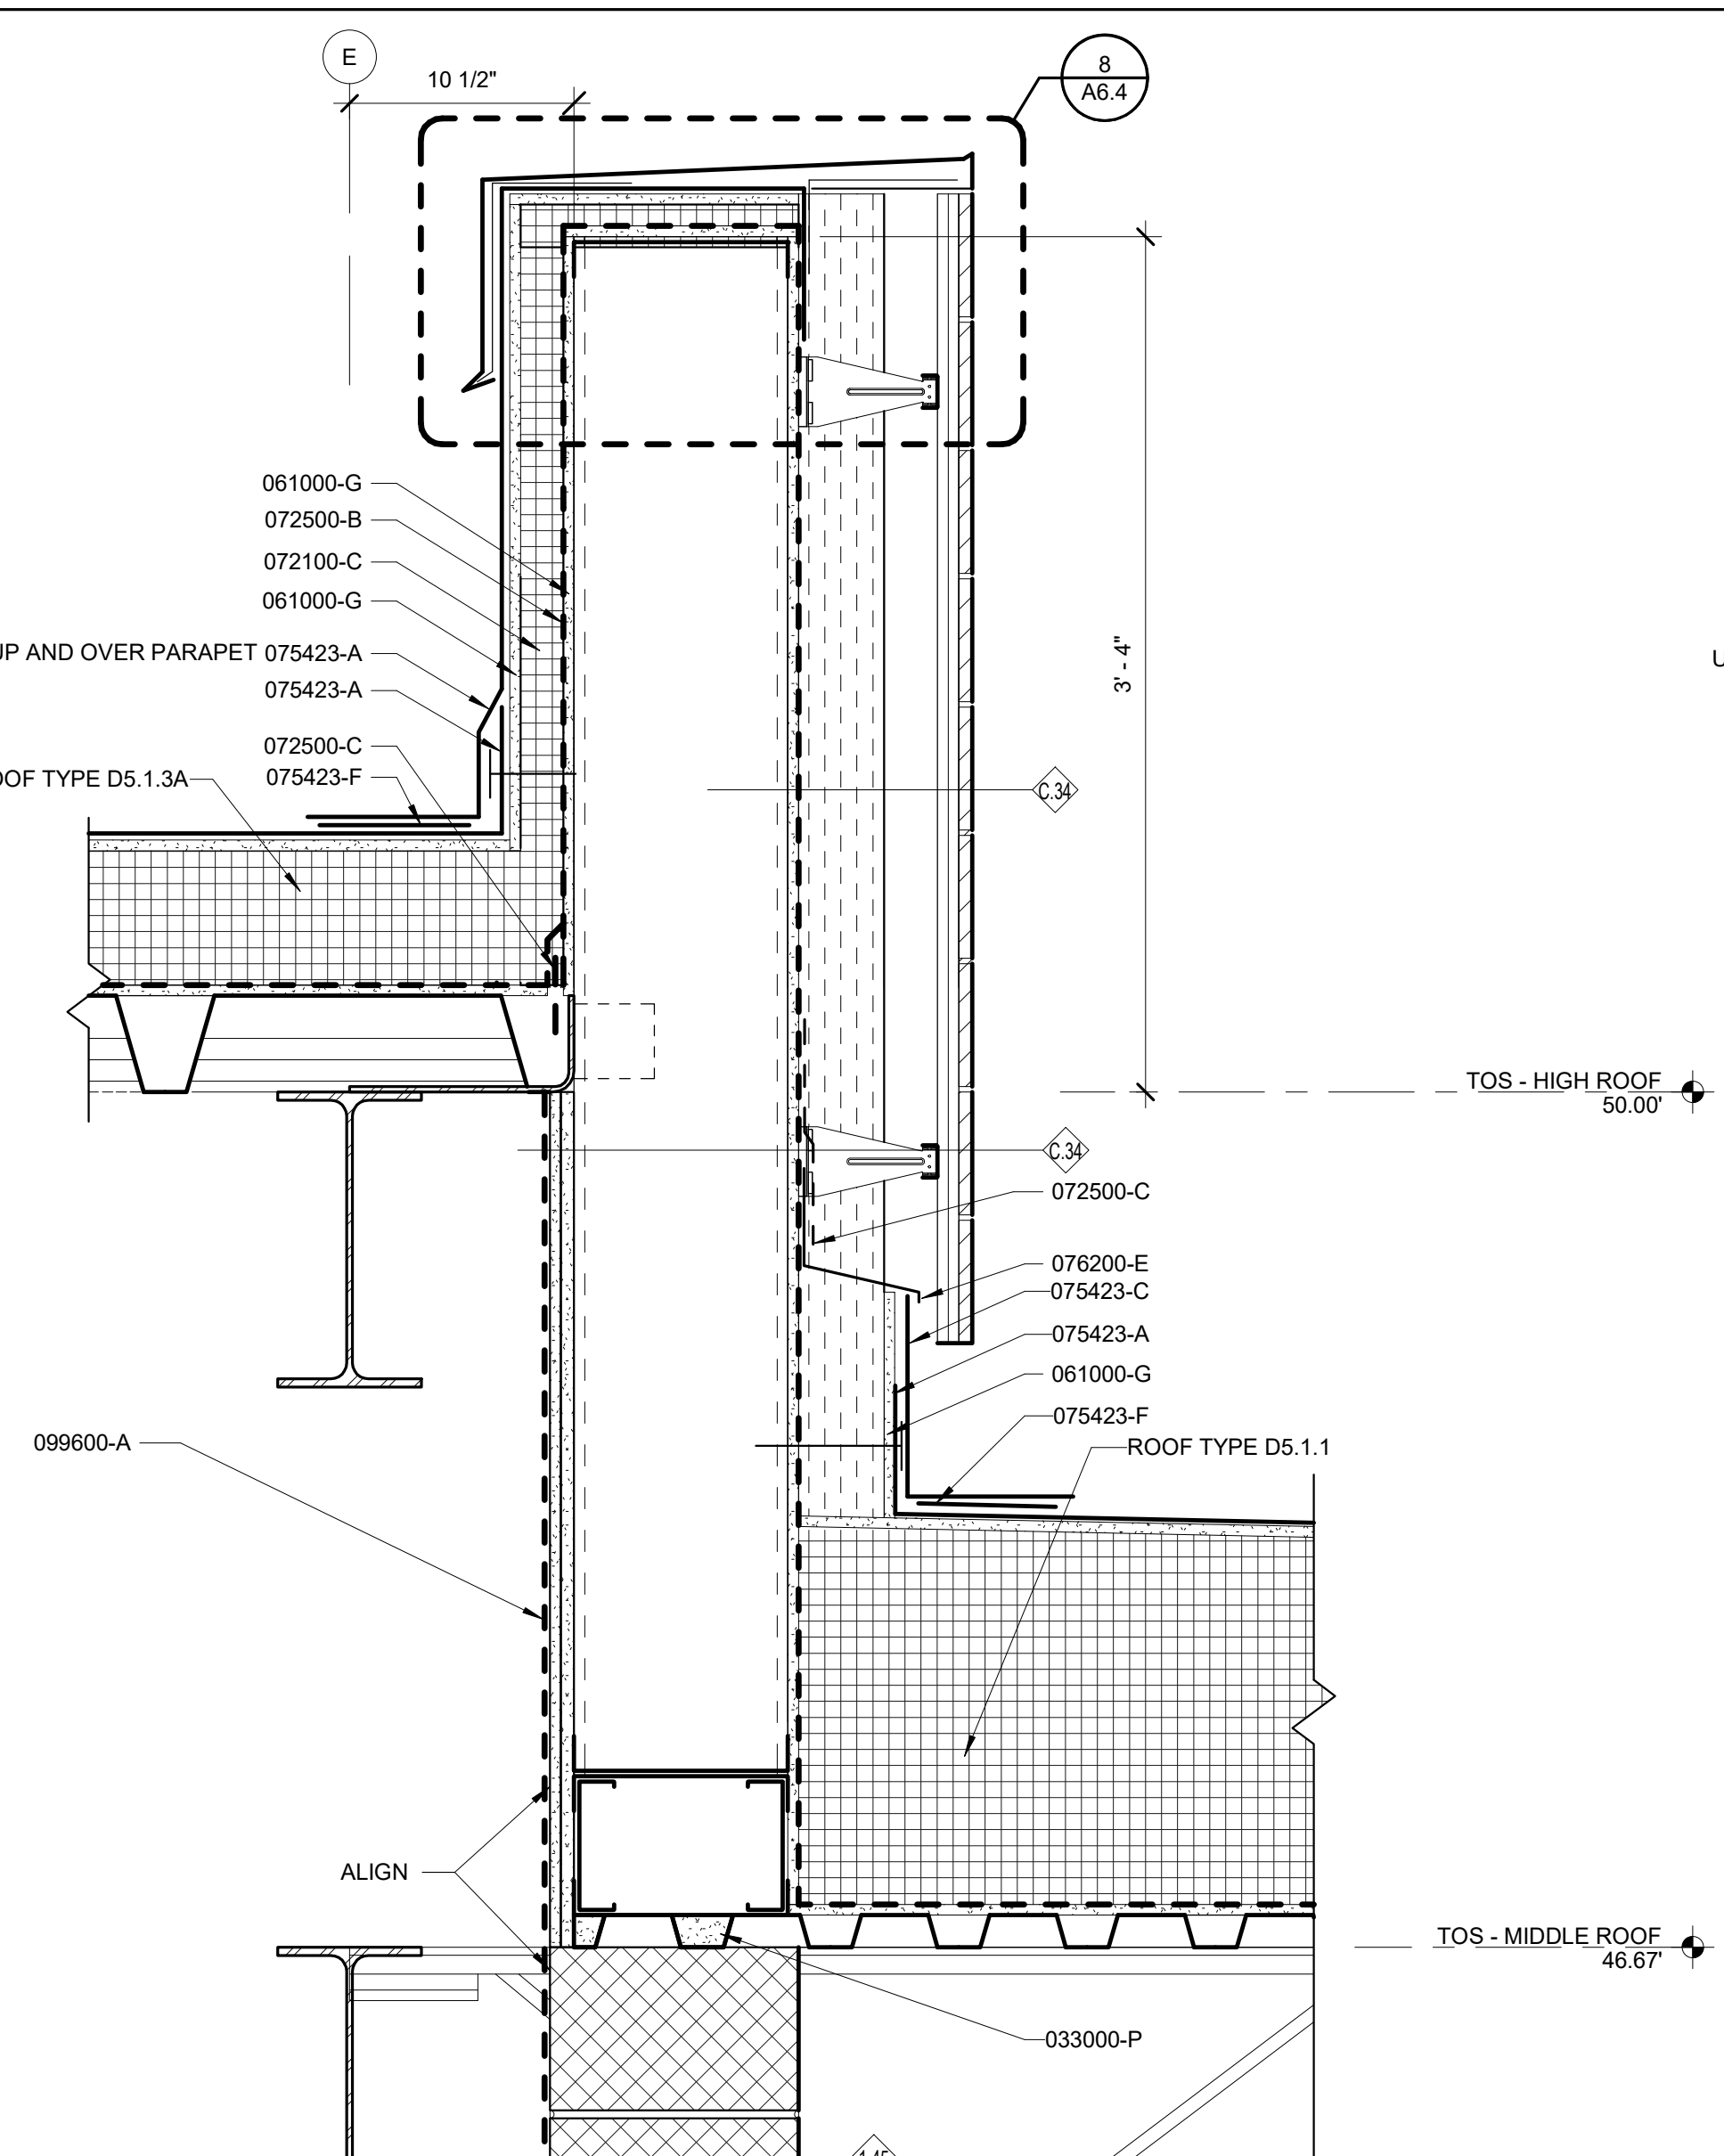

2 SECTION DETAIL
A6.5 1 1/2" = 1'-0"
FROM 3 / A4.5


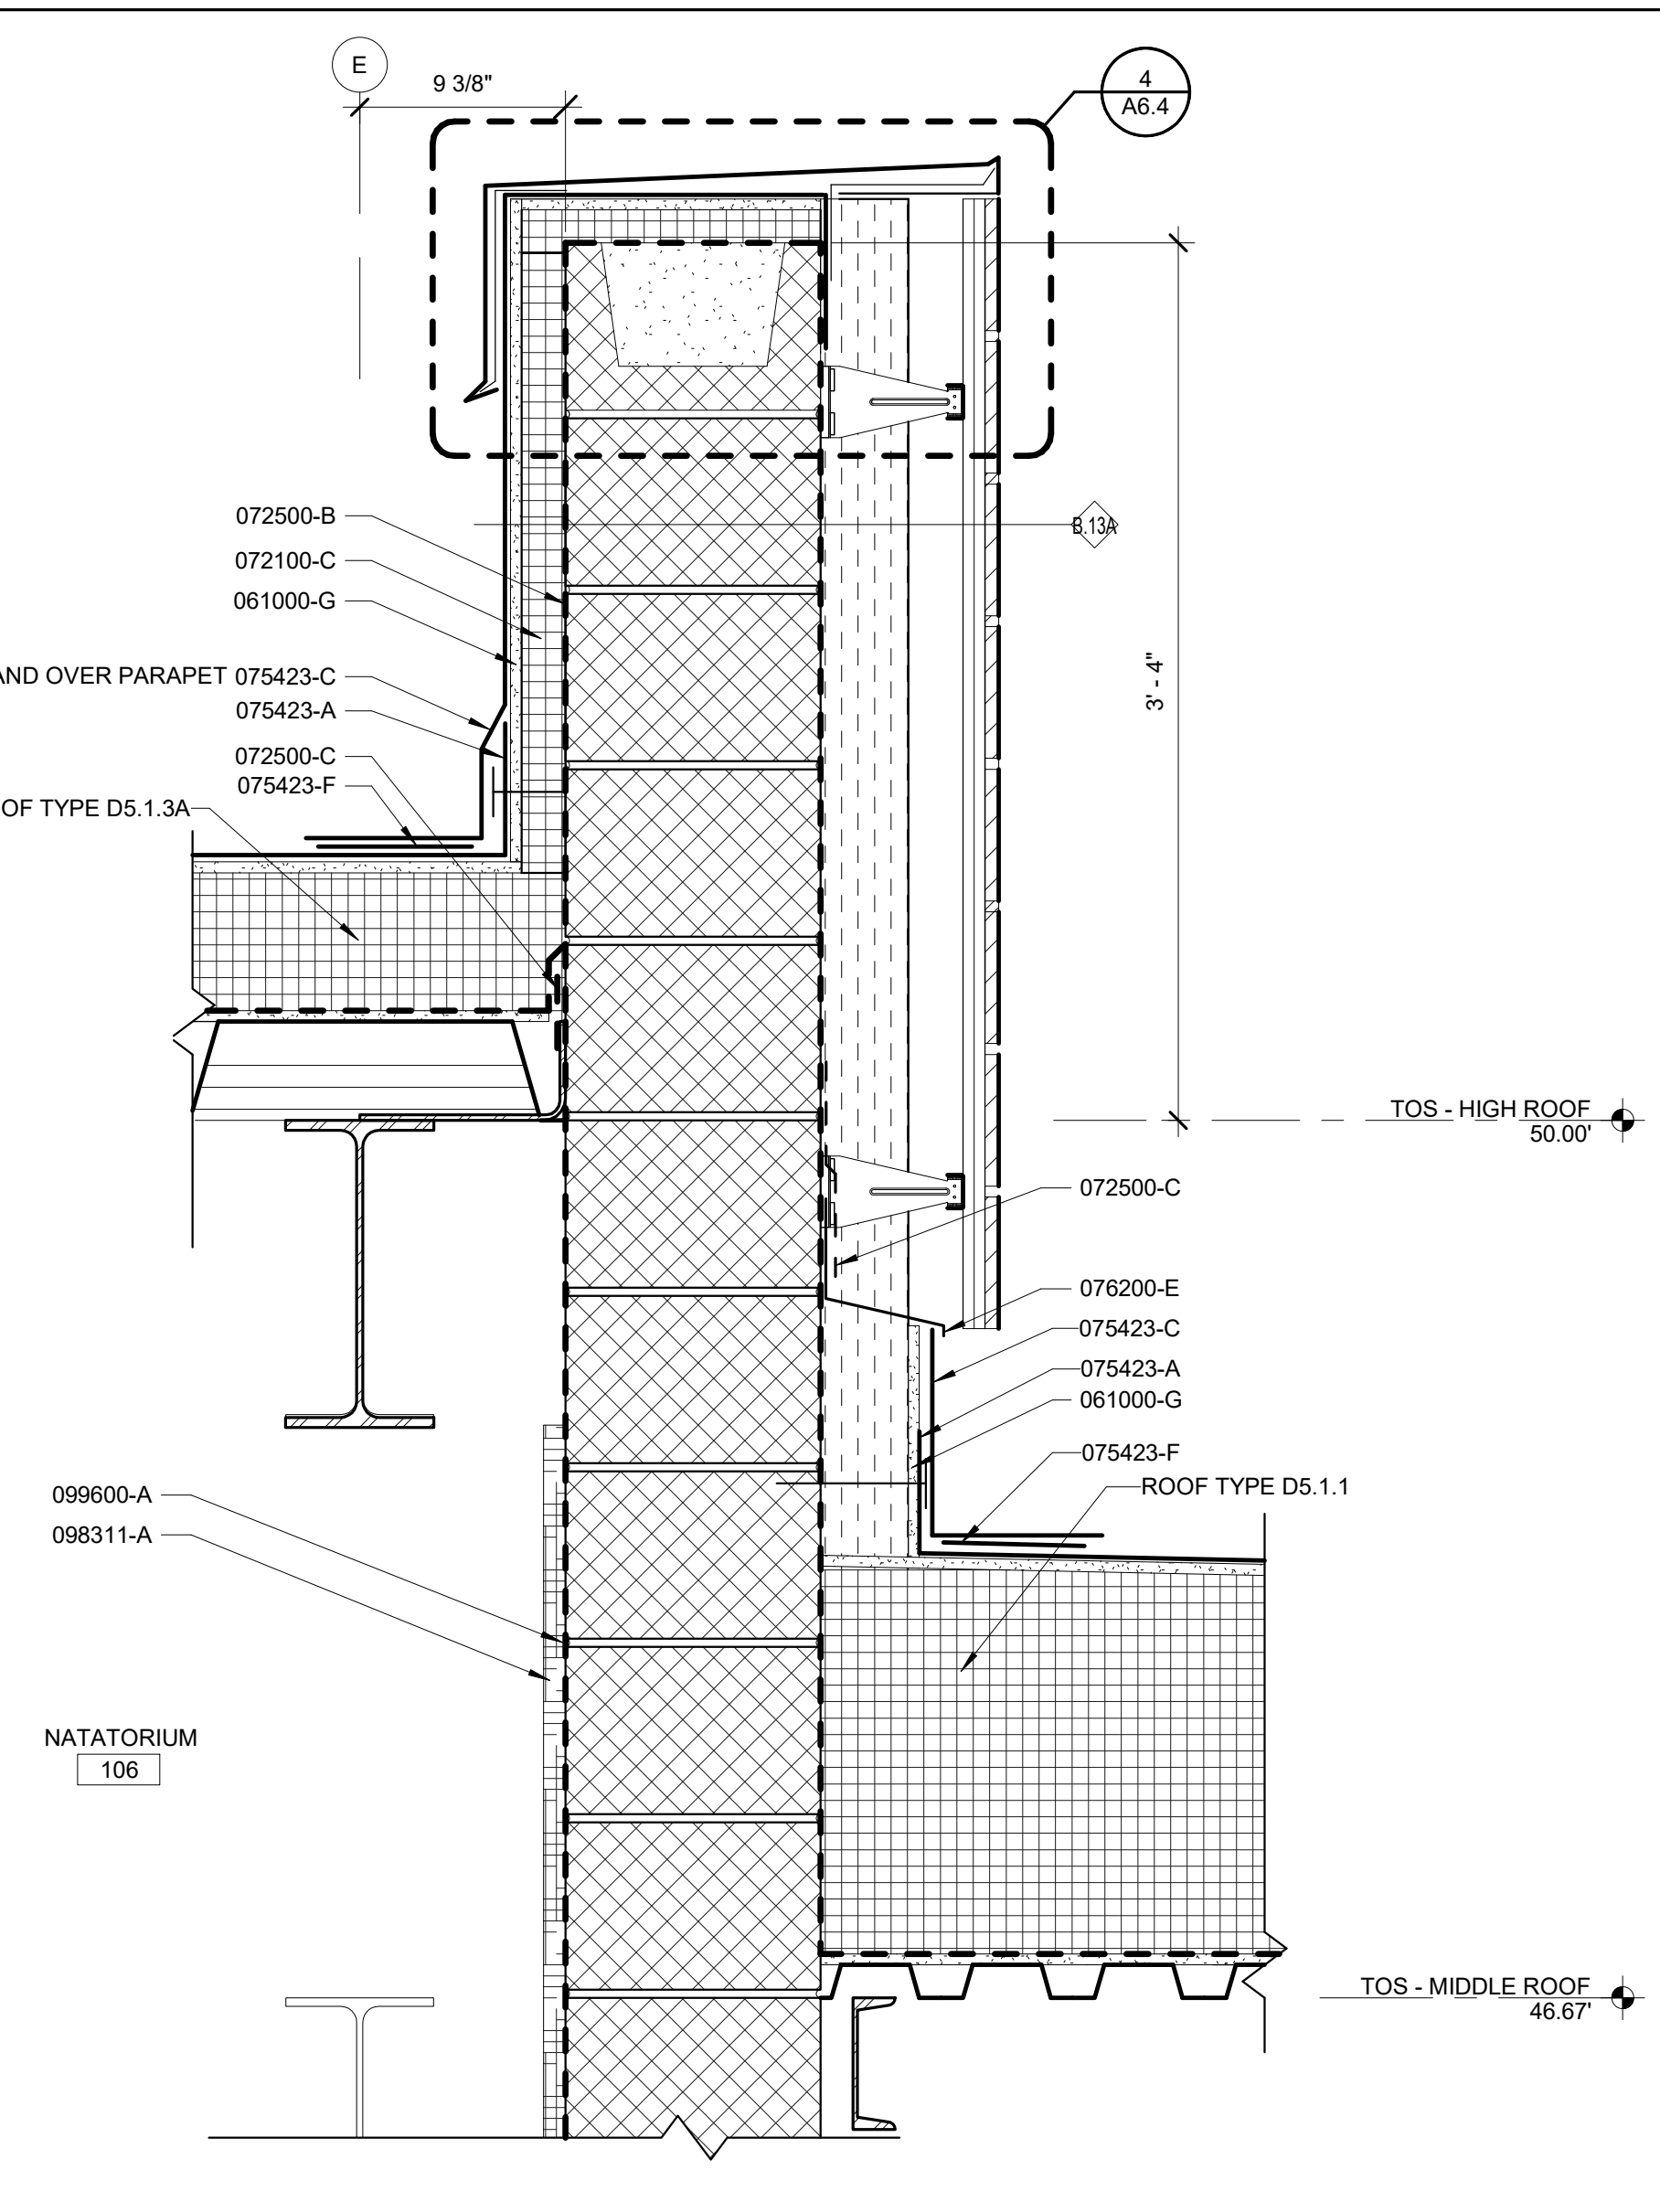


3 SECTION DETAIL
A6.5 1 1/2" = 1'-0"
FROM 8 / A4.5


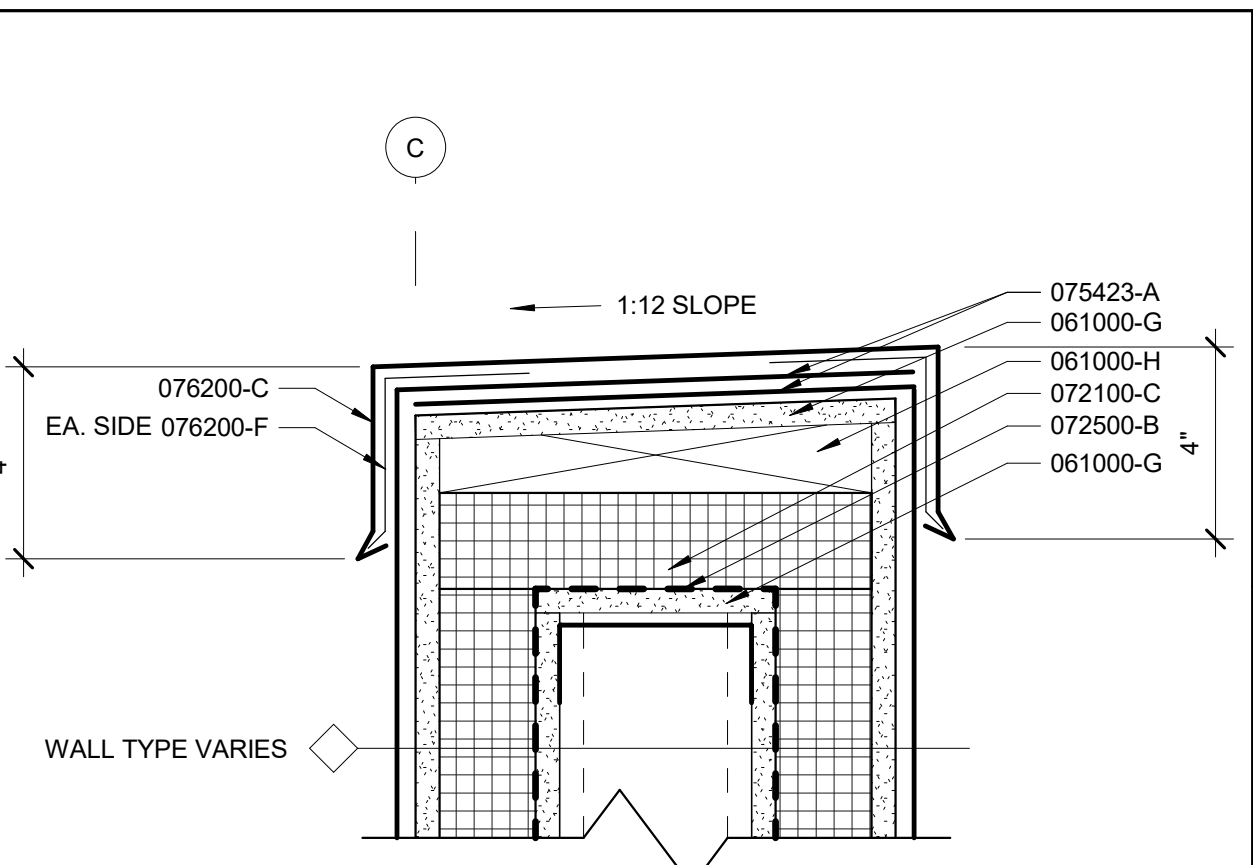


4 SECTION DETAIL
A6.5 3" = 1'-0"
FROM 5 / A6.5



- KEY PLAN:
- 033000-P NON-SHRINK GROUT
 - 051200-A STRUCTURAL STEEL (REFER TO STRUCTURAL FOR MORE INFORMATION)
 - 054000-A COLD-FORMED STEEL FRAMING, SIZE AS INDICATED
 - 061000-G EXTERIOR GYPSUM SHEATHING, 1/2" UNO
 - 061000-H FIRE-RETARDANT TREATED BLOCKING
 - 072100-C RIGID INSULATION BOARD, 2" THICK UNO
 - 072500-A VAPOR-PERMEABLE, AIR/WATER-RESISTIVE BARRIER
 - 072500-B VAPOR-IMPERMEABLE, AIR/WATER-RESISTIVE BARRIER
 - 072500-C TRANSITION MEMBRANE
 - 075423-A TPO ROOFING
 - 075423-C TPO FLASHING
 - 075423-F TPO SPLICE TAPE
 - 076200-C METAL COPING
 - 076200-E 2-PIECE METAL COUNTER FLASHING
 - 076200-F CONTINUOUS LOCKING METAL CLEAT
 - 092116-A GYPSUM BOARD, ABUSE AND MOISTURE RESISTANT, 5/8" THICKNESS UNO
 - 092116-B GYPSUM BOARD, MOISTURE RESISTANT TYPE 'XP', 5/8" THICKNESS UNO
 - 098311-A SHREDDED WOOD ACOUSTIC PANEL, PAINTED PT-1 UNO, 2" THICK UNO
 - 099600-A MULTI-LAYER IMPERMEABLE SURFACE

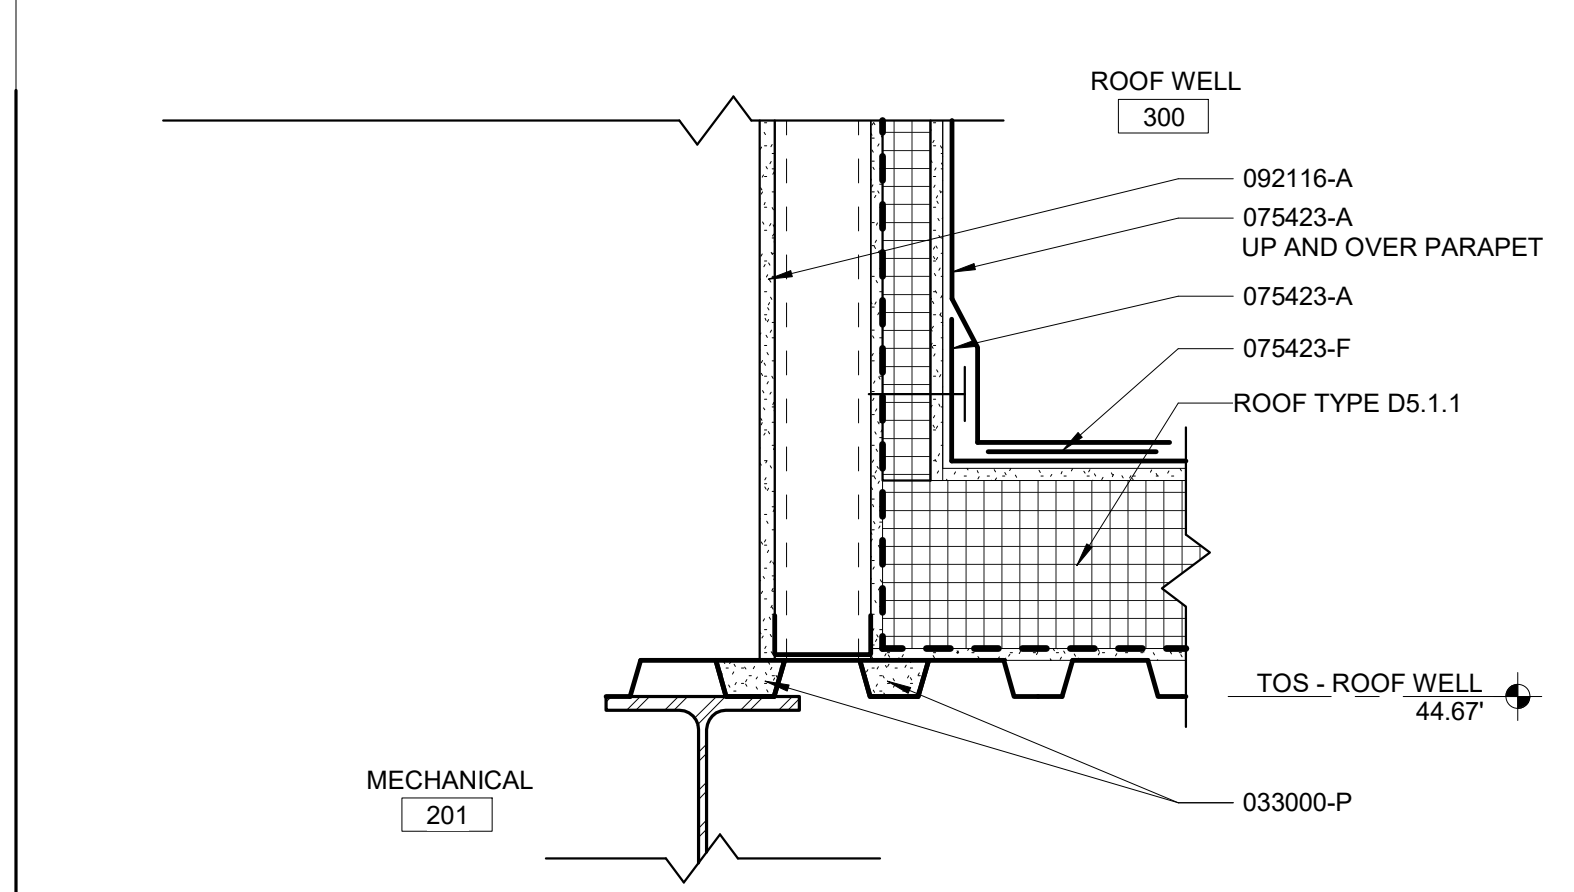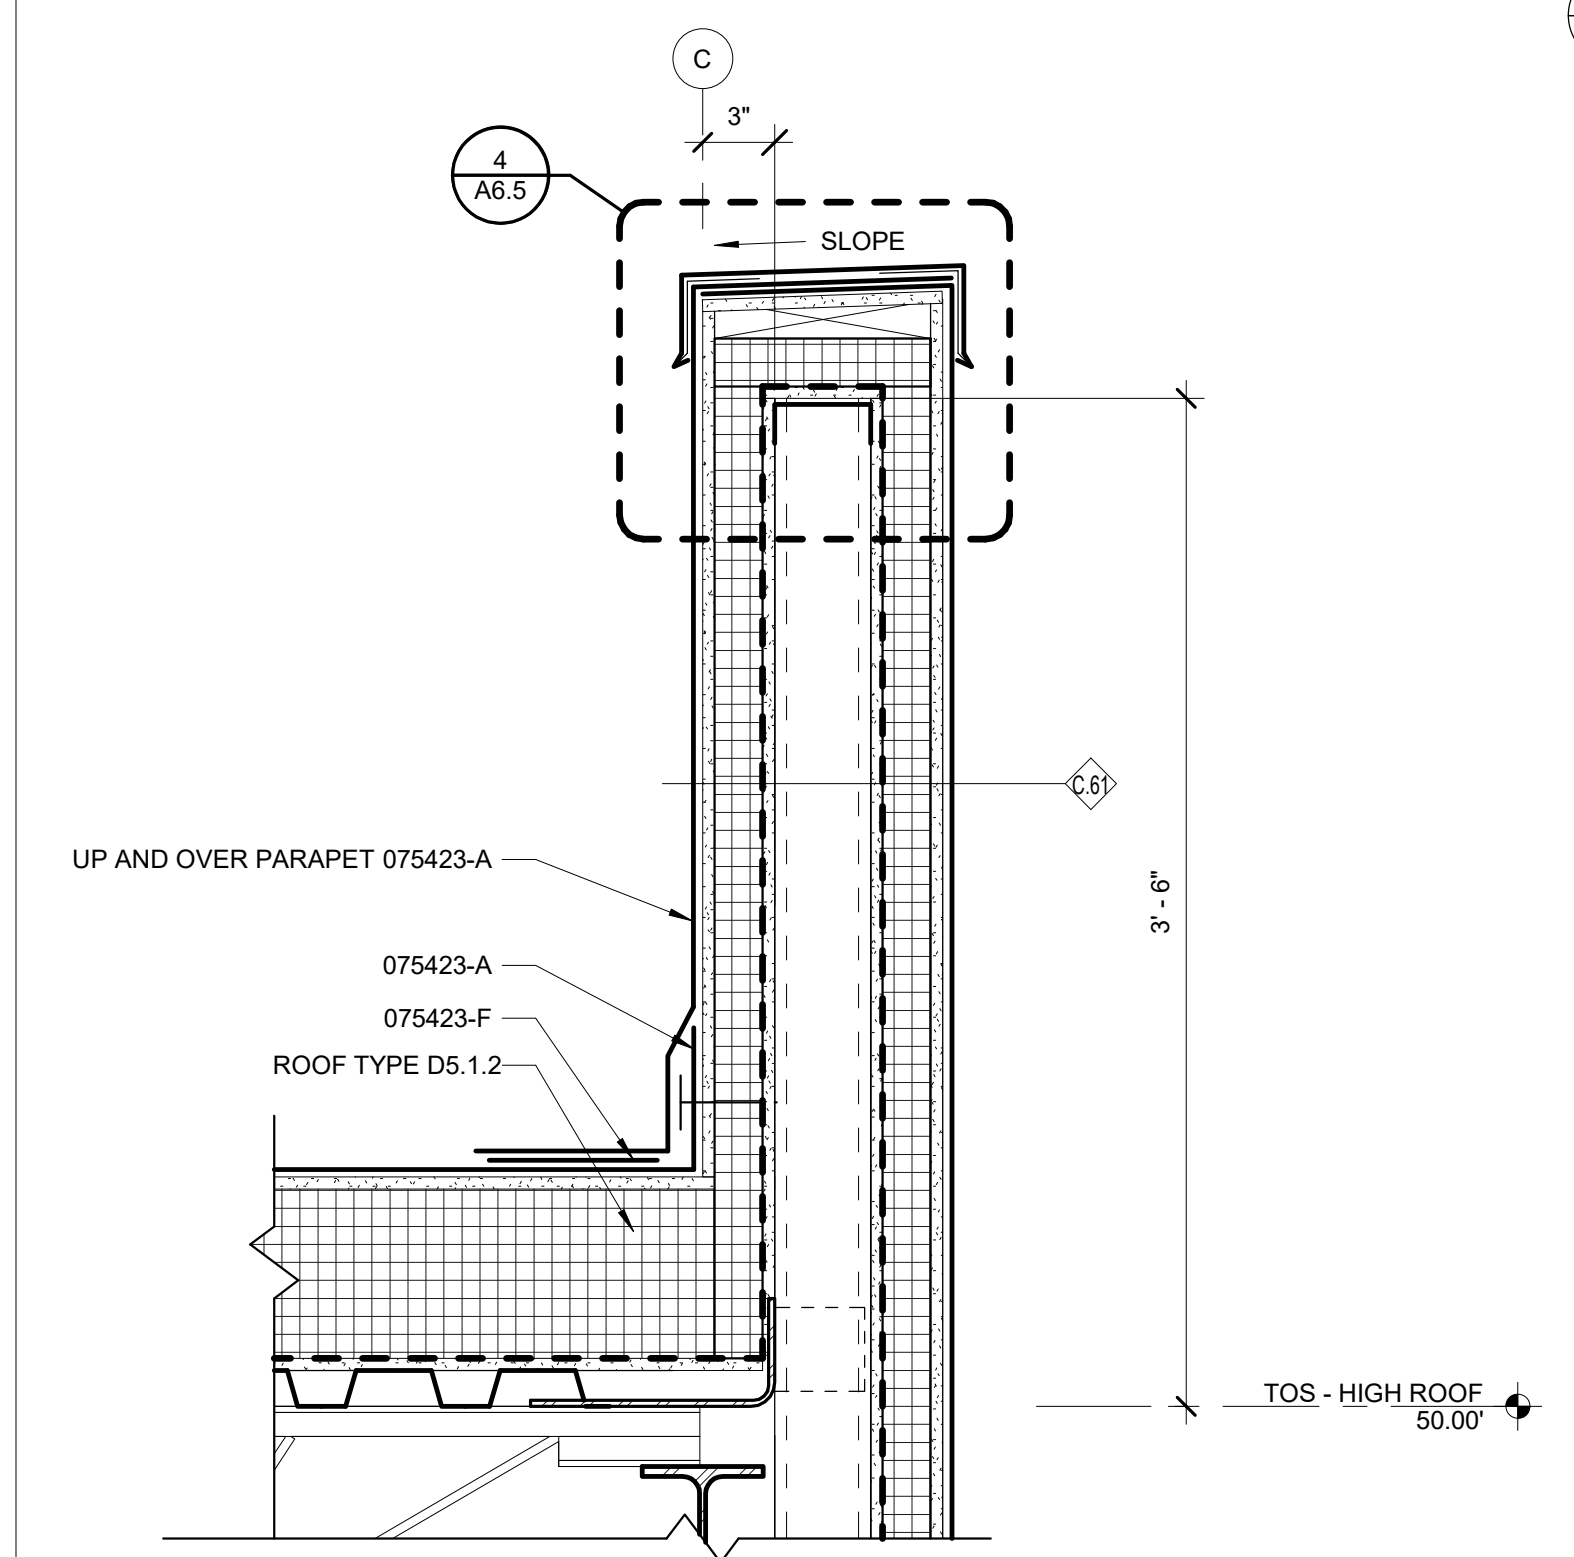



5 SECTION DETAIL
A6.5 1 1/2" = 1'-0"

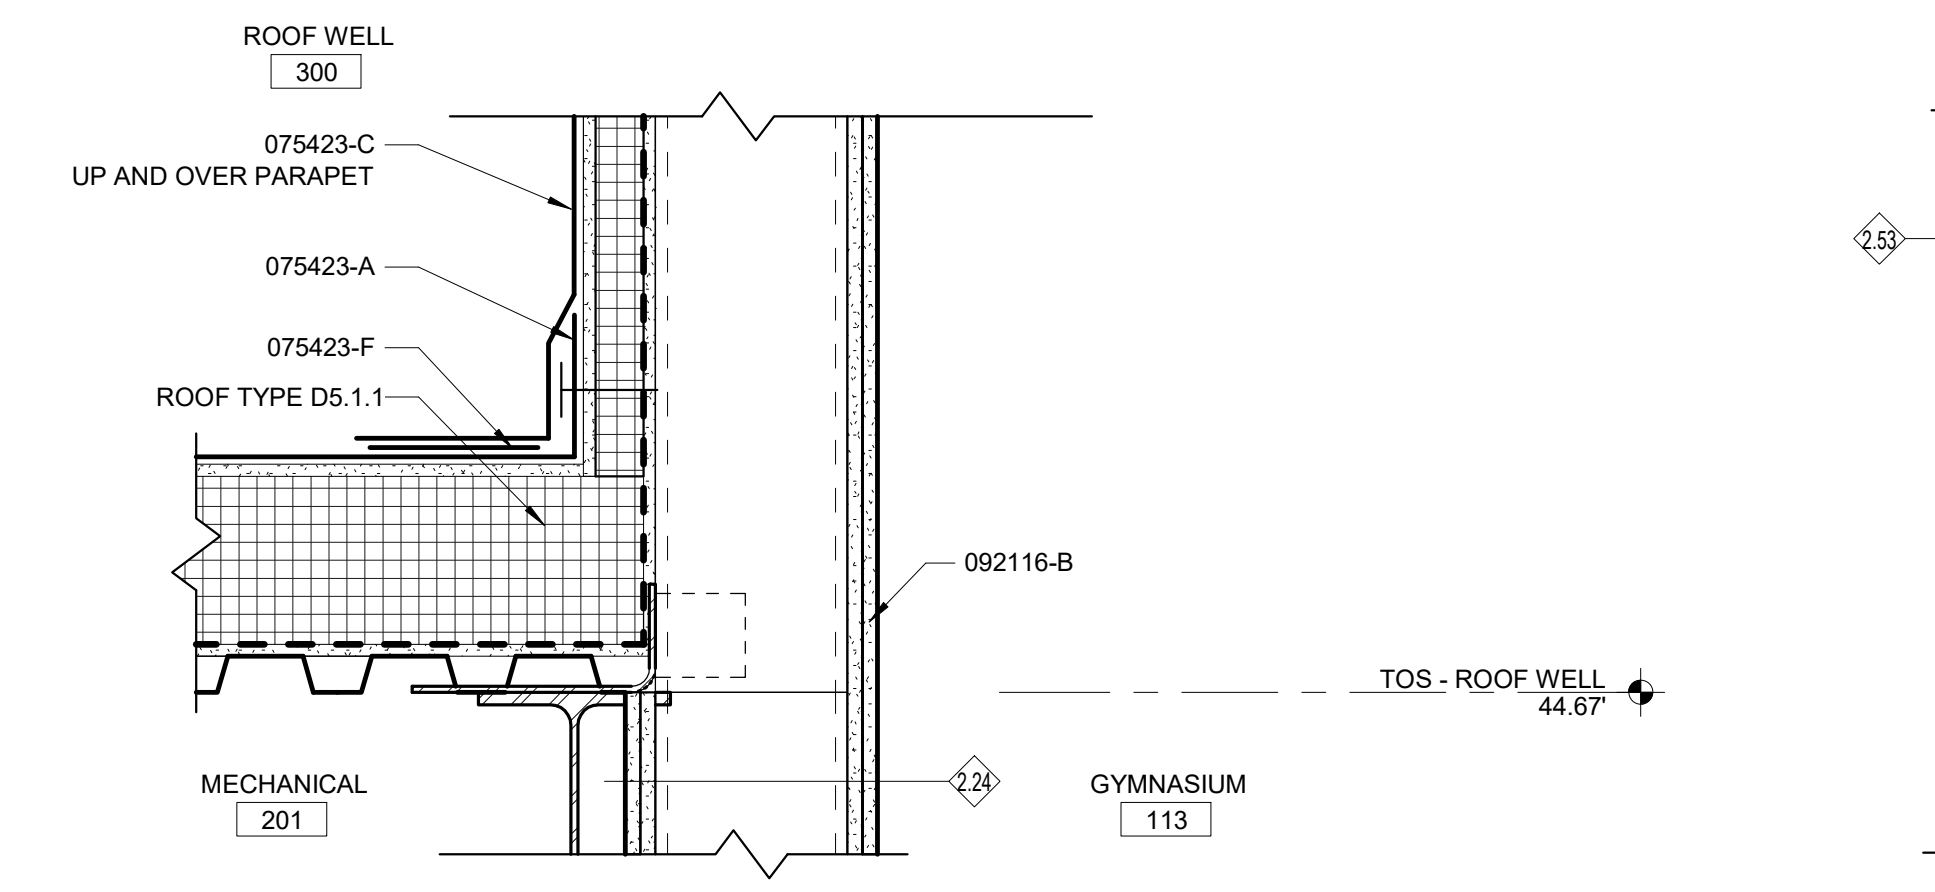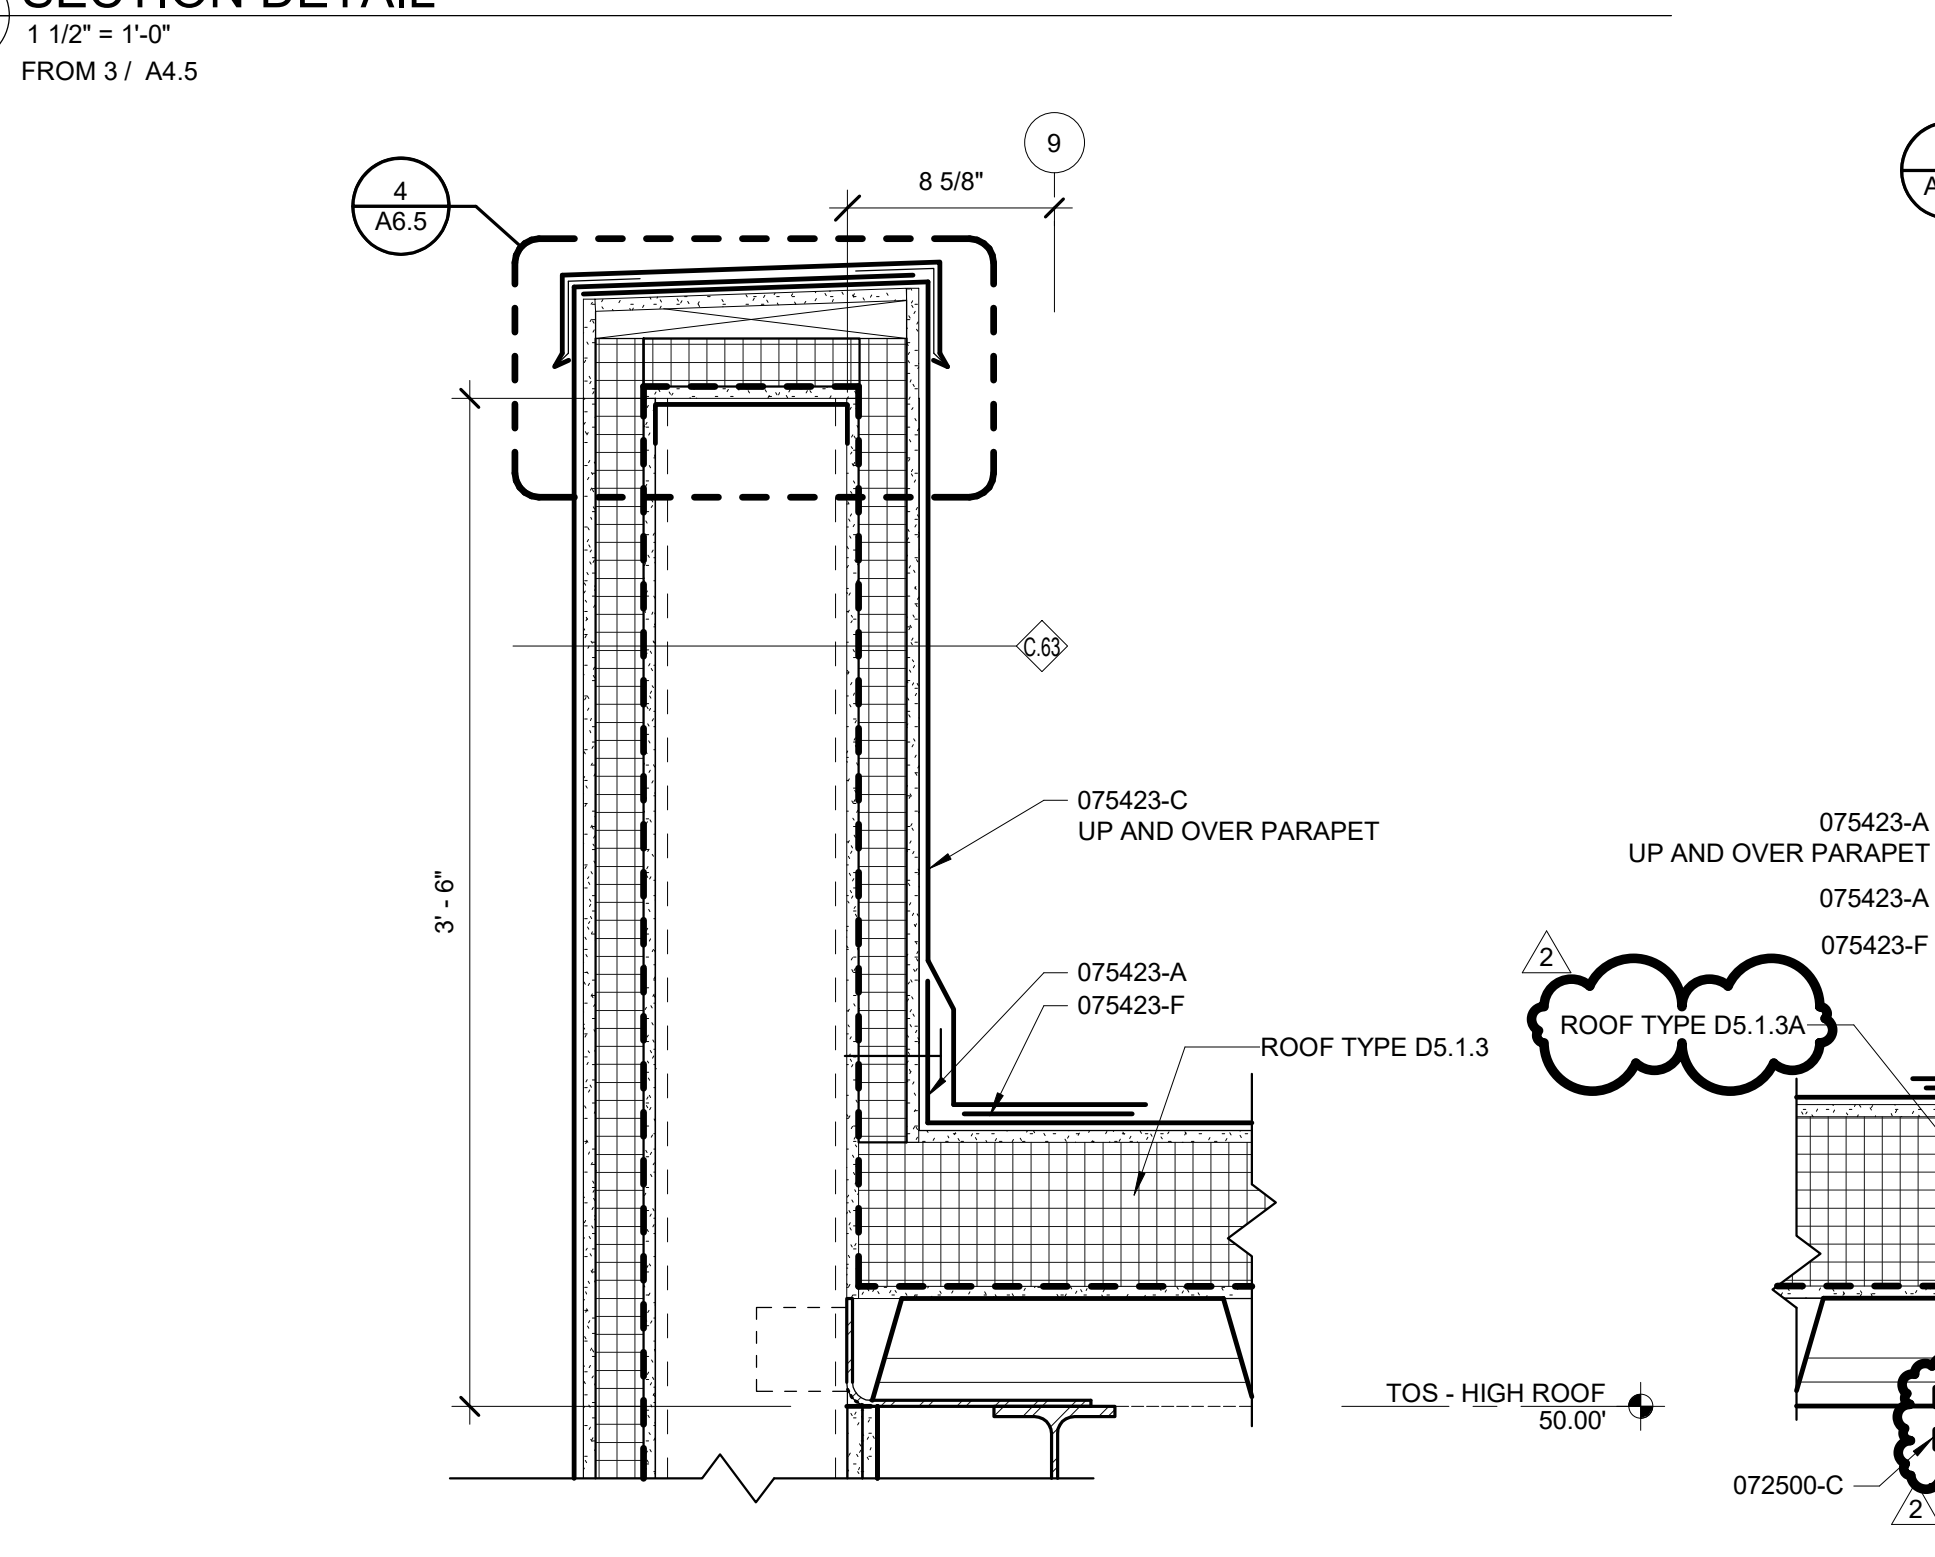


6 SECTION DETAIL
A6.5 1 1/2" = 1'-0"

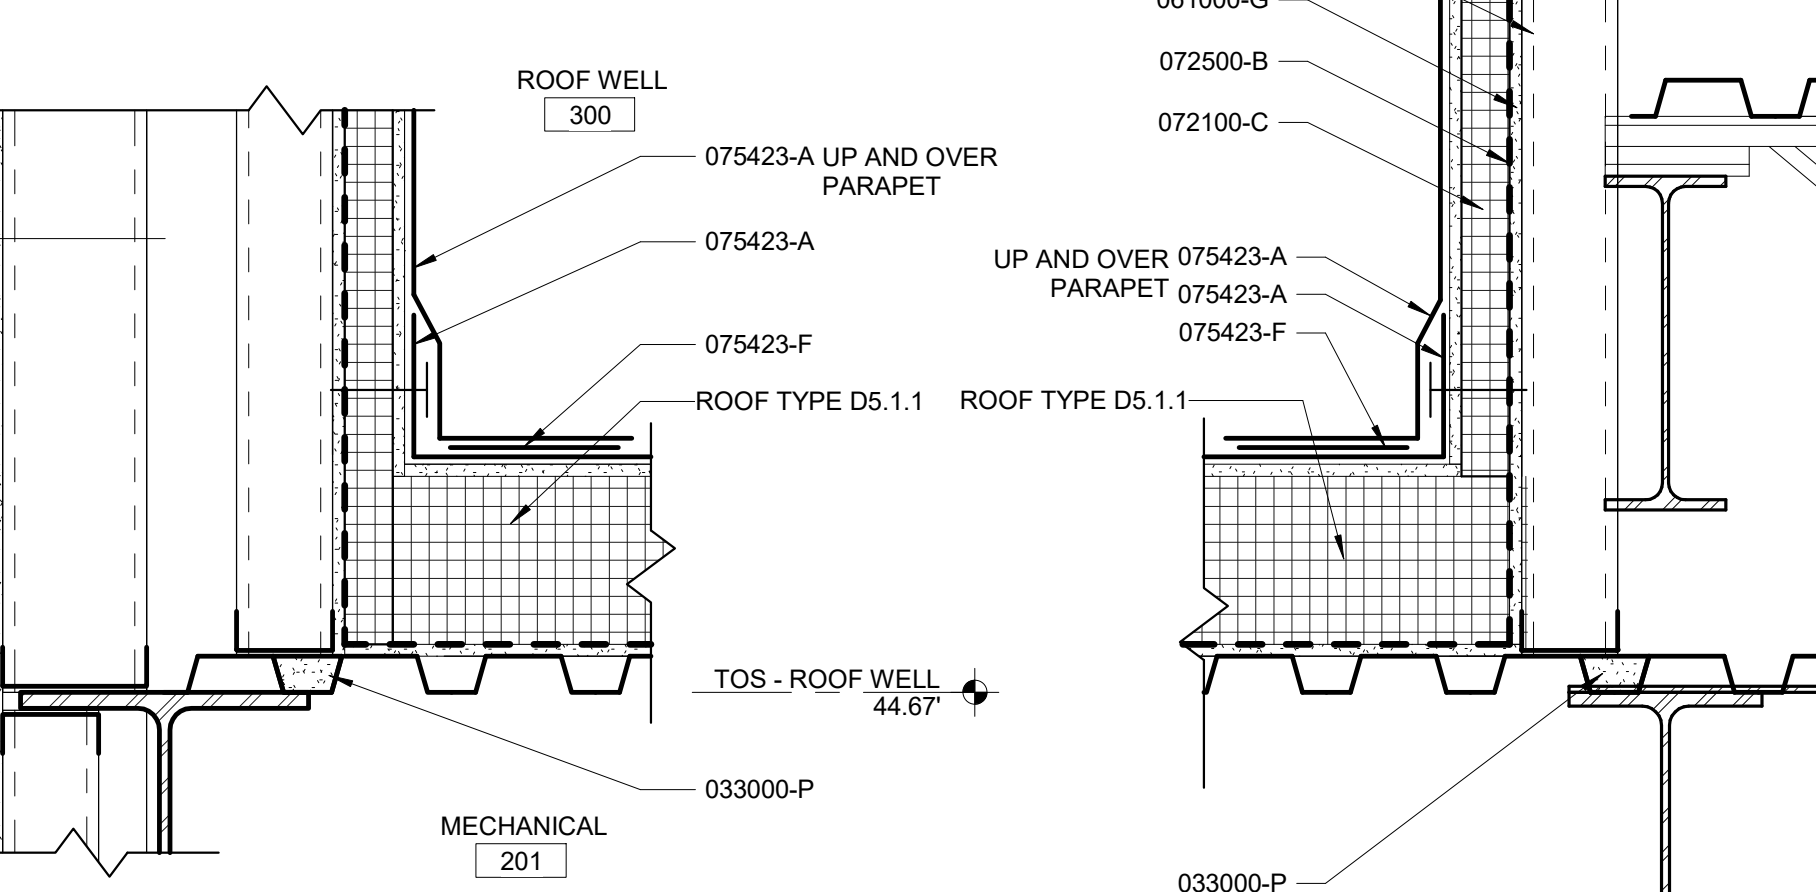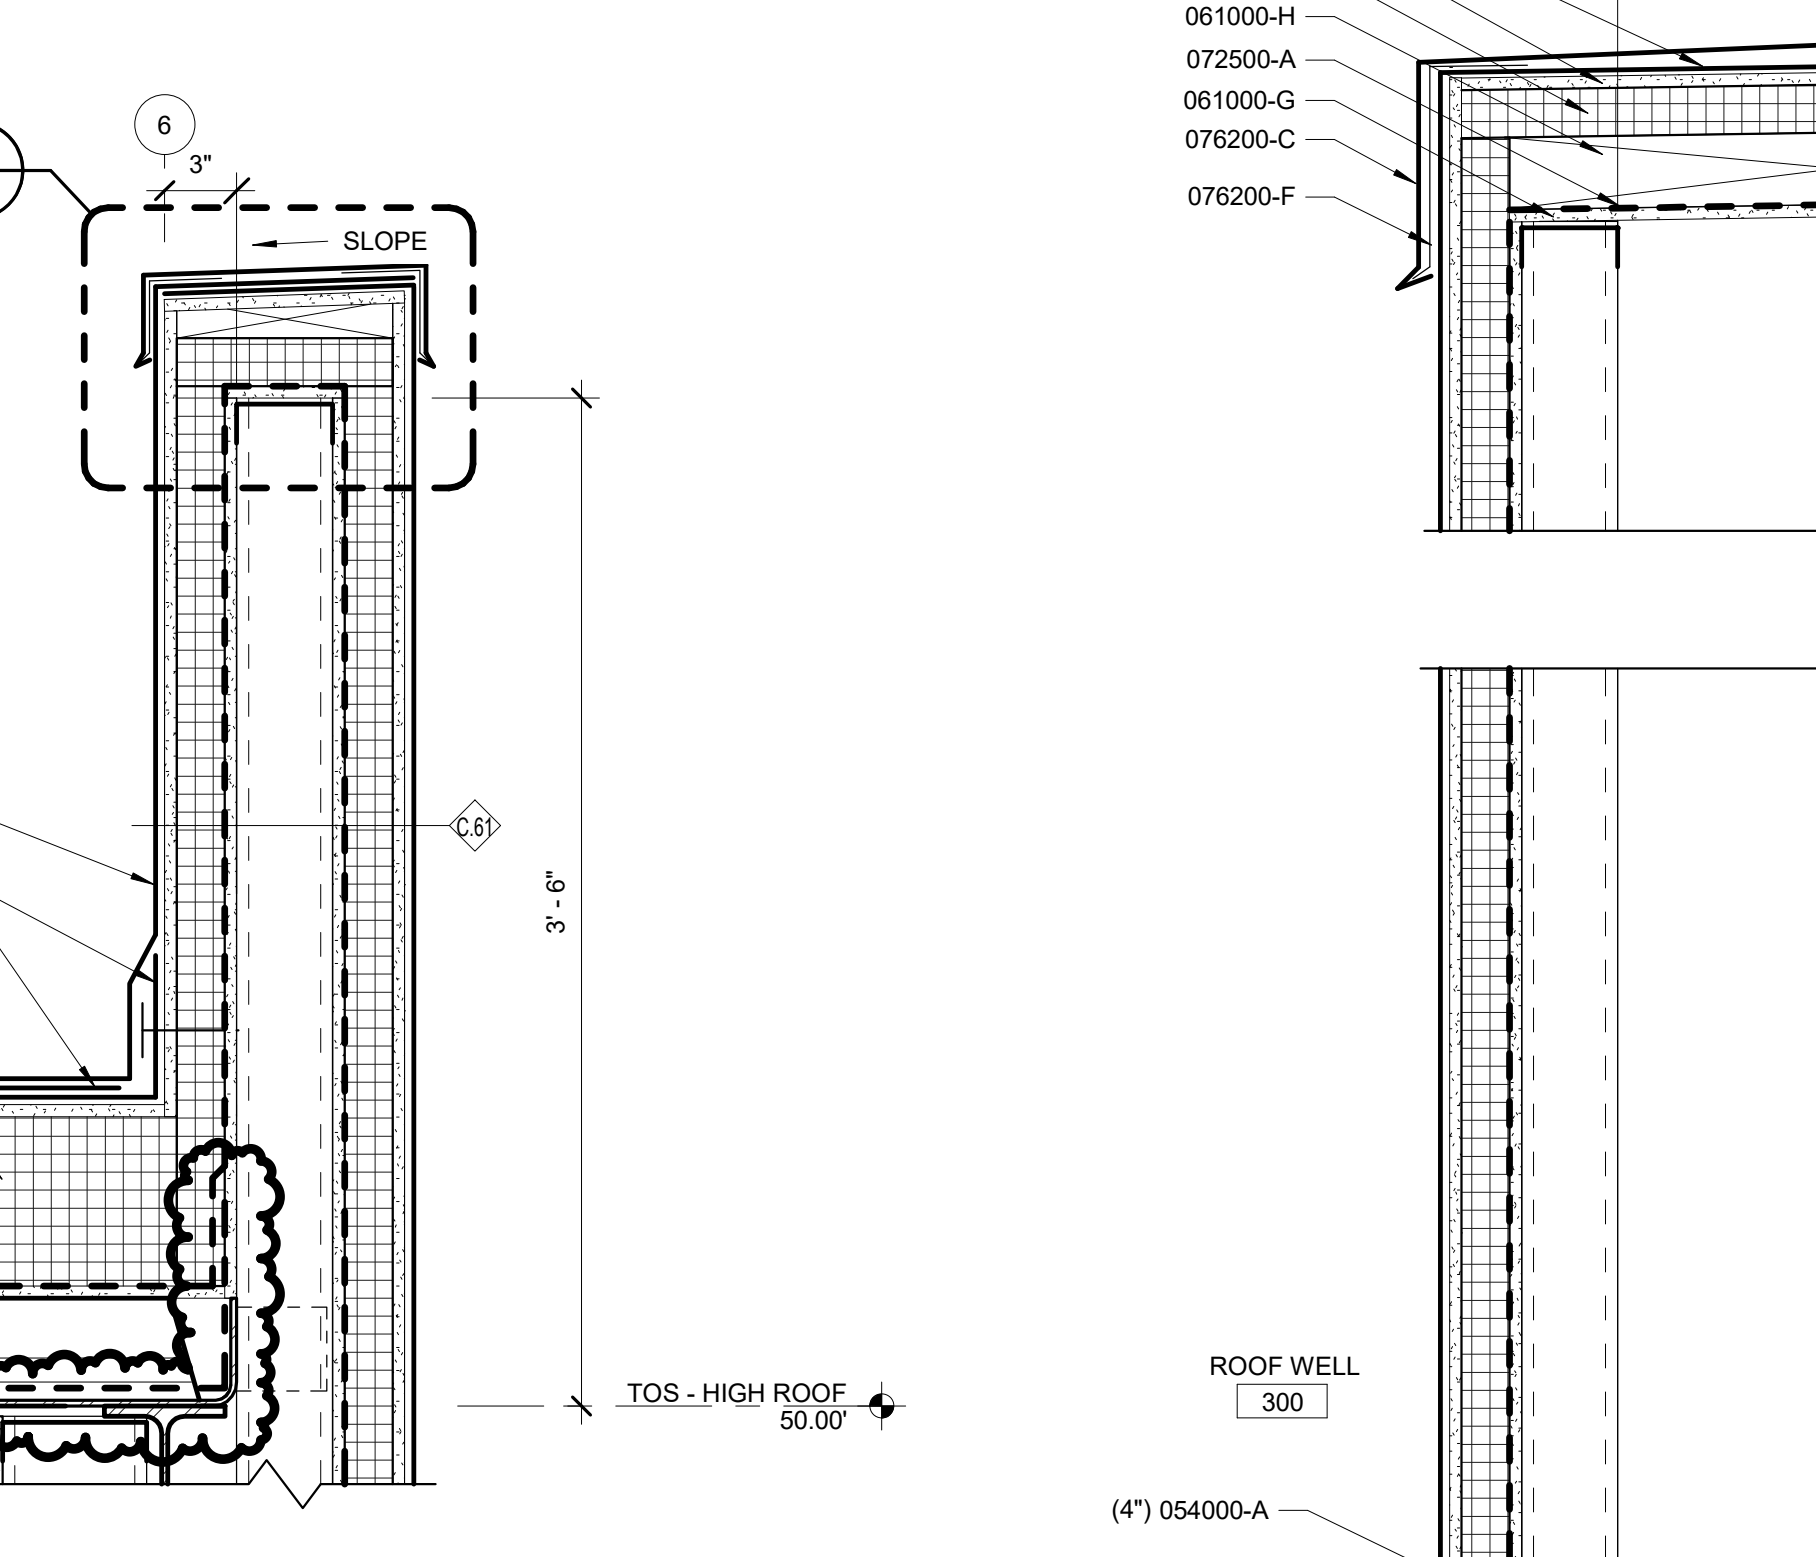

7 SECTION DETAIL
A6.5 1 1/2" = 1'-0"

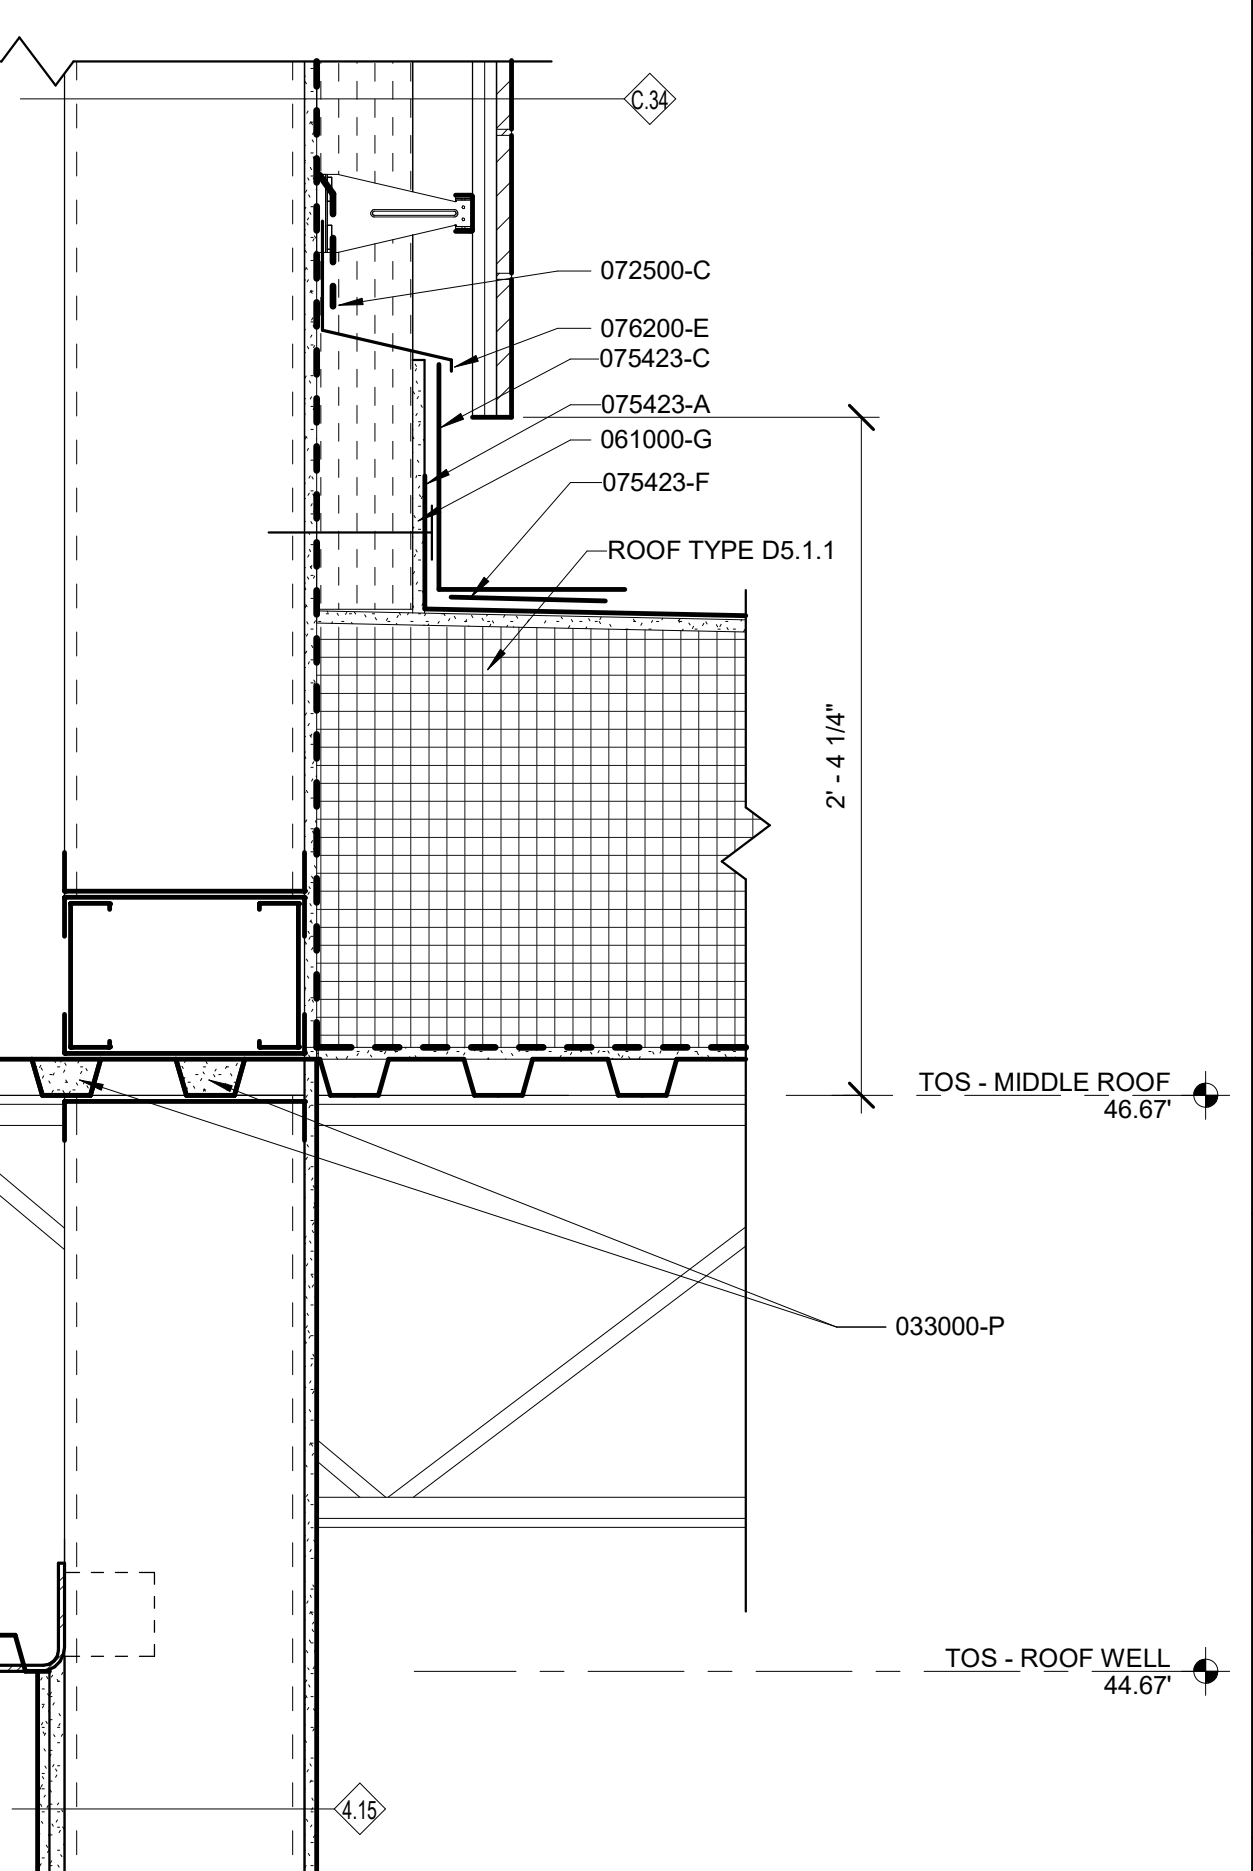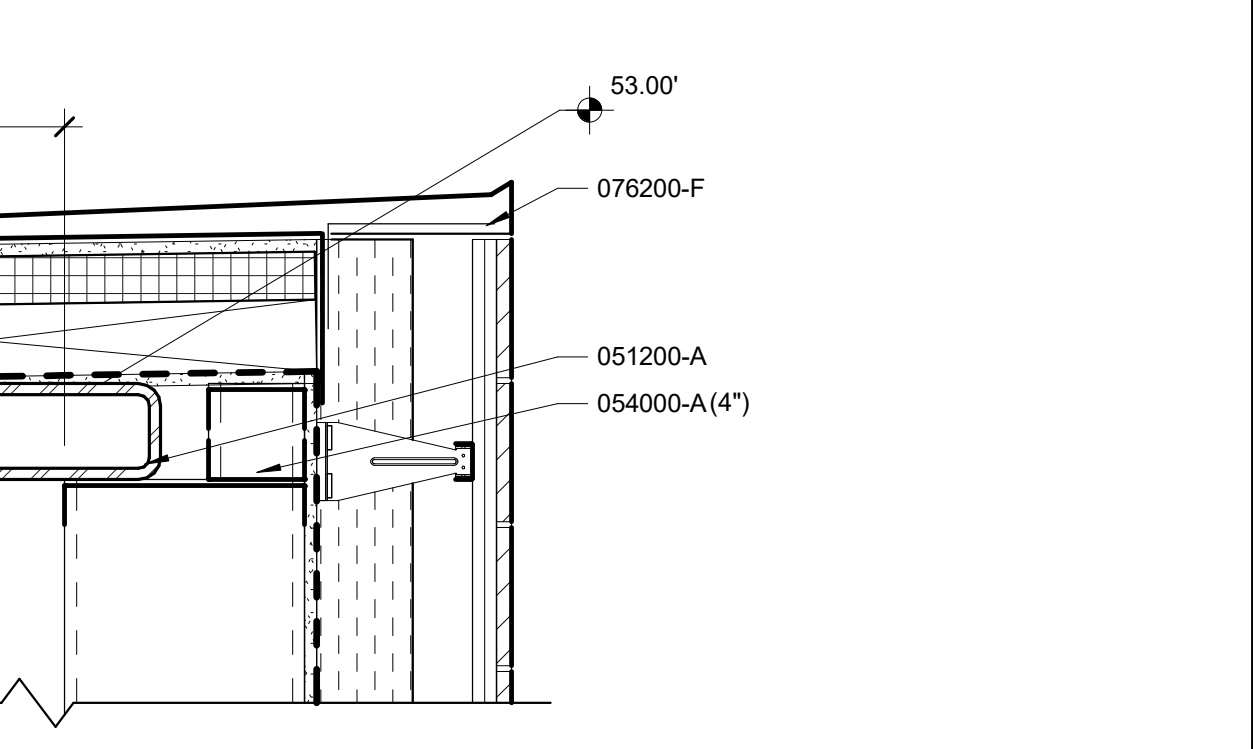


8 SECTION DETAIL
A6.5 1 1/2" = 1'-0"

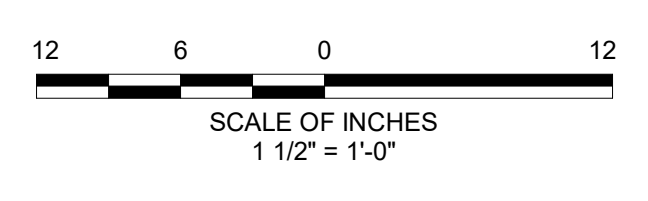

ISSUED FOR BID

Seal: _____
Seal: _____

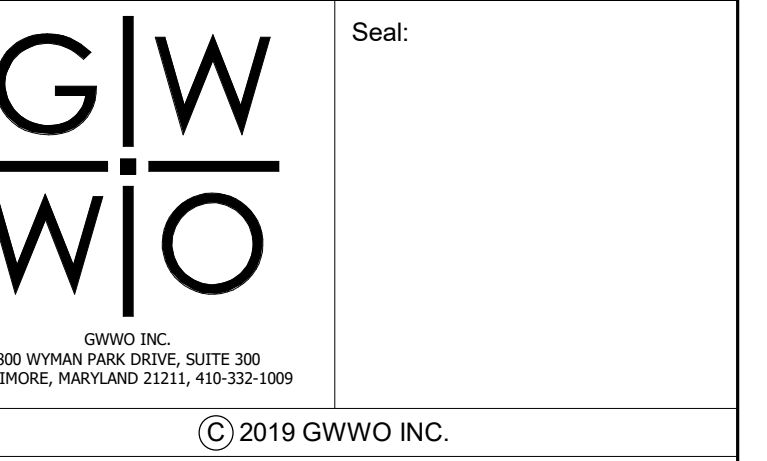
















© 2019 GWIO INC.
I CERTIFY THAT THESE DOCUMENTS WERE PREPARED OR APPROVED BY ME, AND THAT I AM A DULY LICENSED ARCHITECT UNDER THE LAWS OF THE STATE OF MARYLAND. LICENSE NUMBER: 8400, EXPIRATION DATE: 12/31/2020.

Revisions:		
No.	Date	Description
2	1/28/2020	ADDENDUM 2


MIDDLE BRANCH FITNESS & WELLNESS CENTER AT CHERRY HILL
BALTIMORE CITY RECREATION & PARKS

Job No.	#18010	KMS	Drawn
Scale	As indicated	KMS	Checked
Date	12/13/2019	AER	Approved
Drawing Title	SECTION DETAILS		

Sheet A6.5r2

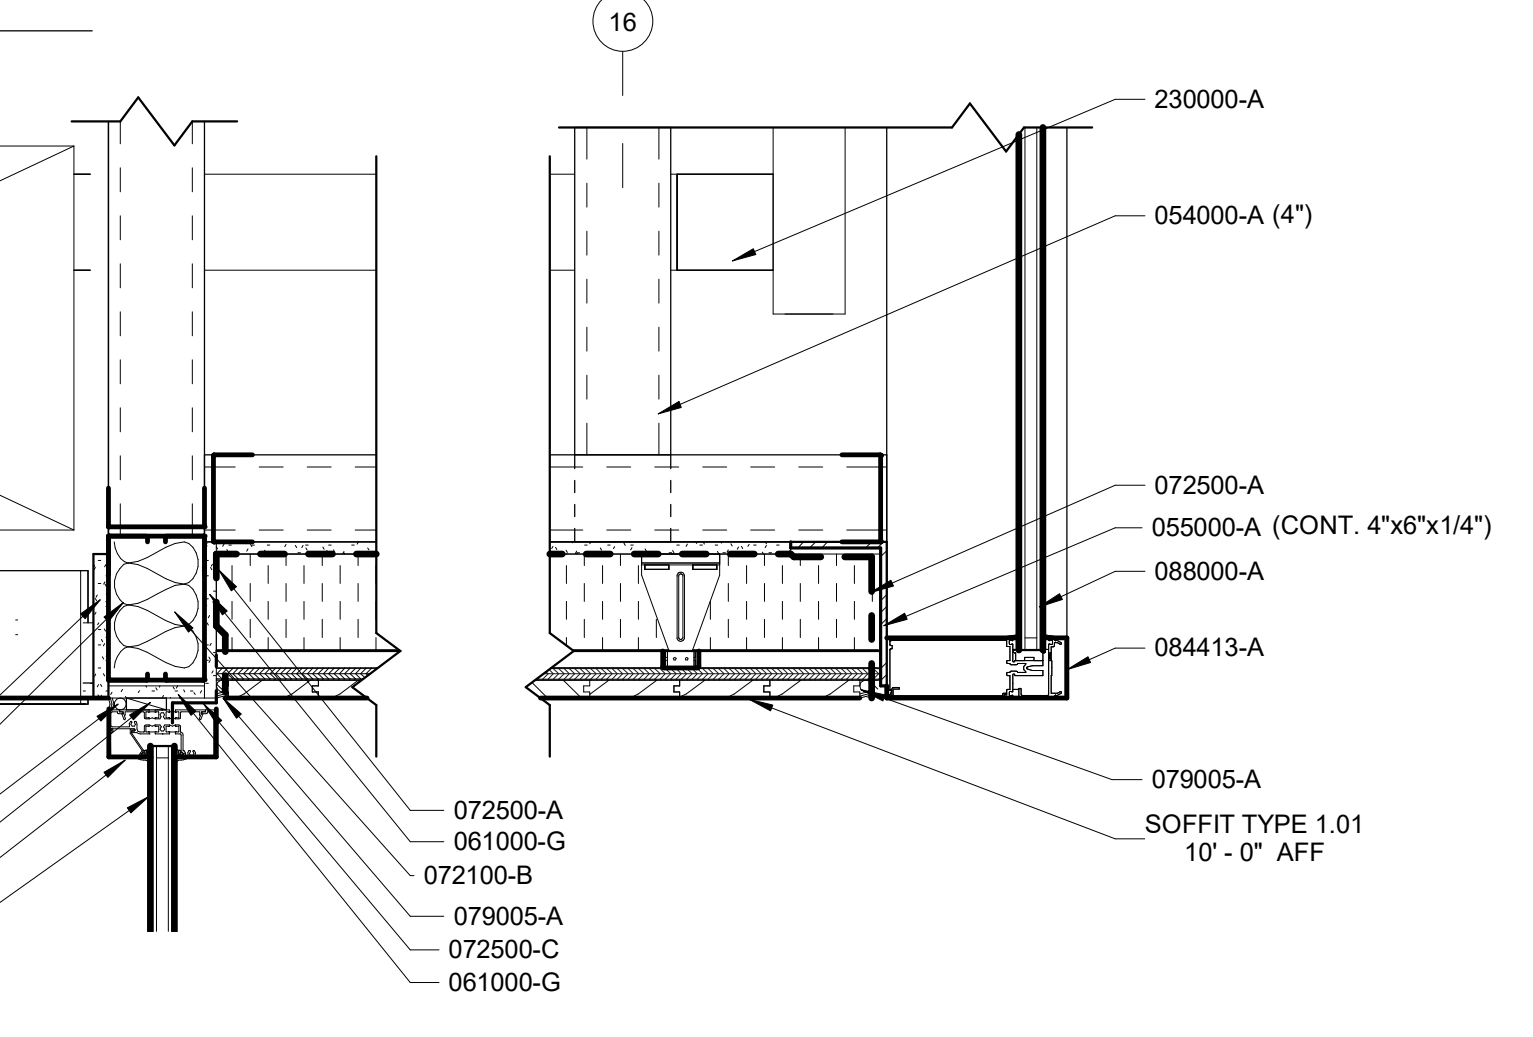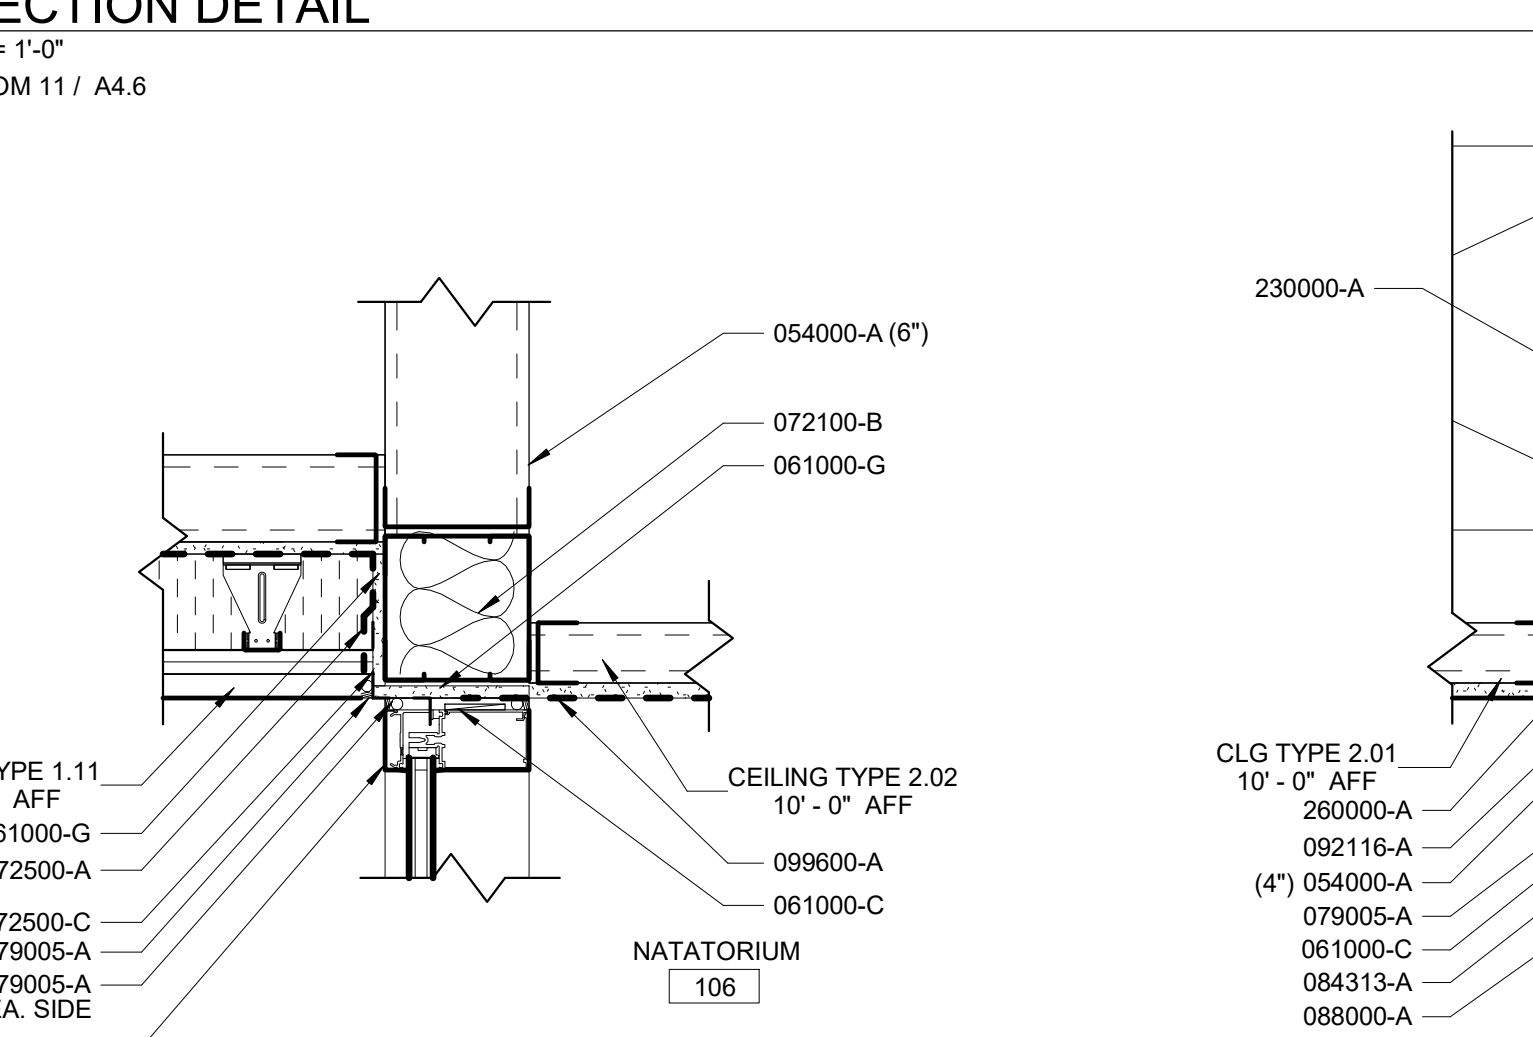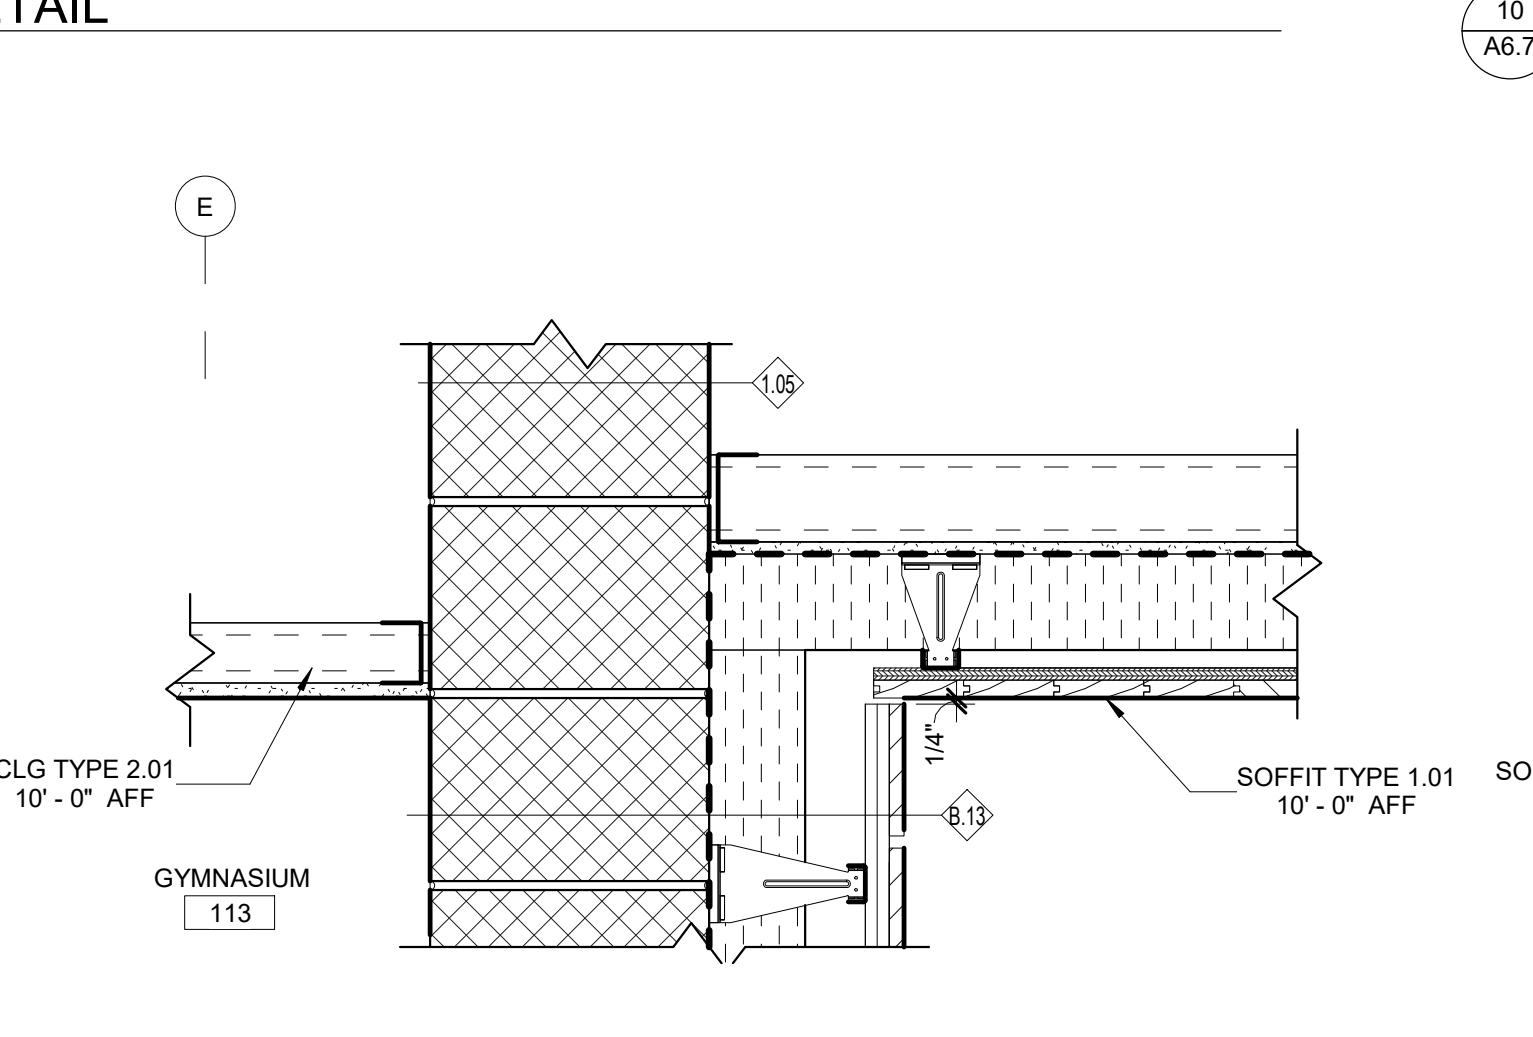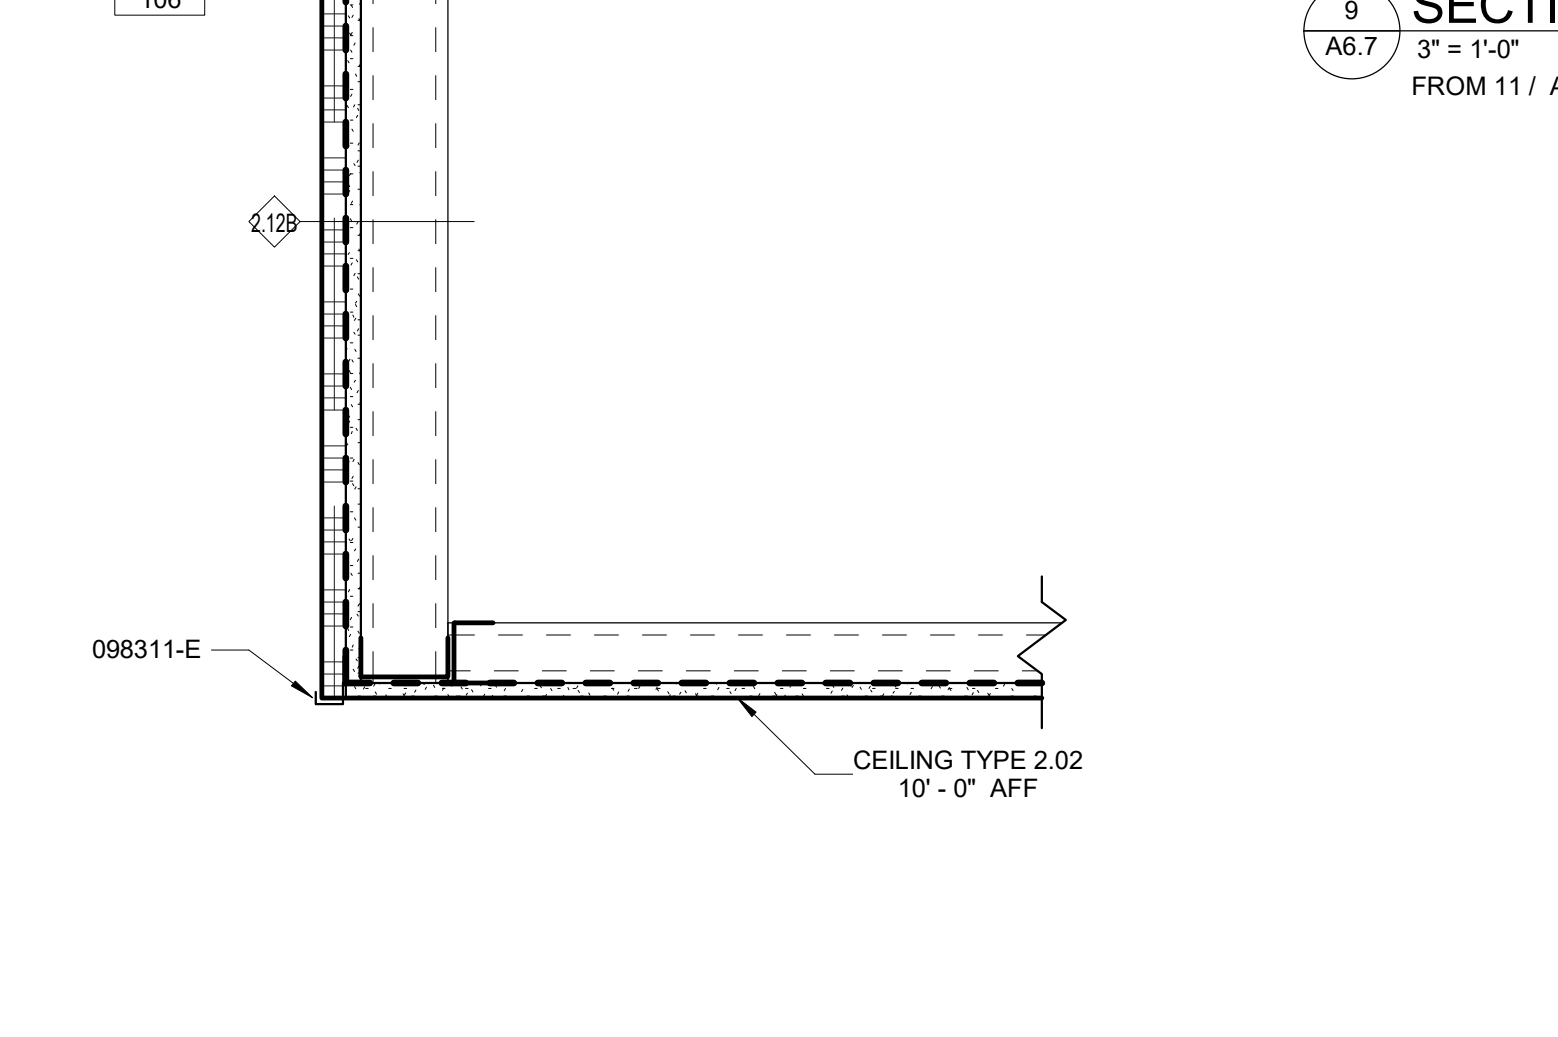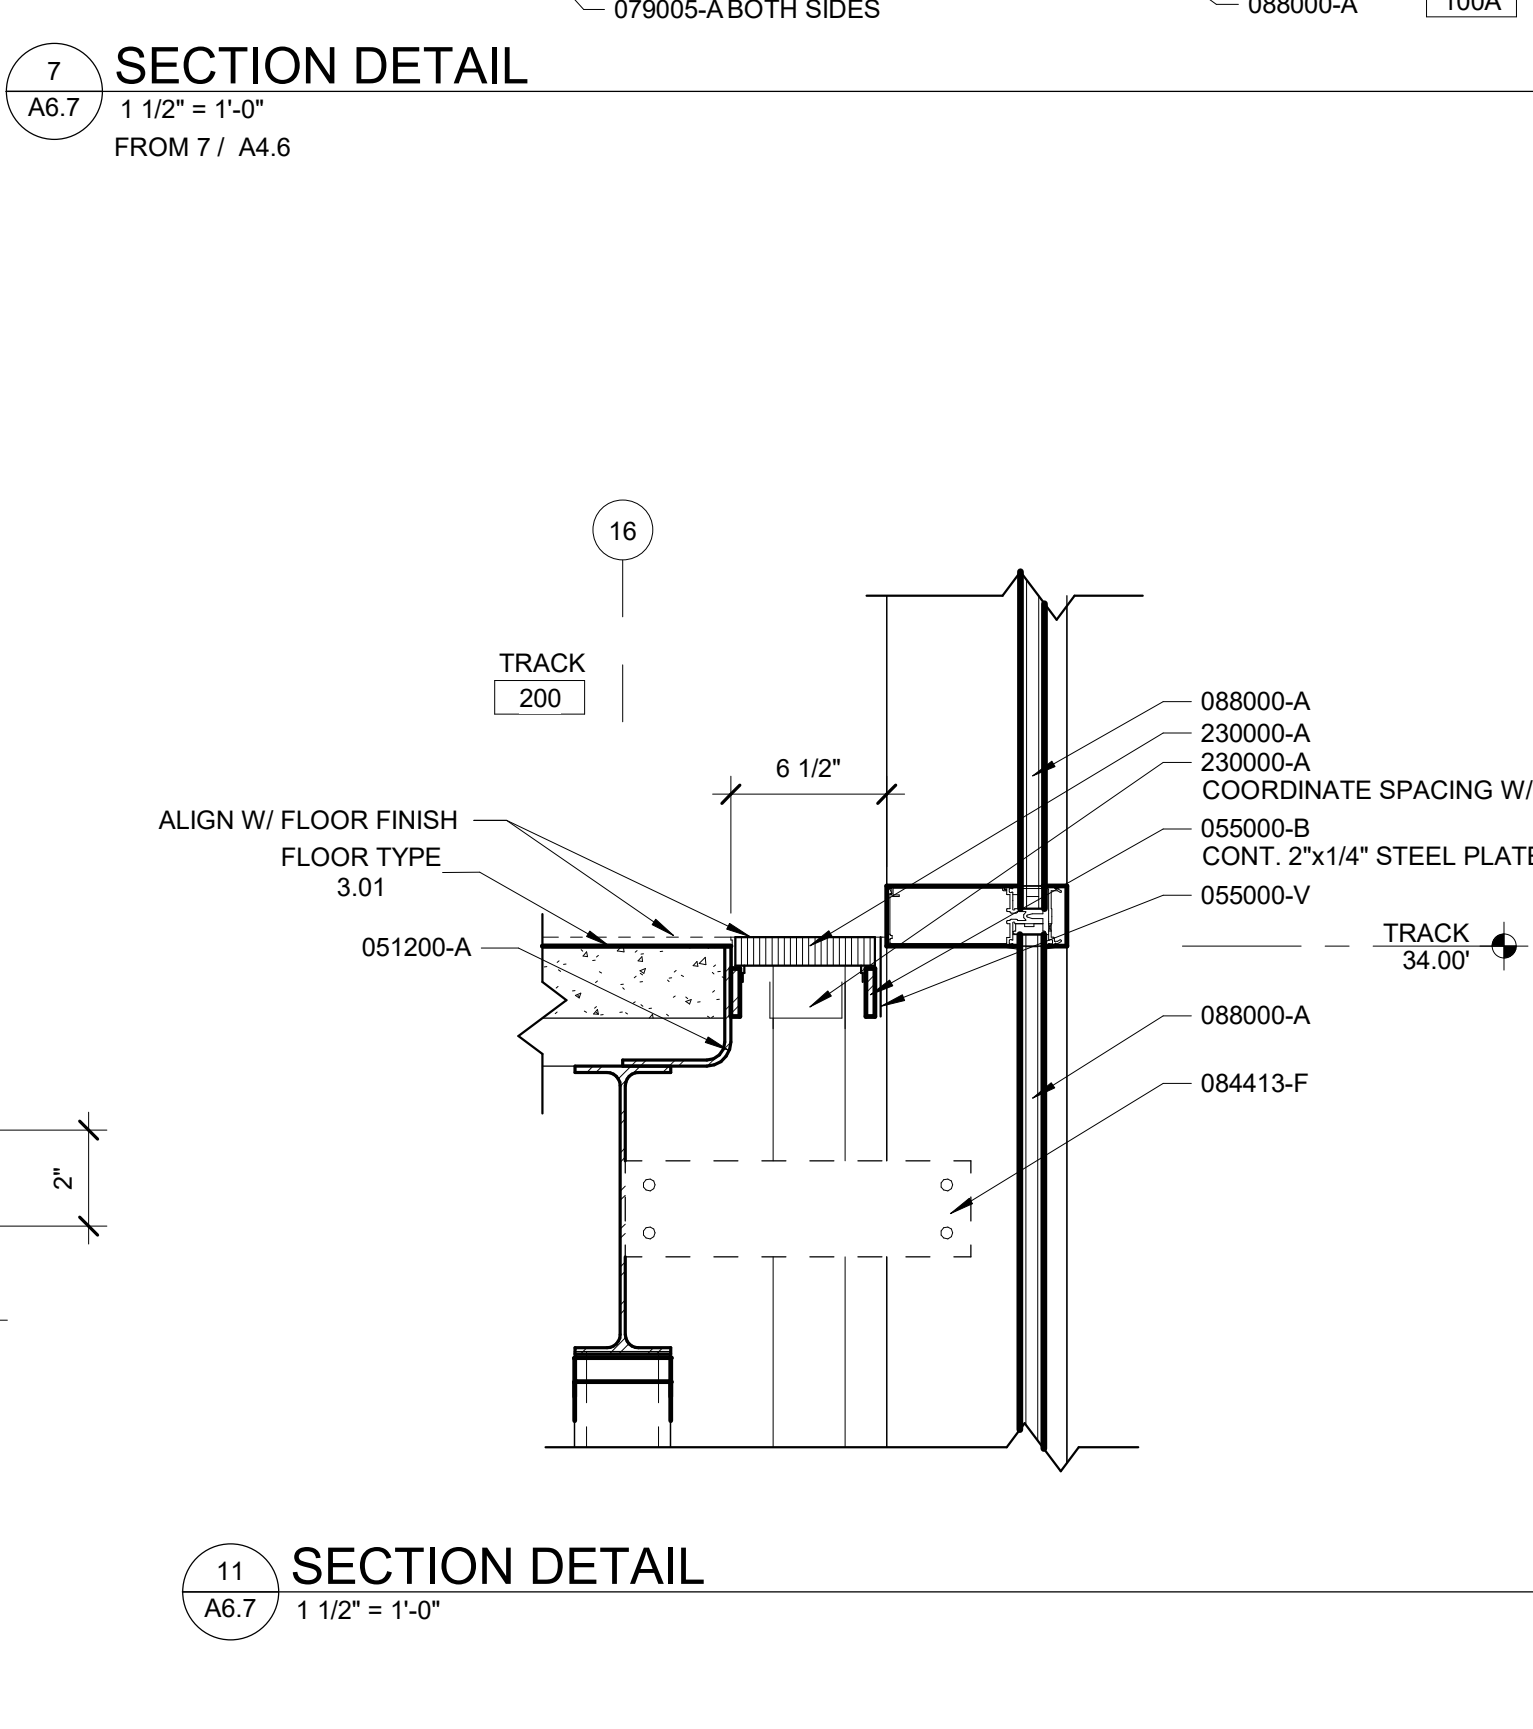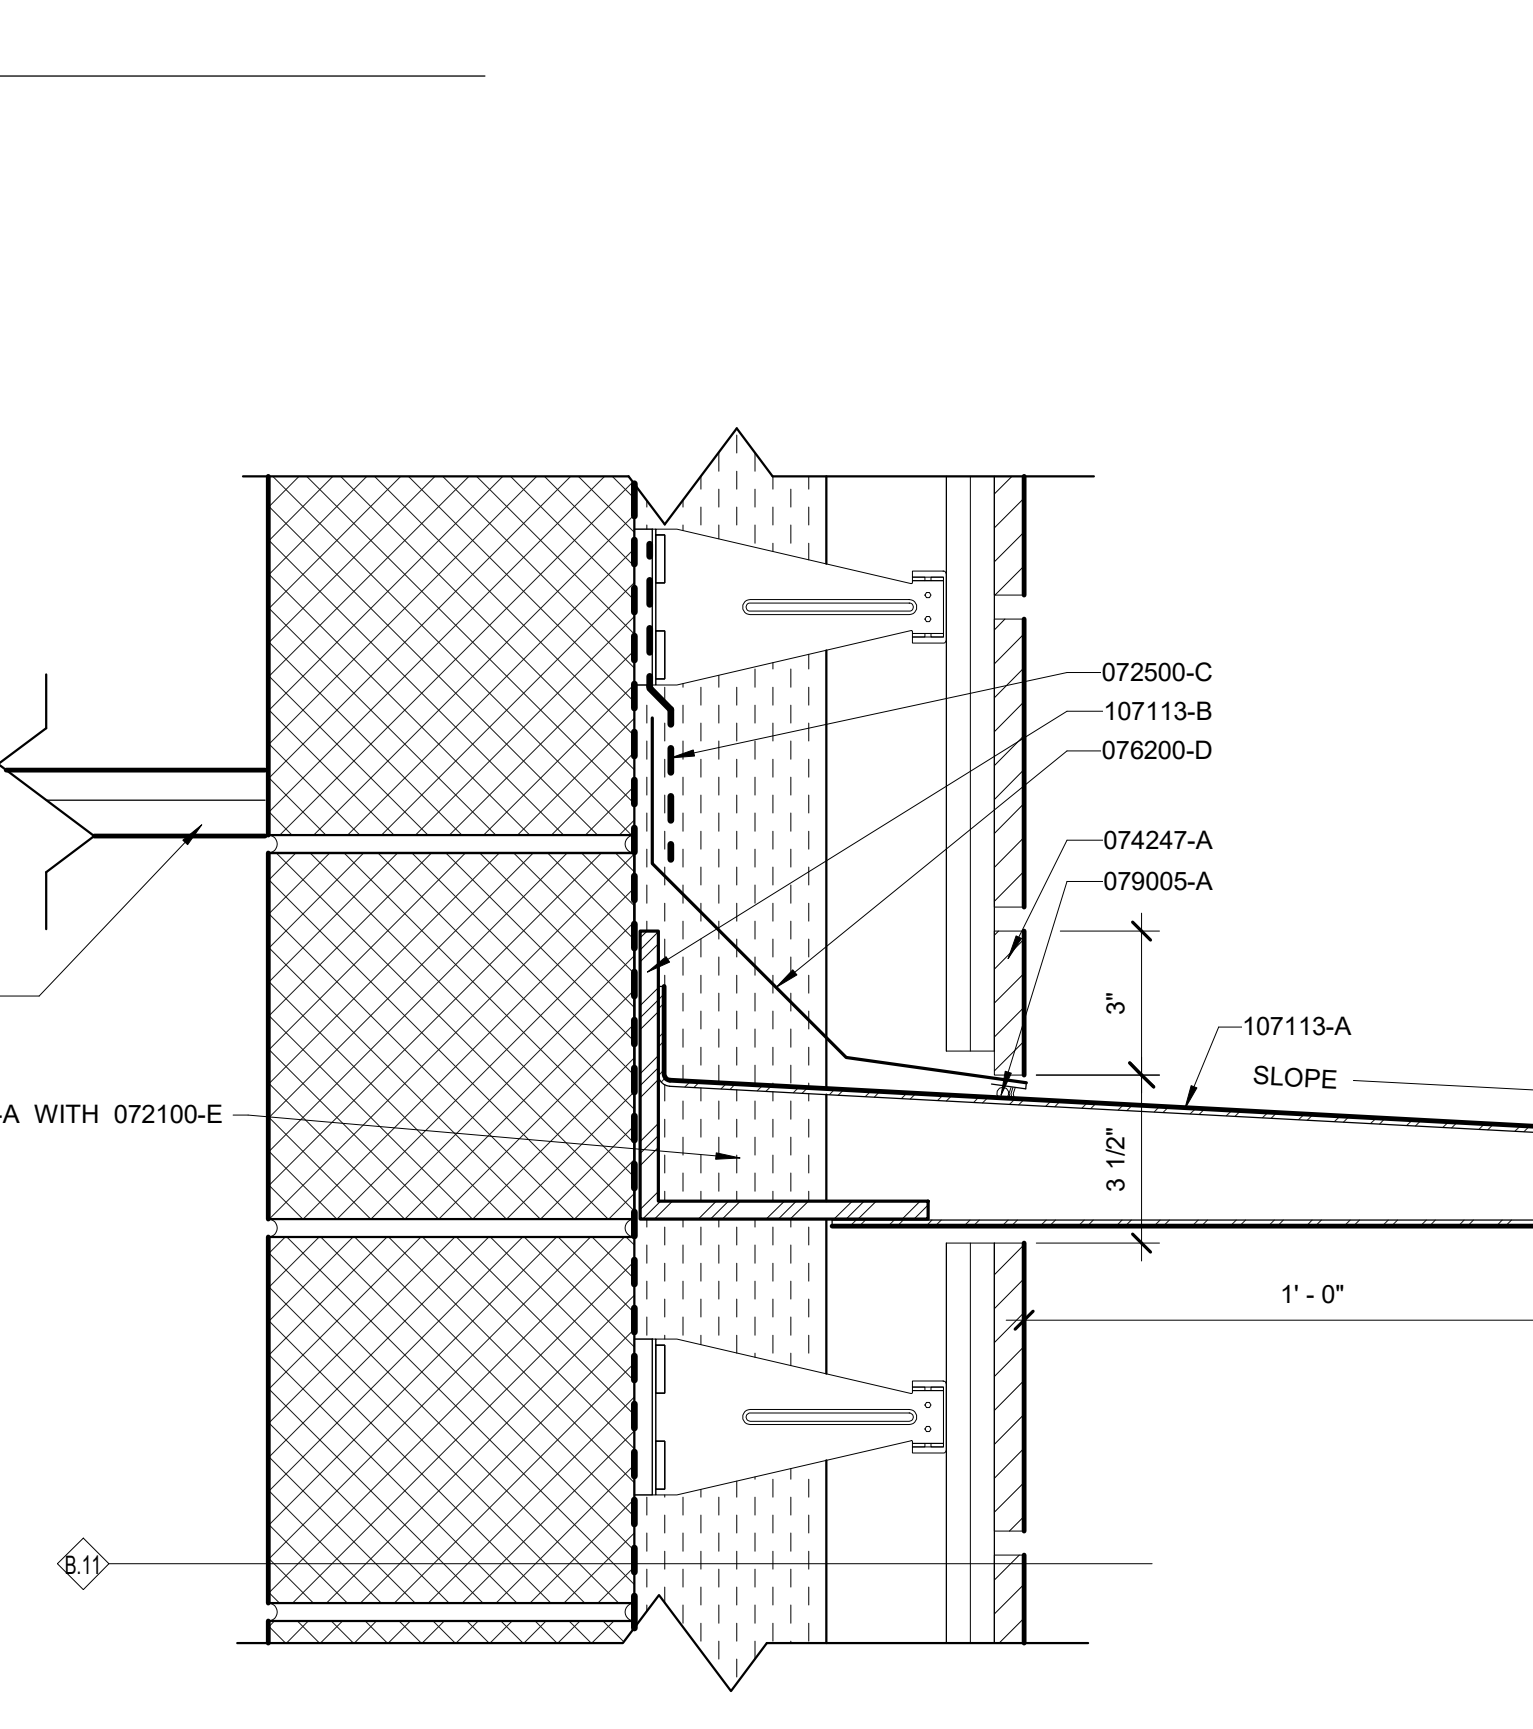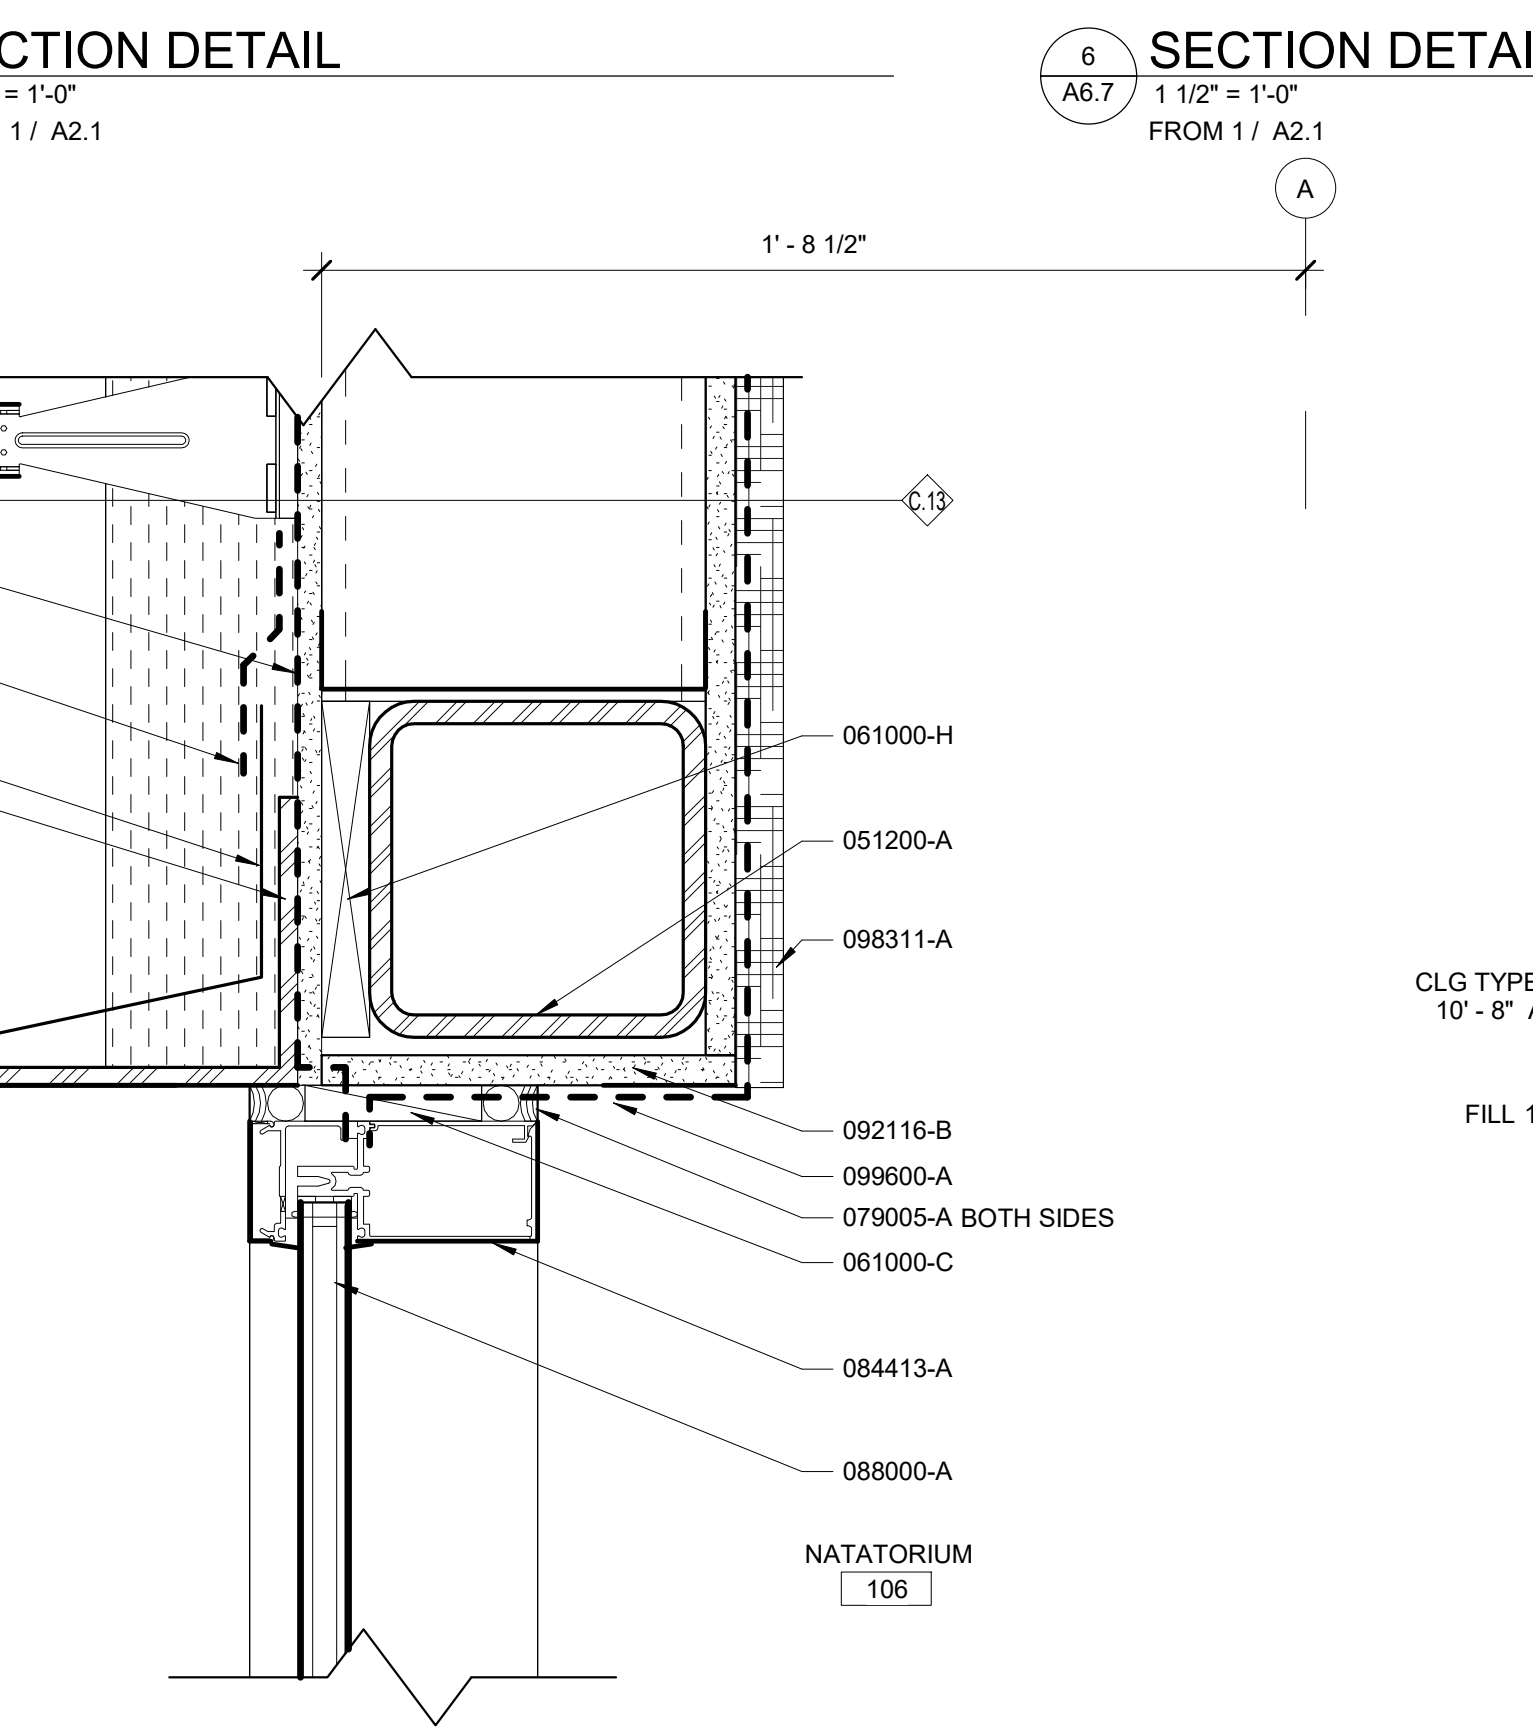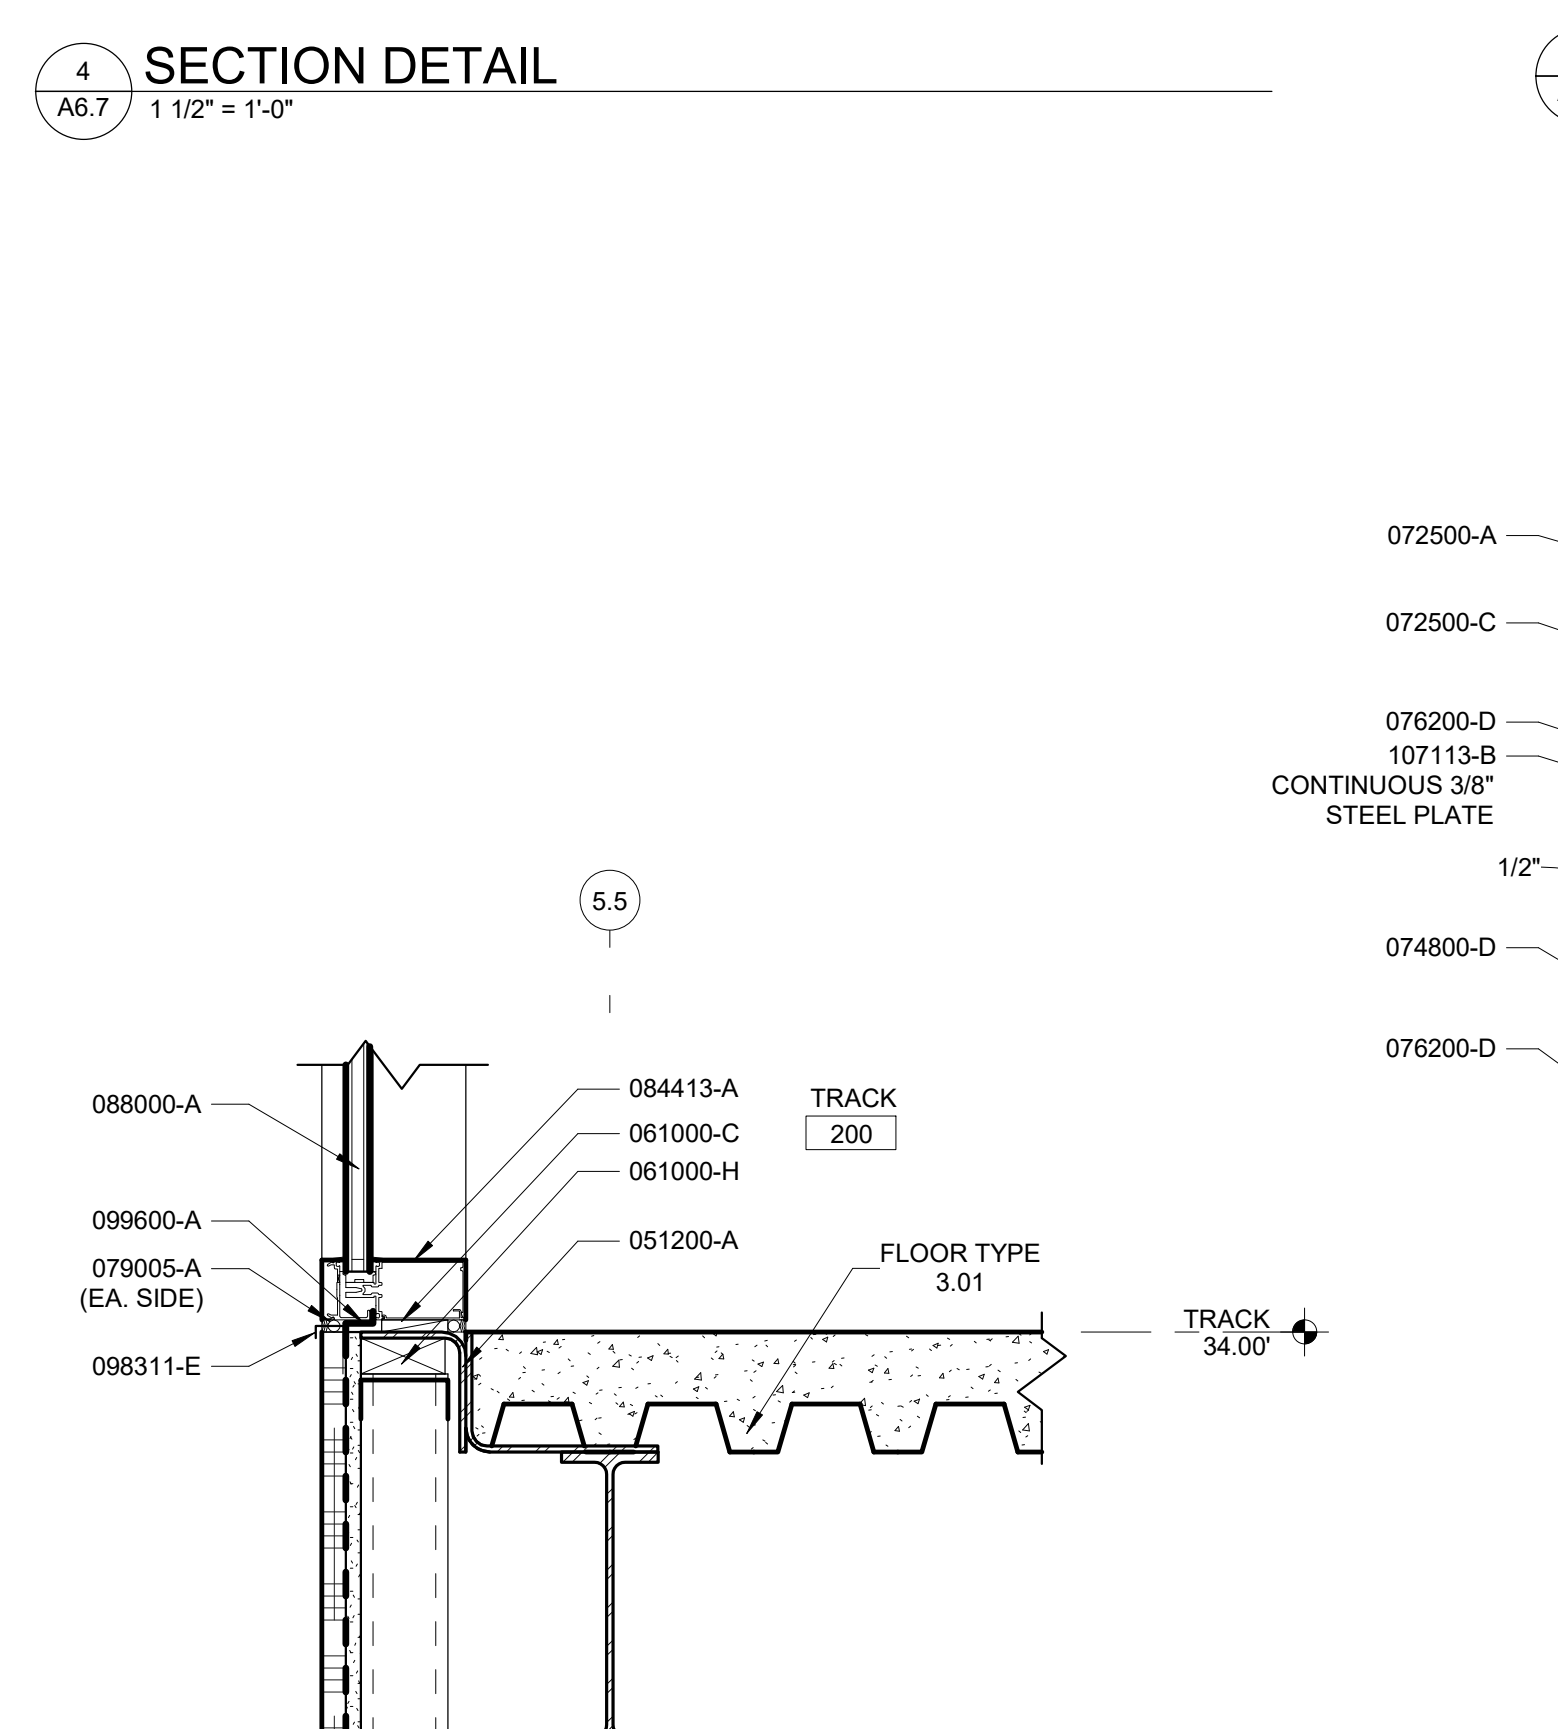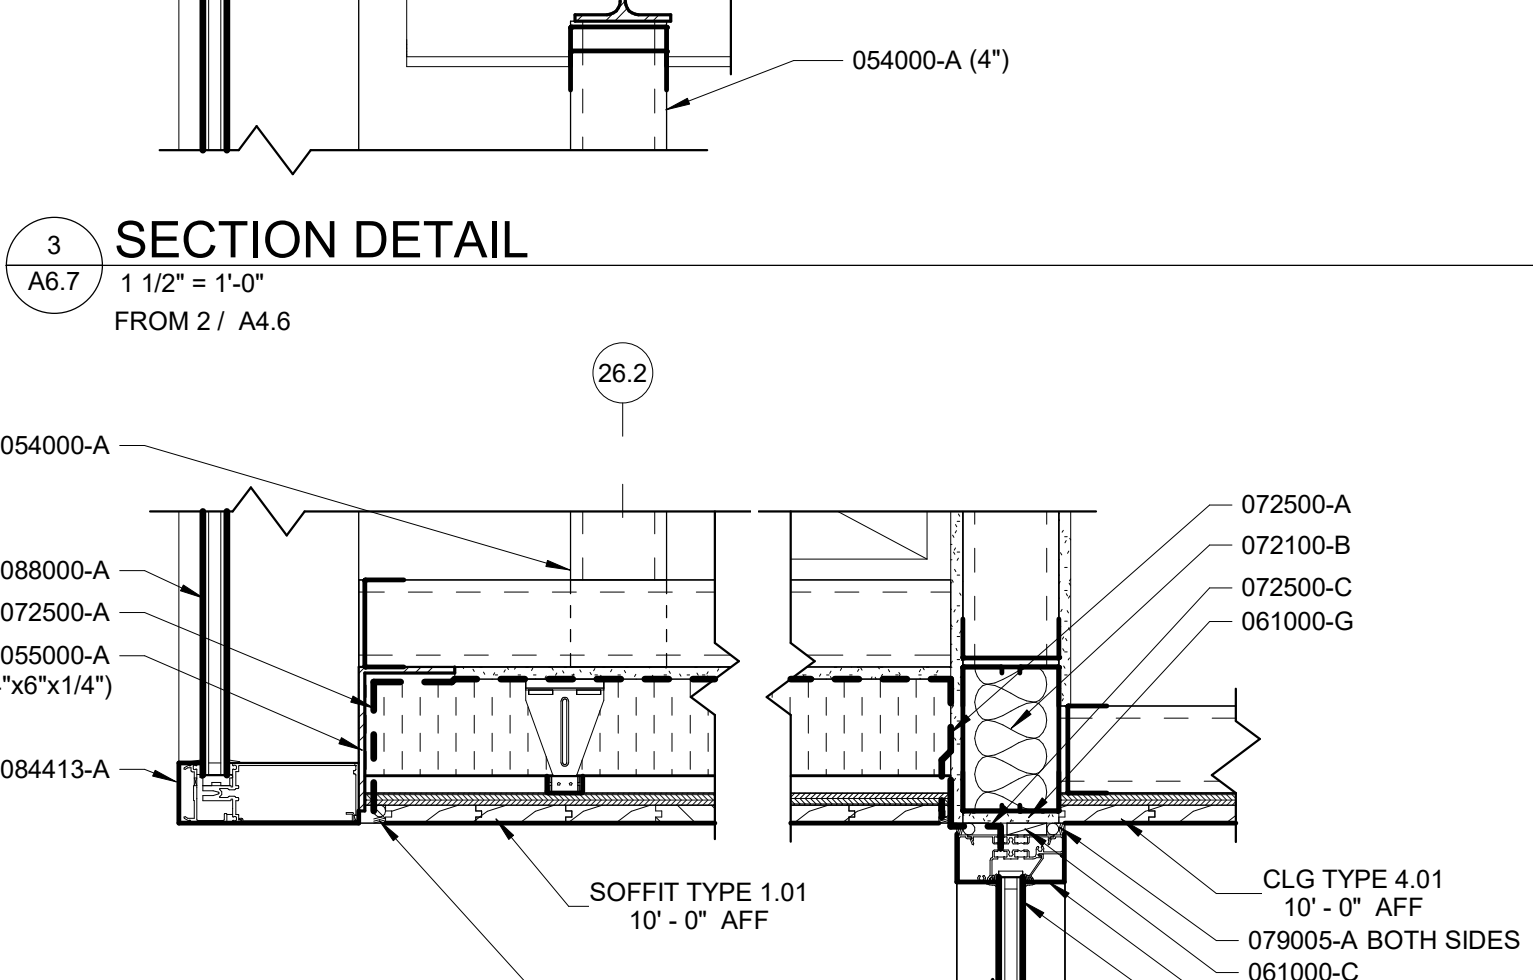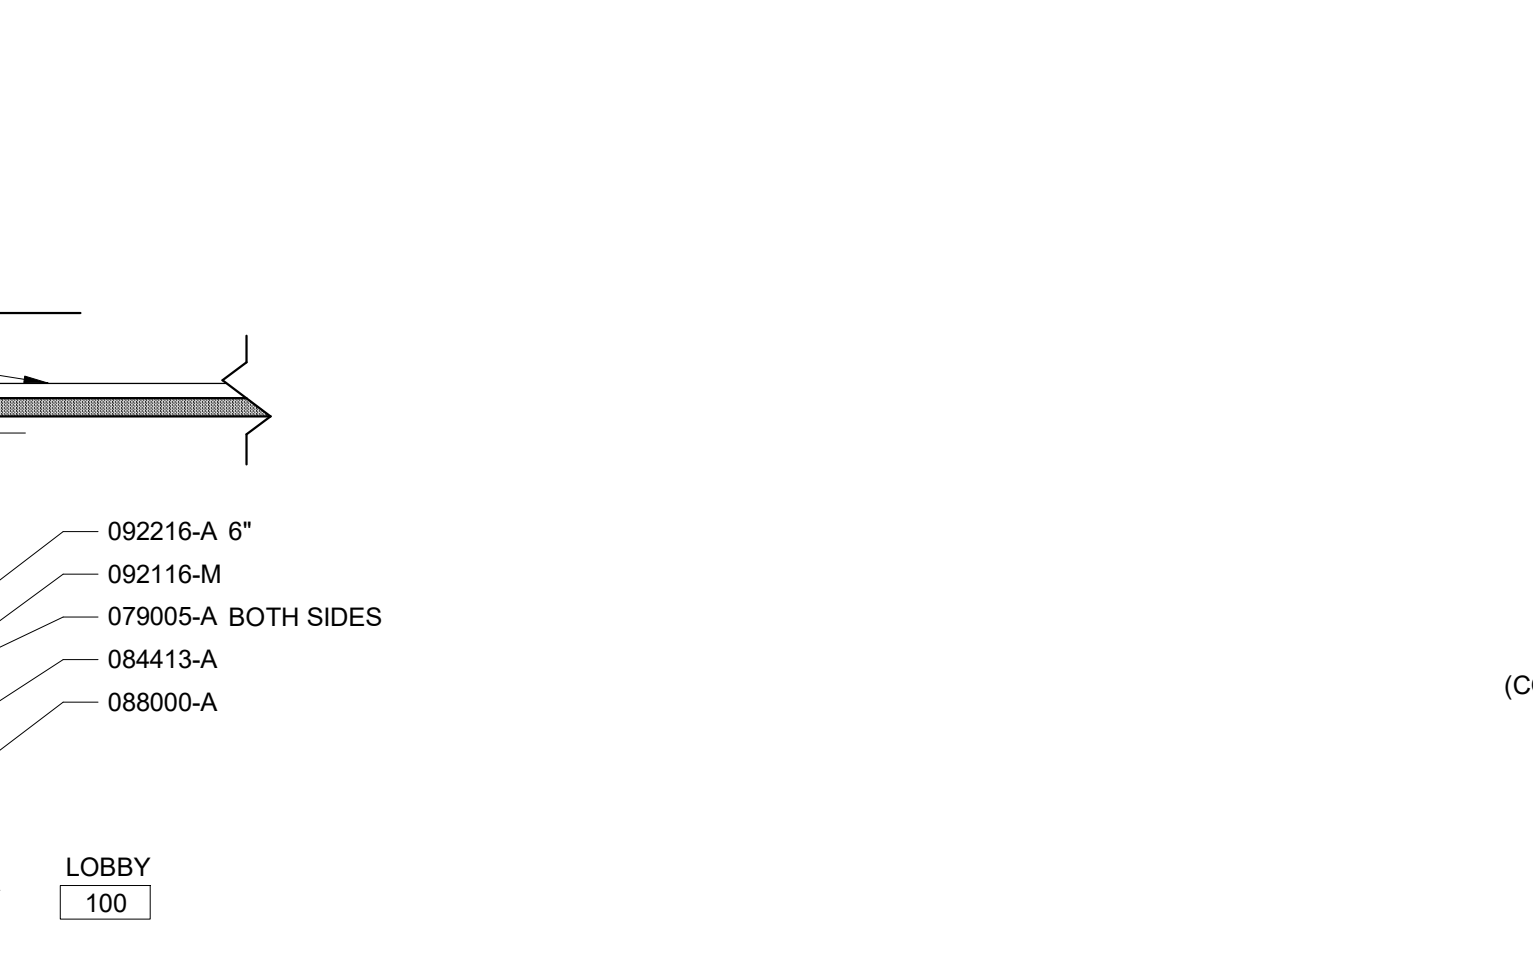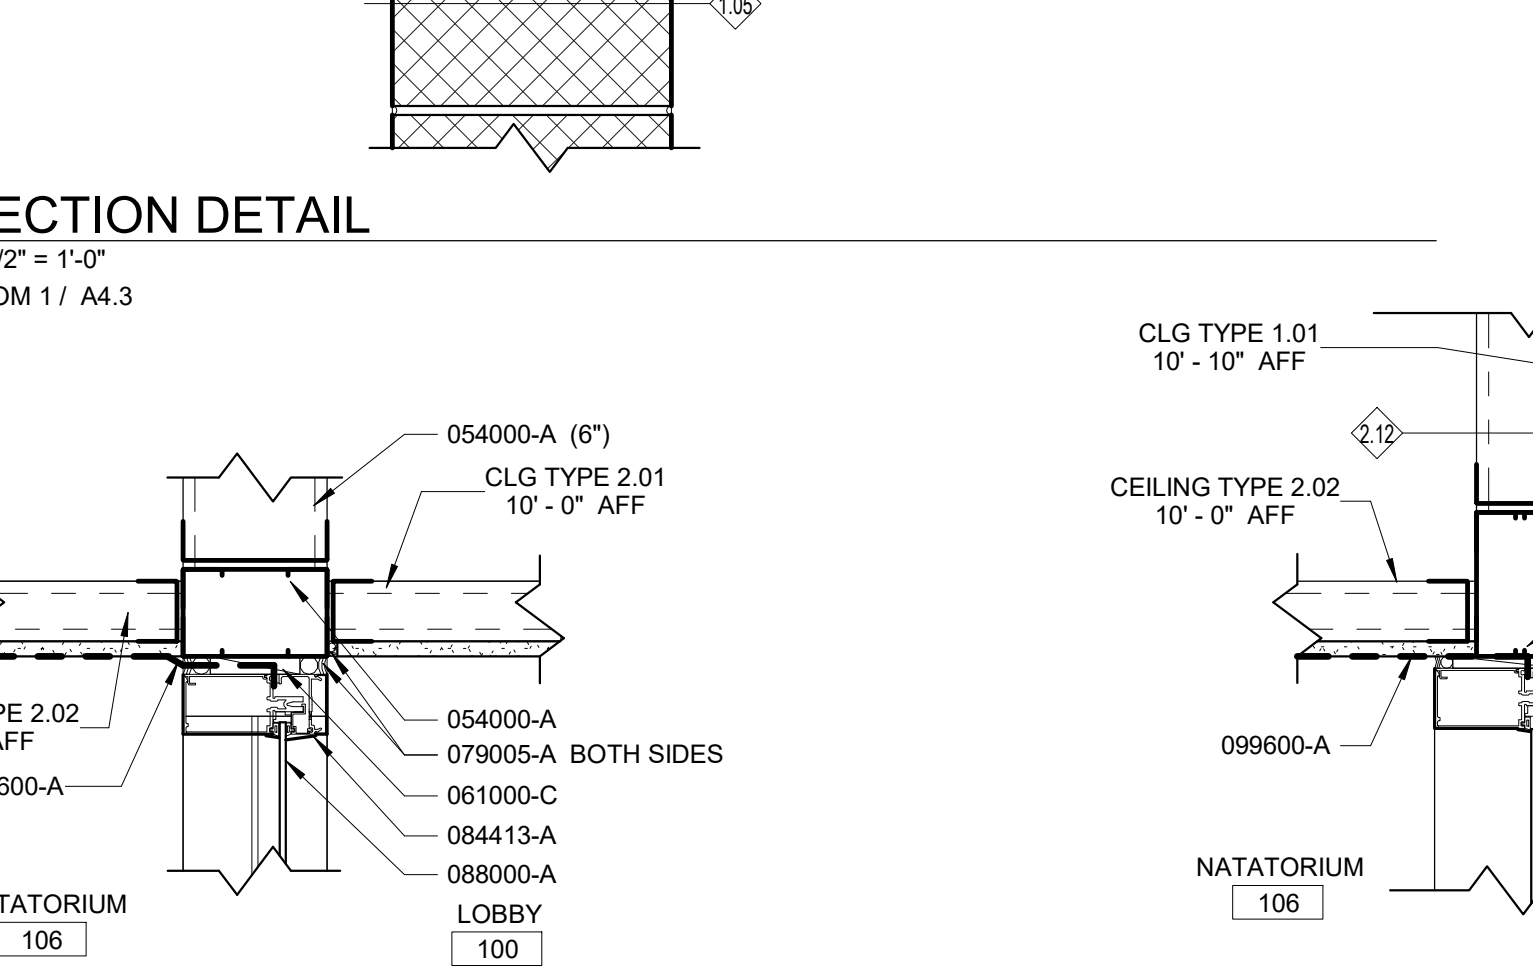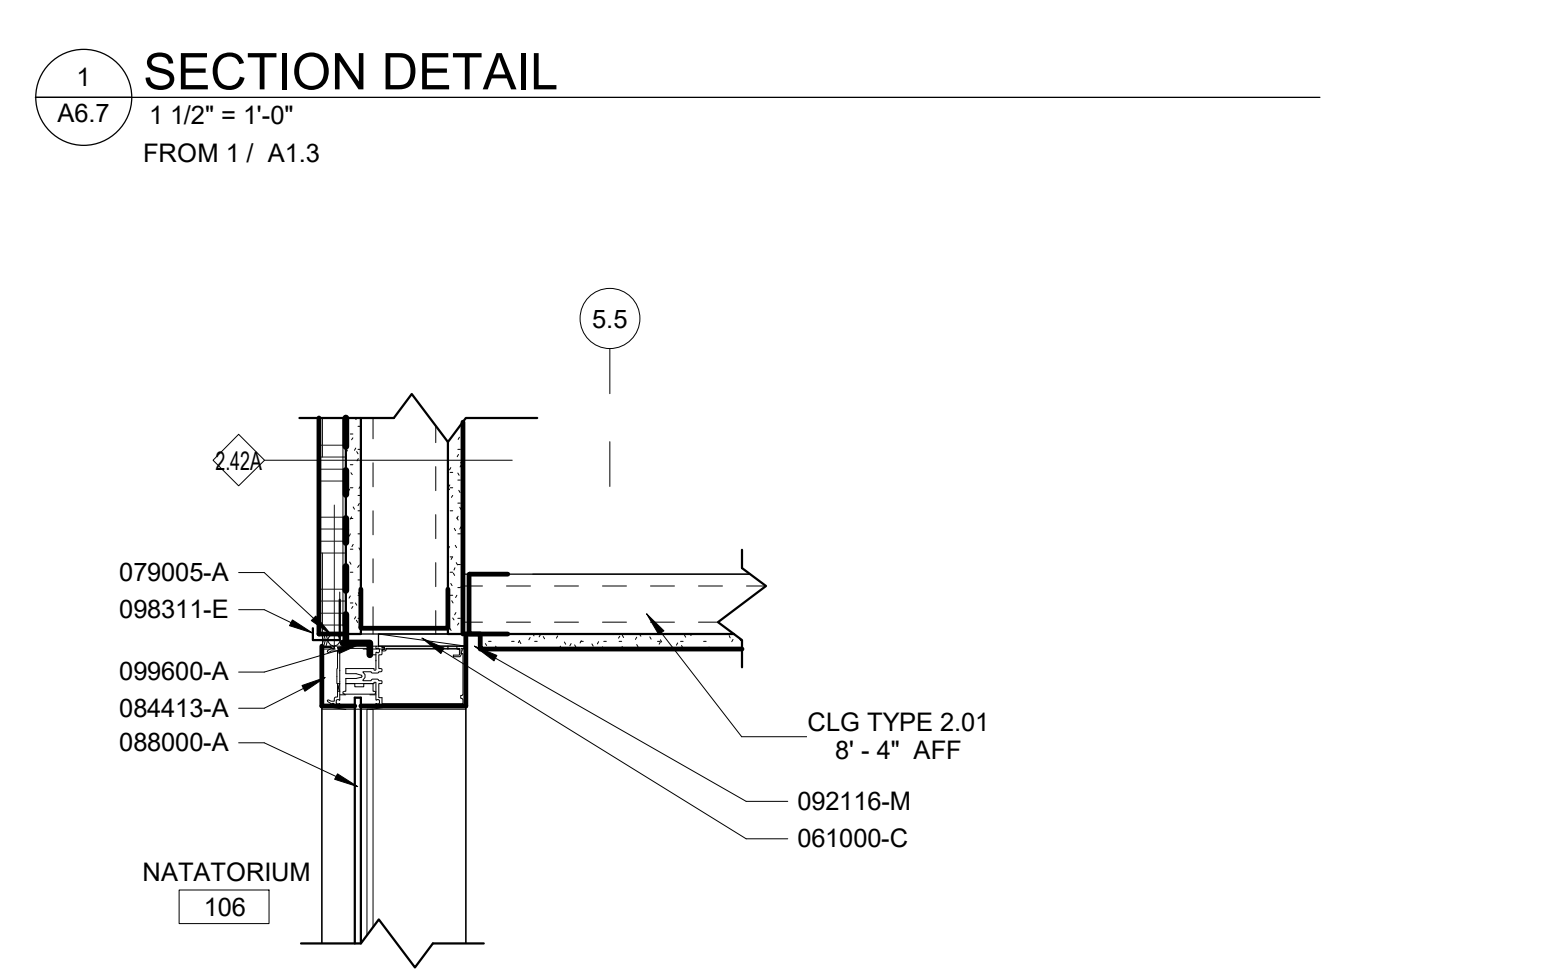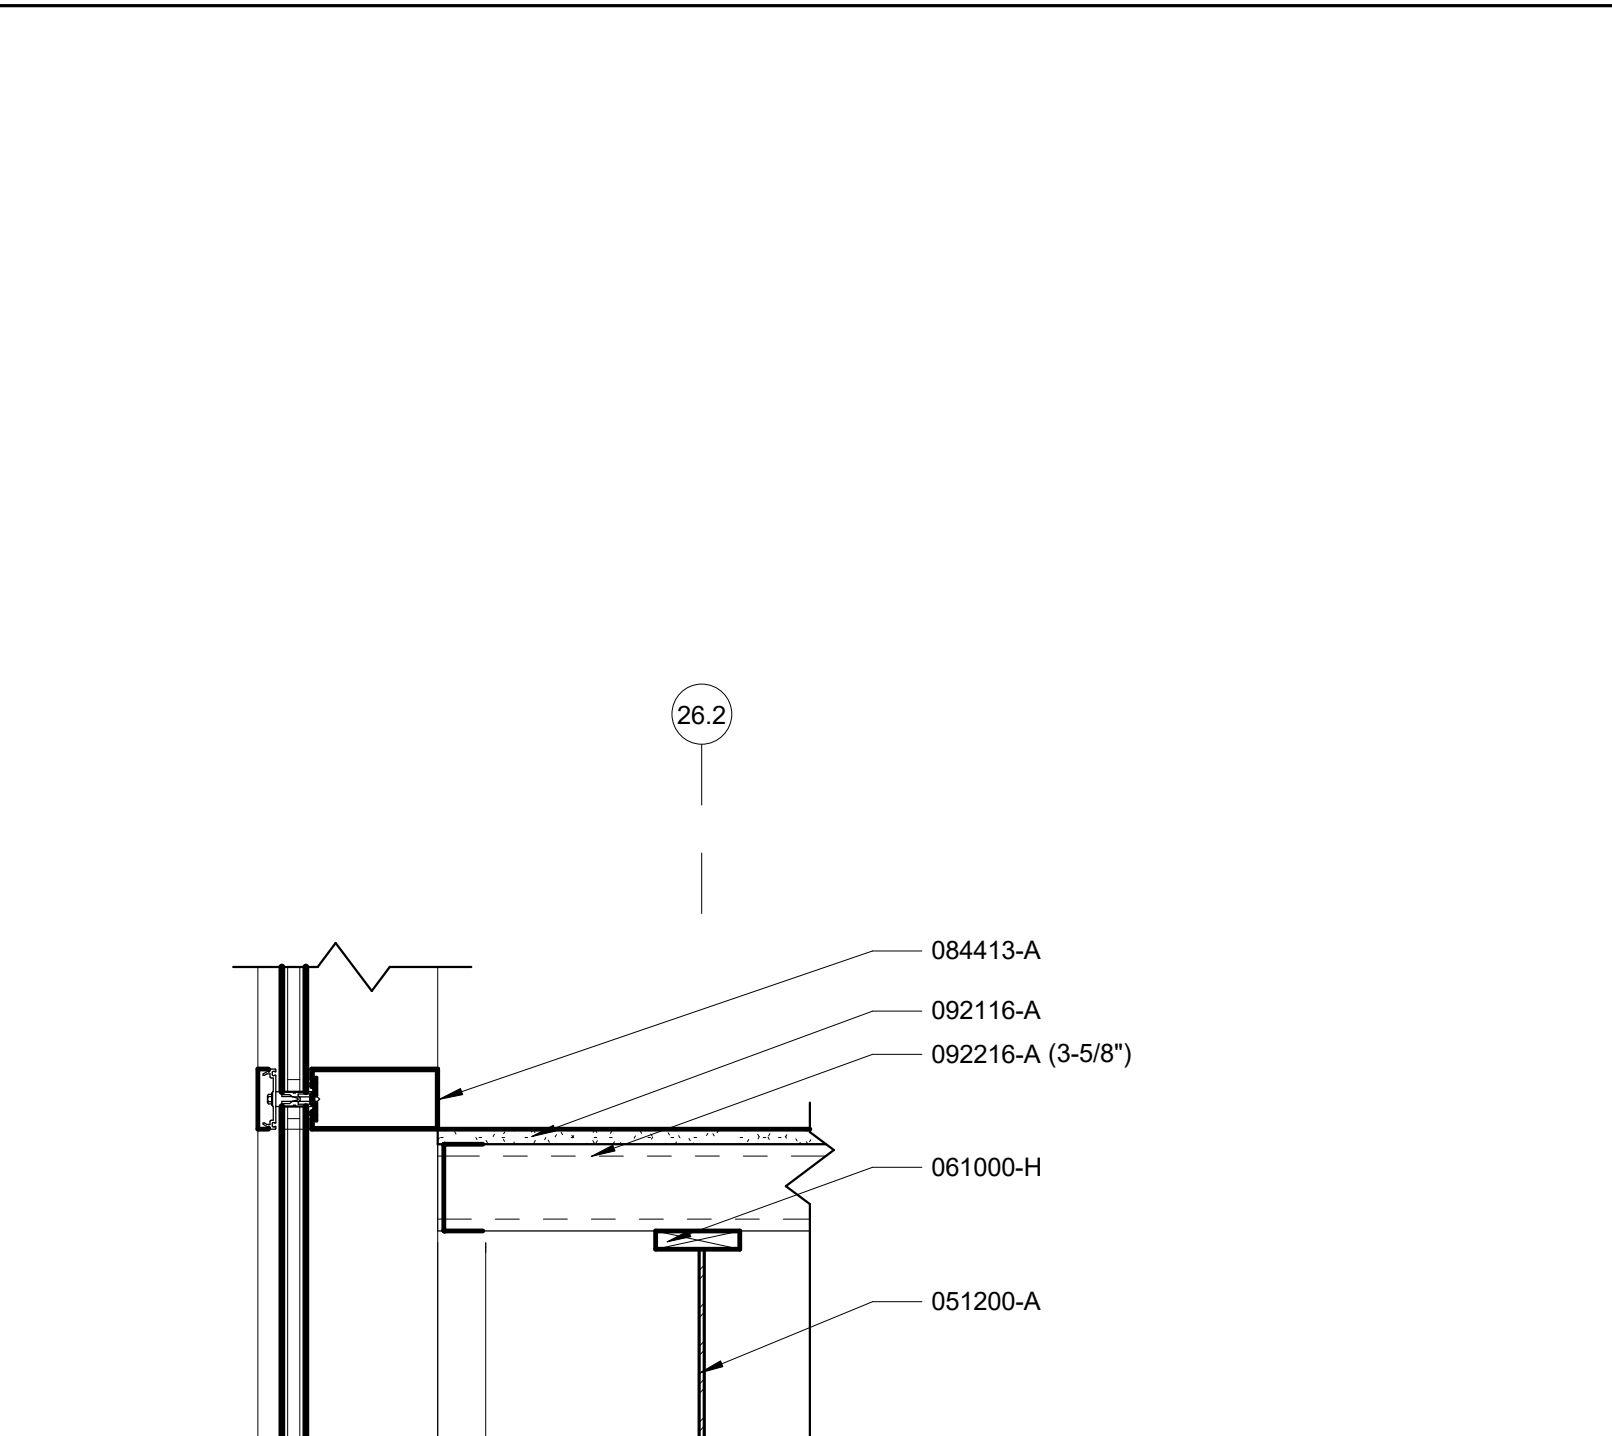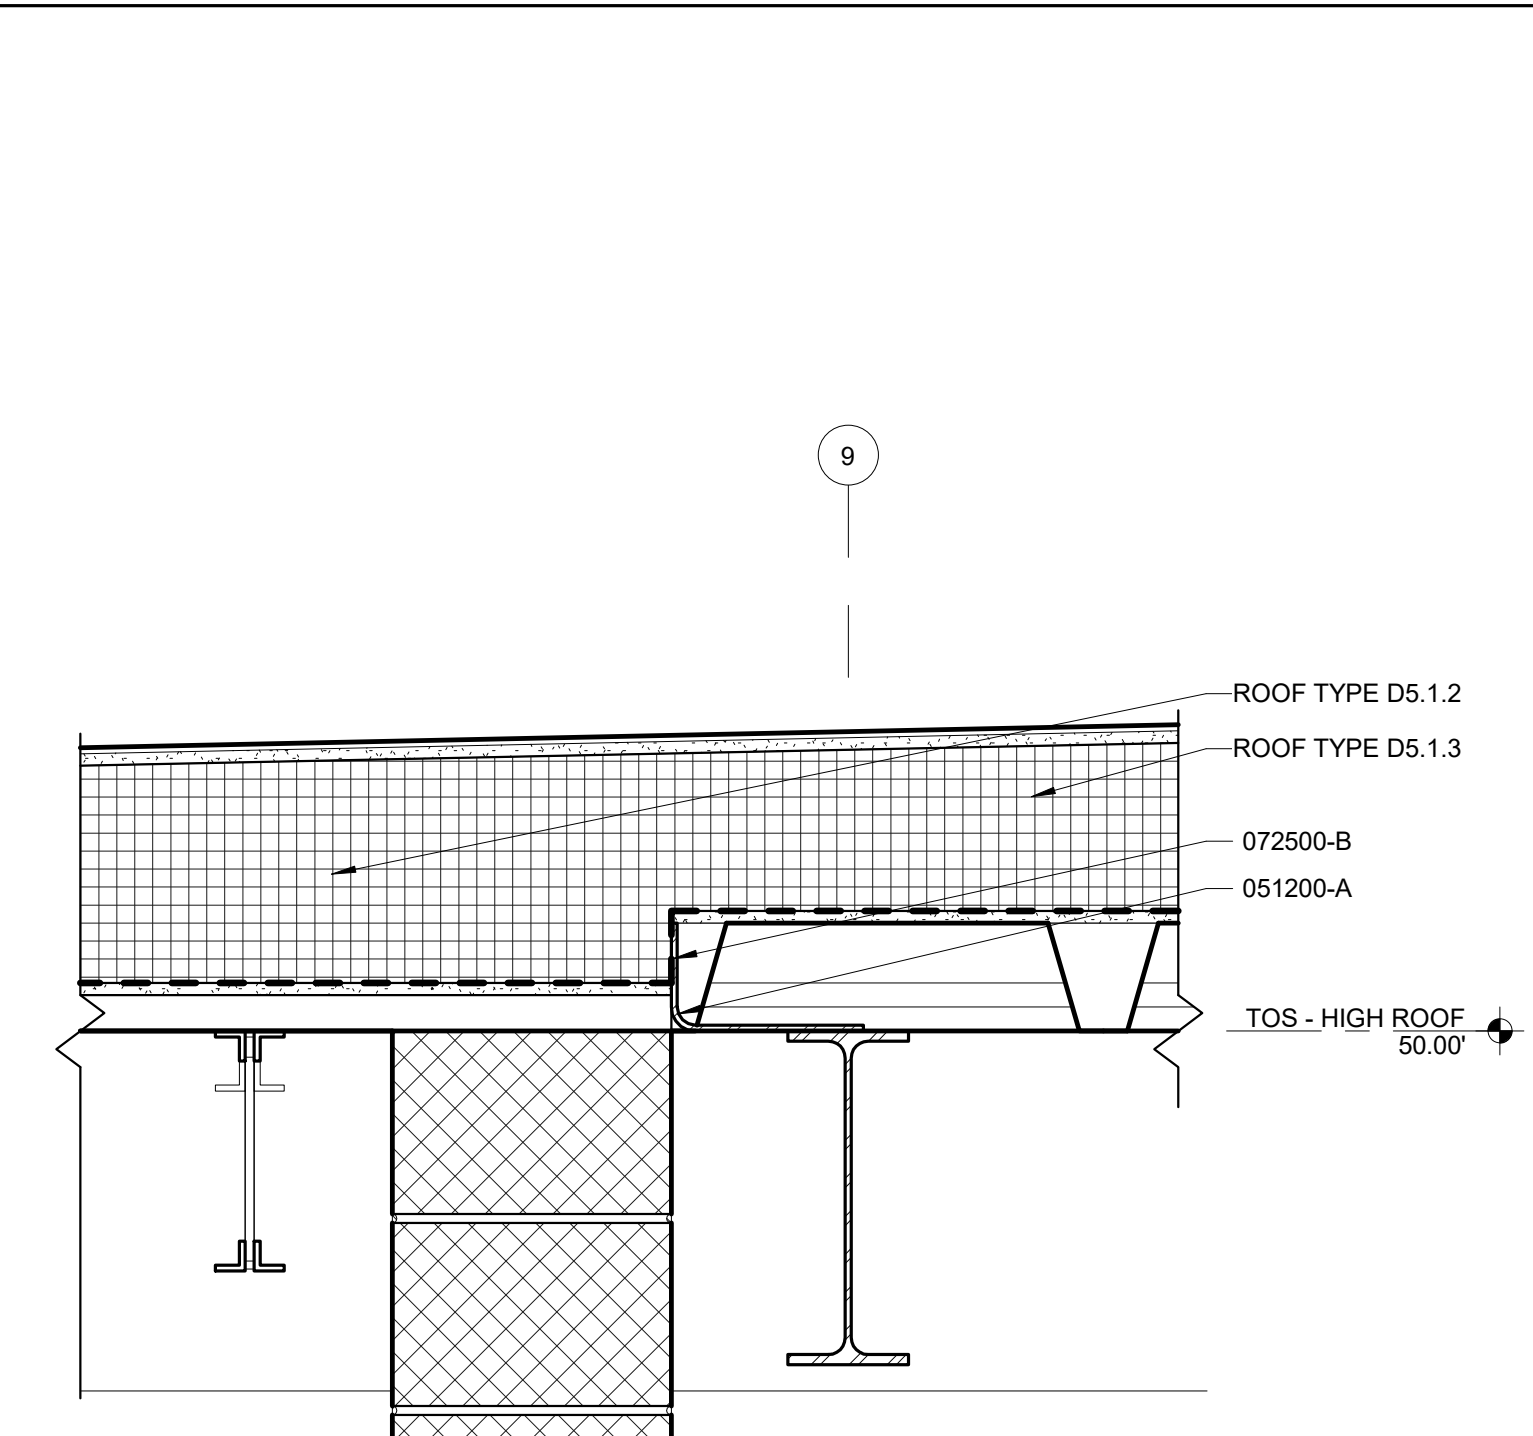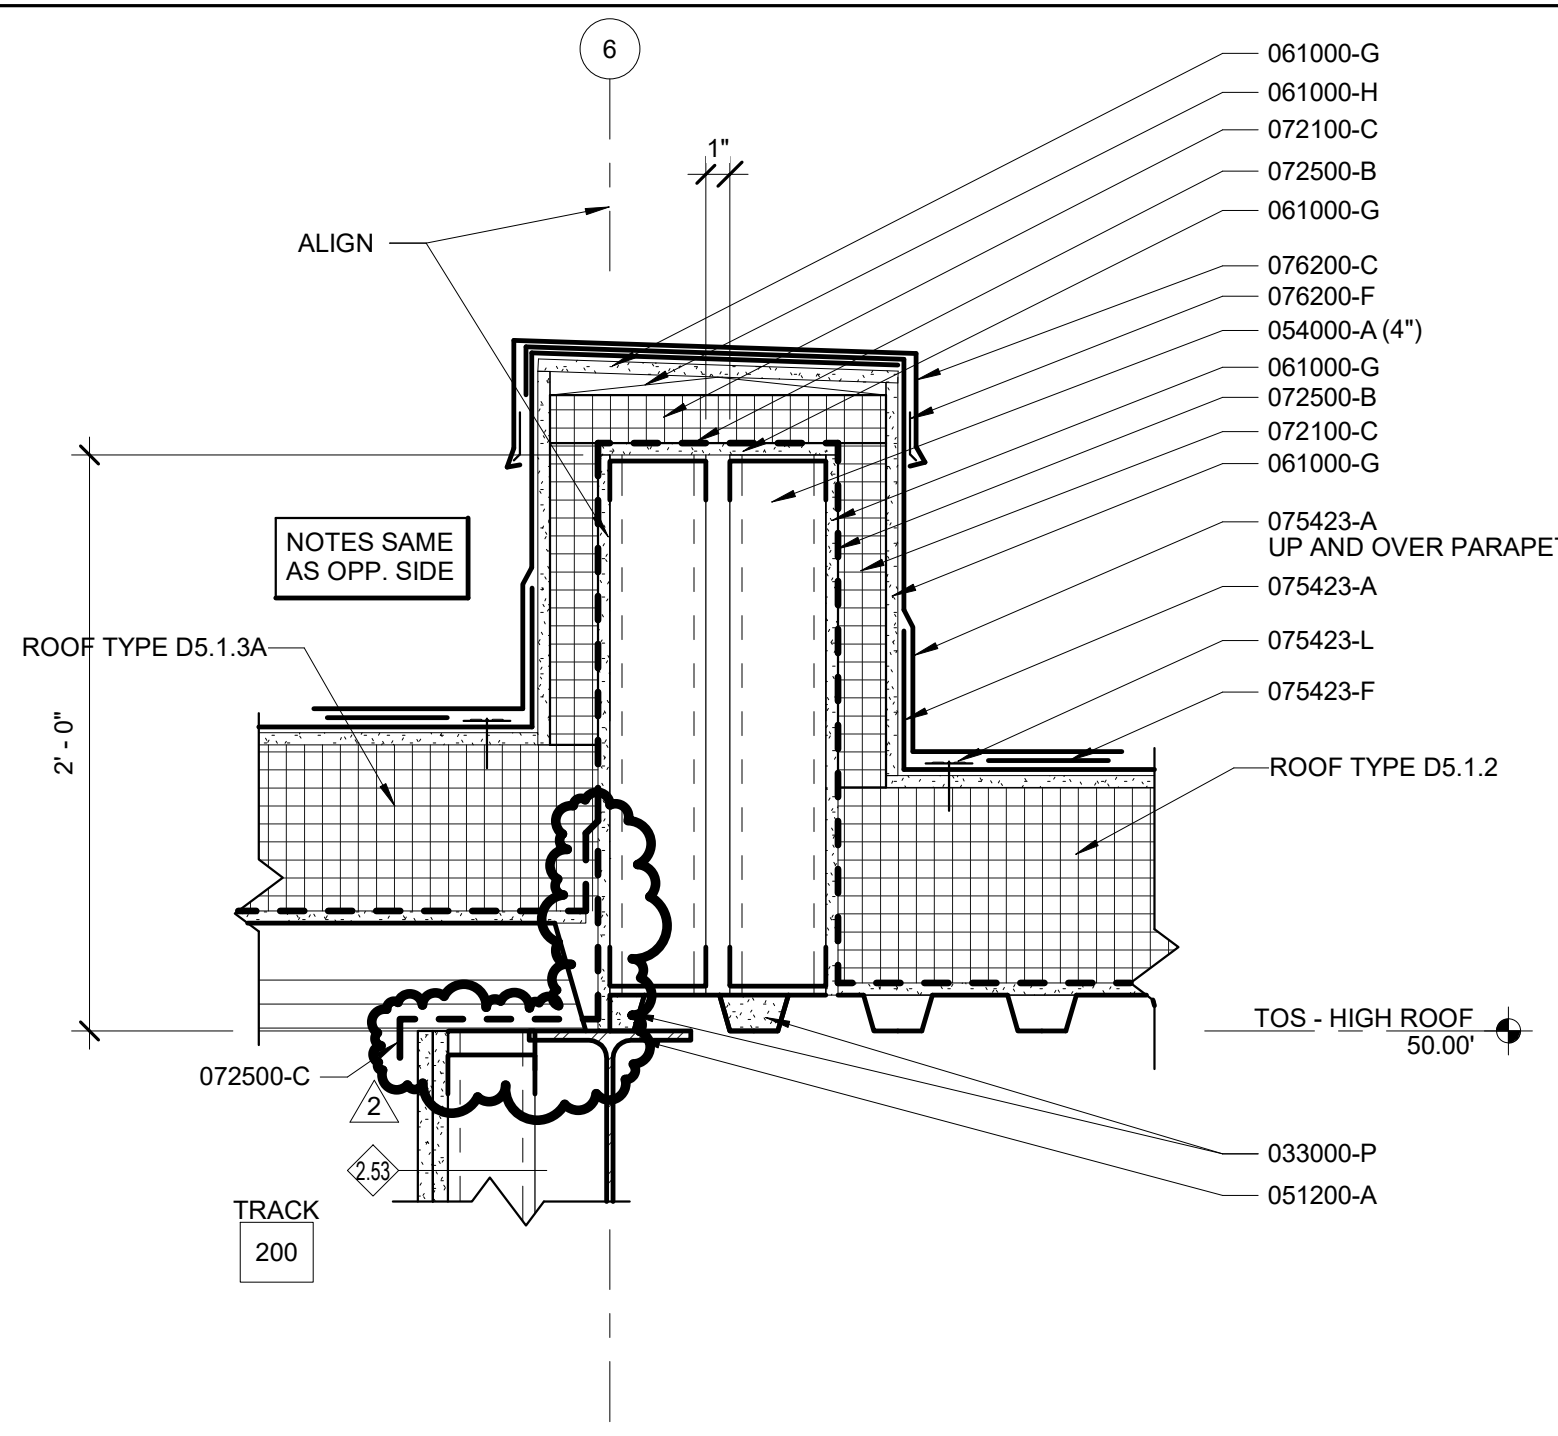


- KEY PLAN:
- KEYNOTES LISTED ON THIS SHEET ARE FOR CONVENIENCE ONLY. REFER TO SHEET CS.2 FOR COMPLETE LIST
- 033000-P NON-SHRINK GROUT
 - 051200-A STRUCTURAL STEEL (REFER TO STRUCTURAL FOR MORE INFORMATION)
 - 054000-A COLD-FORMED STEEL FRAMING, SIZE AS INDICATED
 - 055000-A STEEL ANGLE, SIZE AS INDICATED
 - 055000-B STEEL PLATE, SIZE AS INDICATED
 - 055000-V VIBRATION DAMPENING TAPE
 - 061000-C SHIM
 - 061000-G EXTERIOR GYPSUM SHEATHING, 1/2" UNO
 - 061000-H FIRE-RETARDANT TREATED BLOCKING
 - 072100-B BATT INSULATION, 5 1/2" UNO (OR MAX THICKNESS FOR LOCATION)
 - 072100-C RIGID INSULATION BOARD, 2" THICK UNO
 - 072100-E MINERAL WOOL INSULATION BOARD, 4" THICK UNO
 - 072500-A VAPOR-PERMEABLE, AIRWATER-RESISTIVE BARRIER
 - 072500-B VAPOR-IMPERMEABLE, AIRWATER-RESISTIVE BARRIER
 - 072500-C TRANSITION MEMBRANE
 - 074247-A CONCRETE PANEL
 - 074800-D INSECT SCREEN
 - 075423-A TPO ROOFING
 - 075423-F TPO SPLICE TAPE
 - 075423-L FASTENER
 - 076200-C METAL COPING
 - 076200-D METAL FLASHING
 - 076200-F CONTINUOUS LOCKING METAL CLEAT
 - 079005-A JOINT SEALANT AND BACKER ROD
 - 084313-A GLAZED ALUMINUM STOREFRONT
 - 084413-A GLAZED ALUMINUM CURTAIN WALL
 - 084413-F CURTAIN WALL ANCHOR BRACKET
 - 088000-A GLAZING, REFER TO A8 SERIES FOR GL TYPE
 - 092116-A GYPSUM BOARD, ABUSE AND MOISTURE RESISTANT, 5/8" THICKNESS UNO
 - 092116-B GYPSUM BOARD, MOISTURE RESISTANT TYPE XP, 5/8" THICKNESS UNO
 - 092116-M METAL "F" REVEAL MOLDING, FRY REGLET DRMF S25-50 OR EQUAL
 - 092216-A NON-STRUCTURAL METAL STUD, SIZE AS INDICATED
 - 098311-A SHREDDED WOOD ACOUSTIC PANEL, PAINTED PFT-1 UNO, 2" THICK UNO
 - 098311-E ALUMINUM J TRIM
 - 099600-A MULTI-LAYER IMPERMEABLE SURFACE
 - 107113-A ALUMINUM PLATE, 1/8" THICK, 3-COAT FLOUROPOLYMER FINISH - COLOR 3 UNO
 - 107113-B ALUMINUM ANGLE, SIZE AS INDICATED, 3-COAT FLOUROPOLYMER FINISH - COLOR 1 UNO
 - 230000-A MECHANICAL (REFER TO MECHANICAL FOR MORE INFORMATION)
 - 260000-A ELECTRICAL (REFER TO ELECTRICAL FOR MORE INFORMATION)

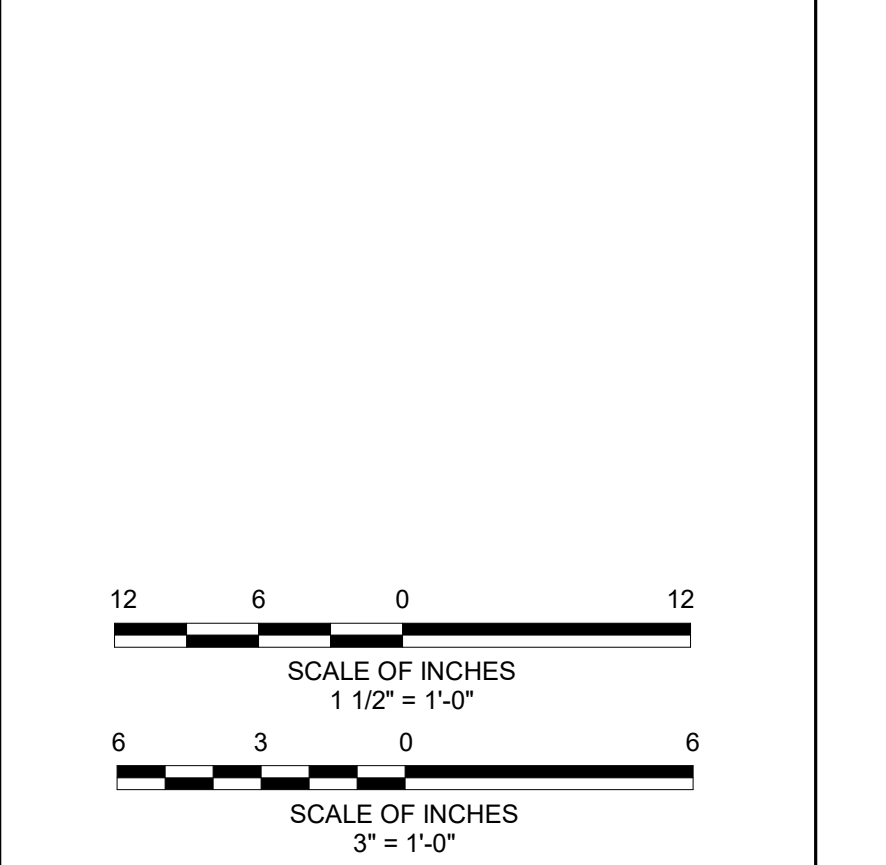

ISSUED FOR BID

Seal

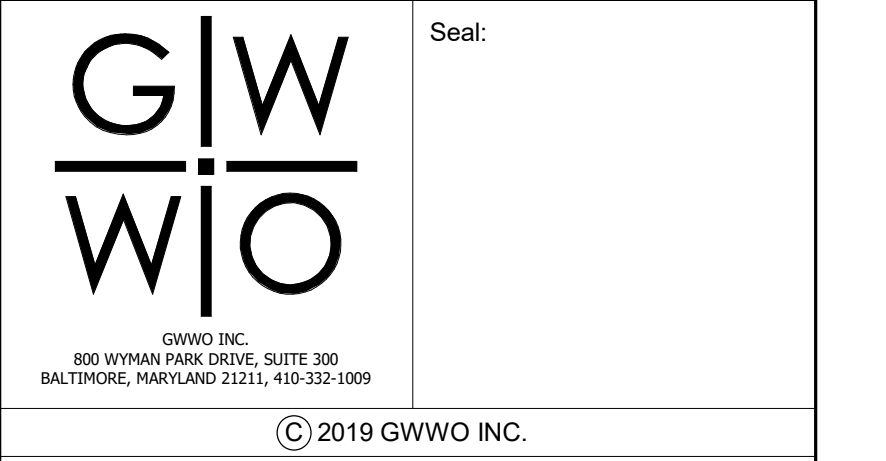

© 2019 GW WIO INC.


CERTIFY THAT THESE DOCUMENTS WERE PREPARED OR APPROVED BY ME, AND THAT I AM A DULY LICENSED ARCHITECT UNDER THE LAWS OF THE STATE OF MARYLAND. LICENSE NUMBER: 8400, EXPIRATION DATE: 12/31/2020

Revisions:	No.	Date	Description
	2	1/28/2020	ADDENDUM 2


MIDDLE BRANCH FITNESS & WELLNESS CENTER AT CHERRY HILL
BALTIMORE CITY RECREATION & PARKS

Job No.	#18010	AWM	Drawn
Scale	As indicated	KMS	Checked
Date	12/13/2019	AER	Approved
Drawing Title	SECTION DETAILS		
Sheet	A6.7r2		


ADDENDUM NO. 2 pg. 117 of 132

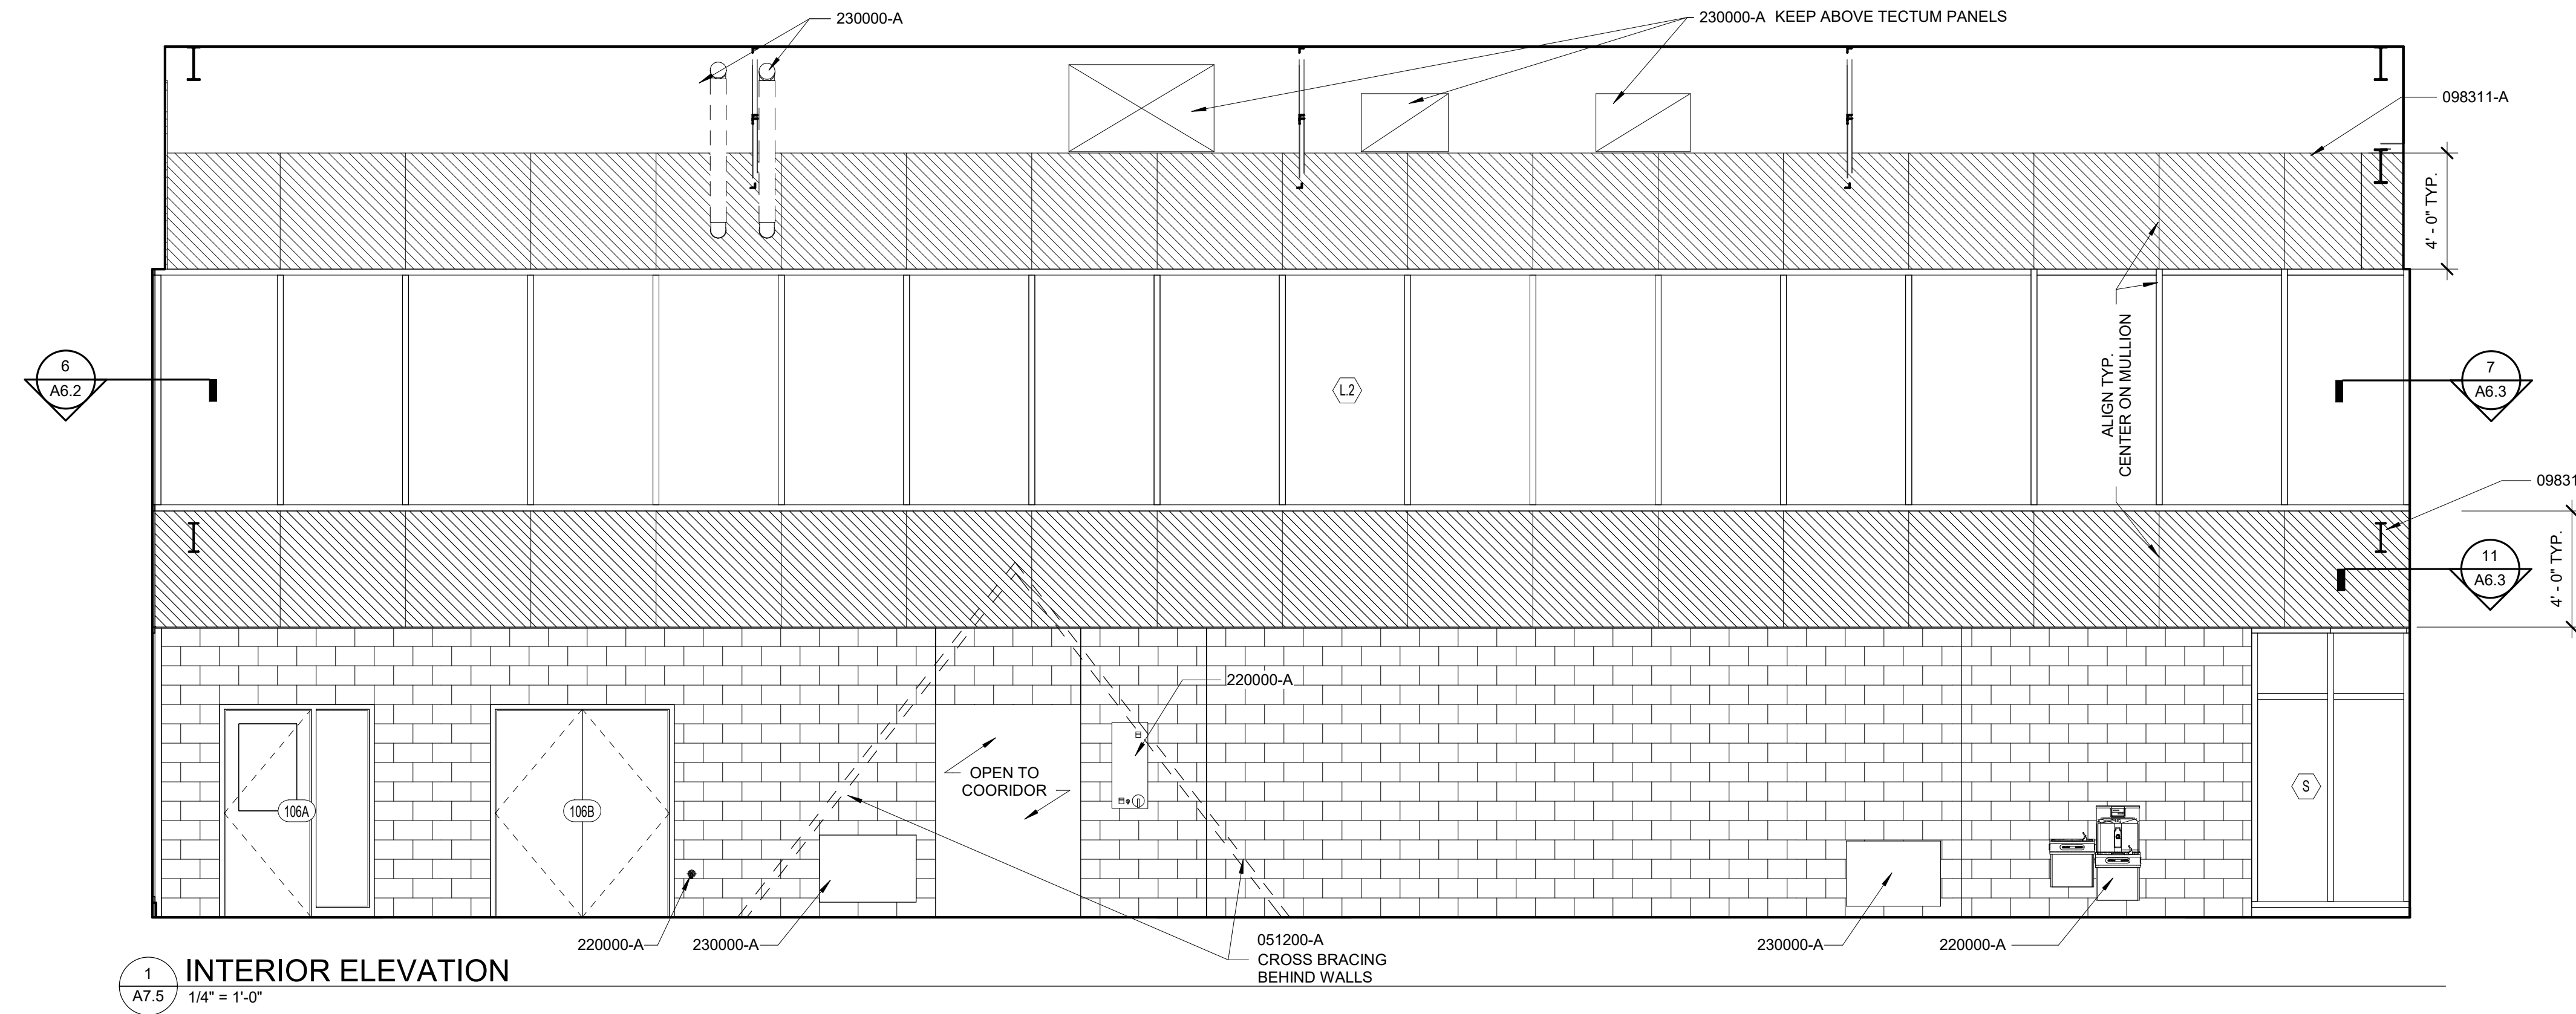

1
A7.5
1/4" = 1'-0"

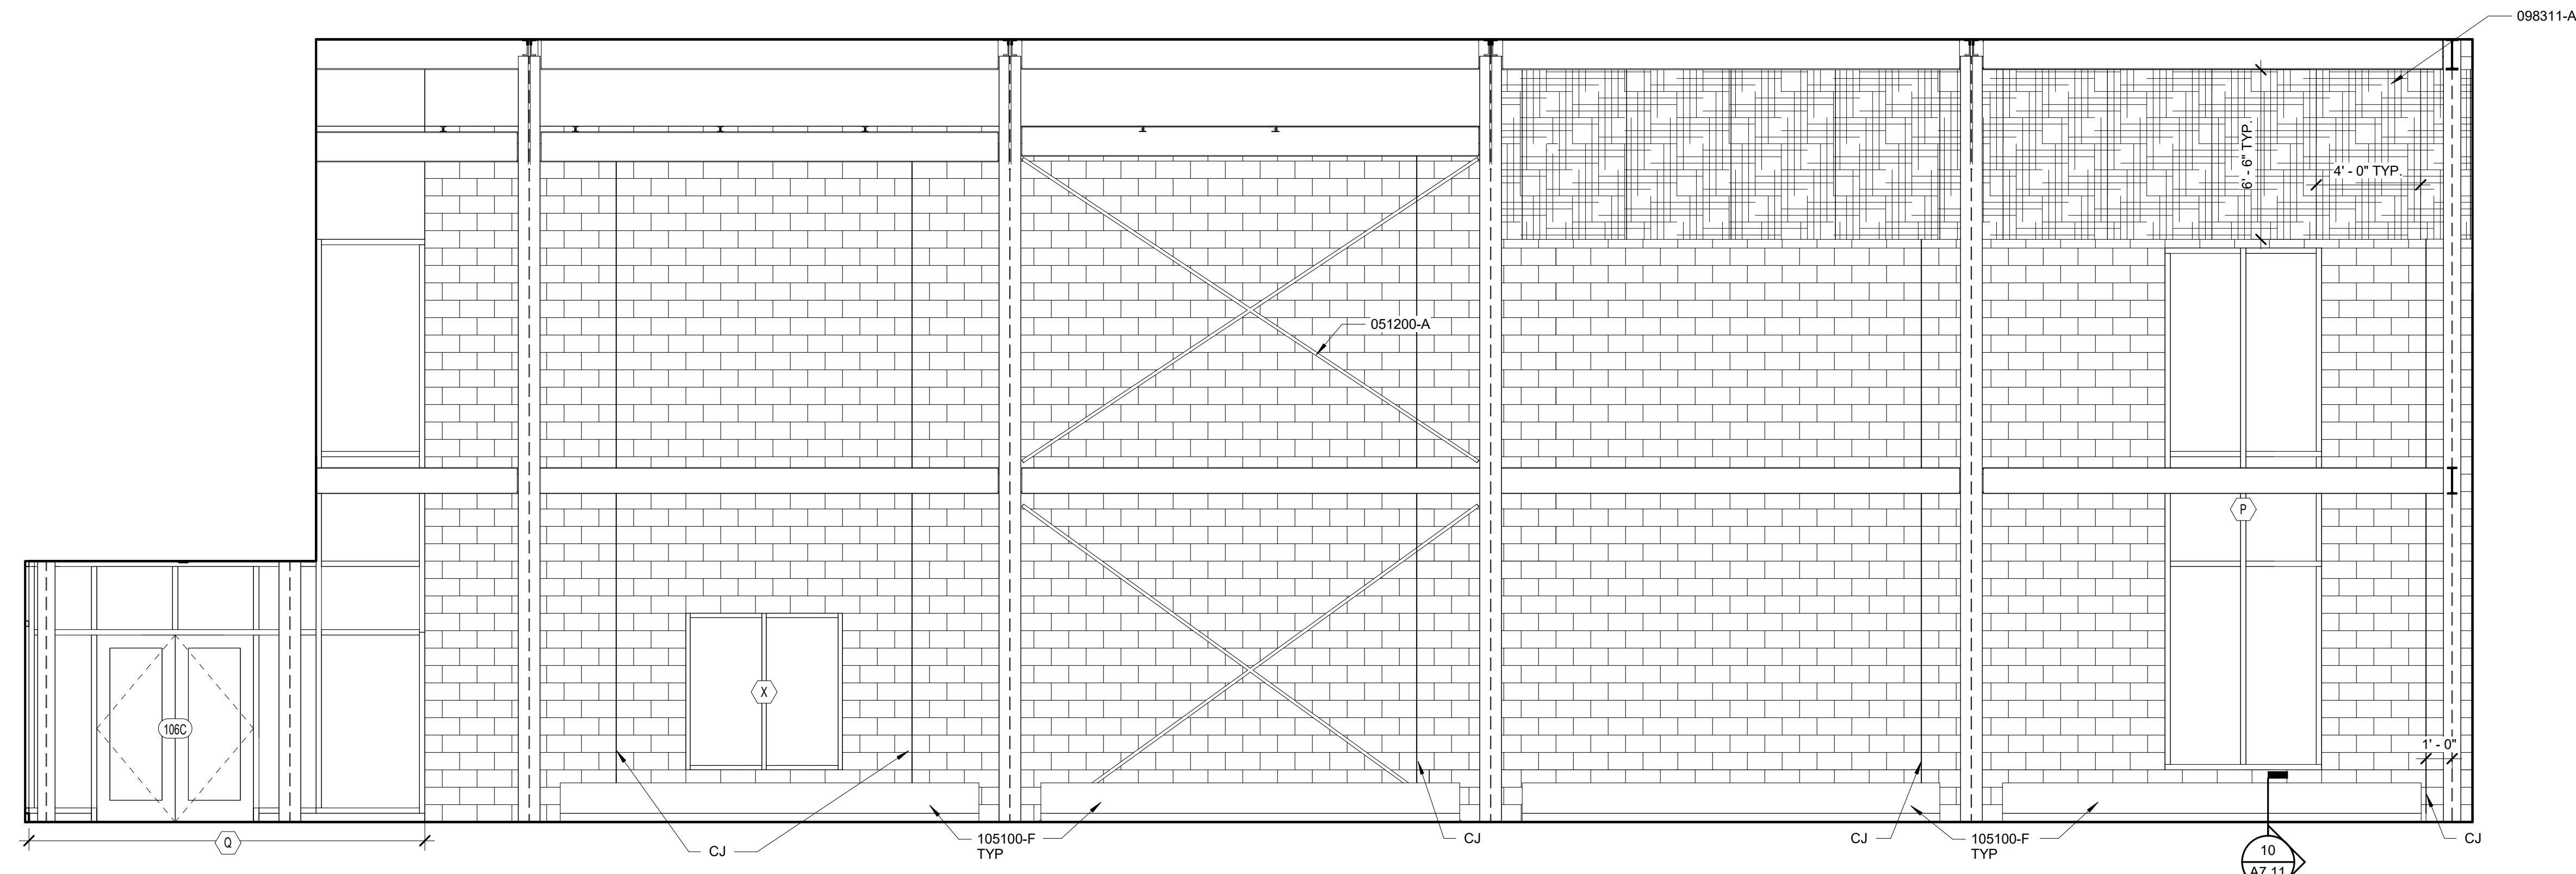

2
A7.5
1/4" = 1'-0"

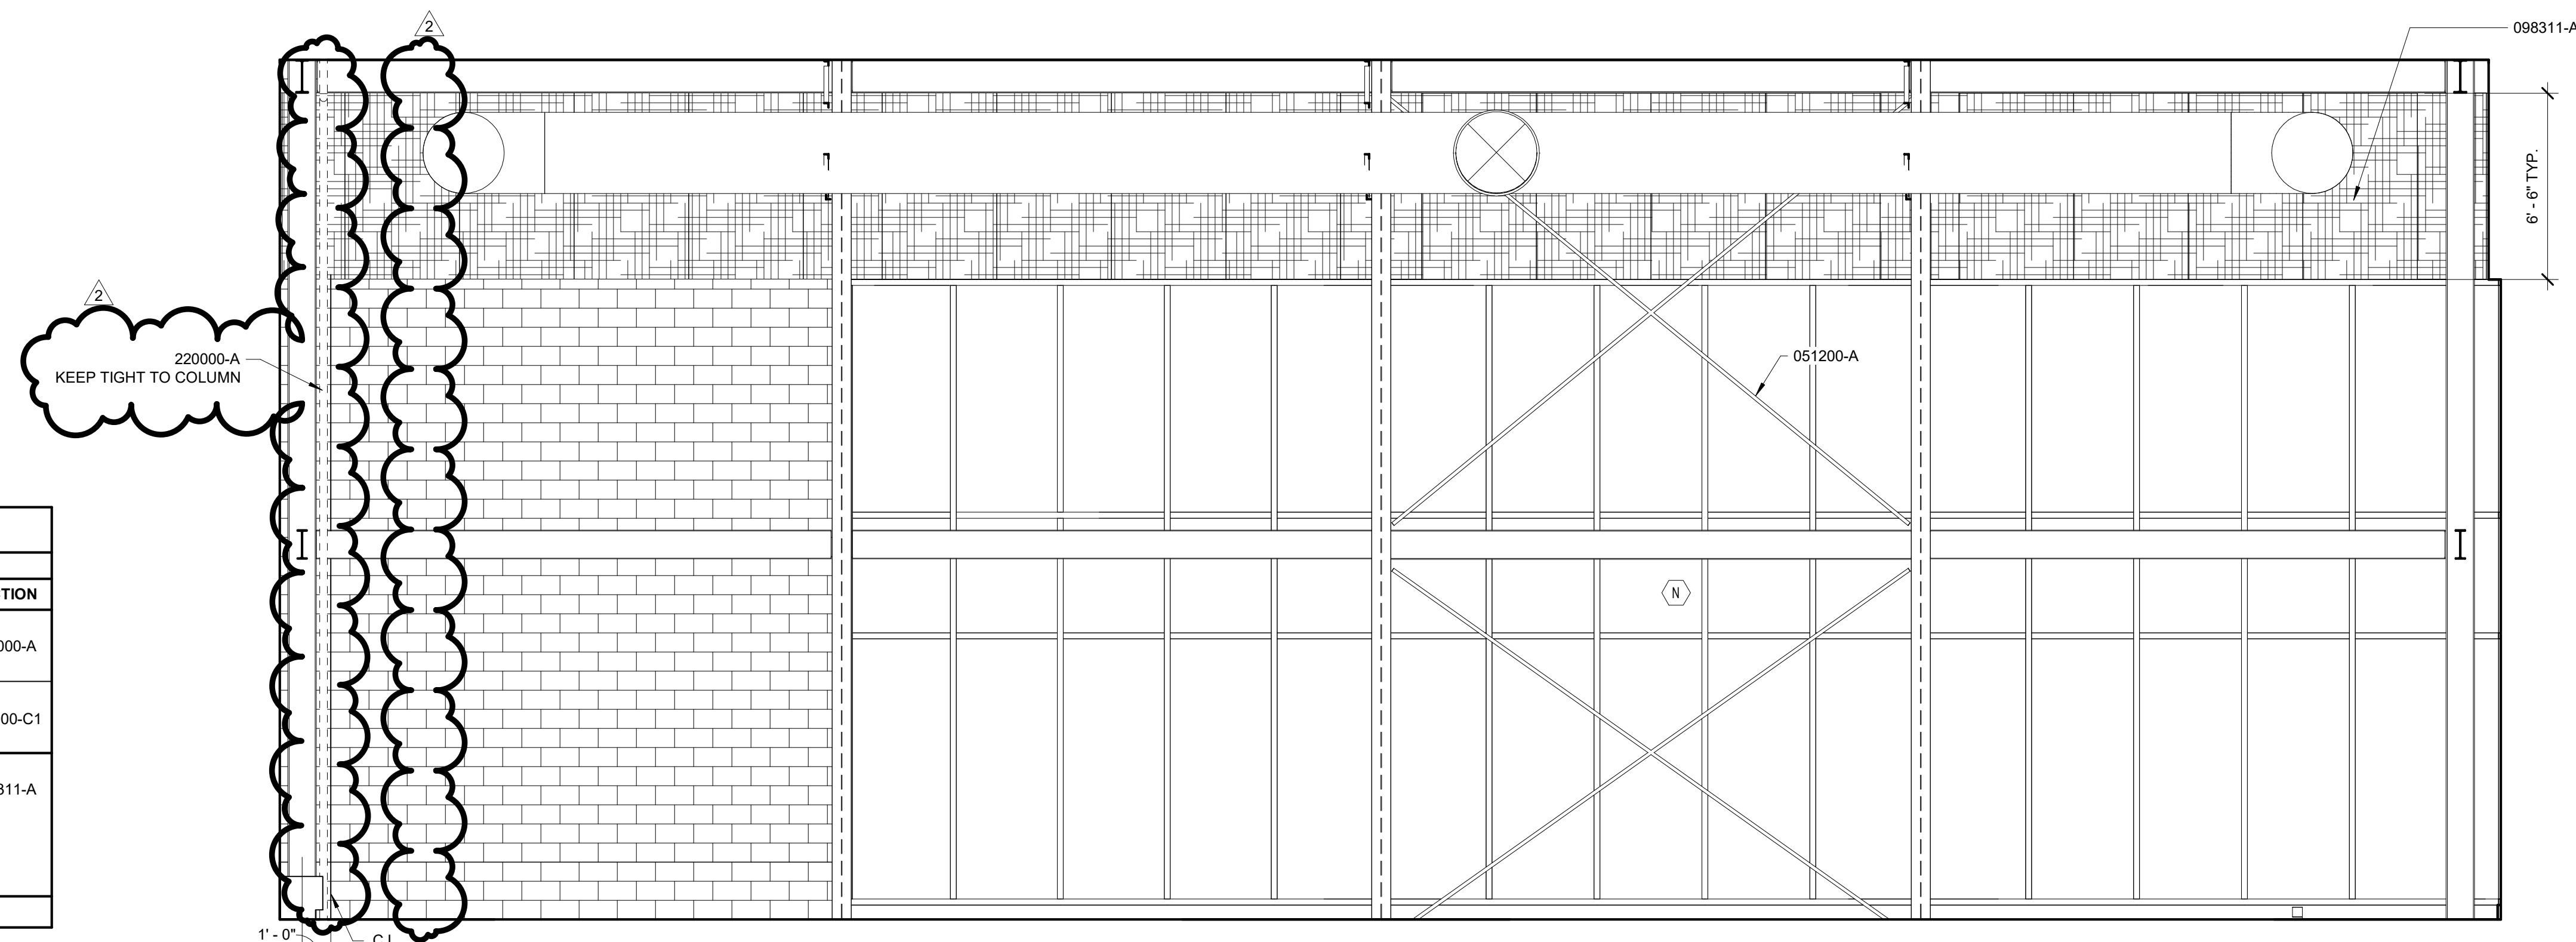

3
A7.5
1/4" = 1'-0"

INTERIOR MATERIALS LEGEND			
FINISH TYPES			
HATCH	MATERIAL DESCRIPTION	MFR/STYLE/COLOR	SECTION
	PORCELAIN TILE	CROSSVILLE RETROACTIVE 2.0, 6X24 COLOR A: ROYAL NAVY PTN COLOR B: SNOW BLIND PTN	093000-A
	GROUND FACE WHERE TAGGED	SEE A9 SERIES	042000-C1
	SHREDDED WOOD ACOUSTIC PANEL	TECTUM FINALE PTD PT-1	098311-A
	SHREDDED WOOD ACOUSTIC PANEL	TECTUM FINALE PTD PT-3	

NOTE: HATCHES ARE SPECIFIC TO A7 SHEETS ONLY.


KEY PLAN:

KEYNOTES LISTED ON THIS SHEET ARE FOR CONVENIENCE ONLY. REFER TO SHEET CS.2 FOR COMPLETE LIST

- 042000-C1 GROUND FACE CMU 1, SIZE AND COLOR AS INDICATED
- 051200-A STRUCTURAL STEEL (REFER TO STRUCTURAL FOR MORE INFORMATION)
- 093000-A WALL TILE. SEE SCHEDULE
- 098311-A SHREDDED WOOD ACOUSTIC PANEL; PAINTED PT-1 UNQ, 2" THICK UNQ
- 105100-F HDPE CUBBIES WITH INTEGRAL BENCH PLUMBING (REFER TO PLUMBING FOR MORE INFORMATION)
- 230000-A MECHANICAL (REFER TO MECHANICAL FOR MORE INFORMATION)

GENERAL NOTES

1. AT ALL INTERIOR ELEVATIONS IN FINISH AREAS WITH EXPOSED-STRUCTURE CEILINGS, PENETRATIONS MADE THROUGH WALLS SHALL BE ALIGNED HORIZONTALLY AND VERTICALLY ON A COMMON CENTERLINE AND IN A NEAT AND ORDERLY MANNER. PENETRATIONS INCLUDE, BUT ARE NOT LIMITED TO: DUCTWORK, CONDUIT, AND PIPING.
2. SEE UNIVERSAL INTERIOR ELEVATIONS AT DEVICES DETAIL FOR ADDITIONAL INFORMATION.
3. MECH, ELEC, PLUMBING EQUIPMENT SHOWN FOR REFERENCE ONLY. SEE M, E, P DRAWINGS FOR FULL DESCRIPTION.

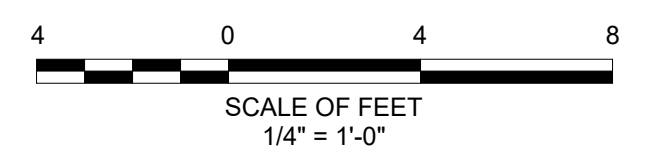

ISSUED FOR BID

Seal

**G|W
W|O**

GWWO INC.
802 WYMAN PARK DRIVE, SUITE 300
BALTIMORE, MARYLAND 21211, 410-352-1909

© 2019 GWWO INC.

I CERTIFY THAT THESE DOCUMENTS WERE PREPARED OR APPROVED BY ME, AND THAT I AM A DULY LICENSED ARCHITECT UNDER THE LAWS OF THE STATE OF MARYLAND.
LICENSE NUMBER: 8400, EXPIRATION DATE: 12/31/2020

Revisions:

No.	Date	Description
2	1/28/2020	ADDENDUM 2

MIDDLE BRANCH FITNESS & WELLNESS CENTER AT CHERRY HILL


BALTIMORE CITY RECREATION & PARKS

Job No. #18010 JPB Drawn
Scale As indicated KMS Checked
Date 12/13/2019 AER Approved
Drawing Title Drawing Number
INTERIOR ELEVATIONS **A7.5r2**
Sheet Of

ABBREVIATIONS

Table of abbreviations and their meanings, organized in two columns. Includes terms like @ - AT, ABOUT; A.B. - ANCHOR BOLTS; ADDL. - ADDITIONAL; etc.

SYMBOL LEGEND

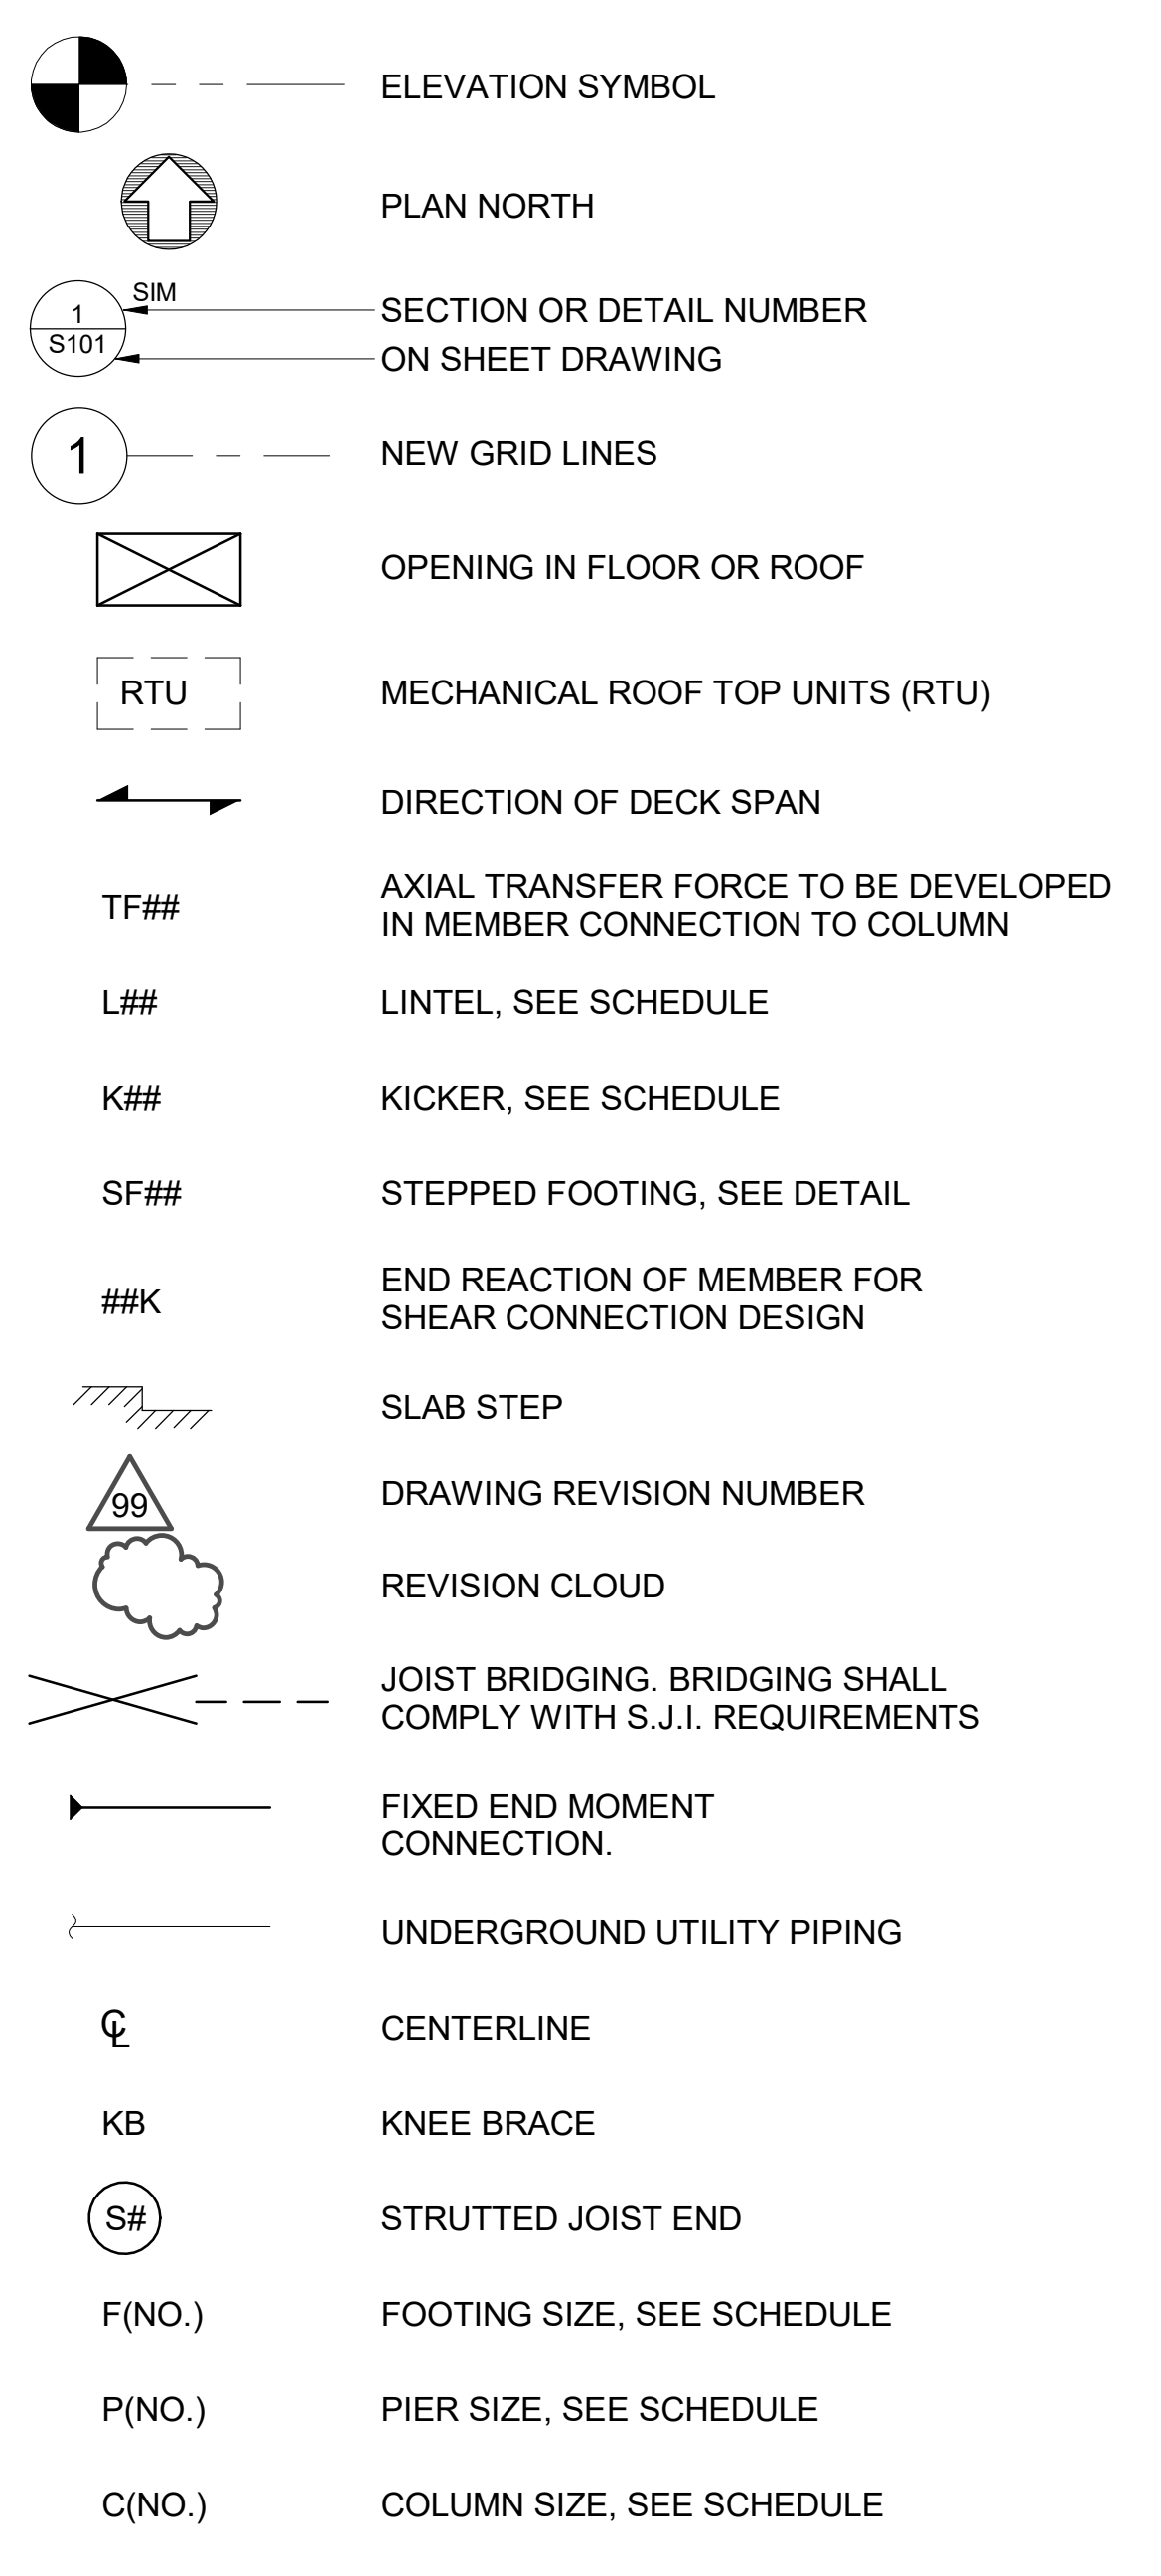

STRUCTURAL DRAWING LIST table with columns for SHEET NO. and SHEET TITLE. Lists sheets S1.0 through S6.1 and their corresponding titles.

COMPONENTS & CLADDING PRESSURES table with columns for ROOF PRESSURES, WALL PRESSURES, and PARAPET PRESSURES. Includes values for negative and positive zones.

NOTES: 1. ALL WIND DESIGN LOADS TO BE DETERMINED AND APPROVED BY A REGISTERED DESIGN PROFESSIONAL... 2. VALUES GIVEN ABOVE ARE NOMINAL WIND PRESSURES(ASD VALUES).

GENERAL NOTES



1. DESIGN LOADS: A. LIVE LOADS: a. ROOF = 30 P.S.F. + APPLICABLE SNOW DRIFT. b. ALL SECOND FLOOR [EXCEPT MECH. ROOM] = 100 P.S.F. c. MECHANICAL ROOMS = 125 P.S.F. d. FIRST FLOOR = 100 P.S.F. e. STAIRS/RUNNING RAMP = 100 P.S.F. B. DEAD LOADS: a. ALL ROOFS EXCEPT HIGH ROOF = 30 P.S.F. b. HIGH ROOF = 35 P.S.F. c. SUPERIMPOSED DEAD LOAD ON DECK = 17 P.S.F. C. WIND LOAD DESIGN PARAMETERS: a. Vw = 44 MPH, Vmax50 = 63 MPH b. WIND EXPOSURE C, c. Iw = 1.00, d. RISK CATEGORY = III, e. Gw = 0.18 f. SEE THIS SHEET FOR COMPONENTS & CLADDING. D. SNOW LOAD DESIGN PARAMETERS: a. Ps = 30 P.S.F., b. Cs = 0.9, c. RISK CATEGORY = III, d. Is = 1.1, e. Ct = 1.00, f. Pt = 18.9 P.S.F., Pf (MIN.) = 30 P.S.F. E. SEISMIC LOAD DESIGN PARAMETERS: a. Ss = 0.128, b. Si = 0.051, c. SITE CLASS = E, d. Sds = 0.214, e. Sd1 = 0.120, f. USE GROUP II, g. RISK CATEGORY = III, h. Ie = 1.25, i. DESIGN CATEGORY B, j. R = 3.0, Qs = 3.0, k. Cs = 3.0, l. DESIGN BASE SHEAR, V = 0.089W m. BASIC STRUCTURAL/SEISMIC SYSTEMS: STRUCTURAL STEEL SYSTEMS NOT SPECIFICALLY DETAILED FOR SEISMIC RESISTANCE; PROCEDURE: EQUIVALENT LATERAL FORCE PROCEDURE. 2. STANDARDS & DESIGN STRESSES: A. CONCRETE SPECIFICATION - ACI 318 & ACI 301. CONCRETE SHALL HAVE MINIMUM 28-DAY COMPRESSIVE STRENGTH OF THE FOLLOWING: a. 4000 P.S.I. NORMAL WEIGHT CONCRETE FOR ALL SLAB ON GRADE & ELEVATED FLOORS. b. 3000 P.S.I. CONCRETE FOR ALL OTHER WORK. REINFORCING BARS - A615, GRADE 60. EPOXY COATED FOR REINFORCEMENT BELOW SLAB LEVEL. C. WIRE MESH - ASTM A185 (FLAT SHEETS FOR ELEVATED SLAB ON DECK) D. STRUCTURAL STEEL - a. AISC MANUAL OF STEEL CONSTRUCTION AND SPECIFICATIONS, 14TH ED. & AWS D1.1. b. STRUCTURAL ASTM A-36 FOR W6, CHANNELS, ANGLES & PLATES. c. ALL OTHER STRUCTURAL STEEL - ASTM A-992, GRADE 50. d. STRUCTURAL STEEL PIPE - ASTM A-53, TYPE S, GRADE B. e. STRUCTURAL STEEL TUBING - ASTM A-500, GRADE B. f. COLD FORMED STEEL STUDS - AISI, SPECIFICATIONS FOR THE DESIGN OF COLD FORMED STEEL STRUCTURAL MEMBERS A.W.S.-D1.3 ASTM A 653, YIELD STRENGTH: a. 50 K.S.I. 16 GA. & HEAVIER b. 37 K.S.I. 18 GA c. 33 K.S.I. 20 GA. d. FINISH: HOT-DIP GALVANIZED (G-60) PER ASTM A924. F. BOLTS - ASTM A325 UNLESS NOTED OTHERWISE. G. ANCHOR BOLTS - ASTM A1554, Grade 36 UNLESS NOTED OTHERWISE. H. WELDING ELECTRODES - E70XX LOW HYDROGEN AS PER WELDING PROCEDURE RECOMMENDATION FOR EXISTING. I. SHEAR STUDS - ASTM A108, & AWS D 1.1. J. STEEL DECK - STEEL DECK INSTITUTE STANDARD SPECIFICATIONS. K. STEEL JOIST - STEEL JOIST INSTITUTE STANDARD SPECIFICATIONS. L. MASONRY - BUILDING CODE REQUIREMENTS FOR MASONRY STRUCTURES ACI 530-88/ASCE 5-88. a. HOLLOW CONCRETE BLOCK - ASTM C90 -GRADE N-1 fm =1500 PSI b. SOLID CONCRETE BLOCK - ASTM C90 -GRADE N-1 fm =1500 PSI c. MORTAR - ASTM C270 - Type S d. GROUT - ASTM C476 - fg = 2500 PSI M. THE INTERNATIONAL BUILDING CODE 2015. 3. DRAWINGS: THE CONTRACTOR SHALL CHECK ALL DRAWINGS AND SHALL PROMPTLY NOTIFY THE ENGINEER OF ANY DISCREPANCIES BEFORE PROCEEDING WITH THE WORK. DO NOT SCALE DRAWINGS. IF THERE ARE ANY QUESTION AS TO WHICH MATERIAL TO USE, THE CONTRACTOR MUST CHOOSE THE MATERIAL OF HIGHER QUALITY. EQUIPMENT LOCATIONS AND WEIGHTS ARE INDICATED FROM INFORMATION PROVIDED BY OTHER CONSULTANT. BEFORE PREPARATION OF SHOP DRAWINGS AND FIELD INSTALLATION, CONTRACTOR TO VERIFY EQUIPMENT LOCATIONS AND WEIGHTS, AND NOTIFY THE ENGINEER OF ANY DISCREPANCY. 4. FOUNDATIONS AND EARTH WORK: A. ELEVATIONS FOR FOUNDATIONS HAVE BEEN ESTABLISHED FROM AVAILABLE INFORMATION. BOTTOM OF ALL EXTERIOR FOOTINGS SHALL BE A MINIMUM OF 2'-6" BELOW FINISHED GRADE UNLESS OTHERWISE NOTED. B. ALL FOOTINGS SHALL BEAR ON IMPROVED SURCHARGED FILL AND ARE DESIGNED FOR A SOIL BEARING PRESSURE OF 2,000 P.S.F. AS RECOMMENDED IN GEOTECHNICAL REPORT [COMM NO. 16046.009] BY RUMMEL, KLEPPER & KAHL, LLP DATED DECEMBER 20, 2018. DURING CONSTRUCTION, THE SOIL BEARING CONDITIONS AND ALLOWABLE SOIL BEARING PRESSURE MUST BE EXAMINED AND APPROVED BY A GEOTECHNICAL ENGINEER. SHOULD IT BE FOUND NECESSARY TO VARY THE ELEVATIONS GIVEN TO SATISFY THE FOREGOING REQUIREMENTS, THE ARCHITECT, STRUCTURAL AND GEOTECHNICAL ENGINEER SHALL BE NOTIFIED BEFORE PROCEEDING WITH THE WORK. E. ALL OVER EXCAVATION AND DISTURBED EARTH UNDER FOOTING SHALL BE REPLACED WITH LEAN CONCRETE (2,000 PSI) APPROVED BY GEOTECHNICAL ENGINEER. F. FILL DIFFERENTIALS ON EITHER SIDE OF FOUNDATION WALLS SHALL NOT EXCEED 12". G. REFER TO GEOTECHNICAL REPORT FOR ADDITIONAL FOUNDATION, FILL, COMPACTION, INSPECTION AND OTHER INFORMATION. H. CONTRACTOR SHALL ADEQUATELY PROTECT ALL WALLS DURING BACKFILL OPERATIONS. 5. CONCRETE: A. ALL REINFORCEMENT BELOW SLAB-ON-GRADE LEVEL SHOULD BE EPOXY COATED. B. ALL EXPOSED CONCRETE WORK SHALL HAVE 5% - 7% AIR ENTRAINMENT. C. DESIGN ALL EXPOSED CORNERS OF FORMED CONCRETE - 3/4". D. SUBMIT SHOP DRAWINGS FOR FABRICATION, BENDING, AND PLACEMENT FOR CONCRETE REINFORCEMENT, SHOWING BAR SCHEDULE STIRRUP SPACING, DIAGRAMS OF BENT BARS, ARRANGEMENT OF CONCRETE REINFORCEMENT INCLUDING SECTIONS AND DETAILS. PROVIDE ACCESSORIES AS REQUIRED. UNLESS NOTED, ALL SPLICES IN REINFORCEMENT TO LAP MINIMUM 44x BAR DIAMETER. F. PROVIDE BOLSTERS OR CHAIRS FOR SLAB REINFORCEMENT SUPPORT. 6. STRUCTURAL STEEL, STEEL DECK & STEEL JOIST: A. CONNECTIONS FOR STRUCTURAL STEEL SHALL BE SHOP WELDED. FIELD CONNECTIONS SHALL BE 3/4" DIAMETER A325 BOLTS UNLESS SHOWN OTHERWISE. B. DESIGN HANGER CONNECTION WITH A SAFETY FACTOR OF 2.0. DETERMINE COMPOSITE STEEL BEAM REACTIONS FROM AISC MANUAL "TOTAL ALLOWABLE UNIFORM LOAD" USING A FACTOR OF 1.70. C. STEEL JOIST MANUFACTURER TO BE A MEMBER OF THE STEEL JOIST INSTITUTE. D. STEEL DECK MANUFACTURER TO BE A MEMBER OF THE STEEL DECK INSTITUTE. E. ALL STRUCTURAL STEEL AND STEEL JOISTS TO RECEIVE ONE COAT OF MANUFACTURER'S STANDARD PAINT. F. ALL DECKS SHALL BE GALVANIZED. G. ALL STEEL EXPOSED TO WEATHER SHALL BE GALVANIZED. H. FOR ALL DECKS, FOLLOW MANUFACTURERS RECOMMENDATION FOR CONSTRUCTION LOADS. I. REFER TO MANUFACTURER'S RECOMMENDATION FOR DECK SHORING REQUIREMENT DURING CONSTRUCTION. J. CONSTRUCTION LOADS IN EXCESS OF 20 P.S.F. SHALL NOT BE PLACED ON FLOOR SLAB UNTIL CONCRETE HAS ATTAINED ITS DESIGN STRENGTH. K. STEEL BEAMS SHALL BE FABRICATED AND ERECTED WITH CAMBER UP. L. STEEL JOIST SHALL BE CUT AS REQUIRED TO FIT AROUND OPENINGS, COLUMNS, BEAM TO COLUMN CONNECTION, PLATE AND OTHER MATERIAL ON TOP OF BEAM. 7. COLD-FORMED METAL FRAMING (CFMF): A. ALLOW ADJUSTMENT FOR CONNECTIONS BETWEEN STUD FRAMING AND OTHER TRADES, SHAPES, ETC. B. EXTERIOR WALL: PROVIDE 6" STEEL STUDS, UNLESS NOTED OTHERWISE. ACTUAL SIZE AND SPACING SHALL BE DETERMINED BY THE COLD FORMED METAL DESIGN ENGINEER. BUT SPACING SHALL NOT EXCEED 16" ON CENTER. ALL CONNECTIONS FOR COLD FORMED METAL FRAMING SHALL BE DESIGNED BY THE COLD FORMED METAL DESIGN ENGINEER. 8. MASONRY: A. ALL SOLID MASONRY PIERS SHALL BE BONDED TO ADJACENT MASONRY. B. FILL CELLS OF CMU SOLID WITH MORTAR IN COURSE DIRECTLY BELOW ALL CHANGES IN THICKNESS OF WALL. C. UNLESS NOTED, ALL VERTICAL REBARS ARE PLACED AT THE CENTER LINE OF THE CMU WALL. PROVIDE REBAR POSITIONER FOR ALL REINFORCEMENT IN CMU WALLS. D. FILL CMU WITH GROUT AT ALL REINFORCEMENT. 9. ANCHORS IN CONCRETE AND MASONRY: A. POST INSTALLED ANCHORS SHALL BE USED ONLY WHERE SPECIFIED ON STRUCTURAL DRAWINGS. B. THE INSTALLATION OF POST INSTALLED ANCHORS FOR MISSING OR MISPLACED CAST-IN-PLACE ANCHORS SHALL BE APPROVED BY THE ENGINEER OF RECORD. C. EXISTING REINFORCING BARS IN THE CONCRETE STRUCTURE SHALL NOT BE CUT UNLESS APPROVED BY THE STRUCTURAL ENGINEER OF RECORD. D. SUBMITTAL OF ALL PROPOSED PRODUCTS, WITH TECHNICAL DATA AND CURRENT ICC-ESR REPORTS IS REQUIRED FOR REVIEW AND APPROVAL BY EOR. ADDITIONAL APPLICATION CALCULATIONS MAY BE REQUIRED BY THE EOR. E. ALL ANCHORS SHALL BE INSTALLED IN STRICT ACCORDANCE WITH MANUFACTURER'S PRINTED INSTALLATION INSTRUCTIONS (MPII) IN CONJUNCTION WITH EDGE DISTANCE, SPACING AND EMBEDMENT DEPTH AS INDICATED ON THE DRAWING. F. THE CONTRACTOR SHALL ARRANGE FOR A MANUFACTURER'S FIELD REPRESENTATIVE TO PROVIDE INSTALLATION TRAINING FOR ALL PRODUCTS TO BE USED. PRIOR TO COMMENCEMENT OF WORK ONLY TRAINED INSTALLERS SHALL PERFORM POST INSTALLED ANCHOR INSTALLATION. A RECORD OF TRAINING SHALL BE KEPT ON SITE AND MADE AVAILABLE TO THE EOR/EO AS REQUESTED. G. THE FOLLOWING MANUFACTURER'S HAVE BEEN PRE-APPROVED FOR SUBMITTAL. a. DEVALT/POWERS FASTENERS b. HILTI INC c. SIMPSON H. CONCRETE ANCHORS: a. MECHANICAL ANCHORS SHALL HAVE BEEN TESTED AND QUALIFIED FOR USE IN ACCORDANCE WITH ACI 308.2 AND ICC-ES AC109 FOR CRACKED, UNCRACKED AND SEISMIC CONCRETE RECOGNITION. b. ADHESIVE ANCHORS SHALL HAVE BEEN TESTED AND QUALIFIED FOR USE IN ACCORDANCE WITH ACI 308.4 AND ICC308 FOR CRACKED, UNCRACKED AND SEISMIC CONCRETE RECOGNITION. c. PRE-APPROVED ADHESIVE ANCHORS INCLUDE: CAST-IN-PLACE INSERTS SHALL HAVE BEEN TESTED AND QUALIFIED FOR USE IN ACCORDANCE WITH ICC-ES AC446 FOR CRACKED, UNCRACKED AND SEISMIC CONCRETE RECOGNITION. I. MASONRY ANCHORS: a. MECHANICAL ANCHORS SHALL HAVE BEEN TESTED AND QUALIFIED FOR USE IN ACCORDANCE WITH ICC-ES AC01 OR AC106. b. ADHESIVE ANCHORS SHALL HAVE BEEN TESTED AND QUALIFIED FOR USE IN ACCORDANCE WITH ICC-ES AC58. J. POWER ACTUATED FASTENERS: a. POWER ACTUATED FASTENERS SHALL HAVE BEEN TESTED AND QUALIFIED FOR USE IN ACCORDANCE WITH ICC-ES AC70.

KEY PLAN:

KEYNOTES LISTED ON THIS SHEET ARE FOR CONVENIENCE ONLY. REFER TO SHEET CS.3 FOR COMPLETE LIST

10. SHOP DRAWINGS: SHOP DRAWINGS OF STRUCTURAL STEEL, STEEL JOISTS, STEEL DECK, REINFORCING BARS AND COLD FORMED METAL FRAMING SHALL BE SUBMITTED TO THE ENGINEER FOR REVIEW, AND SUCH REVIEW SHALL BE SECURED BEFORE FABRICATION IS BEGUN. ALL SHOP DRAWINGS SHALL BE CHECKED AND STAMPED BY THE GENERAL CONTRACTOR BEFORE FORWARDING TO THE ENGINEER. ALL REVISIONS TO SHOP DRAWINGS SHOULD BE CLEARLY IDENTIFIED BY CLOUDS AND REVISION MARKS. 11. INSPECTION AND NOTIFICATION: A. ALL STRUCTURAL WORK SHOULD BE INSPECTED AND TESTED BY AN INDEPENDENT AGENCY IN ACCORDANCE WITH THE INTERNATIONAL BUILDING CODE, CHAPTER 17. B. CONCRETE SHALL BE SAMPLED AND TESTED ACCORDING TO ACI 301, AND THE RESULTS OF THE TESTS SHALL BE FORWARDED TO THE ENGINEER FOR REVIEW. C. ALL REINFORCEMENT IN-PLACE, STRUCTURAL STEEL, STEEL JOIST, STEEL DECK, AND COLD-FORMED METAL FRAMING SHALL BE INSPECTED BY AN INDEPENDENT INSPECTION AGENCY APPROVED BY THE ENGINEER, AND THE RESULTS SHALL BE FORWARDED TO THE ENGINEER PRIOR TO COVERING WORK. INSPECTOR TO REVIEW STRUCTURAL WORKS IN PLACE FOR COMPLIANCE WITH CONTRACT DOCUMENTS, SPECIFICATION AND SHOP DRAWINGS. IN CASE OF CONFLICTING INFORMATION, CONSULT STRUCTURAL ENGINEER FOR CLARIFICATION. D. NOTIFY ENGINEER FOR REVIEW OF REINFORCEMENT IN-PLACE PRIOR TO POURING ANY CONCRETE. E. PERFORM FIELD DENSITY TESTS FOR COMPACTED FILL UNDER SLABS ON GRADE IN ACCORDANCE WITH GEOTECHNICAL REPORT BY AN APPROVED GEOTECHNICAL ENGINEER AND FORWARD THE RESULTS TO THE ENGINEER FOR REVIEW PRIOR TO PLACING CONCRETE. F. FAISANT ASSOCIATES, INC WILL NOT PERFORM THE REQUIRED THIRD PARTY INSPECTION AS PART OF HISHER DESIGN SERVICE. THE ENGINEER MAY VISIT THE SITE TO ASCERTAIN GENERAL CONFORMANCE TO THE CONTRACT DOCUMENTS. HOWEVER, SUCH INSPECTION SHALL NOT BE RELIED UPON BY OTHERS AS ACCEPTANCE OF THE WORK, NOR SHALL IT BE CONSTRUED TO RELIEVE THE CONTRACTOR IN ANY WAY FROM HIS OBLIGATIONS AND RESPONSIBILITIES UNDER THE CONSTRUCTION CONTRACT, UNLESS THE ENGINEER SPECIFICALLY SO STATES IN WRITING. G. FAISANT ASSOCIATES, INC. WILL NOT BE RESPONSIBLE FOR JOB SITE SAFETY AND CONSTRUCTION MEANS AND METHODS.

ISSUED FOR BID

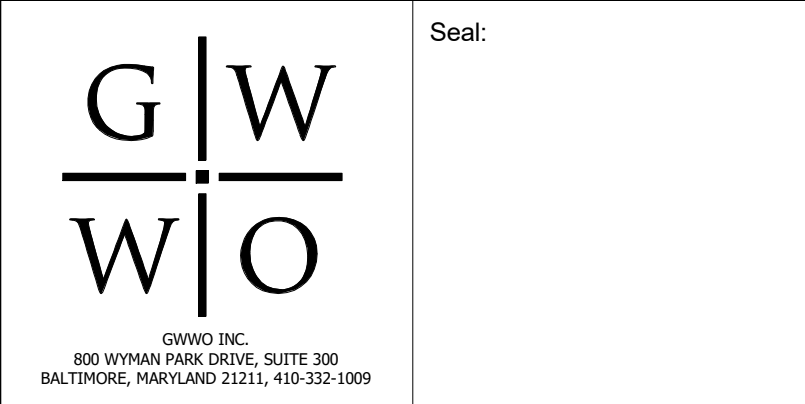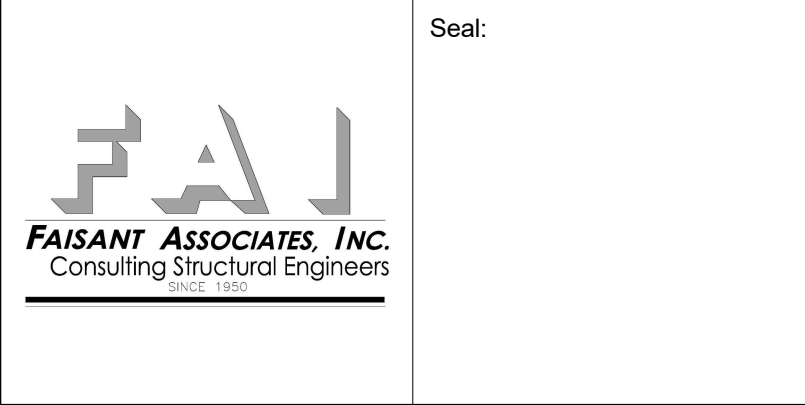

GW/O INC. 800 WYMAN PARK DRIVE, SUITE 300 BALTIMORE, MARYLAND 21211, 410-352-1909



© 2019 GW/O INC.

I CERTIFY THAT THESE DOCUMENTS WERE PREPARED OR APPROVED BY ME, AND THAT I AM A FULLY LICENSED ENGINEER UNDER THE LAWS OF THE STATE OF MARYLAND. LICENSE NUMBER: 15238, EXPIRATION DATE: 01/15/2021

Revisions table with columns: No., Date, Description. Row 2: 01/28/2020, ADDENDUM #2

MIDDLE BRANCH FITNESS & WELLNESS CENTER AT CHERRY HILL

Table with project information: BALTIMORE CITY RECREATION & PARKS, Job No. 18010, YP/AM, Scale As indicated, DR, Date 11/29/19, ACP, Drawing Title GENERAL NOTES, ABBREVIATIONS, AND SYMBOLS, Drawing Number S1.0r2, Sheet

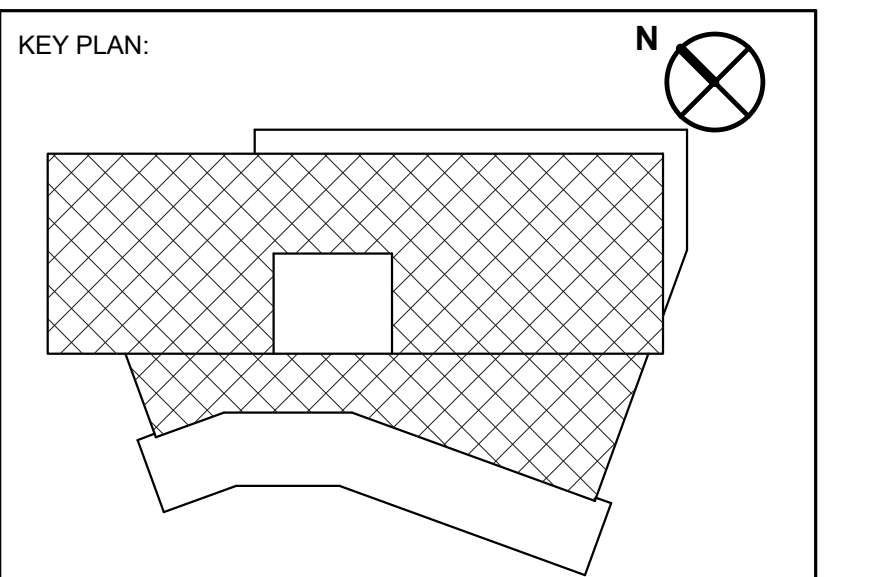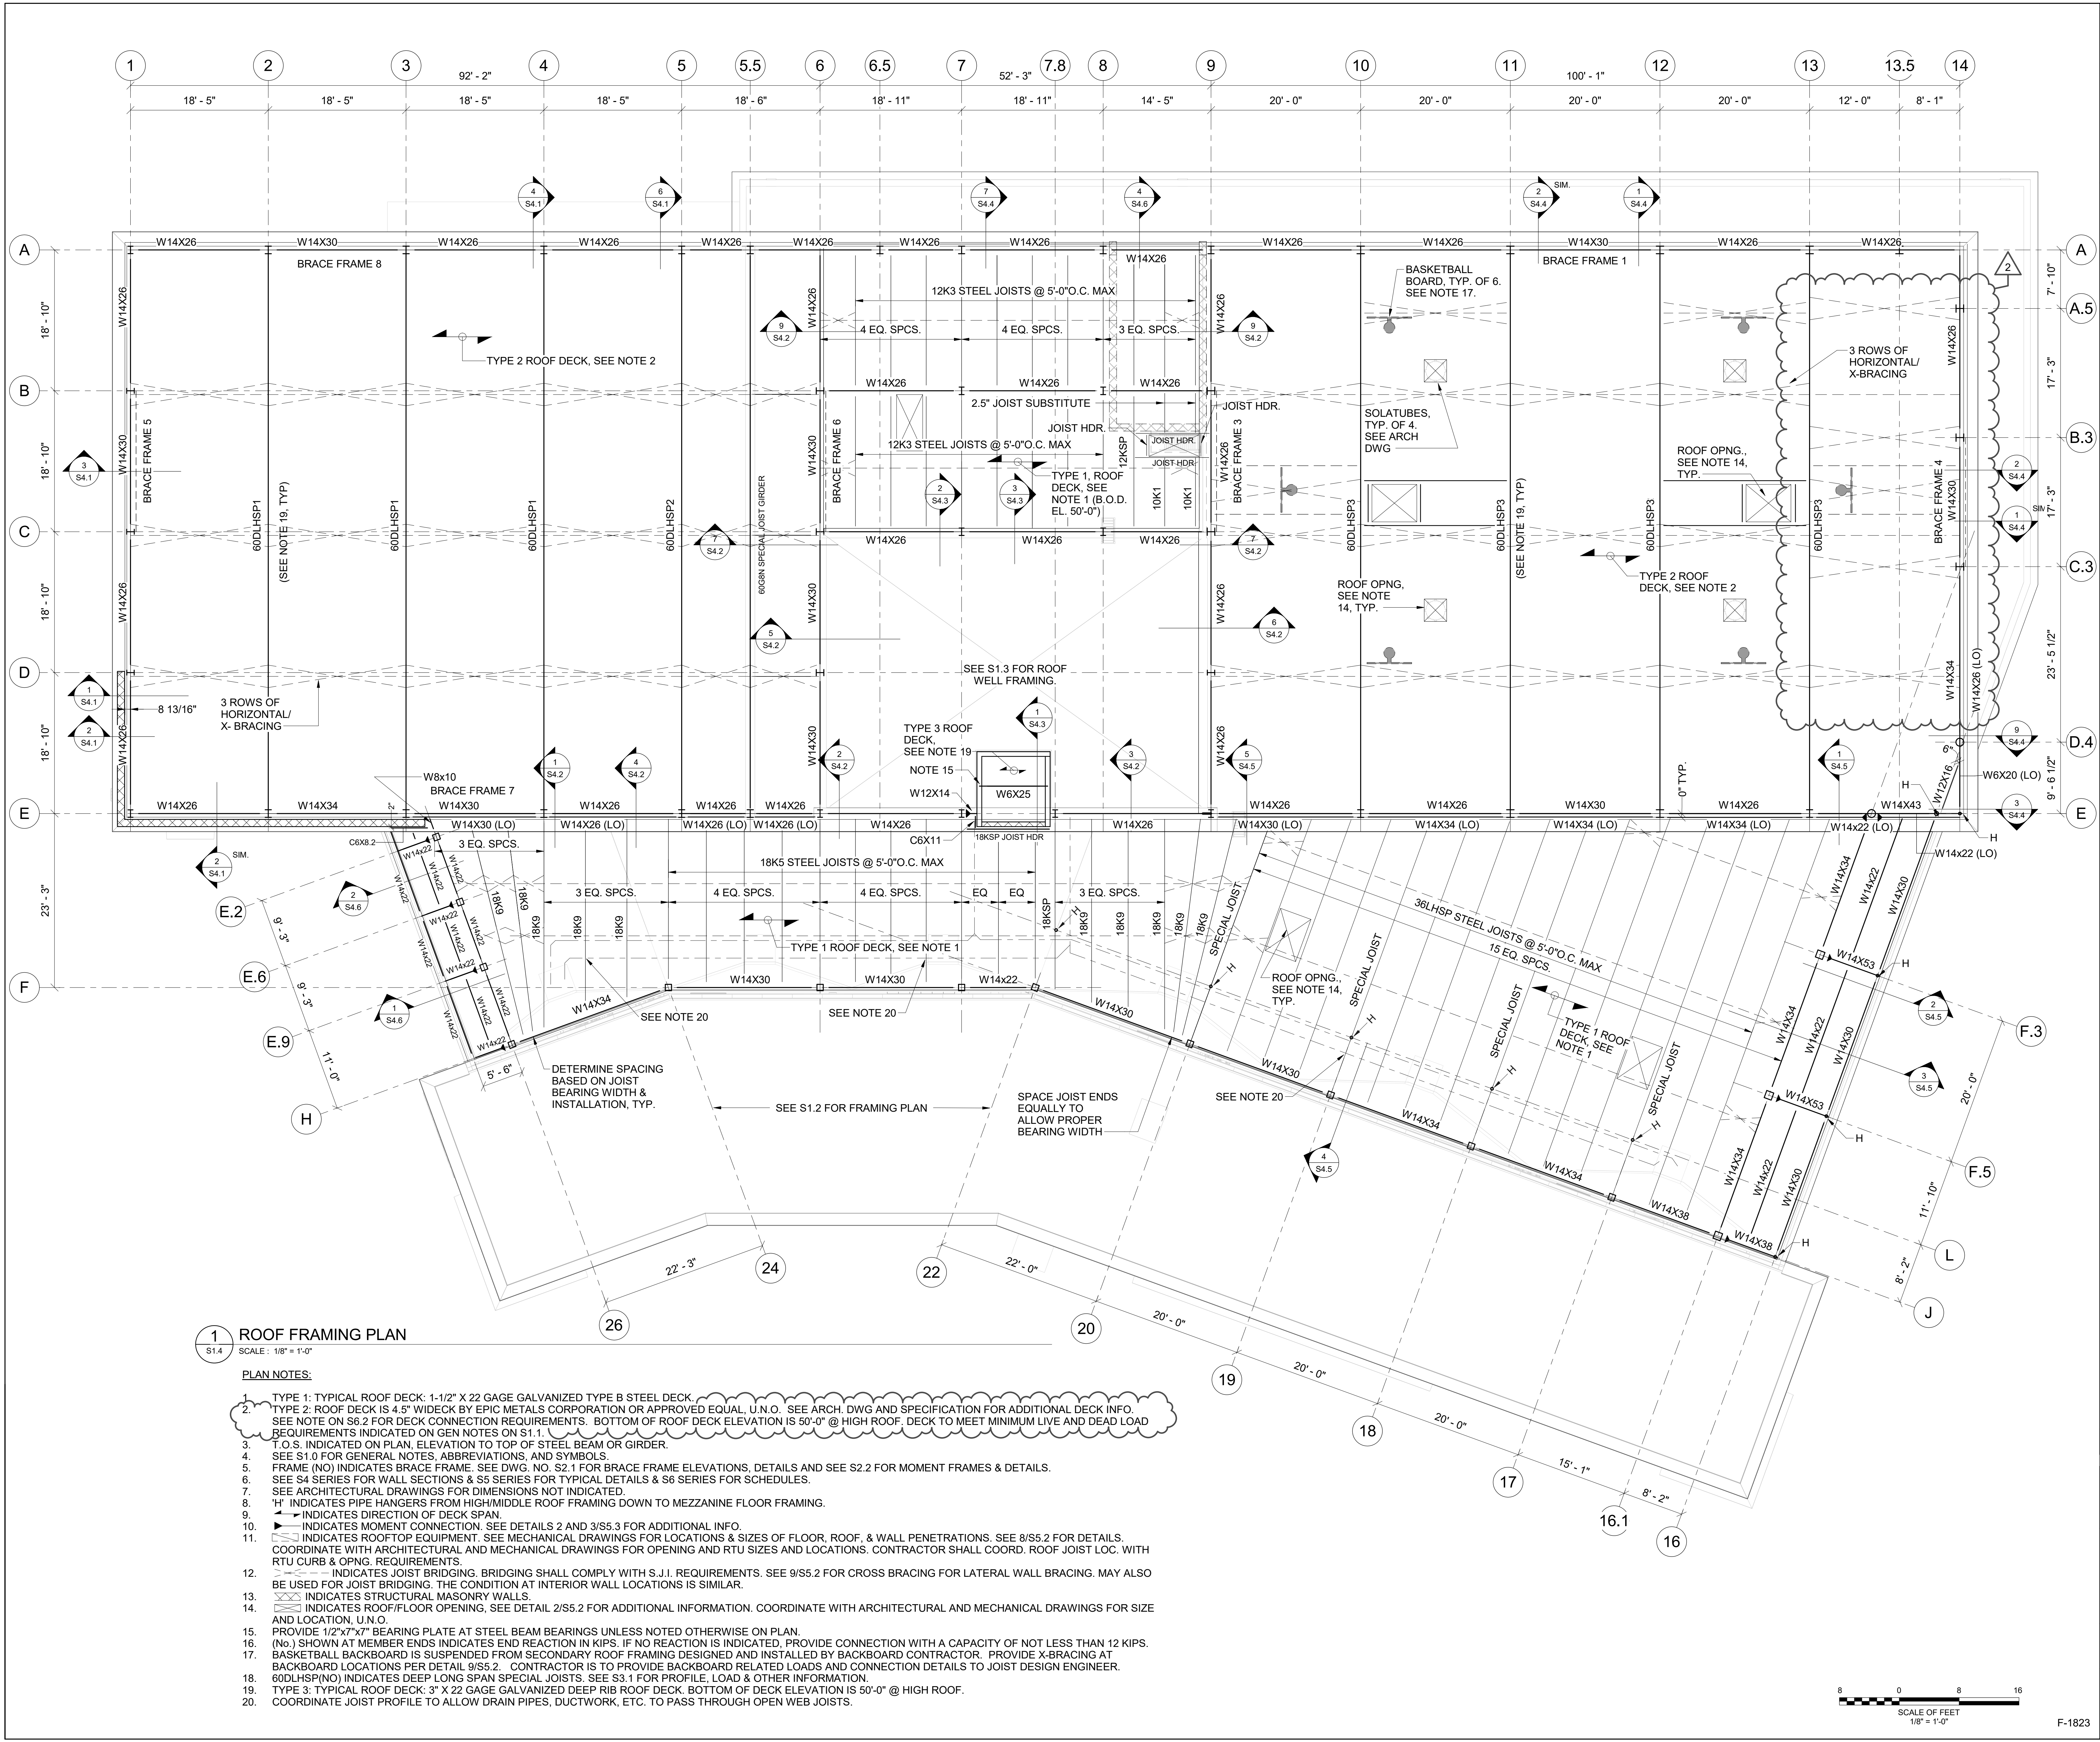


KEYNOTES LISTED ON THIS SHEET ARE FOR CONVENIENCE ONLY. REFER TO SHEET CS.2 FOR COMPLETE LIST

1 ROOF FRAMING PLAN
SCALE: 1/8" = 1'-0"

PLAN NOTES:

1. TYPE 1: TYPICAL ROOF DECK: 1-1/2" X 22 GAGE GALVANIZED TYPE B STEEL DECK.
2. TYPE 2: ROOF DECK IS 4.5" WIDEK BY EPIC METALS CORPORATION OR APPROVED EQUAL, U.N.O. SEE ARCH. DWG AND SPECIFICATION FOR ADDITIONAL DECK INFO. SEE NOTE ON S6.2 FOR DECK CONNECTION REQUIREMENTS. BOTTOM OF ROOF DECK ELEVATION IS 50'-0" @ HIGH ROOF. DECK TO MEET MINIMUM LIVE AND DEAD LOAD REQUIREMENTS INDICATED ON GEN NOTES ON S1.1.
3. T.O.S. INDICATED ON PLAN, ELEVATION TO TOP OF STEEL BEAM OR GIRDER.
4. SEE S1.0 FOR GENERAL NOTES, ABBREVIATIONS, AND SYMBOLS.
5. FRAME (NO) INDICATES BRACE FRAME. SEE DWG. NO. S2.1 FOR BRACE FRAME ELEVATIONS, DETAILS AND SEE S2.2 FOR MOMENT FRAMES & DETAILS.
6. SEE S4 SERIES FOR WALL SECTIONS & S5 SERIES FOR TYPICAL DETAILS & S6 SERIES FOR SCHEDULES.
7. SEE ARCHITECTURAL DRAWINGS FOR DIMENSIONS NOT INDICATED.
8. 'H' INDICATES PIPE HANGERS FROM HIGH/MIDDLE ROOF FRAMING DOWN TO MEZZANINE FLOOR FRAMING.
9. ——— INDICATES DIRECTION OF DECK SPAN.
10. ——— INDICATES MOMENT CONNECTION. SEE DETAILS 2 AND 3/S5.3 FOR ADDITIONAL INFO.
11. ——— INDICATES ROOFTOP EQUIPMENT. SEE MECHANICAL DRAWINGS FOR LOCATIONS & SIZES OF FLOOR, ROOF, & WALL PENETRATIONS. SEE 8/S5.2 FOR DETAILS. COORDINATE WITH ARCHITECTURAL AND MECHANICAL DRAWINGS FOR OPENING AND RTU SIZES AND LOCATIONS. CONTRACTOR SHALL COORD. ROOF JOIST LOC. WITH RTU CURB & OPNG. REQUIREMENTS.
12. ——— INDICATES JOIST BRIDGING. BRIDGING SHALL COMPLY WITH S.J.I. REQUIREMENTS. SEE 9/S5.2 FOR CROSS BRACING FOR LATERAL WALL BRACING. MAY ALSO BE USED FOR JOIST BRIDGING. THE CONDITION AT INTERIOR WALL LOCATIONS IS SIMILAR.
13. ——— INDICATES STRUCTURAL MASONRY WALLS.
14. ——— INDICATES ROOF/FLOOR OPENING. SEE DETAIL 2/S5.2 FOR ADDITIONAL INFORMATION. COORDINATE WITH ARCHITECTURAL AND MECHANICAL DRAWINGS FOR SIZE AND LOCATION, U.N.O.
15. PROVIDE 1/2"x7"x7" BEARING PLATE AT STEEL BEAM BEARINGS UNLESS NOTED OTHERWISE ON PLAN.
16. (No.) SHOWN AT MEMBER ENDS INDICATES END REACTION IN KIPS. IF NO REACTION IS INDICATED, PROVIDE CONNECTION WITH A CAPACITY OF NOT LESS THAN 12 KIPS. BASKETBALL BACKBOARD IS SUSPENDED FROM SECONDARY ROOF FRAMING DESIGNED AND INSTALLED BY BACKBOARD CONTRACTOR. PROVIDE X-BRACING AT BACKBOARD LOCATIONS PER DETAIL 9/S5.2. CONTRACTOR IS TO PROVIDE BACKBOARD RELATED LOADS AND CONNECTION DETAILS TO JOIST DESIGN ENGINEER.
18. 60DLHSP(NO) INDICATES DEEP LONG SPAN SPECIAL JOISTS. SEE S3.1 FOR PROFILE, LOAD & OTHER INFORMATION.
19. TYPE 3: TYPICAL ROOF DECK: 3" X 22 GAGE GALVANIZED DEEP RIB ROOF DECK. BOTTOM OF DECK ELEVATION IS 50'-0" @ HIGH ROOF.
20. COORDINATE JOIST PROFILE TO ALLOW DRAIN PIPES, DUCTWORK, ETC. TO PASS THROUGH OPEN WEB JOISTS.

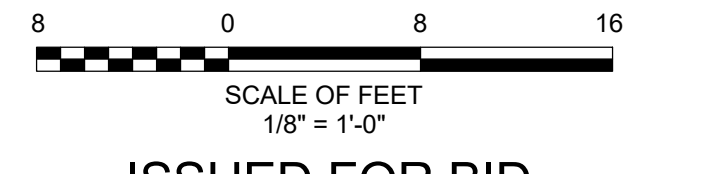

ISSUED FOR BID

FAI
FAISANT ASSOCIATES, INC.
Consulting Structural Engineers

G|W
W|O

GW INC.
800 WYMAN PARK DRIVE, SUITE 300
BALTIMORE, MARYLAND 21211, 410-352-1909

© 2019 GWWO INC.

I CERTIFY THAT THESE DOCUMENTS WERE PREPARED OR APPROVED BY ME, AND THAT I AM A DULY LICENSED ENGINEER UNDER THE LAWS OF THE STATE OF MARYLAND. LICENSE NUMBER: 15238, EXPIRATION DATE: 01/15/2021

Revisions:	No.	Date	Description
	2	01/28/2020	ADDENDUM #2


MIDDLE BRANCH FITNESS & WELLNESS CENTER AT CHERRY HILL
BALTIMORE CITY RECREATION & PARKS

Job No.	18010	YP/AM	Drawn
Scale	1/8" = 1'-0"	DR	Checked
Date	11/29/19	ACP	Approved
Drawing Title	Roof Framing Plan		

Sheet **S1.4r2**

KEY PLAN:


KEYNOTES LISTED ON THIS SHEET ARE FOR CONVENIENCE ONLY. REFER TO SHEET CS.2 FOR COMPLETE LIST

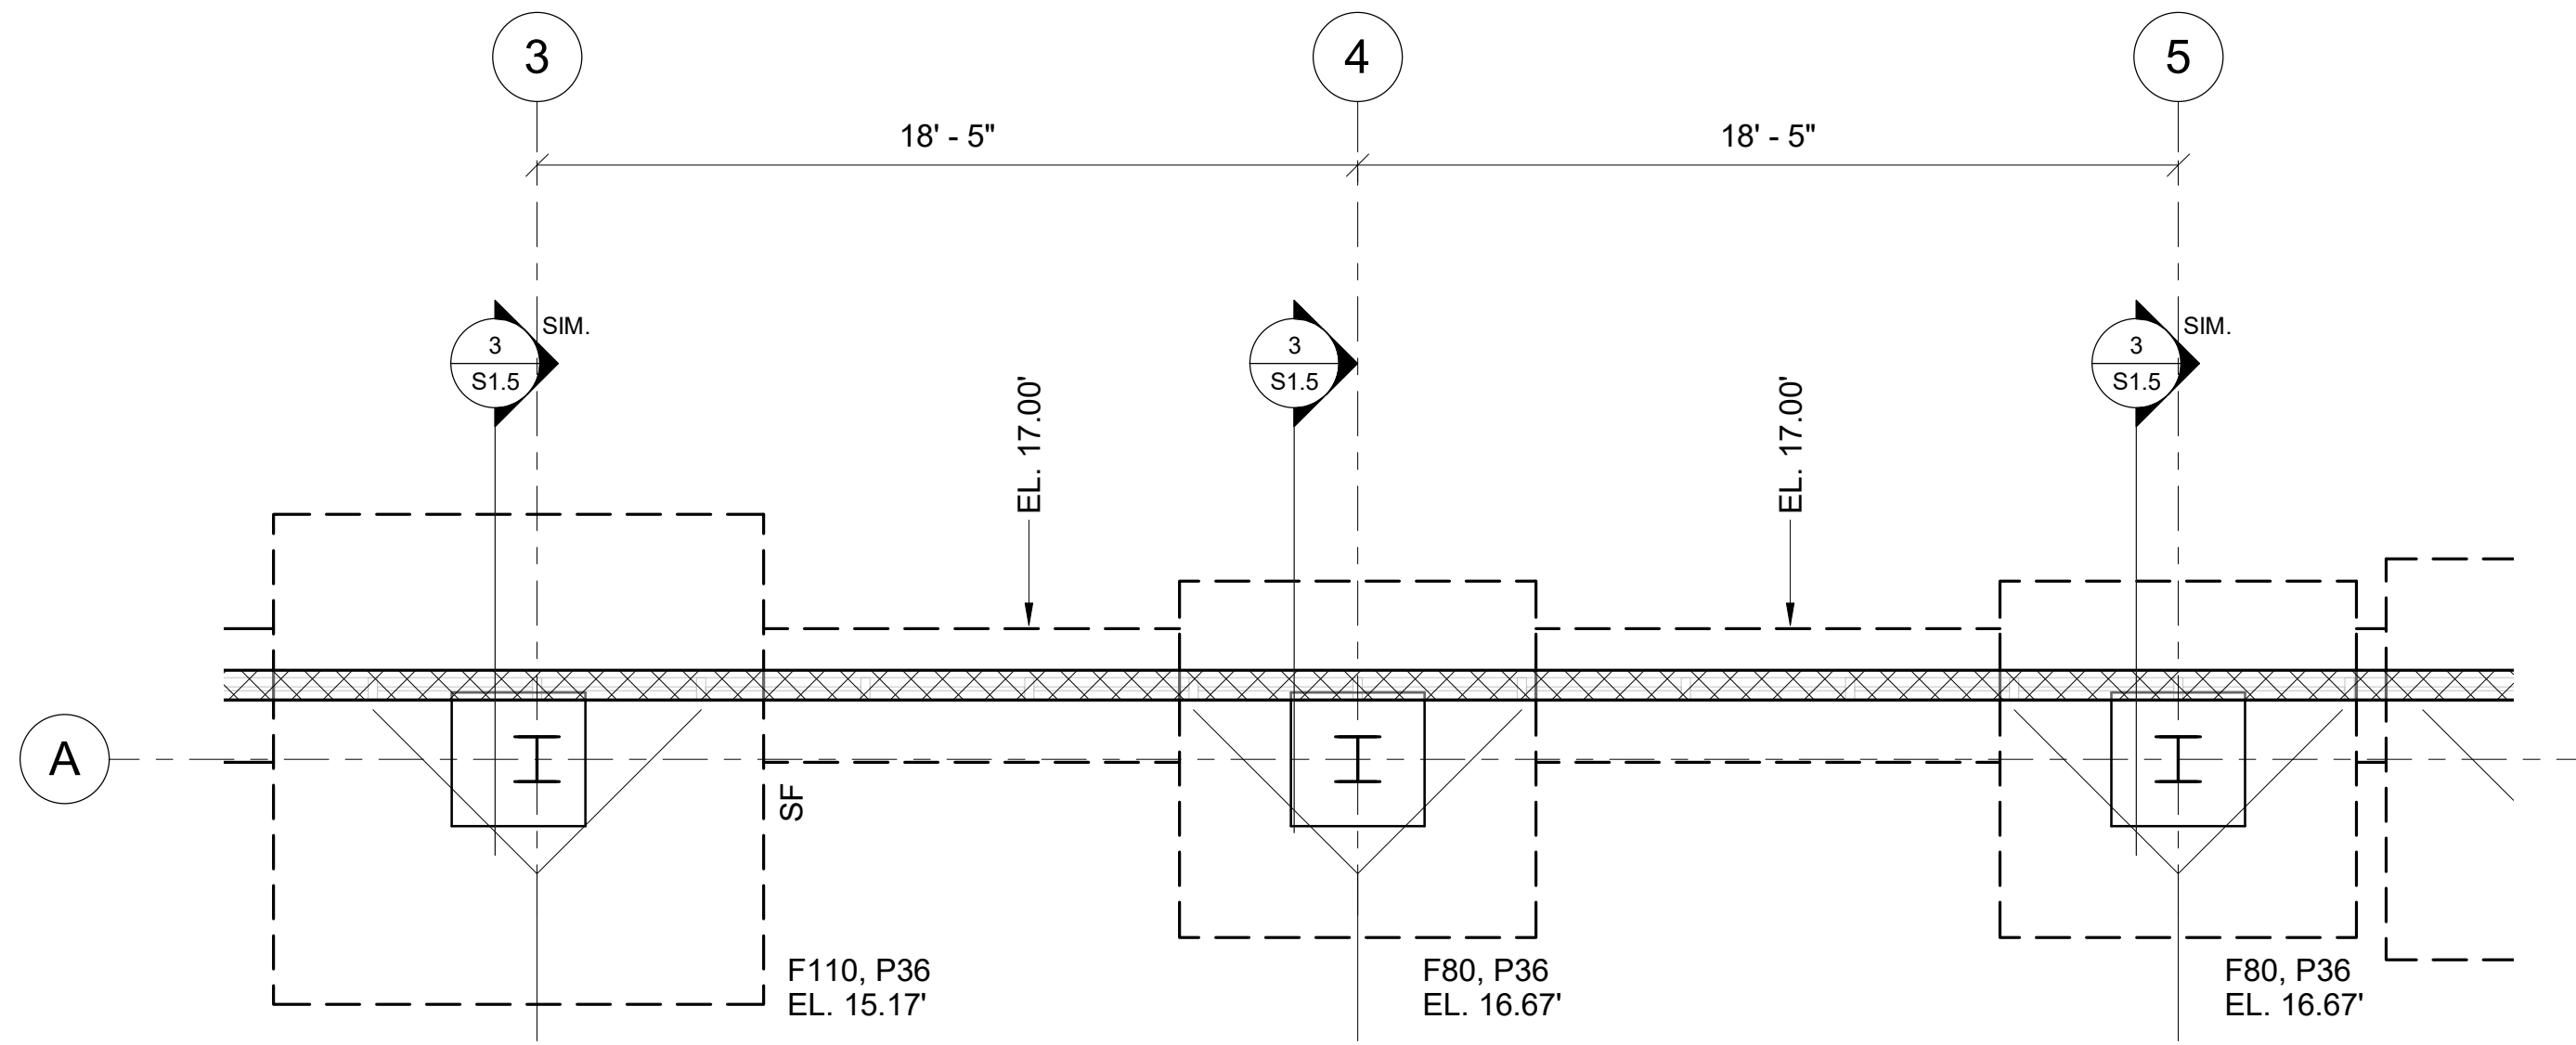

1 PARTIAL FLOOR PLAN (ADD ALT. #2)
S1.5 SCALE: 1/4" = 1'-0"

PLAN NOTES:


- SEE S6.1 FOR COLUMN, PIER & FOOTING SCHEDULES.
- EL. (NO.) - INDICATES BOTTOM OF CONCRETE FOOTING ELEVATION.
- F(NO.) - INDICATES FOOTING MARK. SEE S6.1 FOR FOOTING SCHEDULE.
- SF INDICATES STEPPED FOOTING. SEE 3/S5.1. UNLESS NOTED, PROVIDE STEPPED FOOTINGS AS REQUIRED FROM LOW TO HIGH FOOTINGS PER TYPICAL DETAIL.

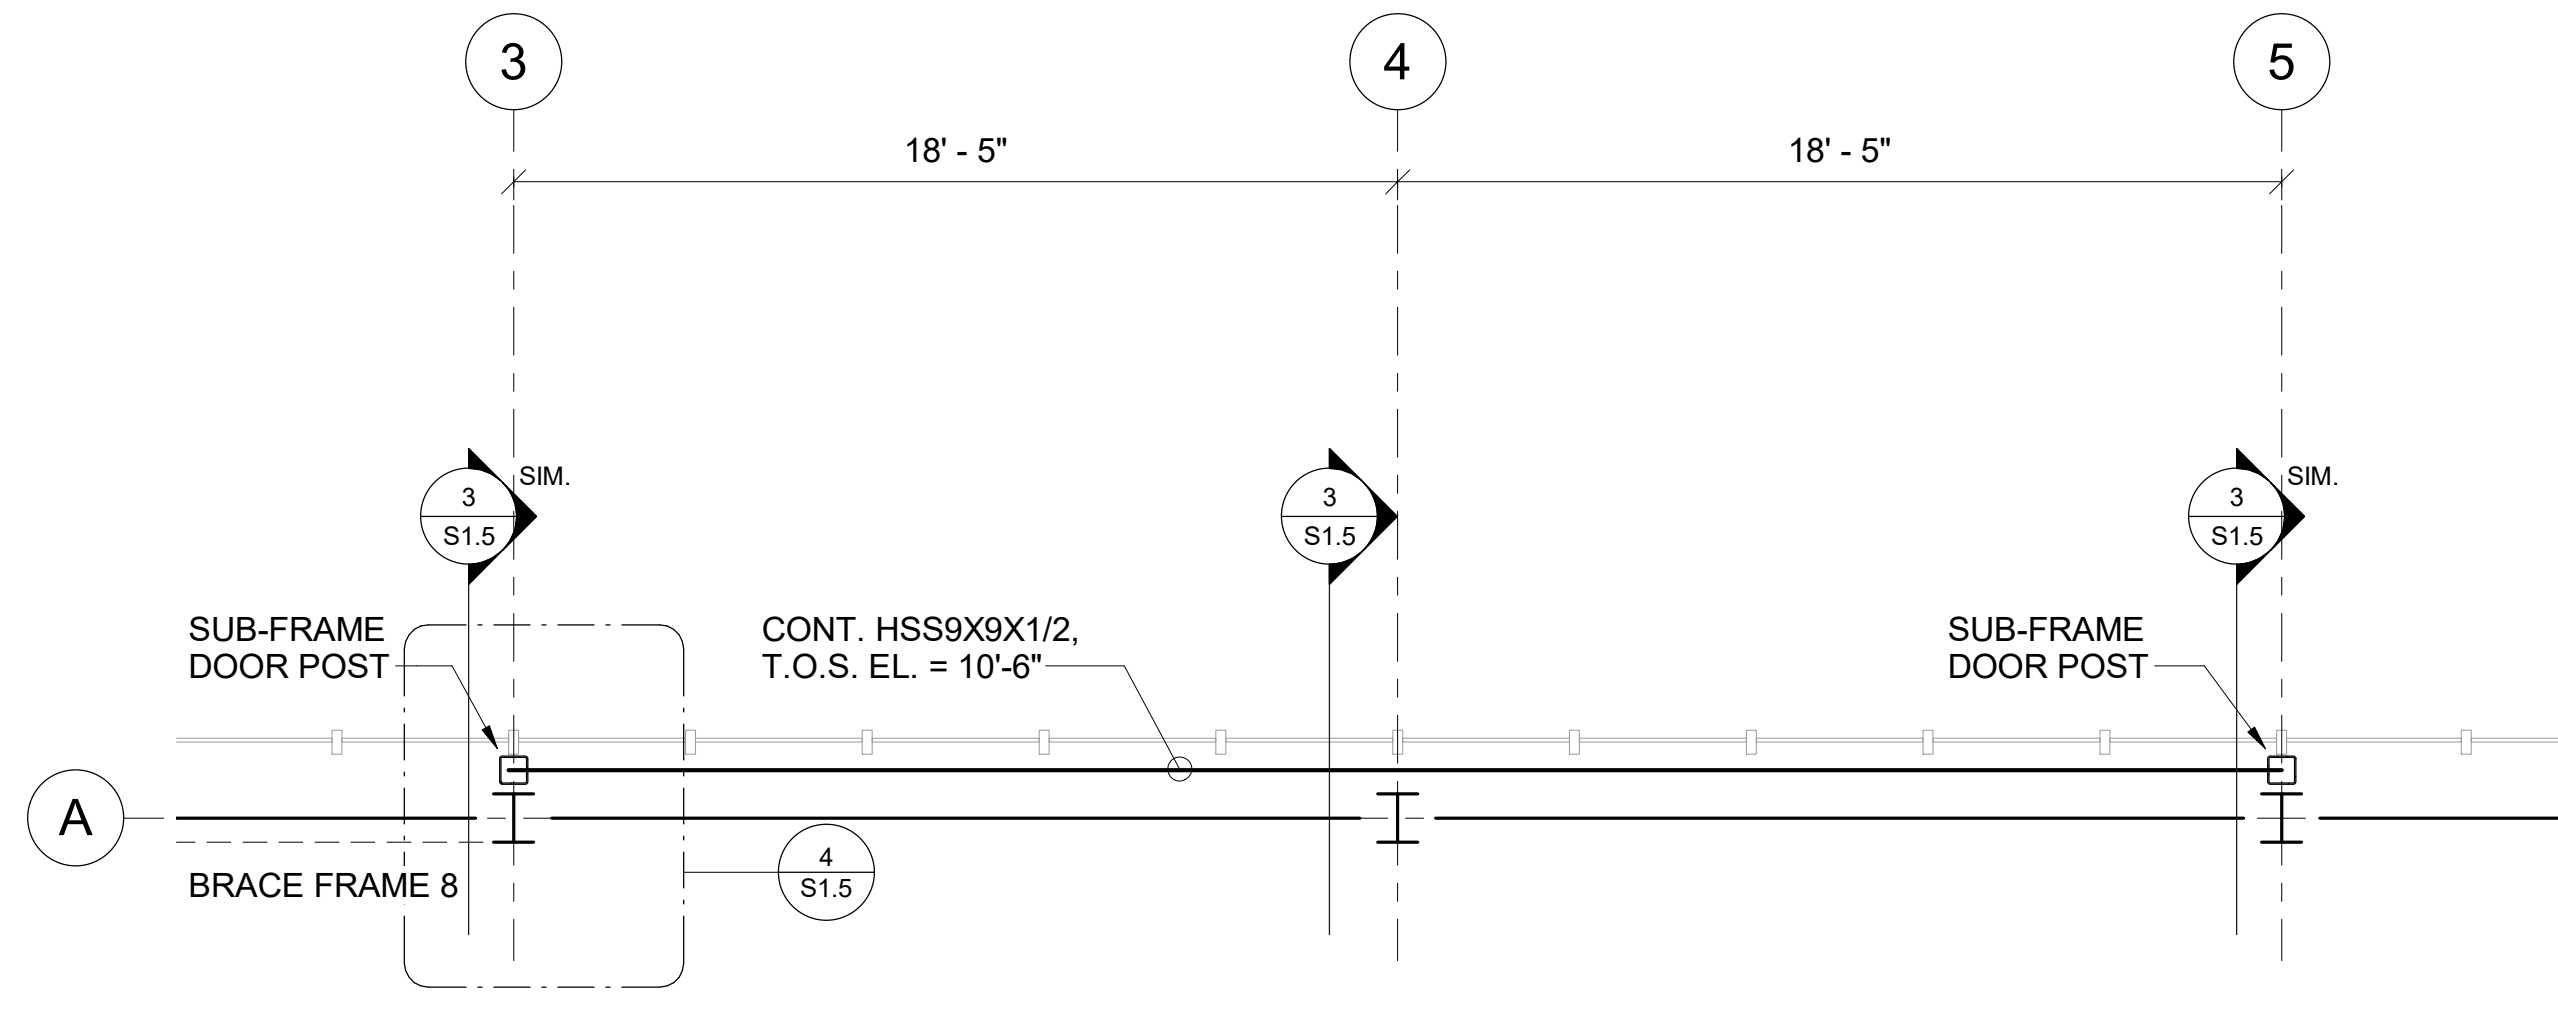


2 PARTIAL FRAMING PLAN @ DOOR HEADER (ADD ALT. #2)
S1.5 SCALE: 1/4" = 1'-0"

PLAN NOTES:


- T.O.S. INDICATED ON PLAN, ELEVATION TO TOP OF STEEL BEAM OR GIRDER.
- SEE S1.0 FOR GENERAL NOTES, ABBREVIATIONS, AND SYMBOLS.
- FRAME (NO) INDICATES BRACE FRAME. SEE DWG. NO. S2.1 FOR BRACE FRAME ELEVATIONS AND DETAILS.
- SEE S4 SERIES FOR WALL SECTIONS & S5 SERIES FOR TYPICAL DETAILS & S6 SERIES FOR SCHEDULES.
- SEE ARCHITECTURAL DRAWINGS FOR DIMENSIONS NOT INDICATED.

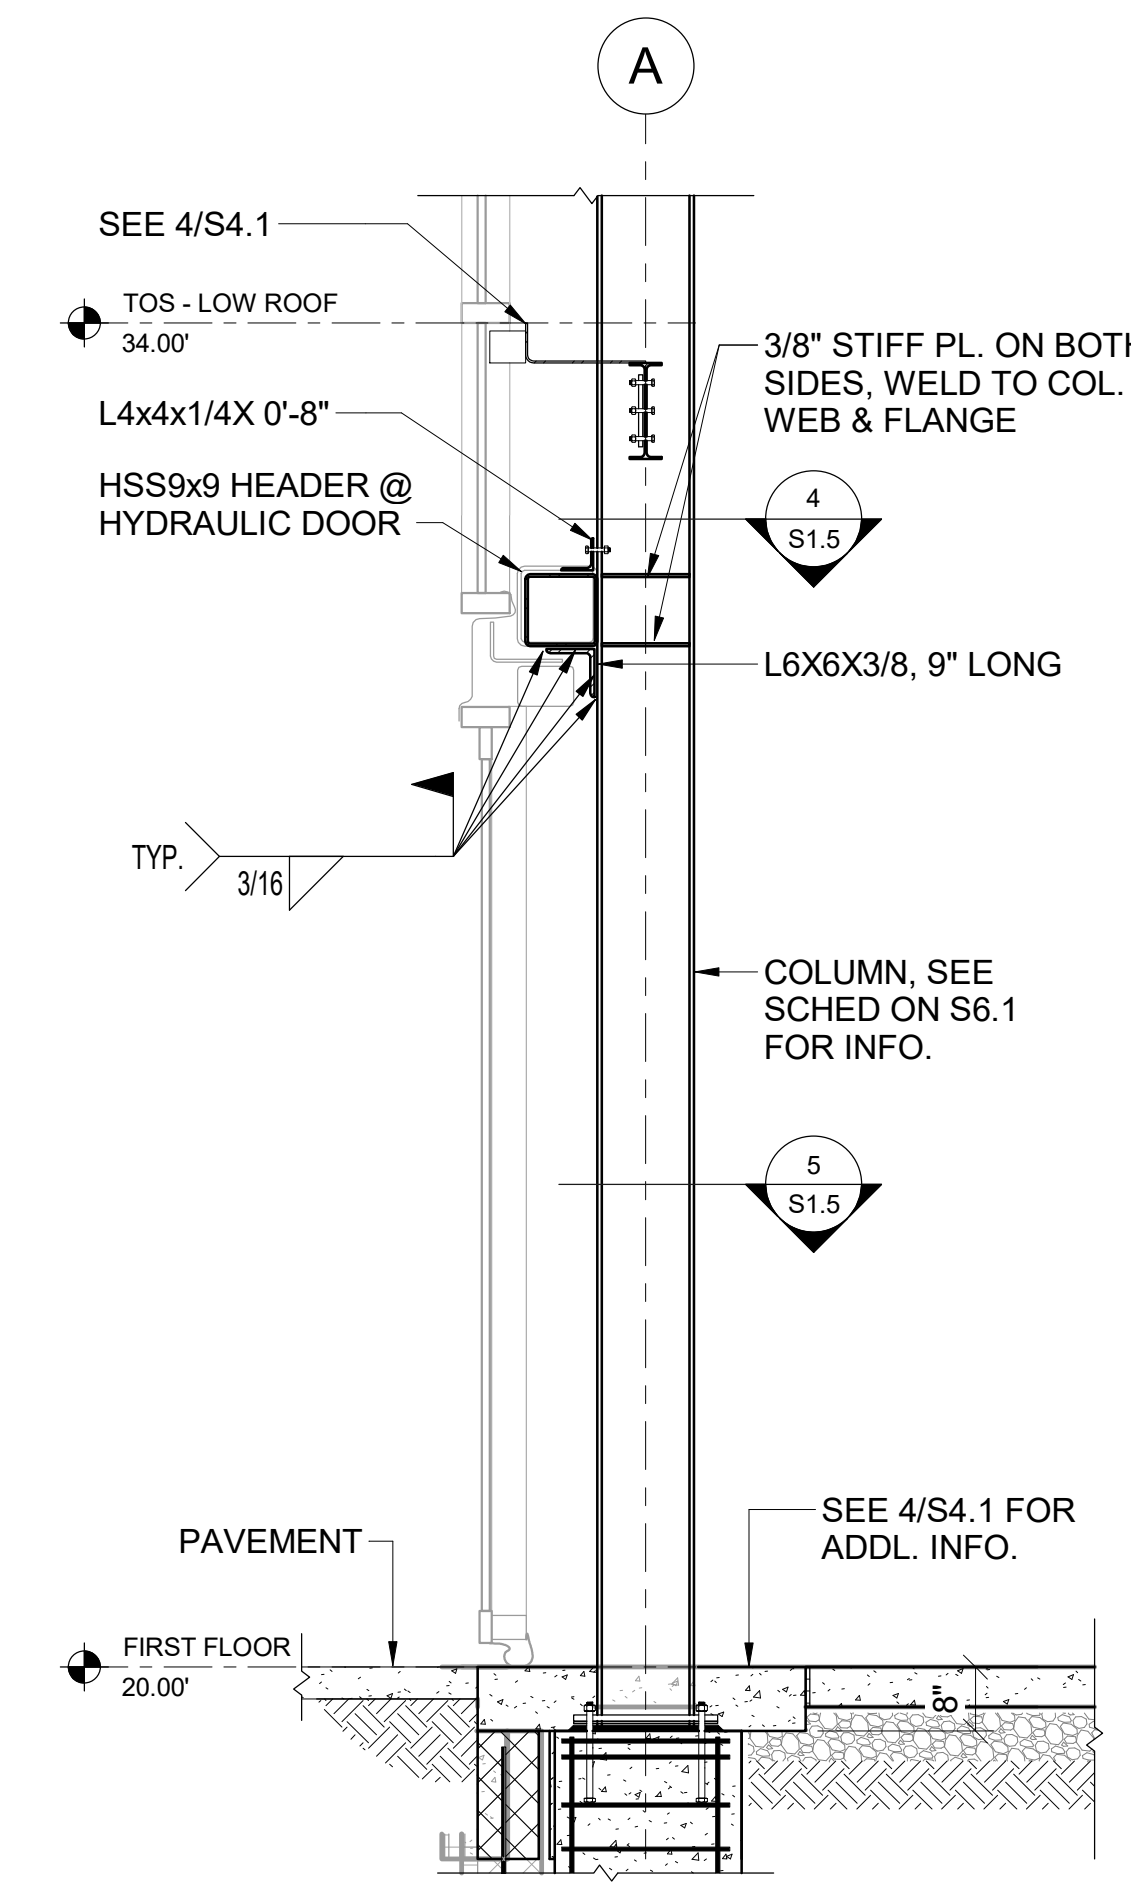


3 WALL SECTION (ADD ALT. #5)
S1.5 SCALE: 1/2" = 1'-0"

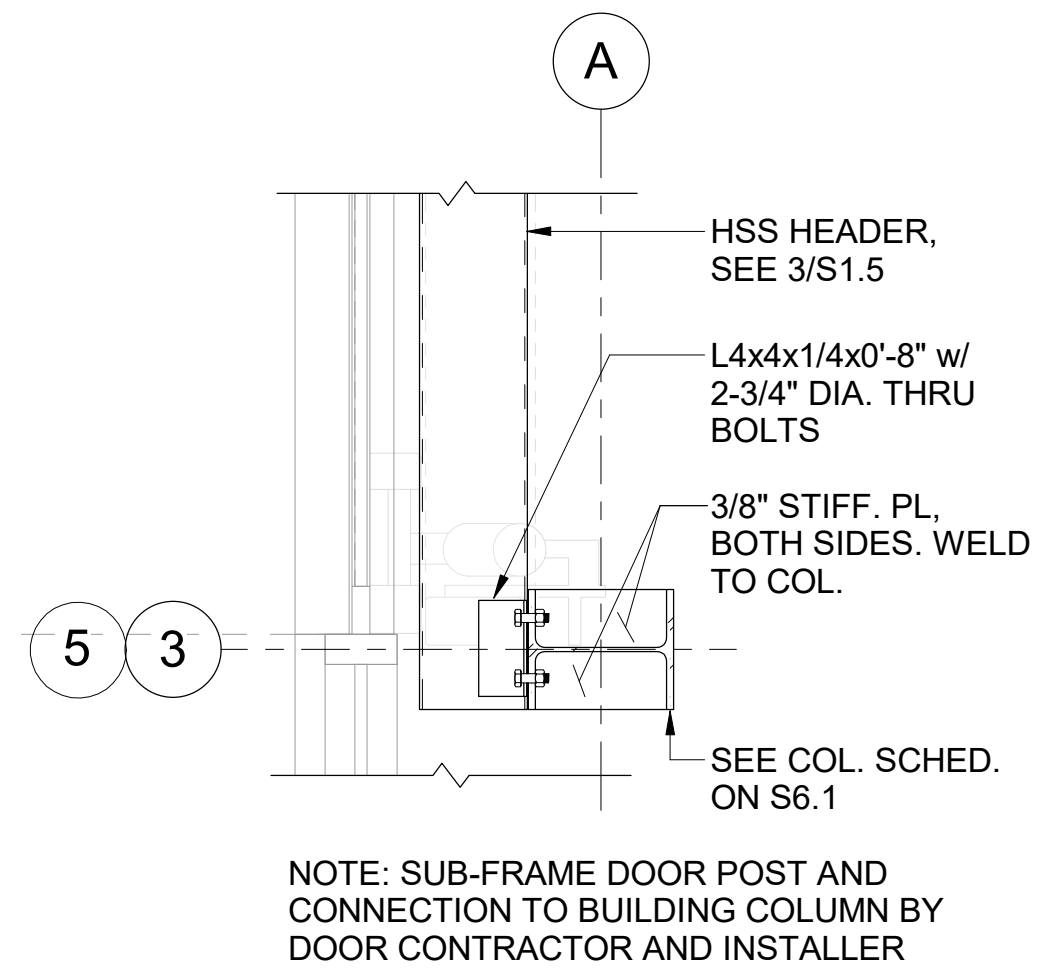


4 PLAN VIEW (ADD ALT. #2)
S1.5 SCALE: 3/4" = 1'-0"

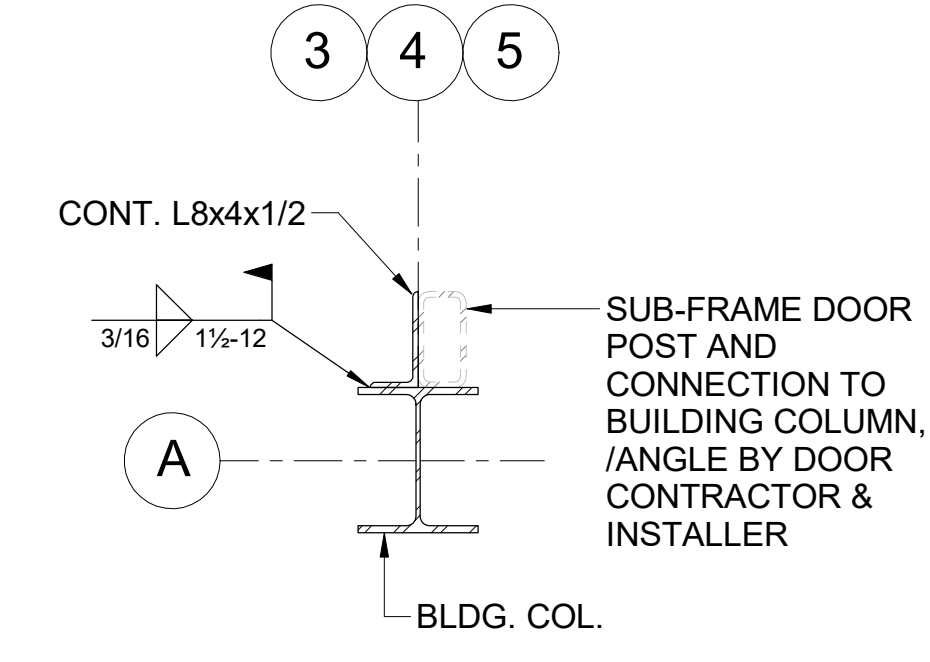

5 PLAN VIEW (ADD ALT. #2)
S1.5 SCALE: 3/4" = 1'-0"

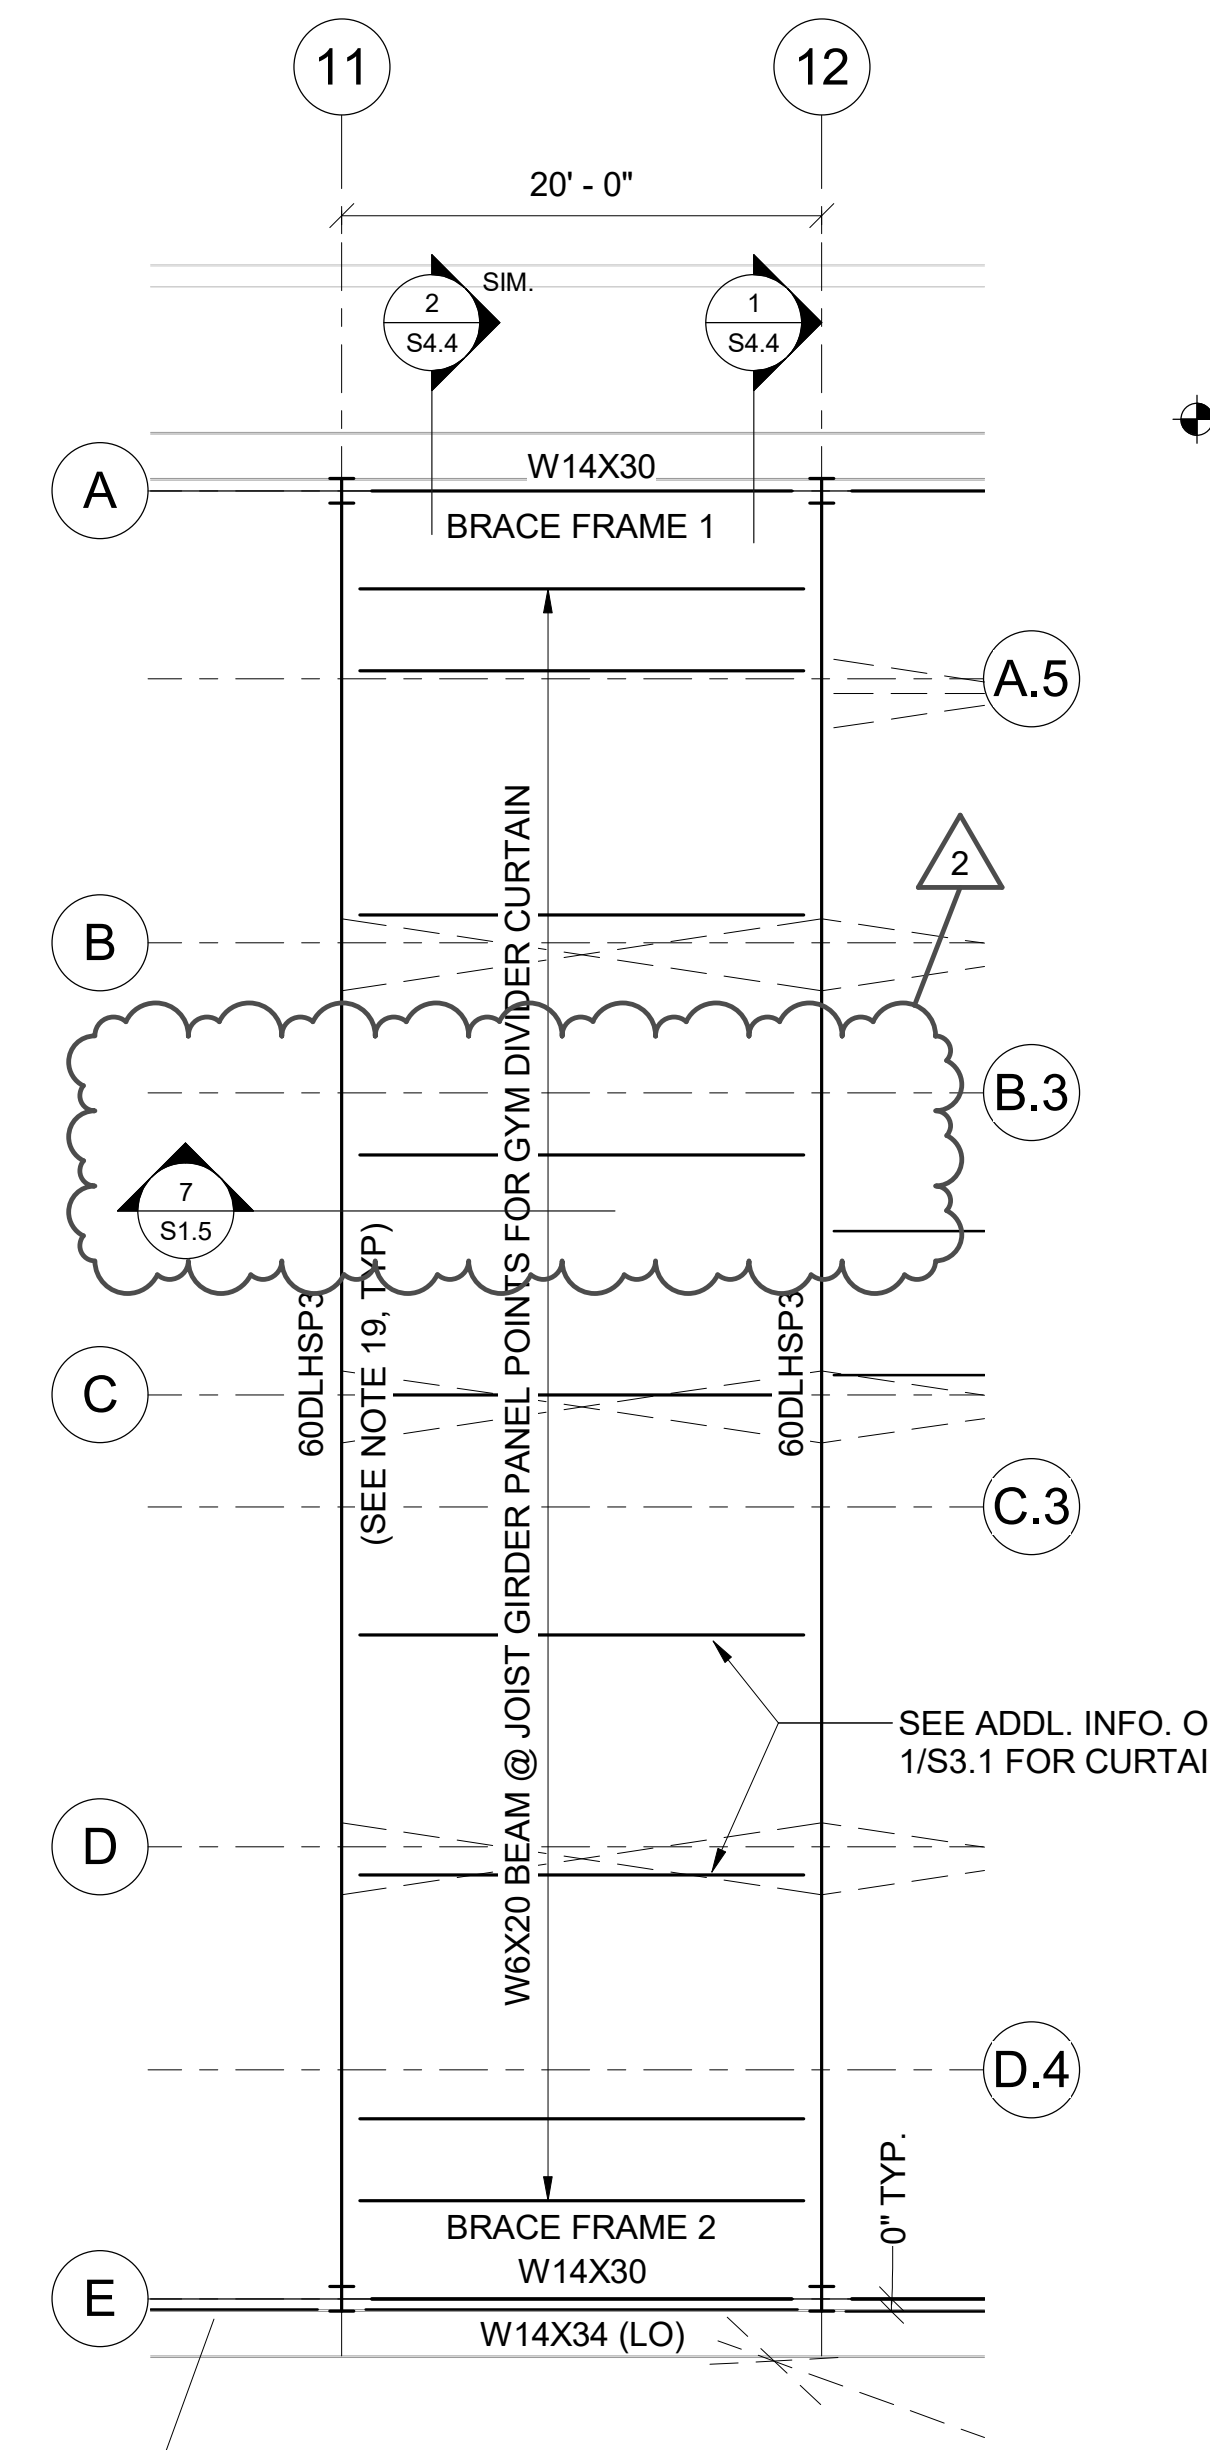

6 ROOF FRAMING PLAN (ADD ALT #5)
S1.5 SCALE: 1/8" = 1'-0"

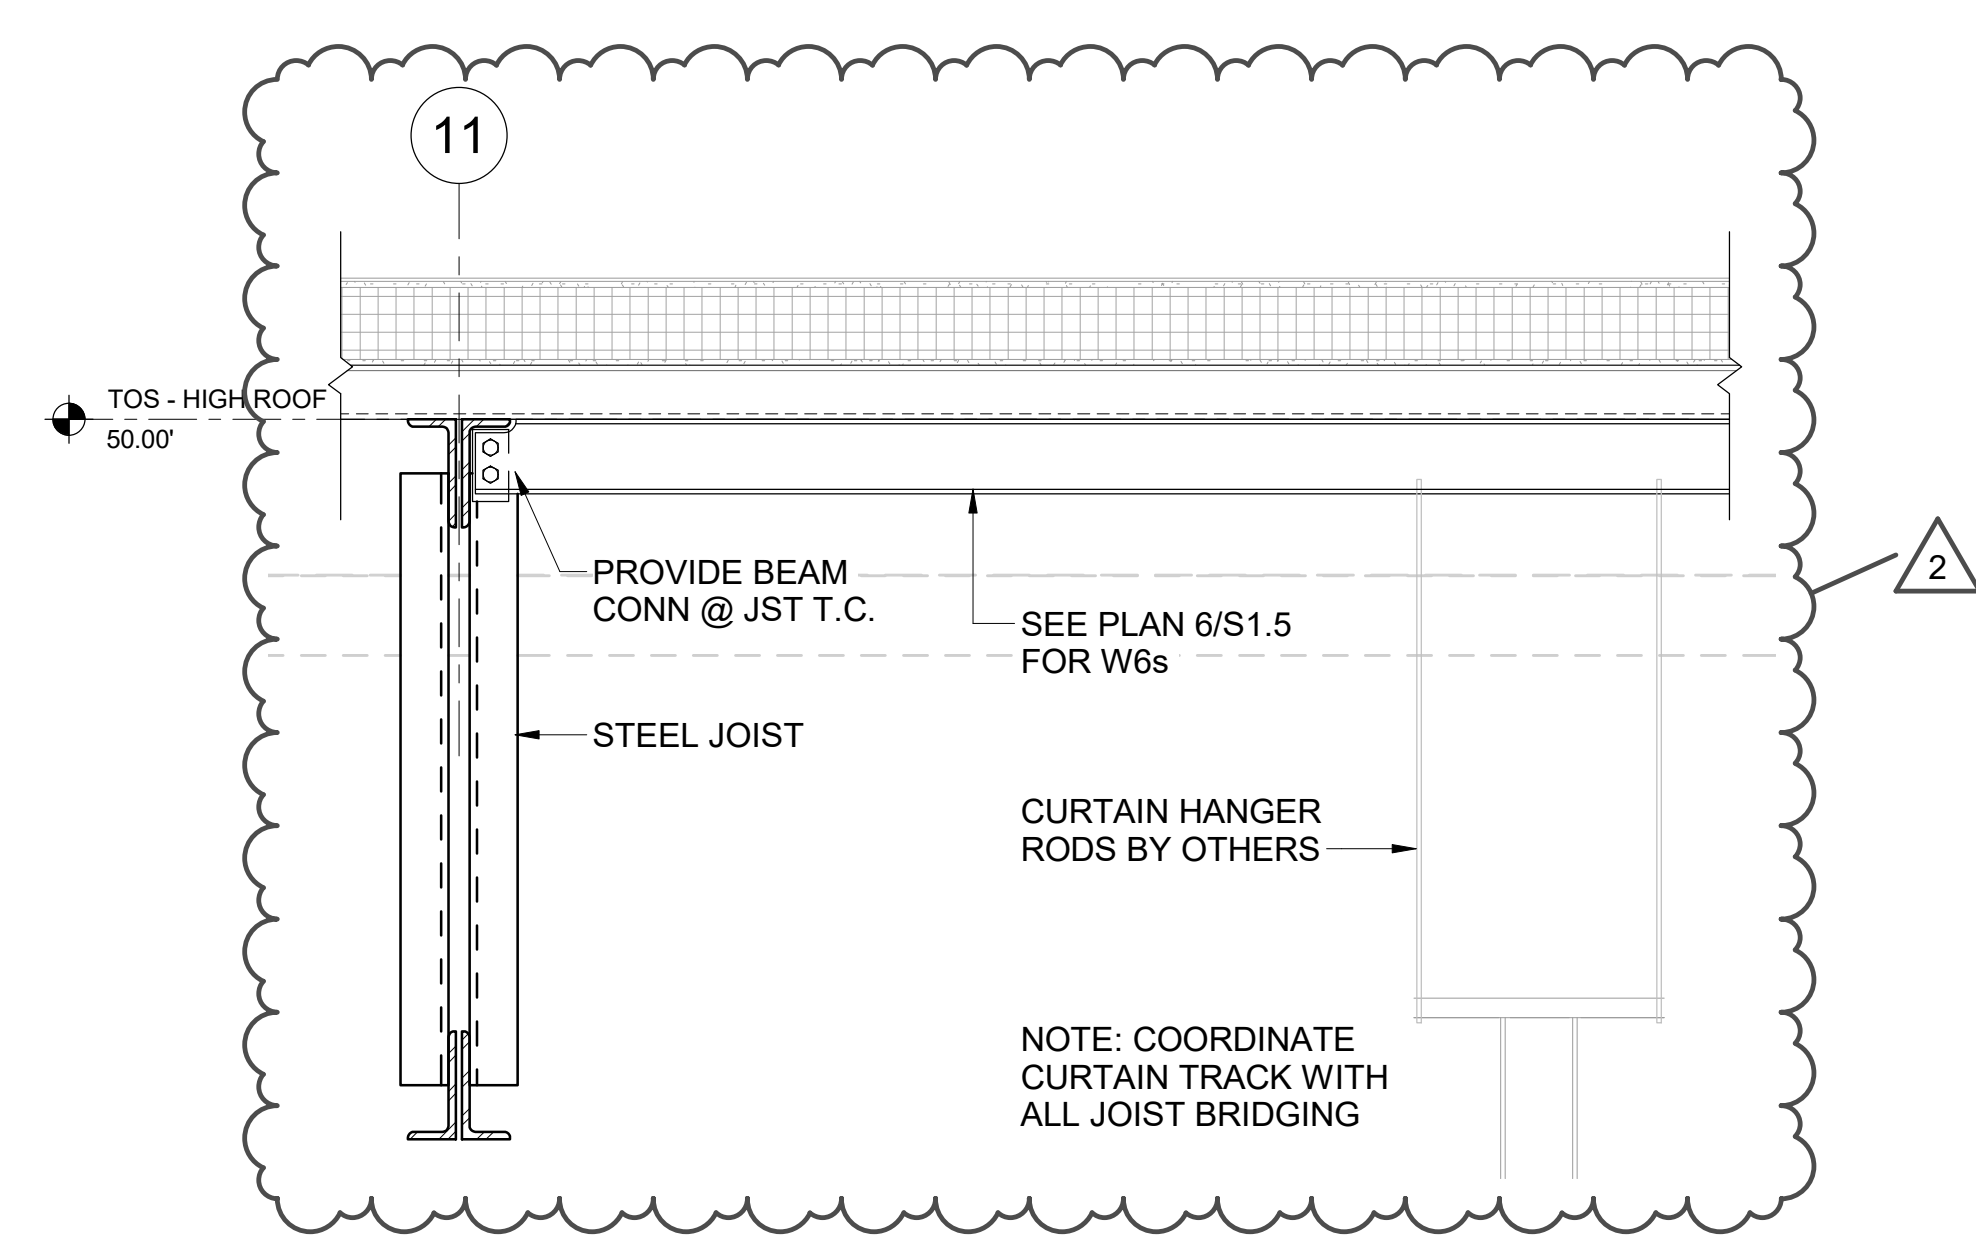

7 ROOF SECTION (ADD ALT. #5)
S1.5 SCALE: 3/4" = 1'-0"

ISSUED FOR BID



© 2019 GWWO INC.
I CERTIFY THAT THESE DOCUMENTS WERE PREPARED OR APPROVED BY ME, AND THAT I AM A FULLY LICENSED ENGINEER UNDER THE LAWS OF THE STATE OF MARYLAND. LICENSE NUMBER: 15238, EXPIRATION DATE: 01/19/2021

Revisions:		
No.	Date	Description
2	01/28/2020	ADDENDUM #2

MIDDLE BRANCH FITNESS & WELLNESS CENTER AT CHERRY HILL
BALTIMORE CITY RECREATION & PARKS

Job No.	18010	YP/AM	Drawn
Scale	As indicated	DR	Checked
Date	11/29/19	ACP	Approved



Drawing Title: ADD ALTERNATE - HYDRAULIC DOOR & GYM DIVIDER CURTAIN
Drawing Number: S1.5r2

F-1823

Sheet

KEY PLAN:


KEYNOTES LISTED ON THIS SHEET ARE FOR CONVENIENCE ONLY. REFER TO SHEET CS.2 FOR COMPLETE LIST

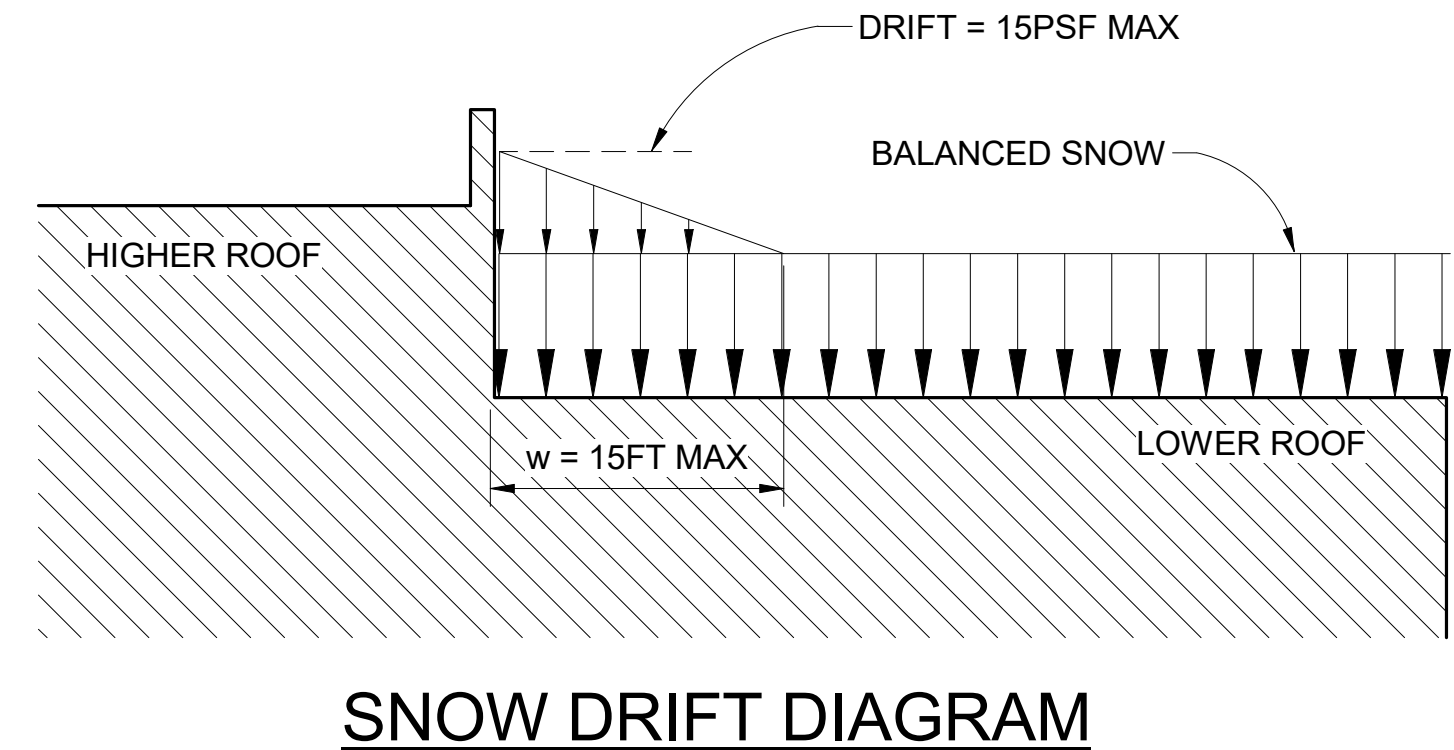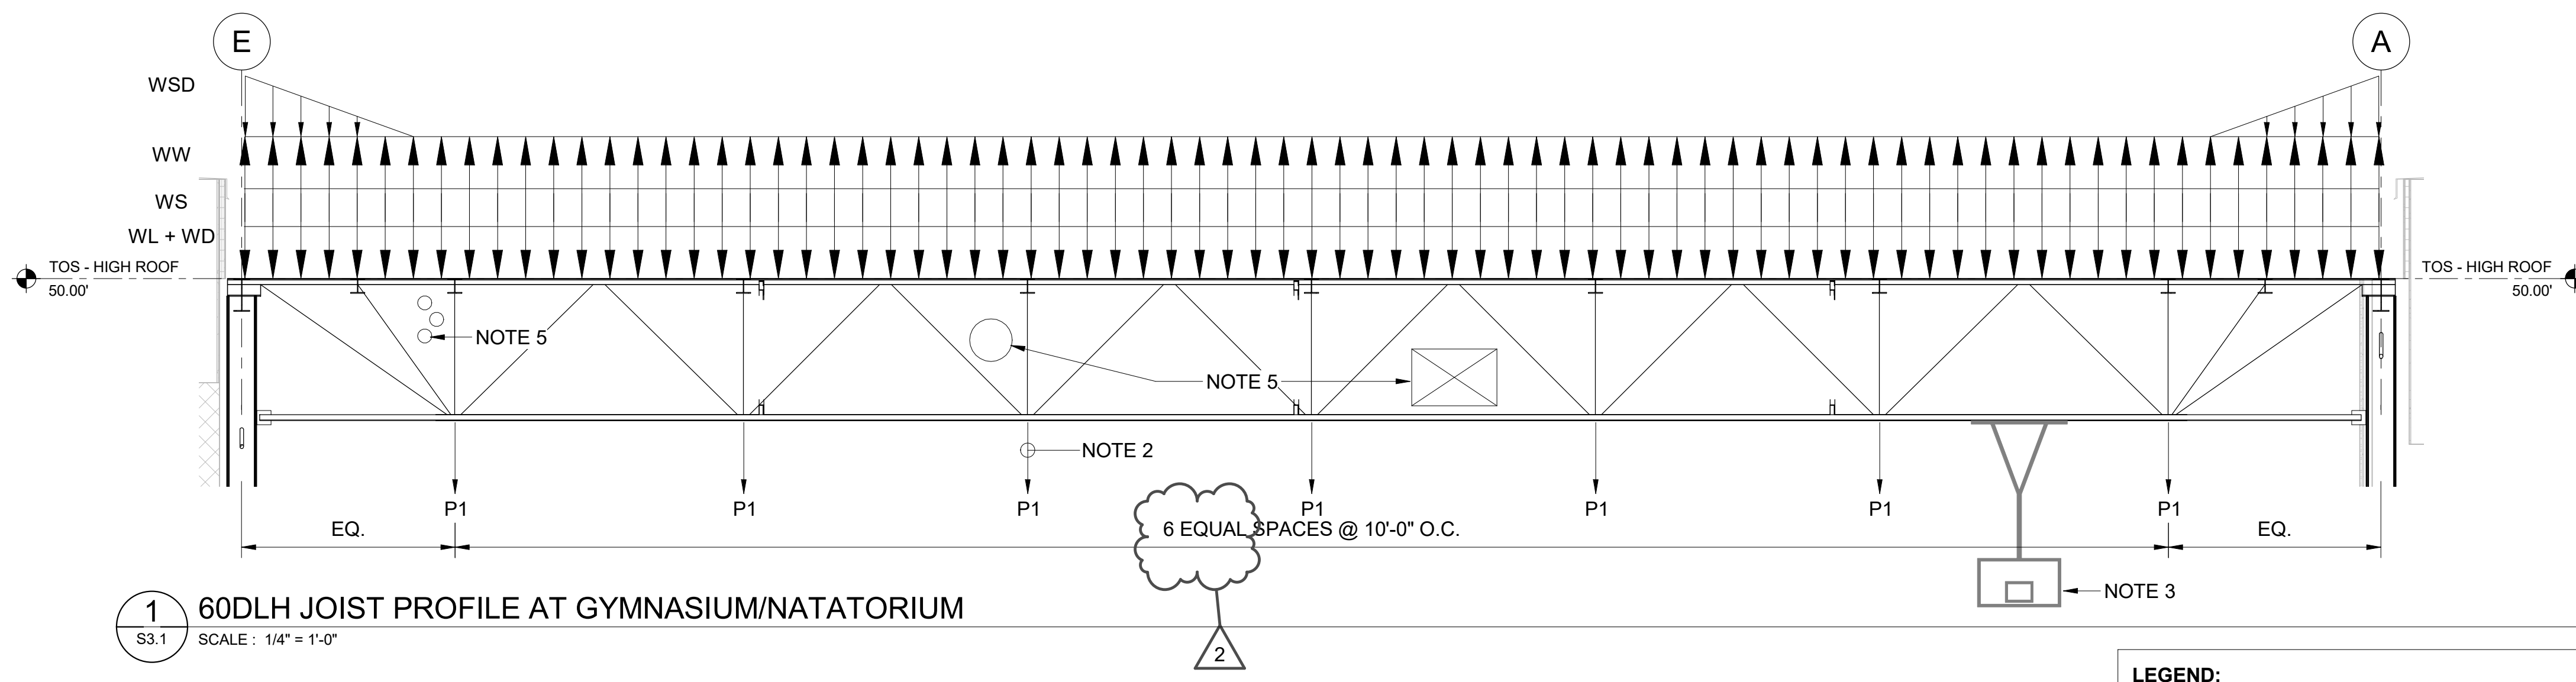


1 60DLH JOIST PROFILE AT GYMNASIUM/NATATORIUM
S3.1 SCALE: 1/4" = 1'-0"

LEGEND:
 WD - ROOF DEAD LOAD
 WL - ROOF LIVE LOAD
 WS - ROOF SNOW LOAD
 WSD - ROOF SNOW DRIFT LOAD [SEE THIS SHEET]
 WW - WIND LOAD
 P1 = 200 LBS [GYM DIVIDER CURTAIN]


JOIST PROFILE NOTES:
 1. SEE GENERAL NOTE 1 FOR DEAD, LIVE, SNOW, WIND LOAD INFORMATION AND THE COMPONENTS & CLADDING CHART ON S1.1.
 2. SEE S1.5 FOR ADDL. INFO FOR BEAMS @ JOIST GIRDER PANEL POINTS FOR GYM DIVIDER CURTAIN.
 3. SEE NOTE 17 ON S1.4 FOR BASKETBALL BACKBOARD INFORMATION.
 4. SEE S1.2, S1.4 & S4 SERIES FOR LOCATIONS OF ALL HANGER POSTS.
 5. COORDINATE ALL JOIST PROFILES FOR PIPES/DUCTS ETC.
 6. COORDINATE LOADS AT JOIST BOTTOM CHORD WITH FOLDING PARTITION MFR.
 7. SEE THIS SHEET FOR SNOW DRIFT INFORMATION.

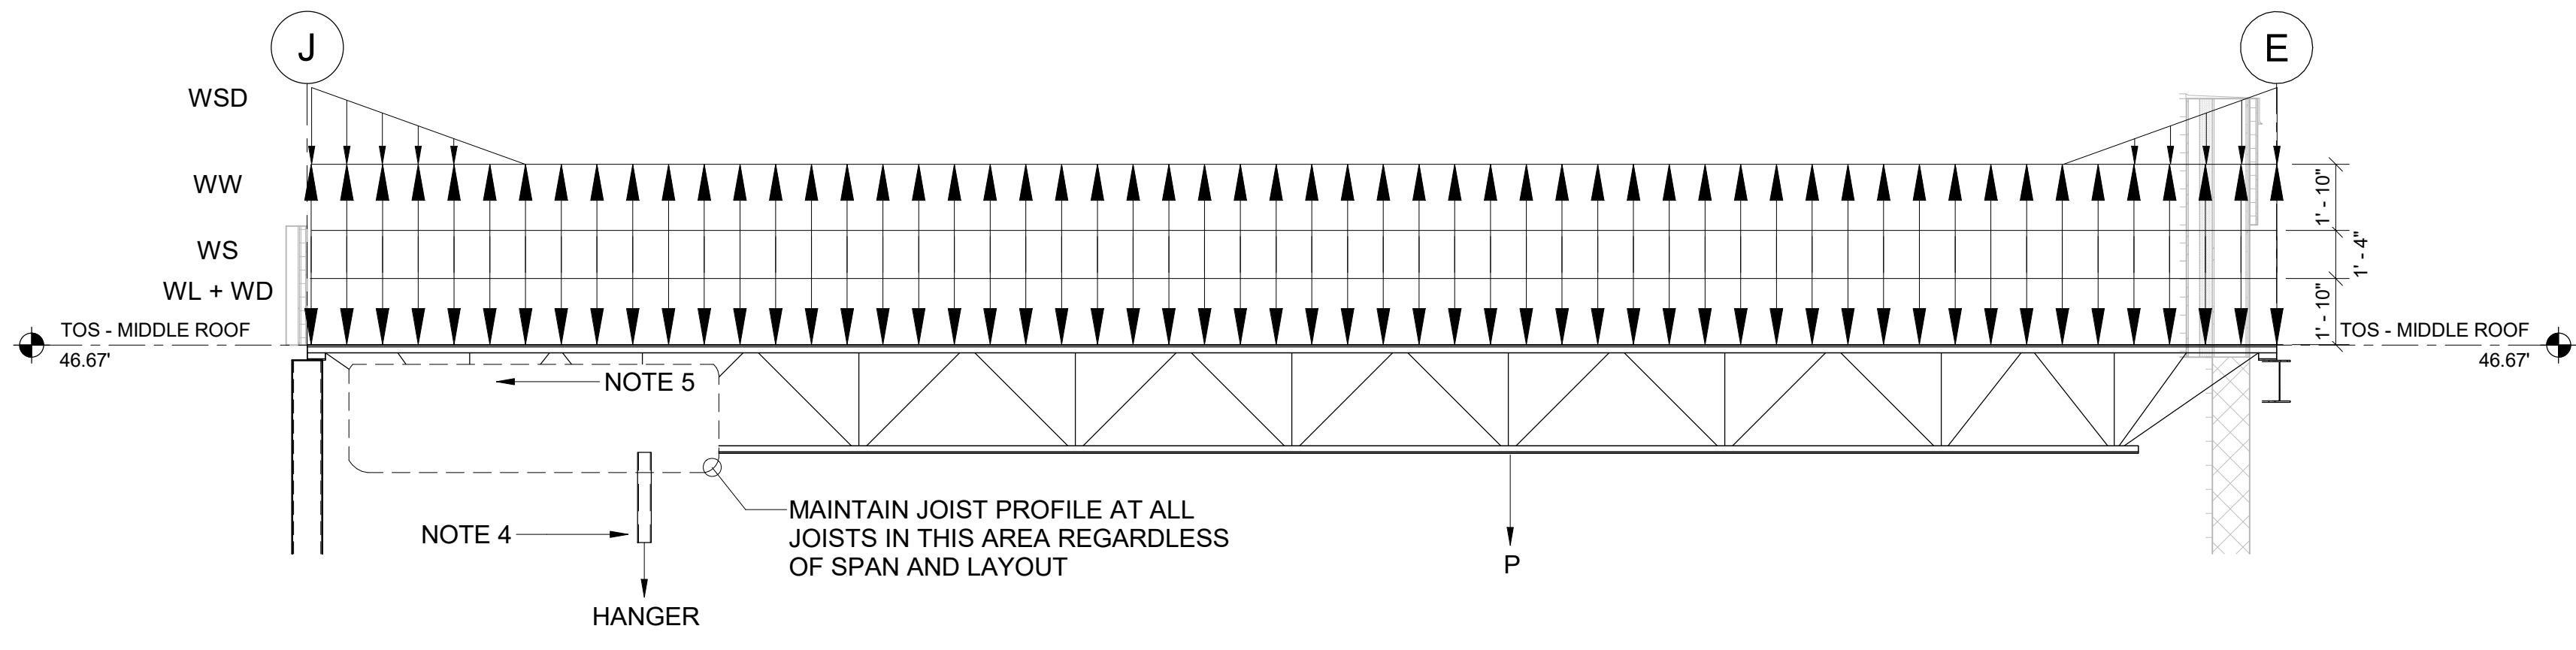

2 36LH JOIST PROFILE AT NEXUS
S3.1 SCALE: 1/4" = 1'-0"

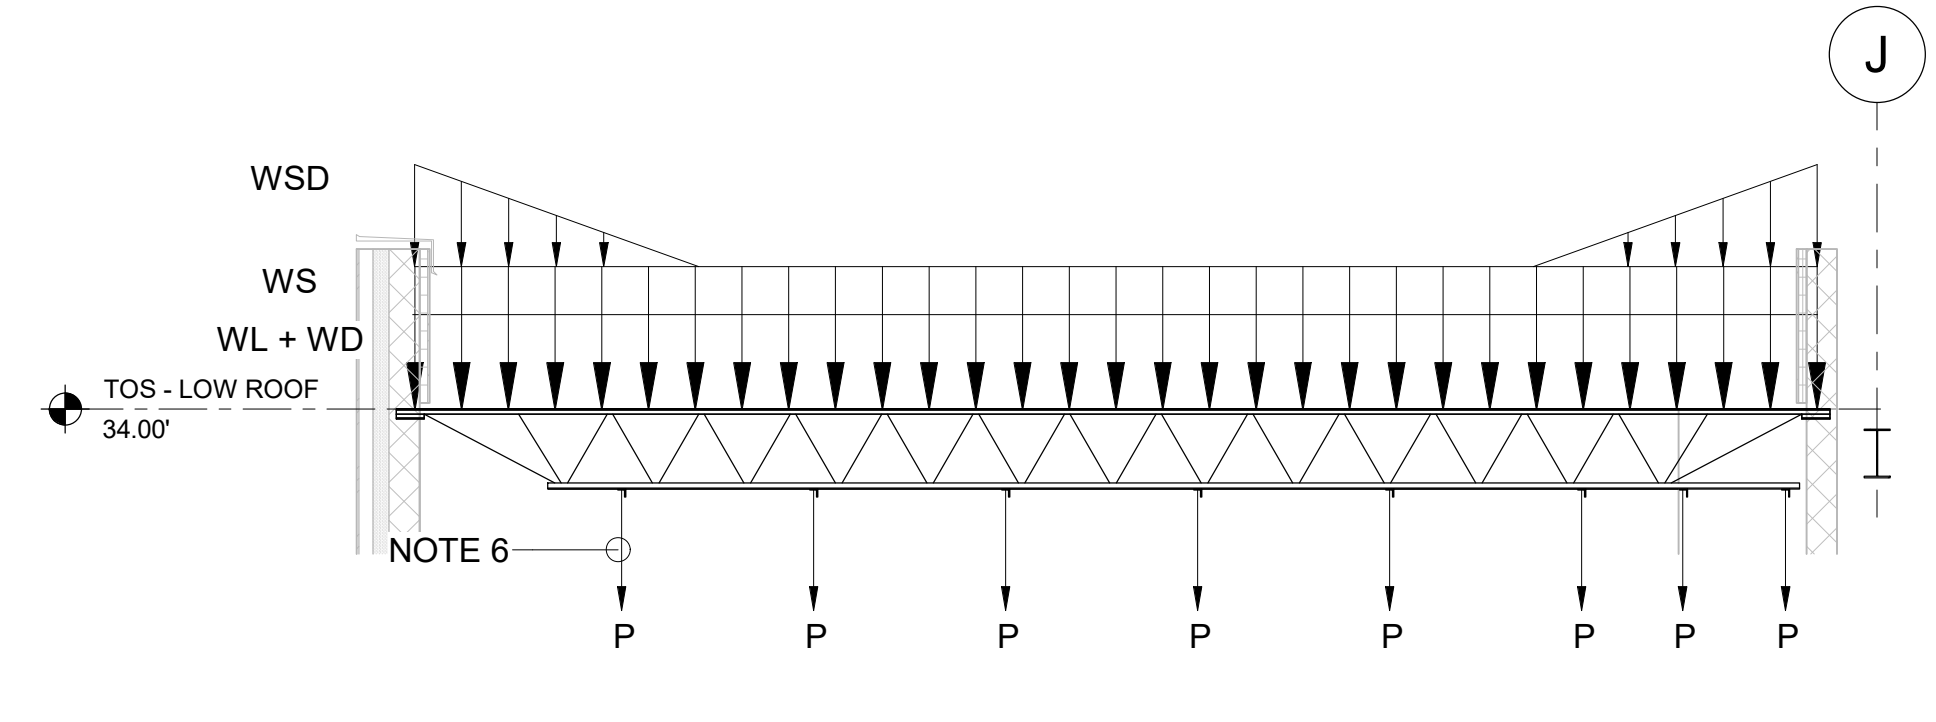


3 18K JOIST PROFILE AT NEXUS
S3.1 SCALE: 1/4" = 1'-0"

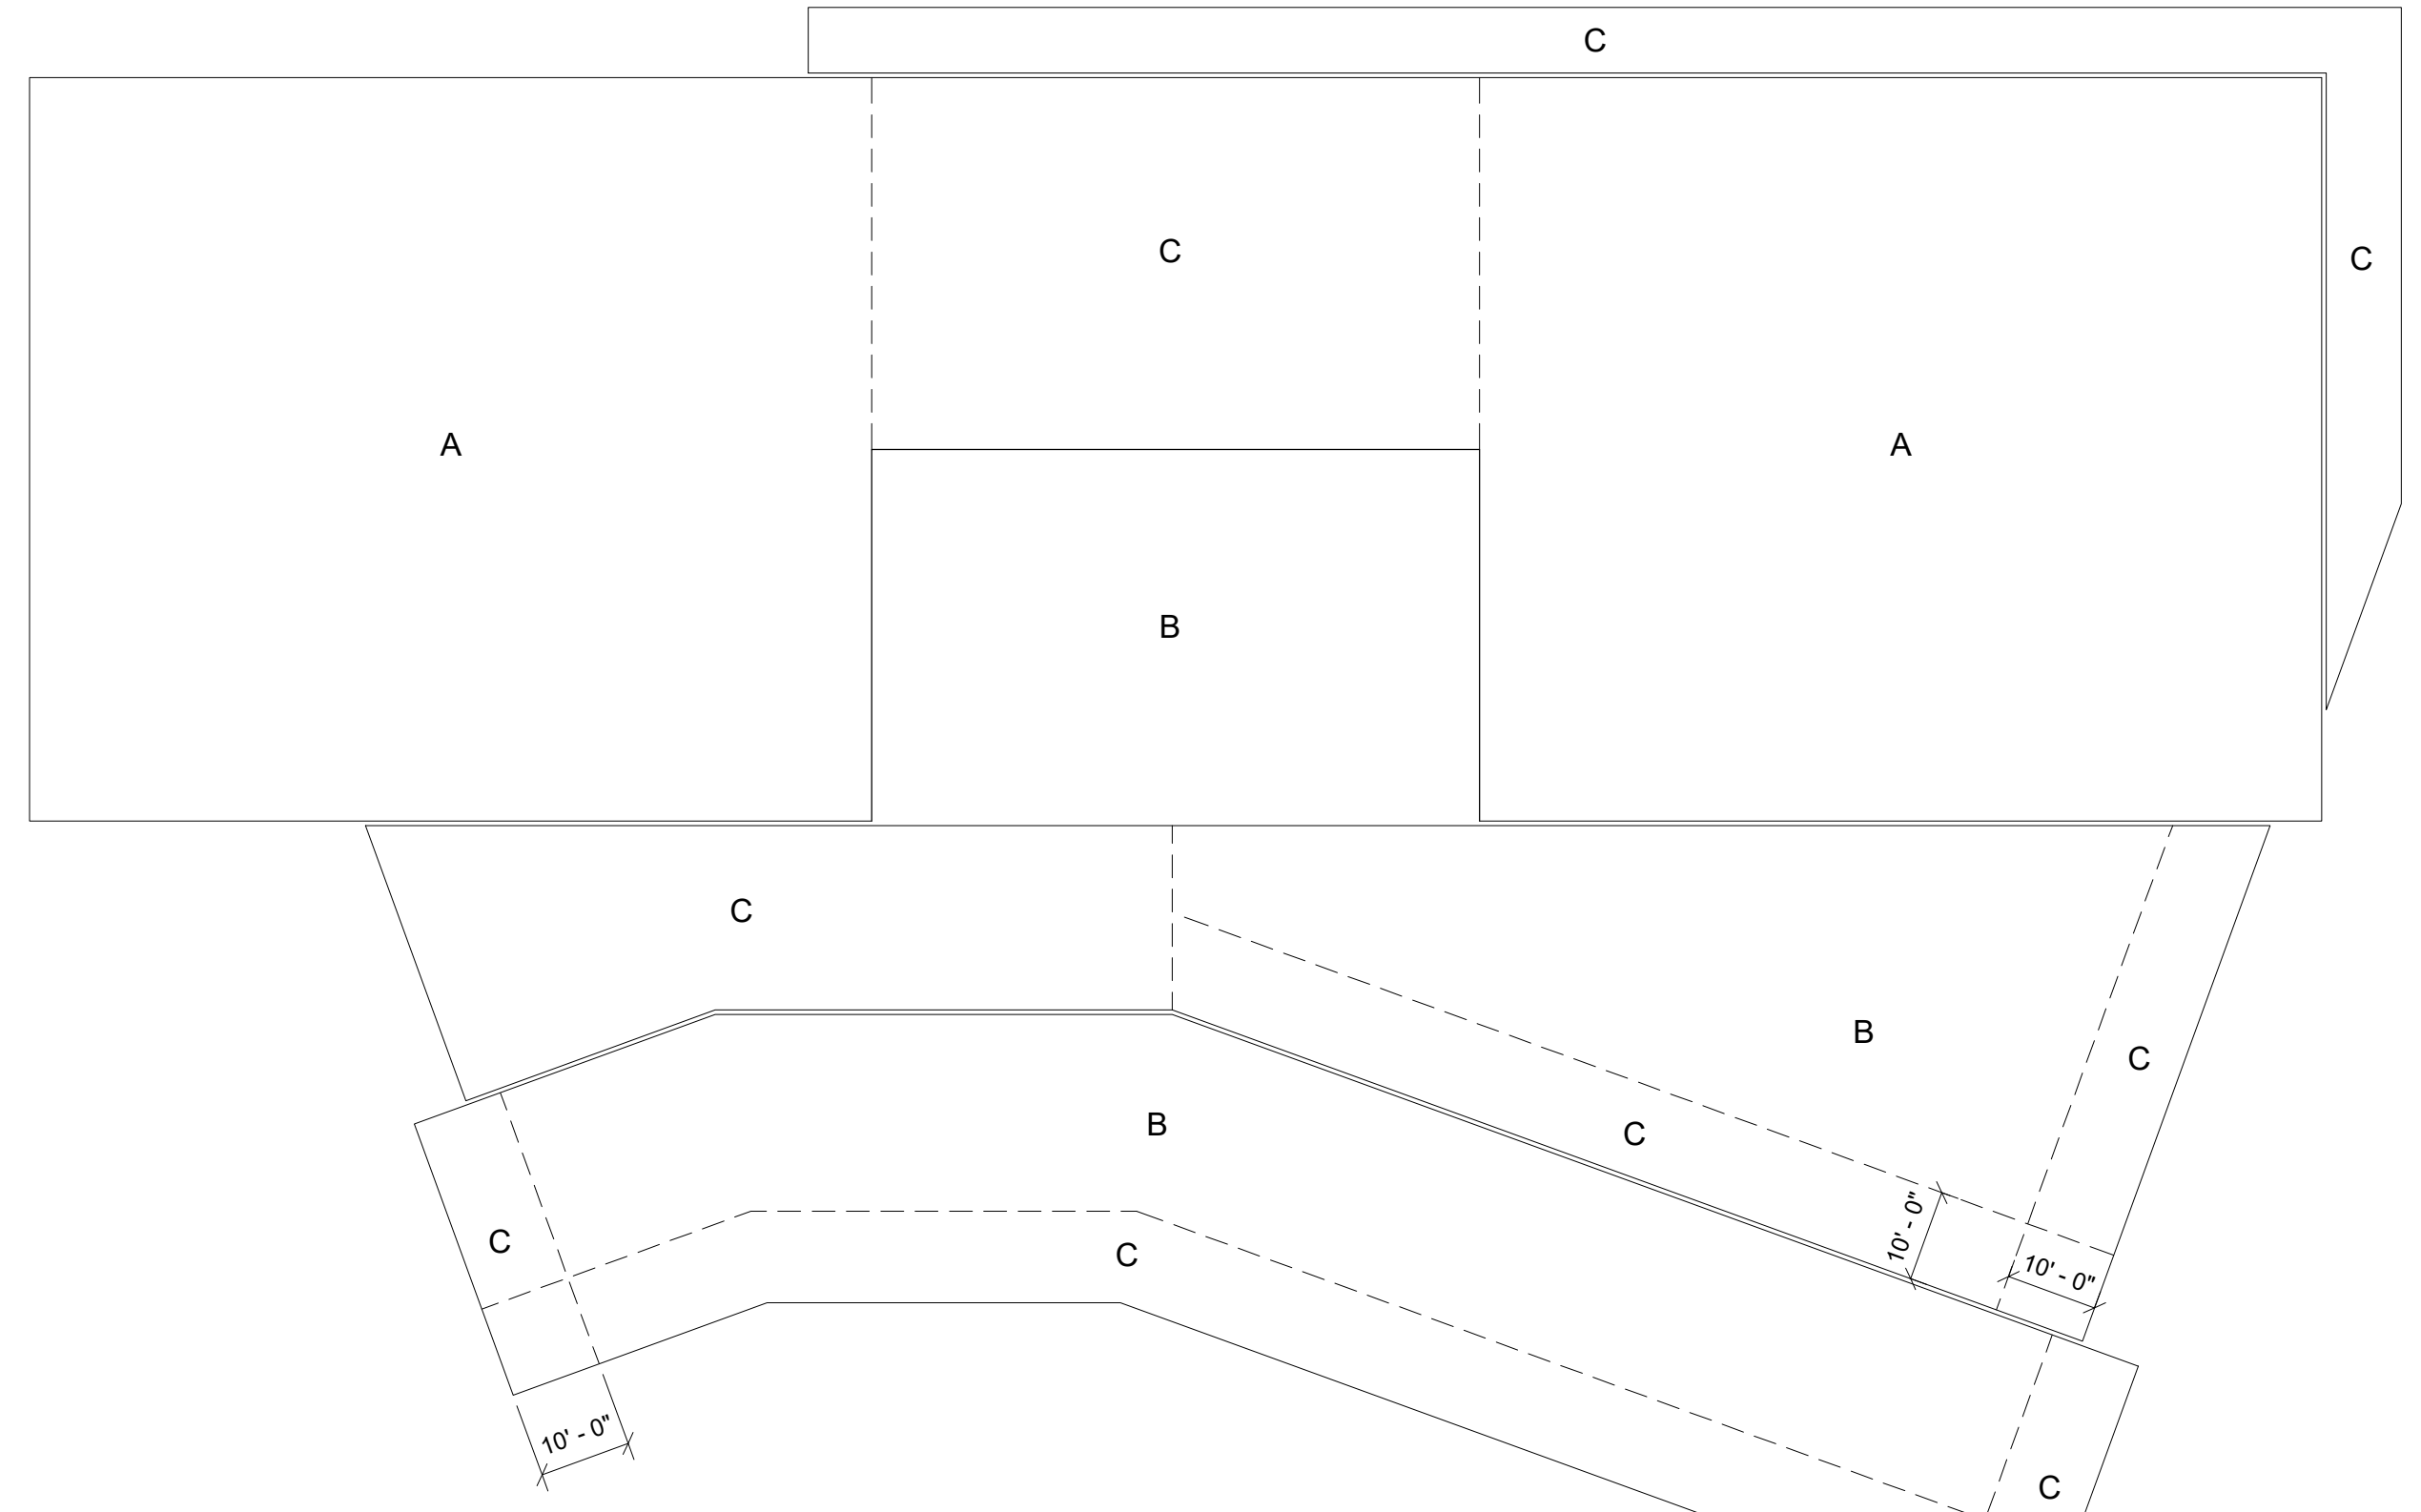


ROOF DECK WELDING PLAN
 NOTES:
 1. SEE FRAMING PLANS FOR DECK INFORMATION & SPAN.
 2. FASTEN DECK TO SUPPORTING STRUCTURAL STEEL MEMBERS AS FOLLOWS:
 ZONE A: 3/4" Ø ARC PUDDLE WELD, 36/3 PATTERN WITH 1" X 3/8" SEAM WELD FOR SIDELAP
 ZONE B: 5/8" Ø ARC PUDDLE WELD, 36/4 PATTERN WITH (5) 10" TEK SCREWS FOR SIDELAP
 ZONE C: 5/8" Ø ARC PUDDLE WELD, 36/7 PATTERN WITH (6) 10" TEK SCREWS FOR SIDELAP

4 ROOF FASTENER PLAN
S3.1 SCALE: 1" = 20'-0"

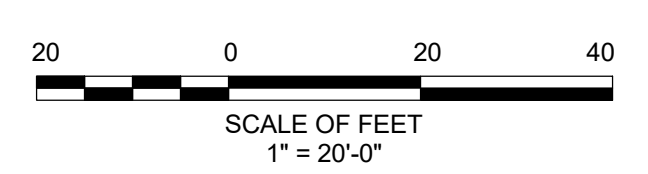

ISSUED FOR BID

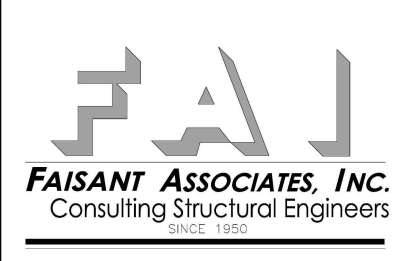

GWOW INC.
 800 WYMAN PARK DRIVE, SUITE 300
 BALTIMORE, MARYLAND 21211, 410-352-1909


© 2019 GWOW INC.
 I CERTIFY THAT THESE DOCUMENTS WERE PREPARED OR APPROVED BY ME, AND THAT I AM A FULLY LICENSED ENGINEER UNDER THE LAWS OF THE STATE OF MARYLAND. LICENSE NUMBER: 15238, EXPIRATION DATE: 01/15/2021

Revisions:		
No.	Date	Description
2	01/28/2020	ADDENDUM #2


MIDDLE BRANCH FITNESS & WELLNESS CENTER AT CHERRY HILL
 BALTIMORE CITY RECREATION & PARKS

Job No.	18010	YP/AM	Drawn
Scale	As indicated	DR	Checked
Date	11/29/19	ACP	Approved
Drawing Title	Drawing Number		


JOIST LOADING DIAGRAMS
 Sheet F-1823
 S3.1r2
 OF

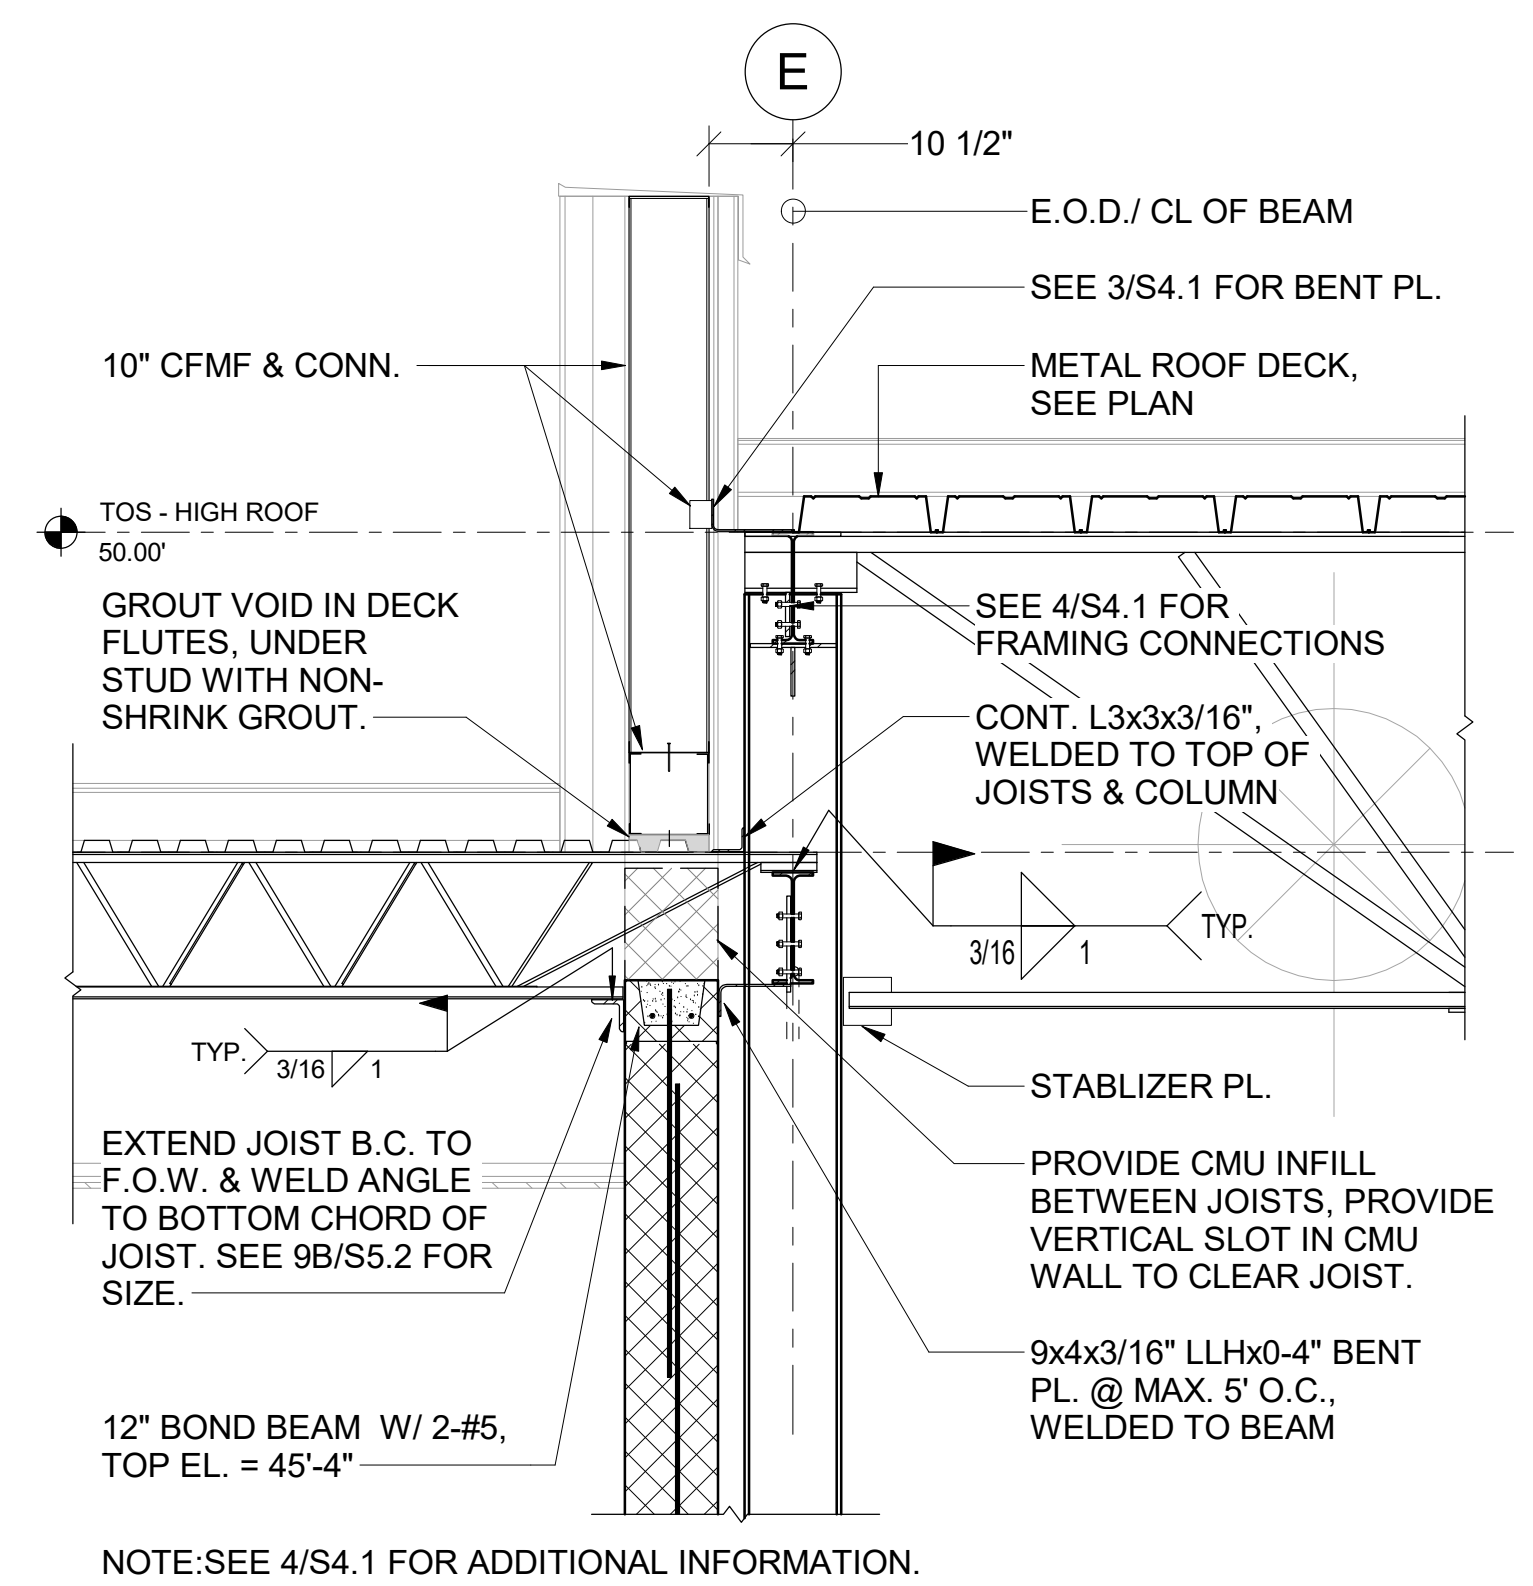


1 WALL SECTION
S4.2 SCALE: 1/2" = 1'-0"

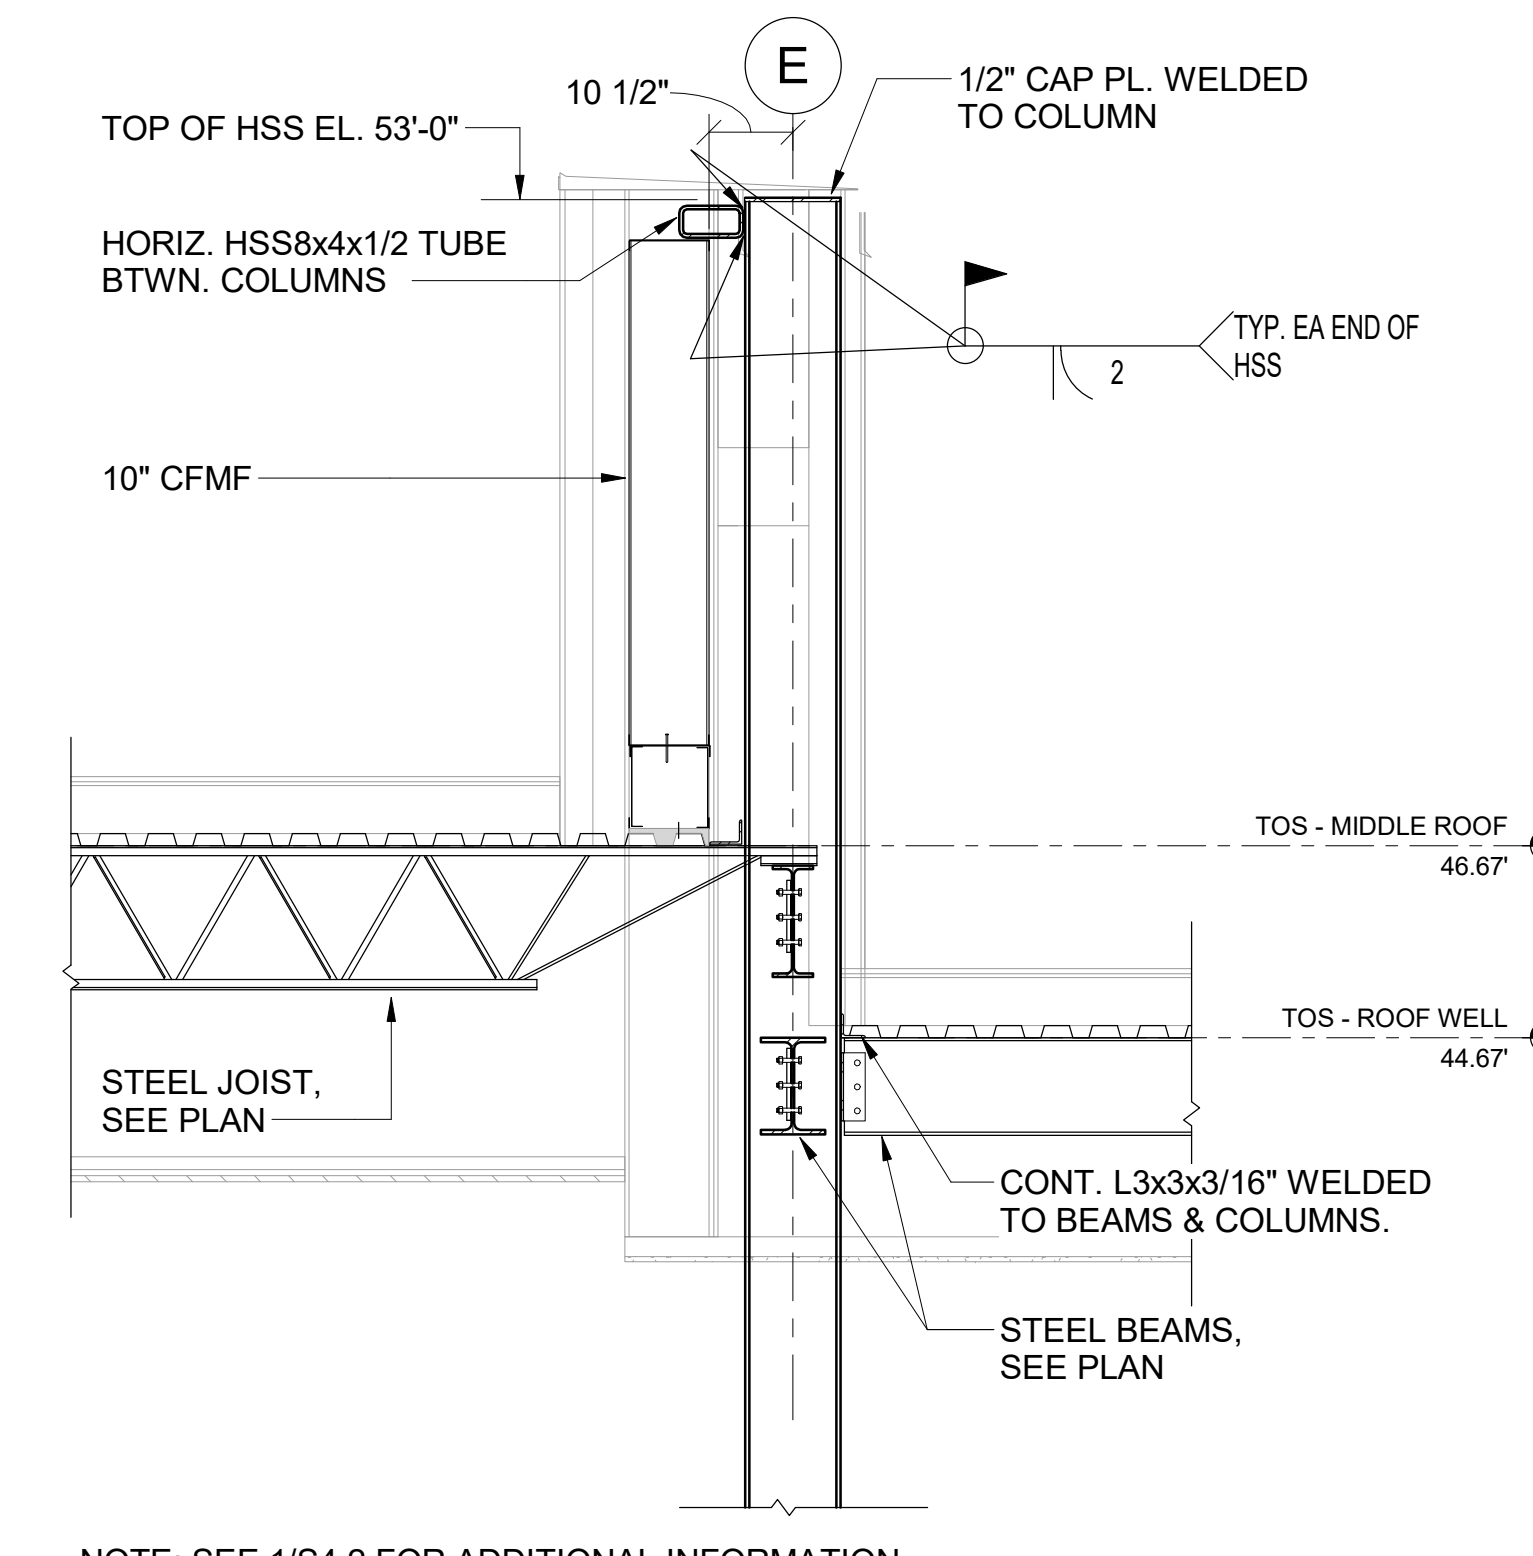


2 WALL SECTION
S4.2 SCALE: 1/2" = 1'-0"

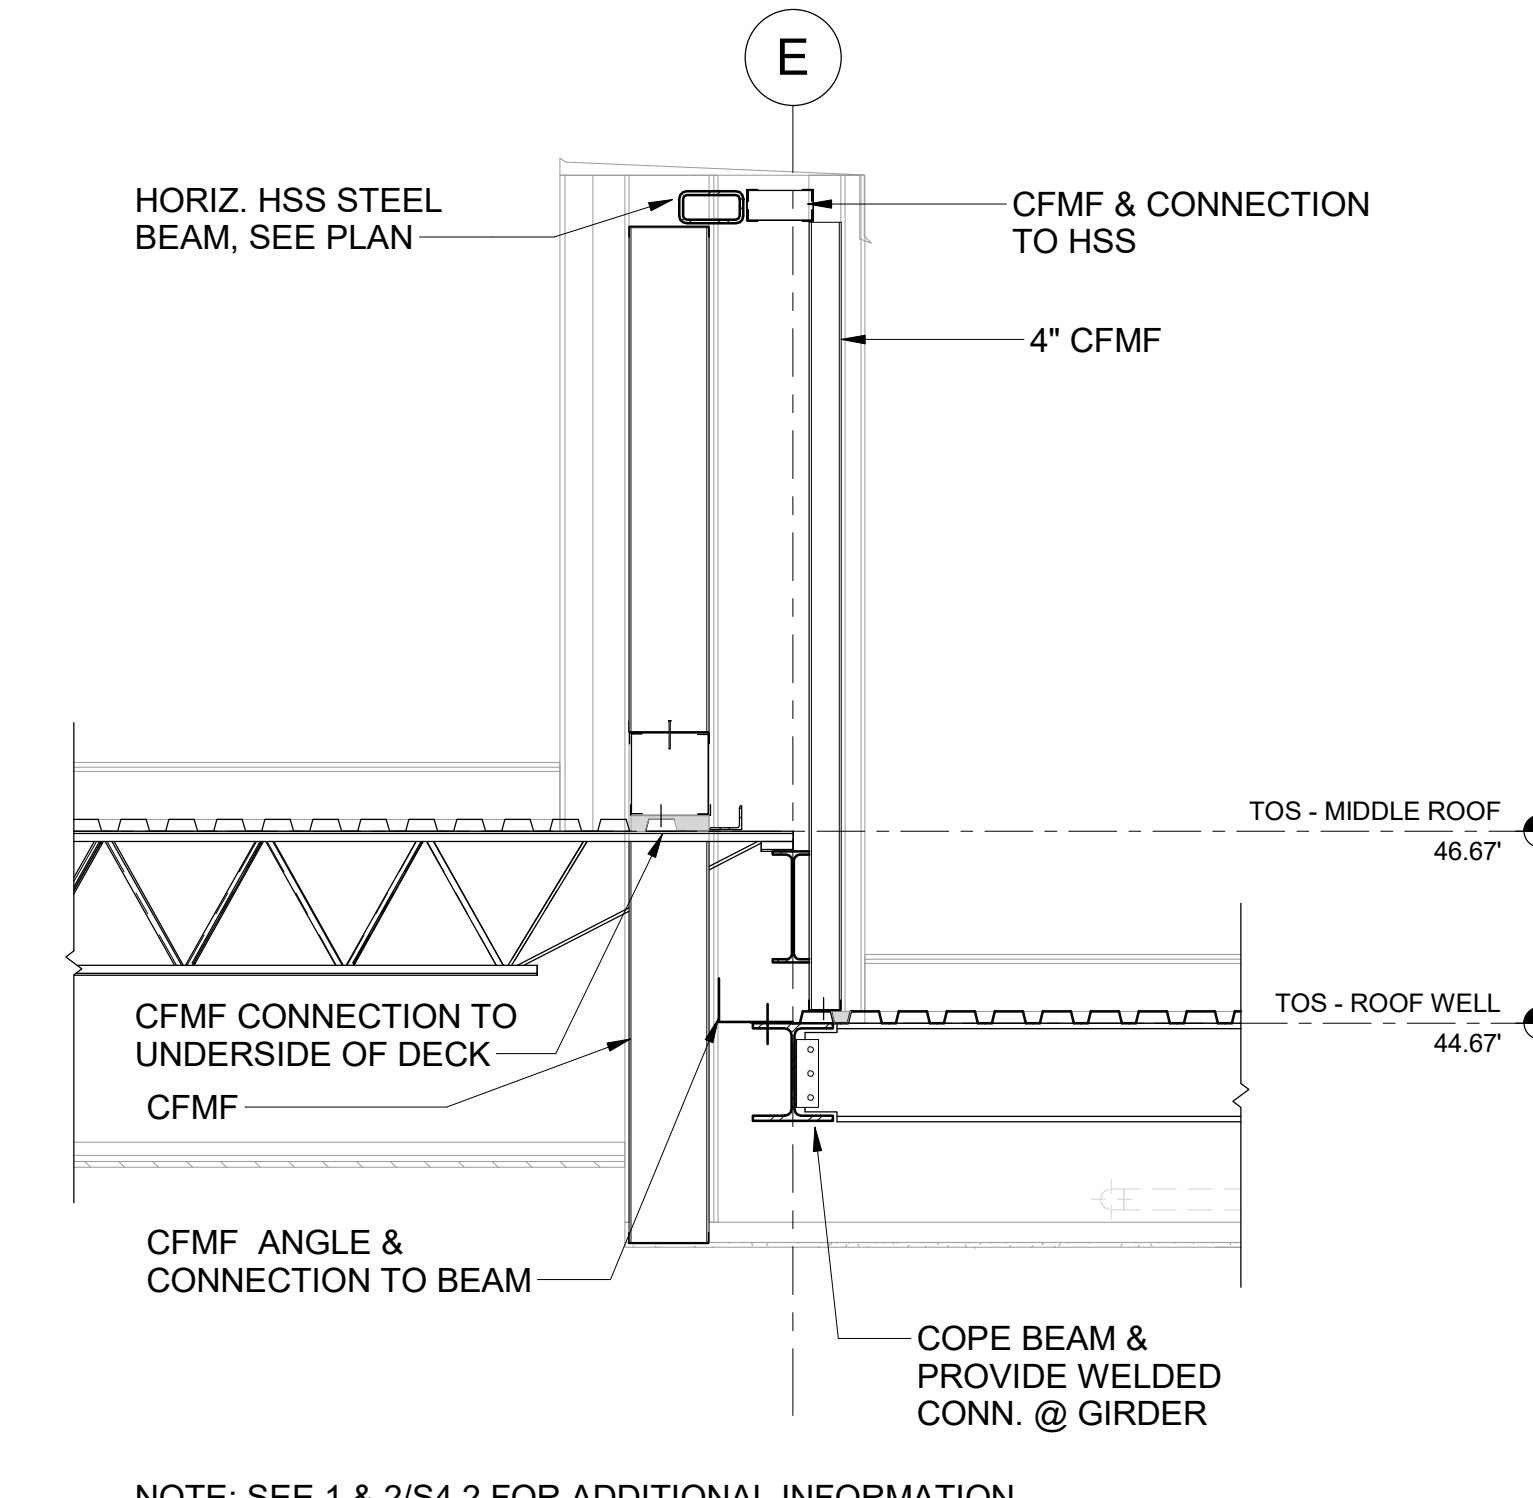


3 WALL SECTION
S4.2 SCALE: 1/2" = 1'-0"

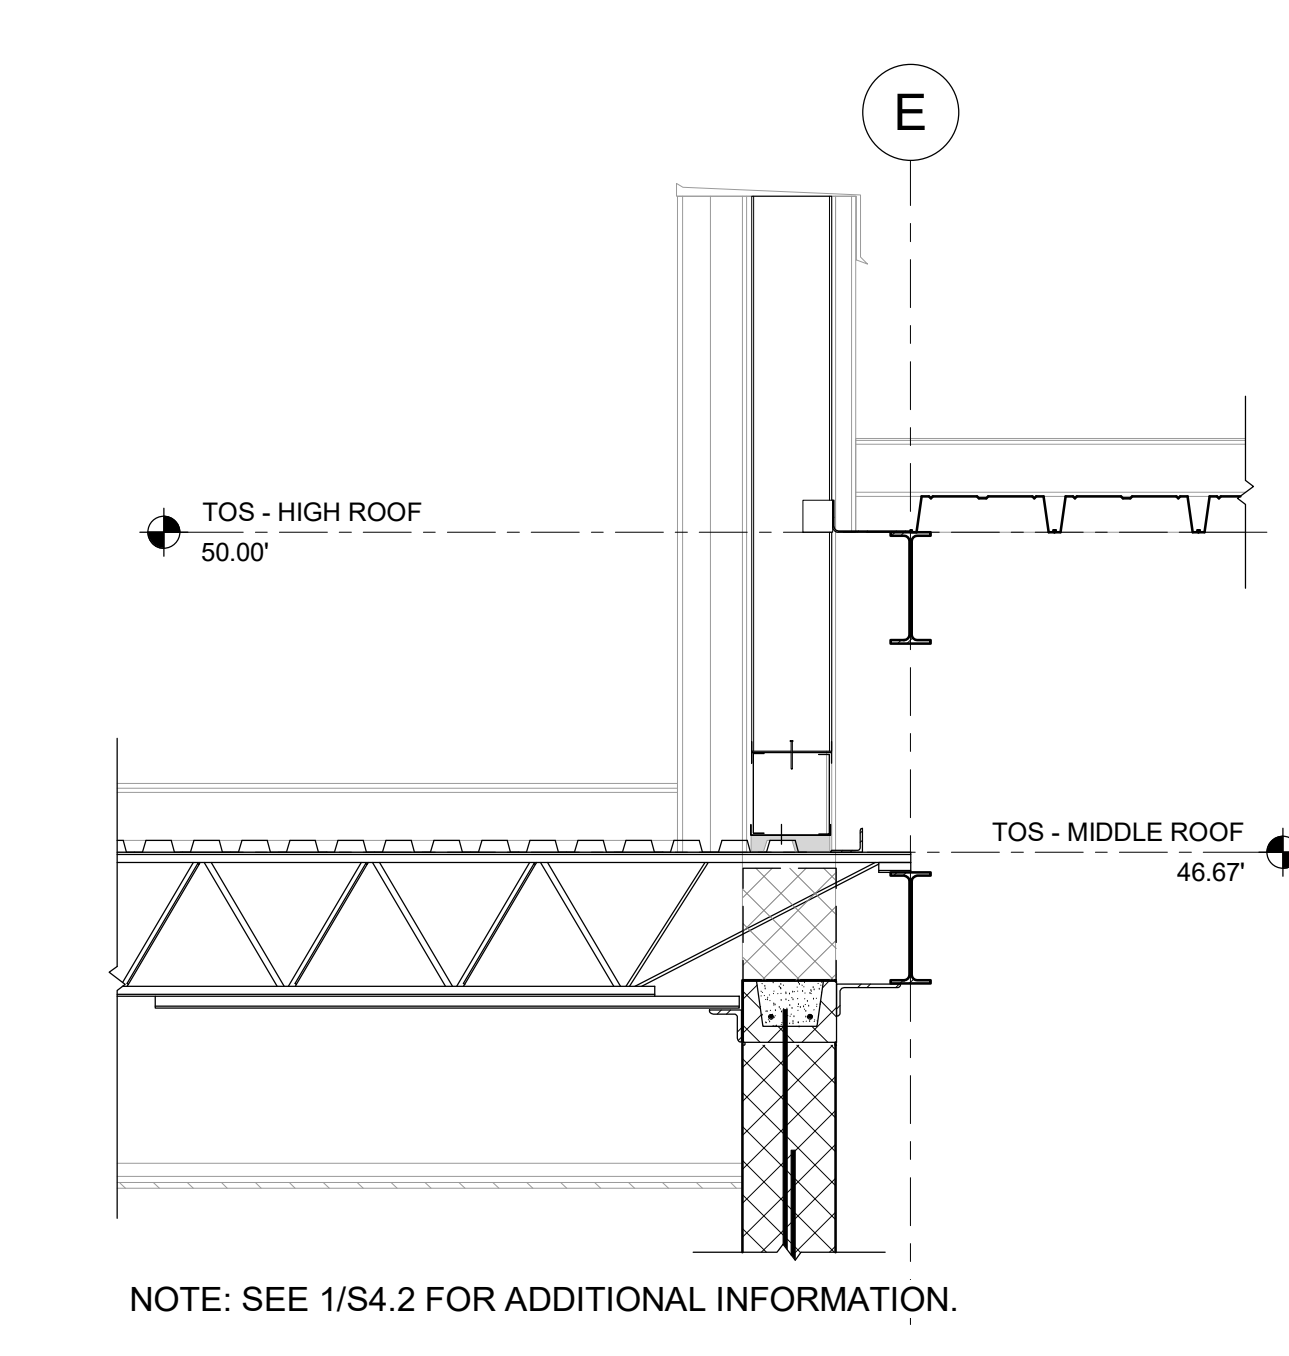


4 WALL SECTION
S4.2 SCALE: 1/2" = 1'-0"

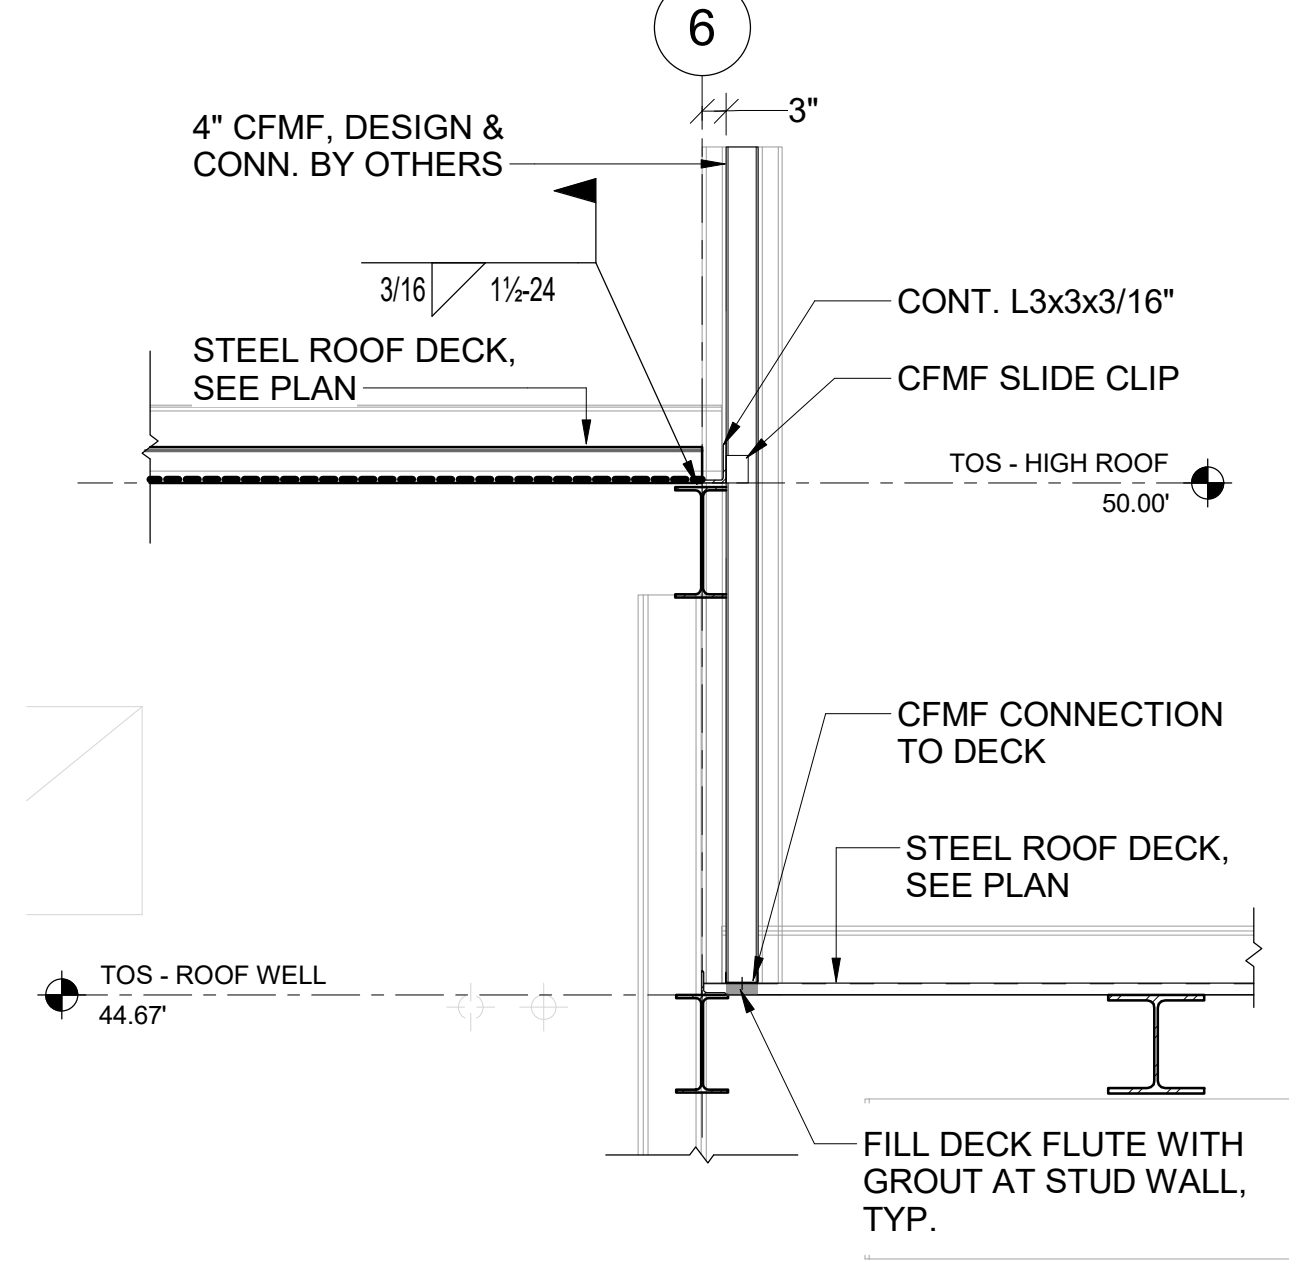


5 WALL SECTION
S4.2 SCALE: 1/2" = 1'-0"

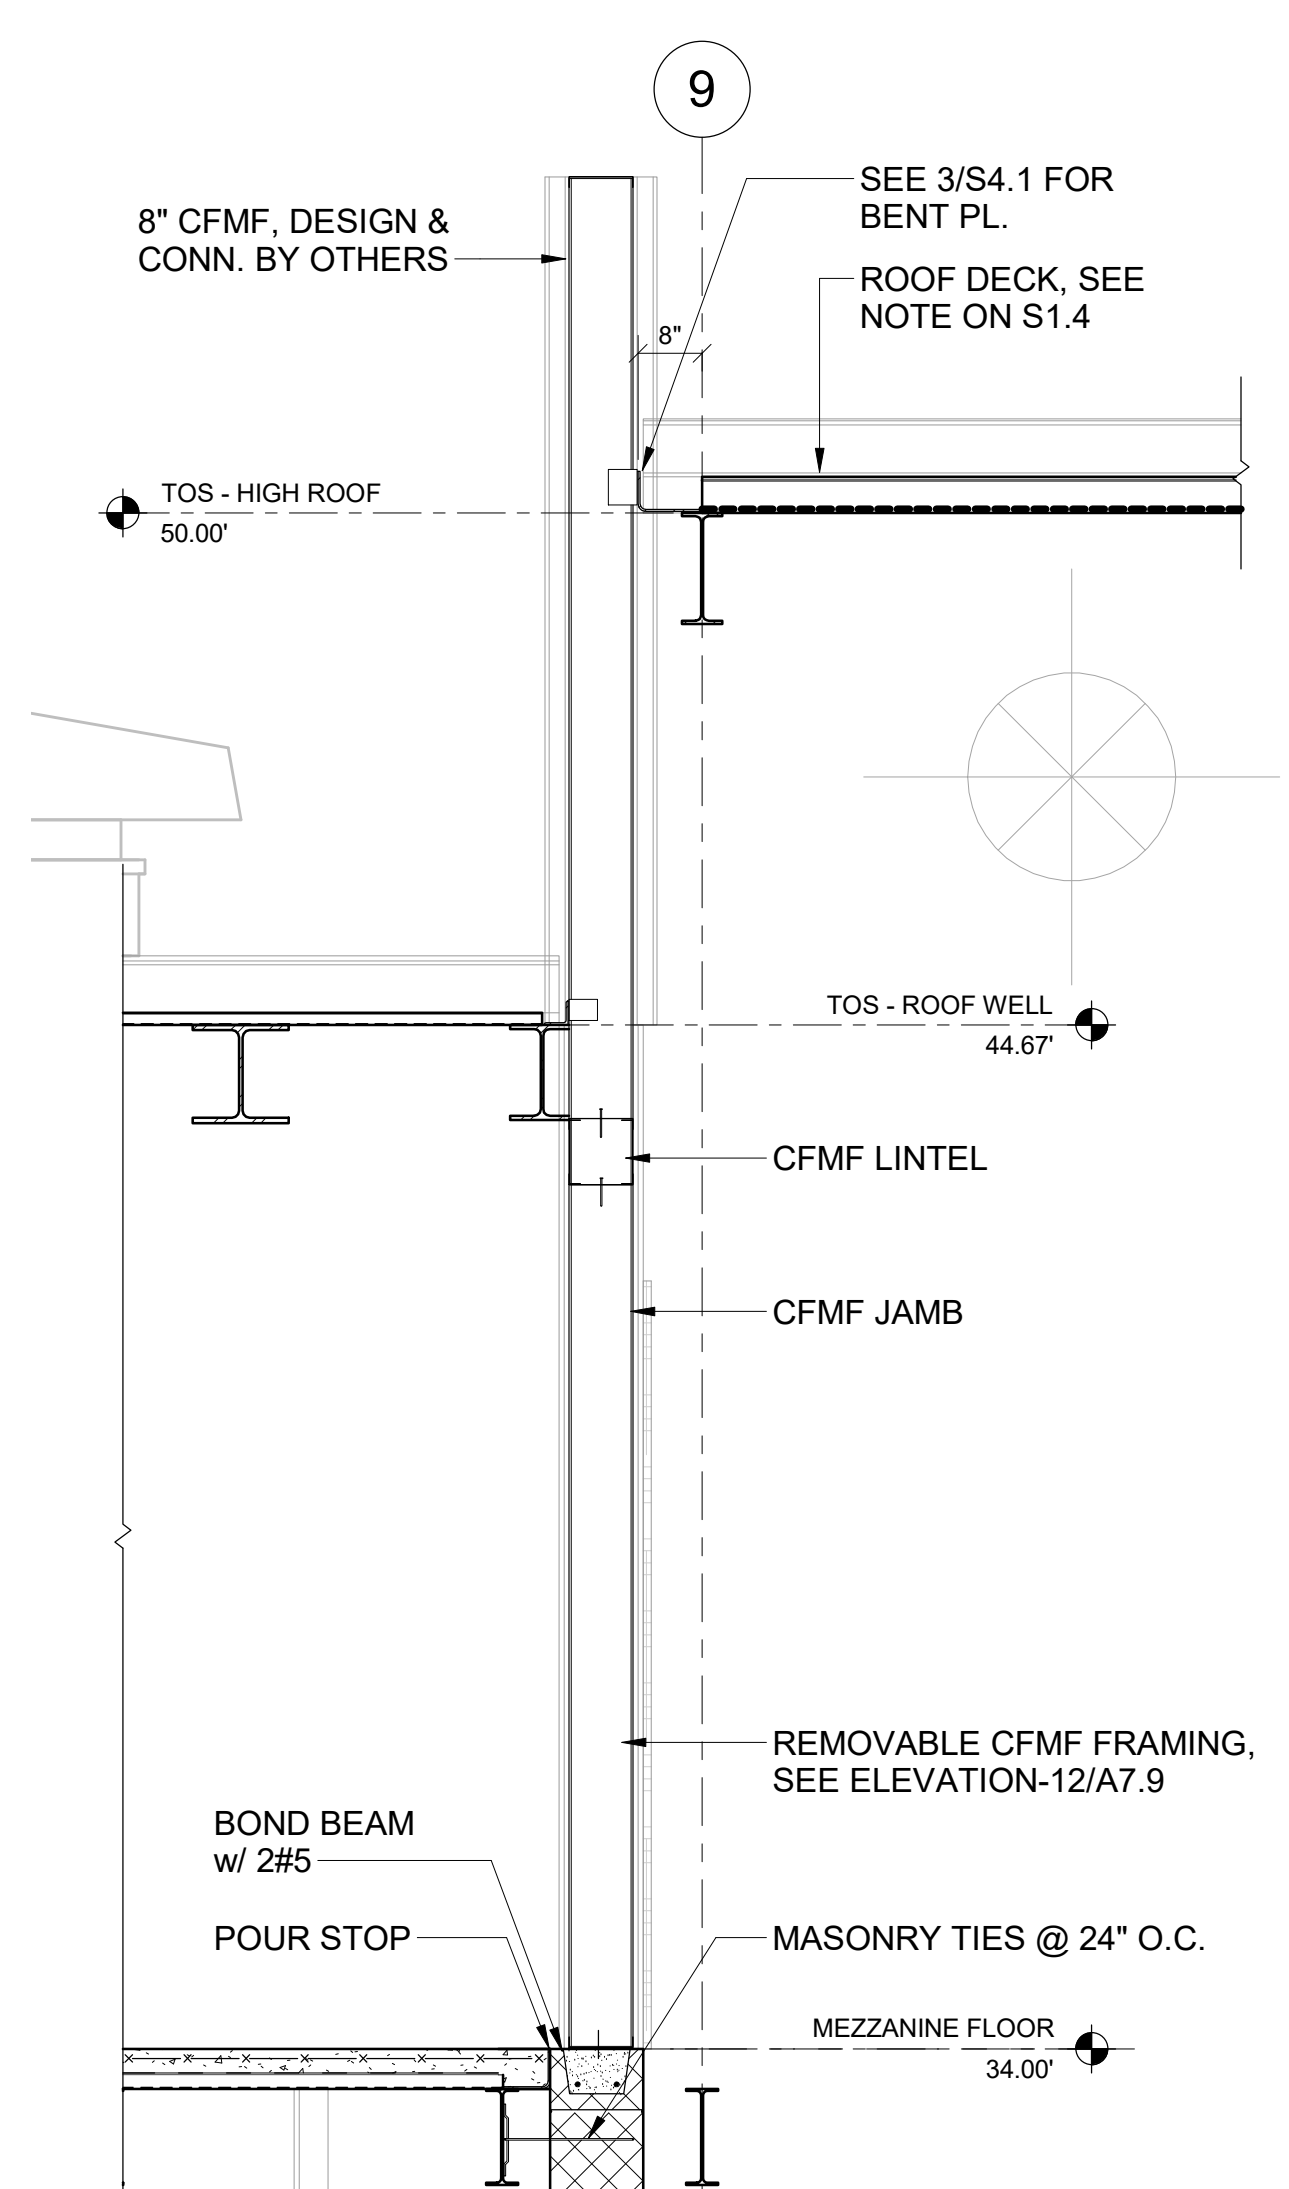

6 WALL SECTION
S4.2 SCALE: 1/2" = 1'-0"

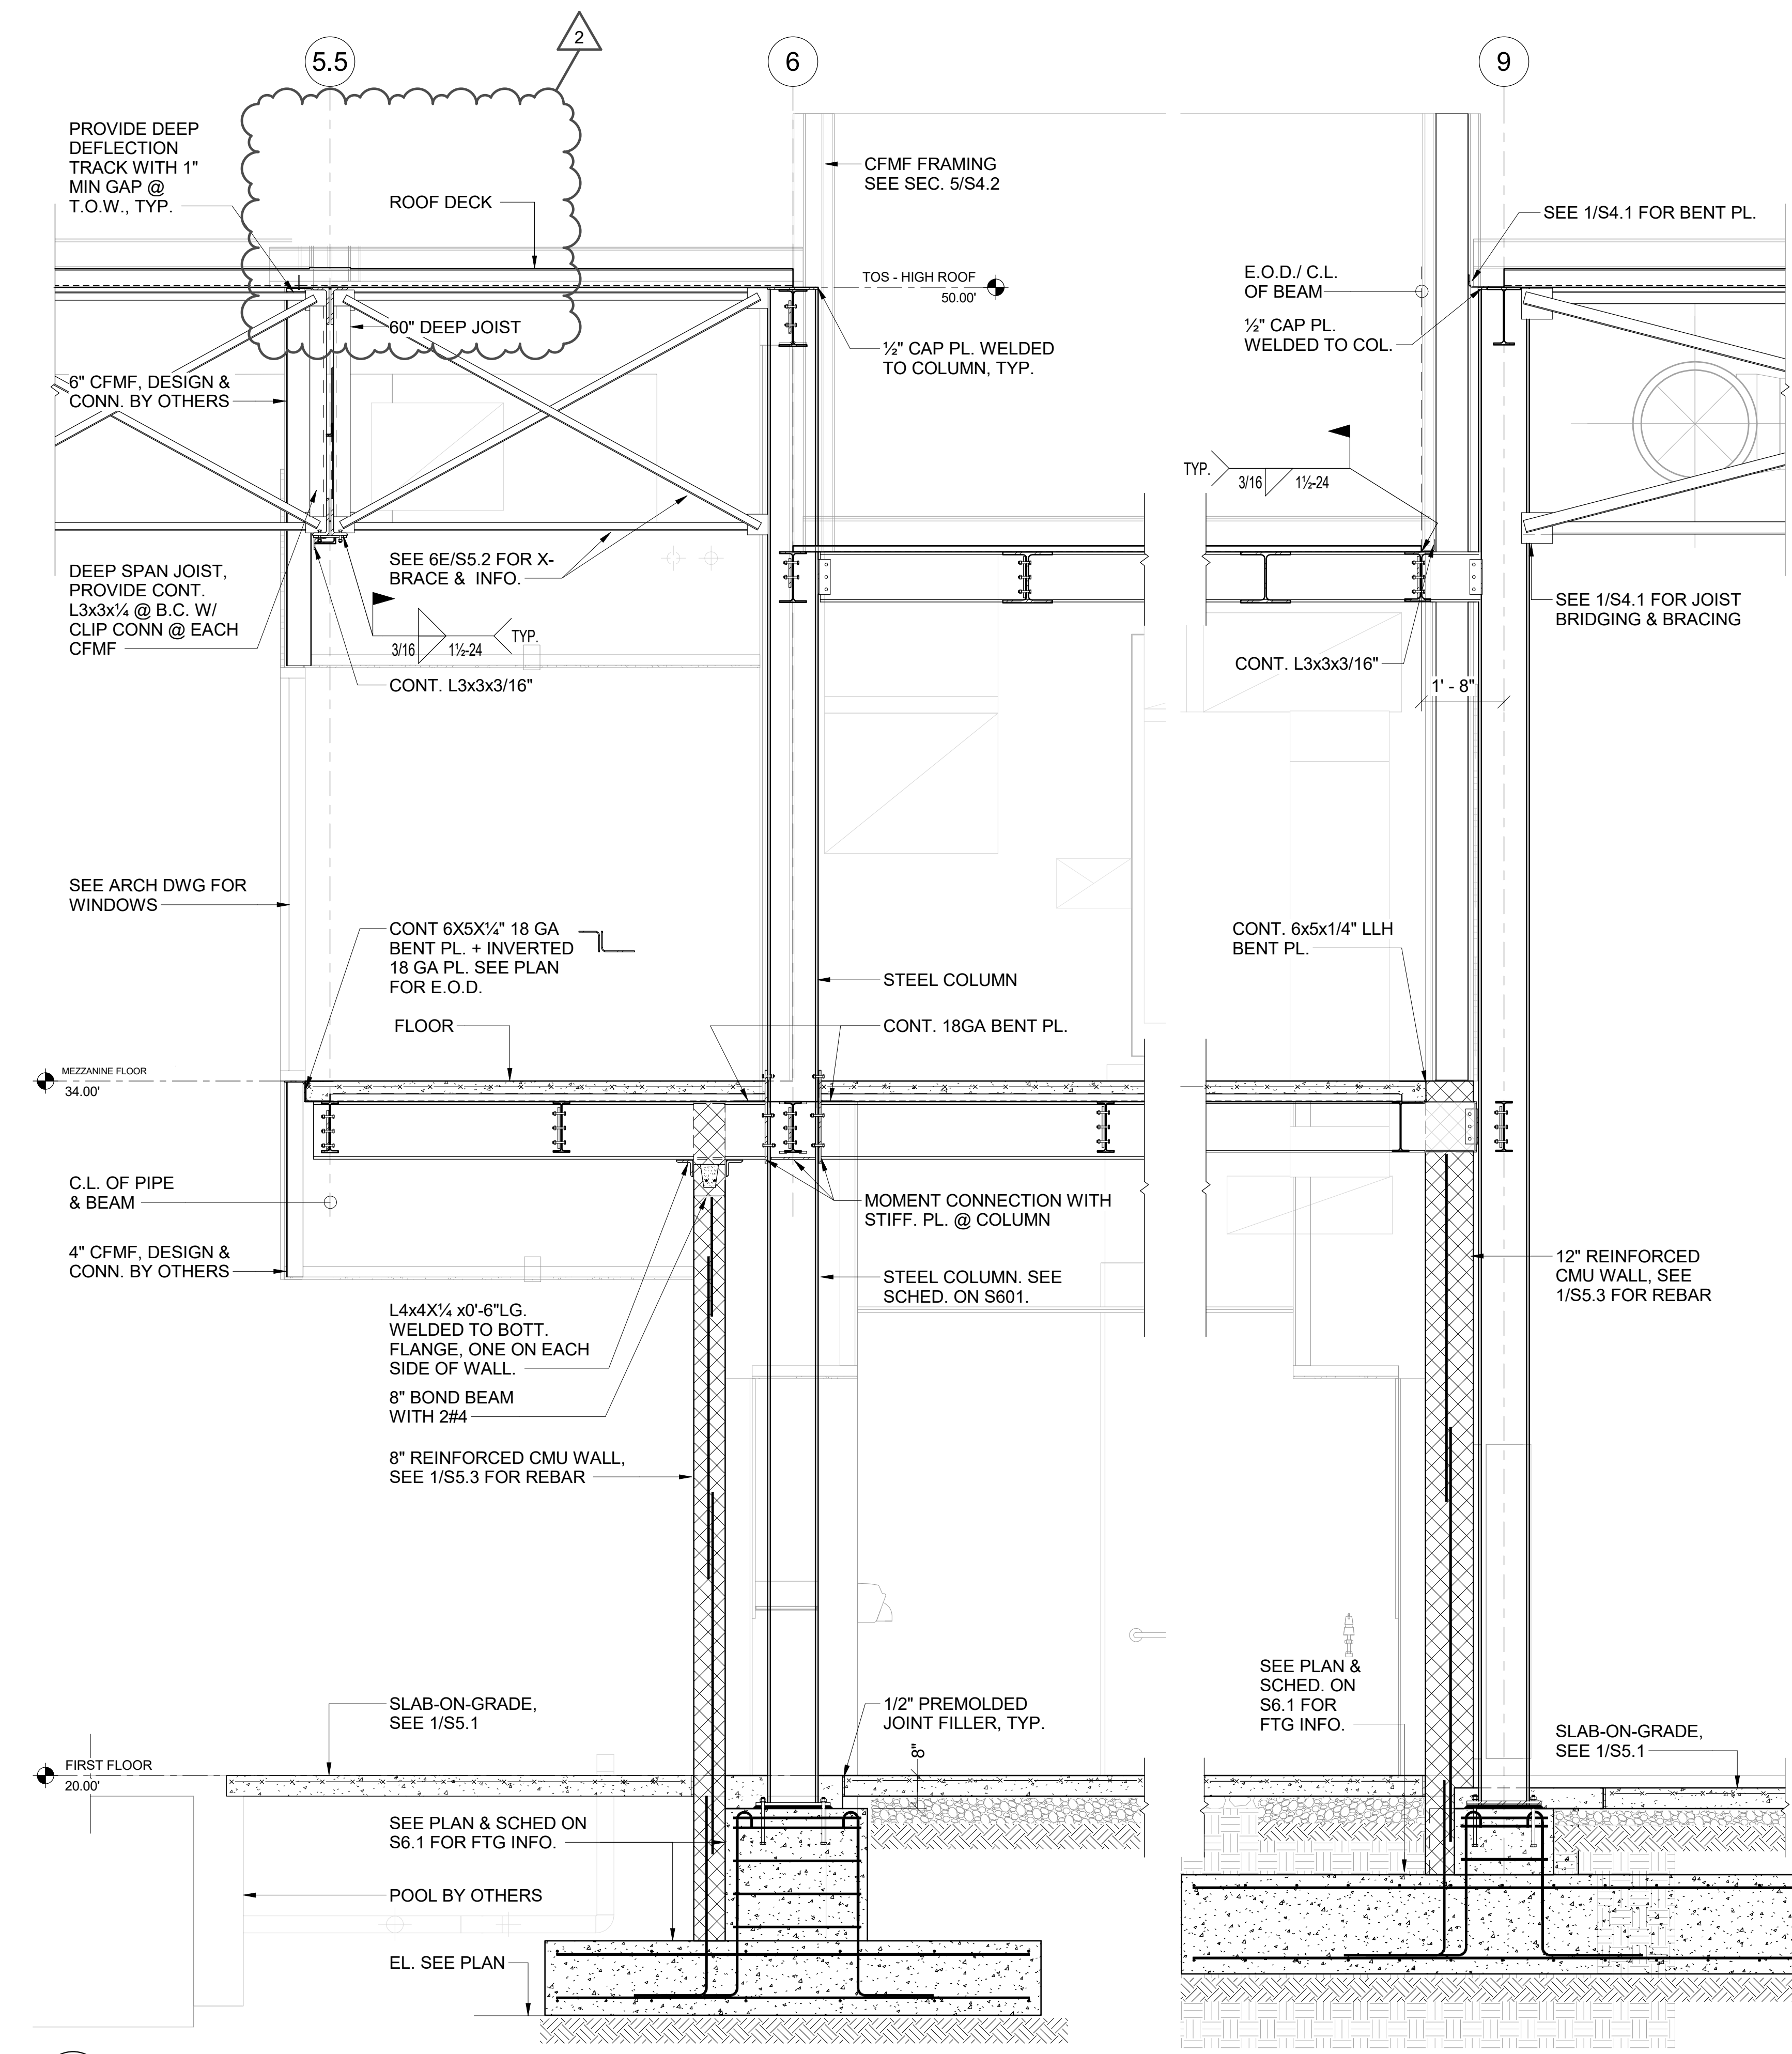


7 WALL SECTION
S4.2 SCALE: 1/2" = 1'-0"

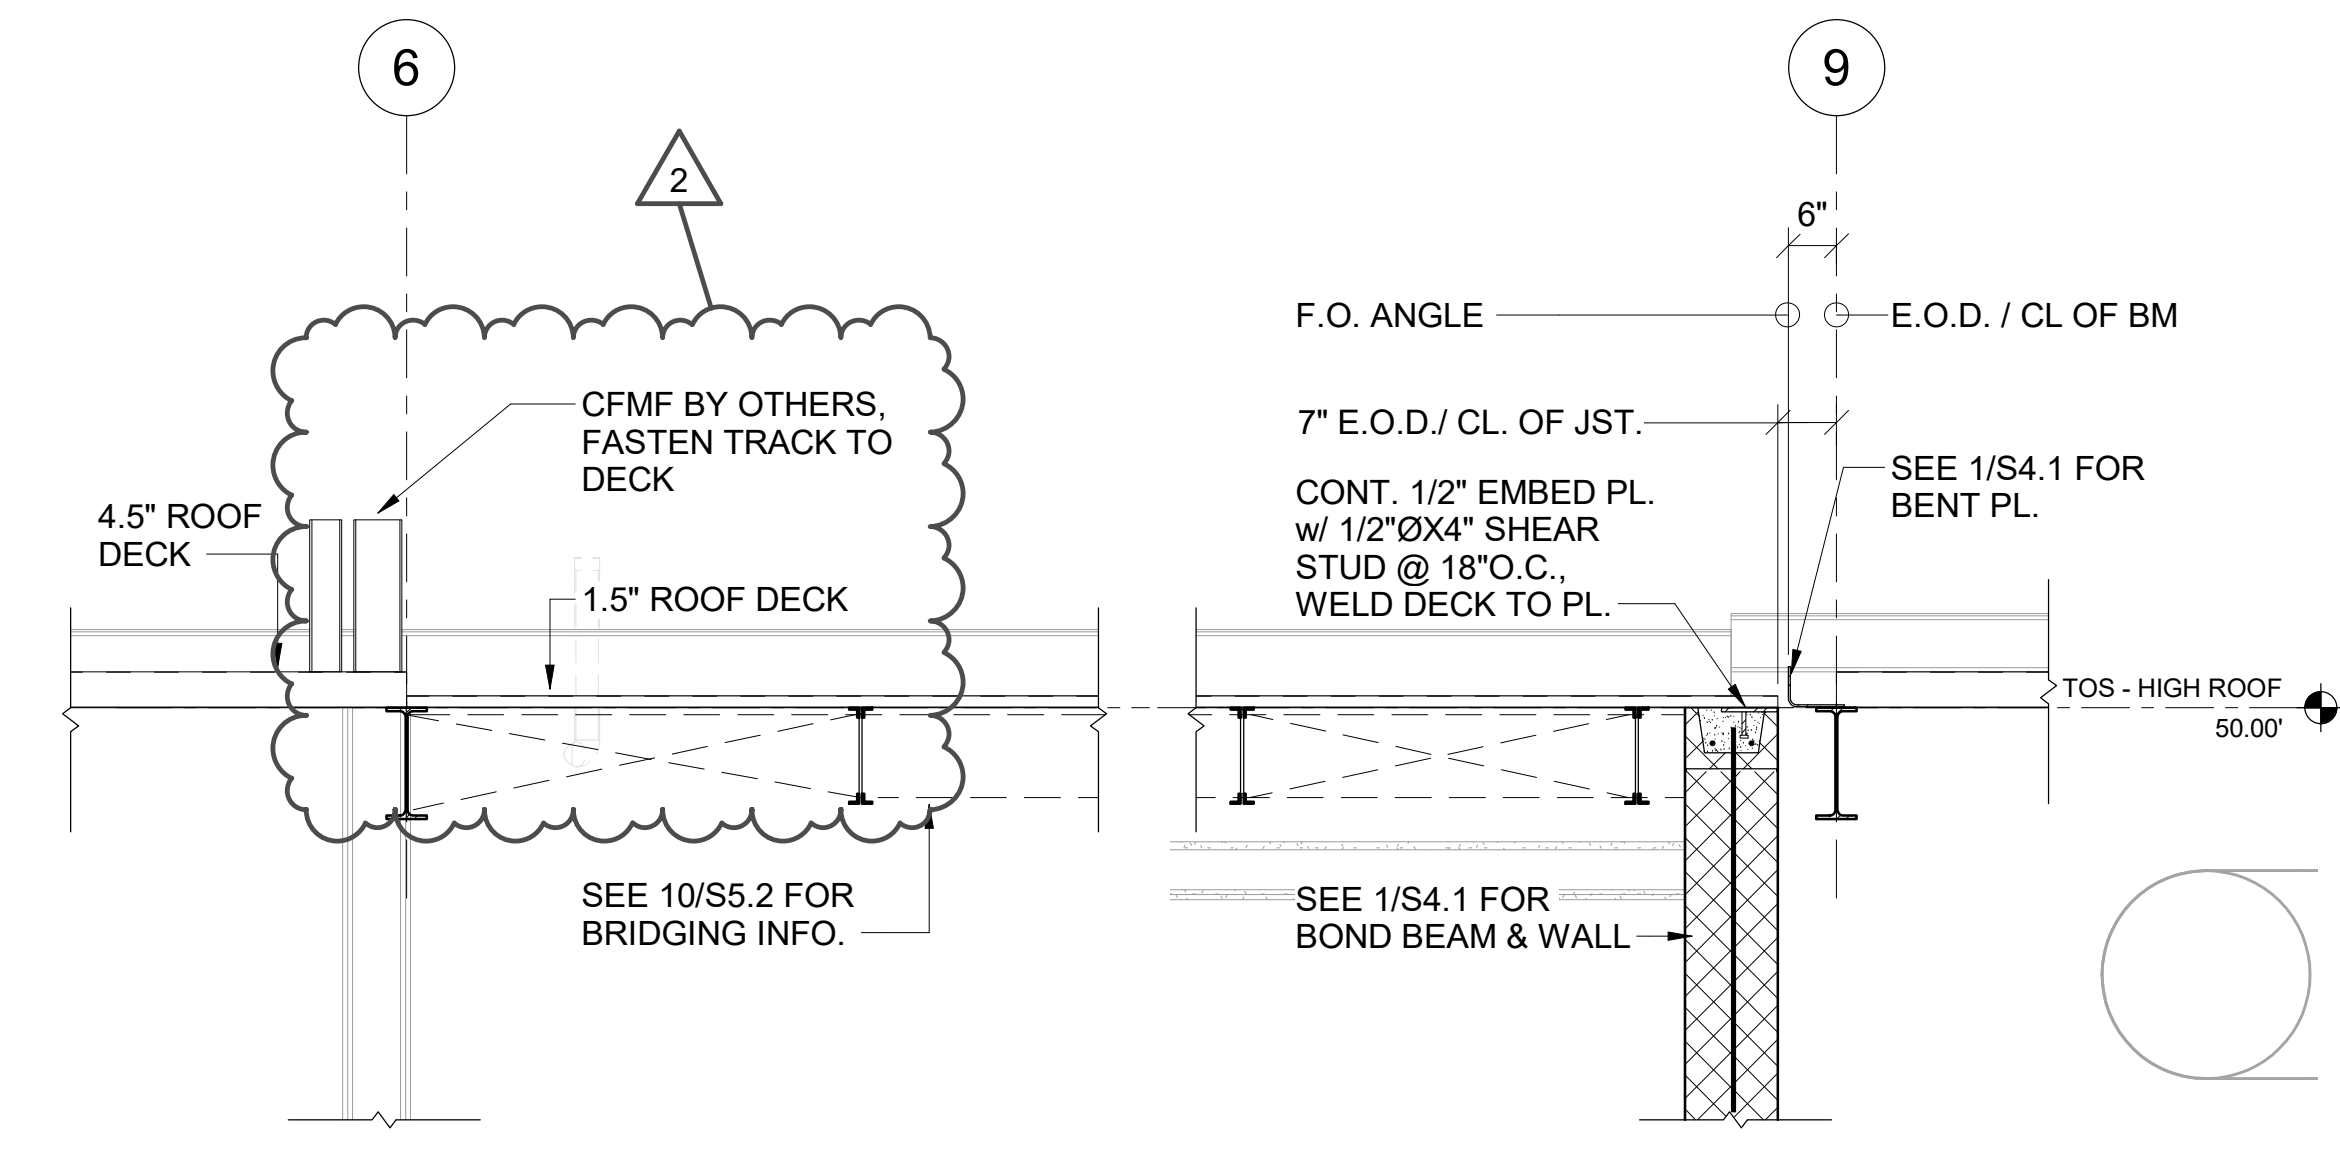

9 WALL SECTION
S4.2 SCALE: 1/2" = 1'-0"

KEY PLAN:

KEYNOTES LISTED ON THIS SHEET ARE FOR CONVENIENCE ONLY. REFER TO SHEET CS.2 FOR COMPLETE LIST

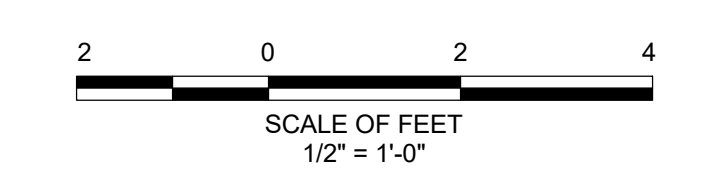

ISSUED FOR BID

F A I
FAISANT ASSOCIATES, INC.
Consulting Structural Engineers

G W O
GW INC.
800 WYMAN PARK DRIVE, SUITE 300
BALTIMORE, MARYLAND 21211, 410-352-1909

I CERTIFY THAT THESE DOCUMENTS WERE PREPARED OR APPROVED BY ME, AND THAT I AM A FULLY LICENSED ENGINEER UNDER THE LAWS OF THE STATE OF MARYLAND. LICENSE NUMBER: 15238, EXPIRATION DATE: 01/15/2021



Revisions:	No.	Date	Description
	2	01/28/2020	ADDENDUM #2

MIDDLE BRANCH FITNESS & WELLNESS CENTER AT CHERRY HILL
BALTIMORE CITY RECREATION & PARKS

Job No.	18010	YP/AM	Drawn
Scale	1/2" = 1'-0"	DR	Checked
Date	11/29/19	ACP	Approved
Drawing Title	WALL SECTIONS		
Drawing Number	S4.2r2		

F-1823

KEY PLAN:

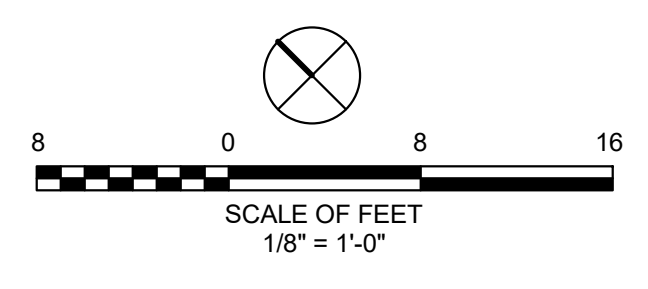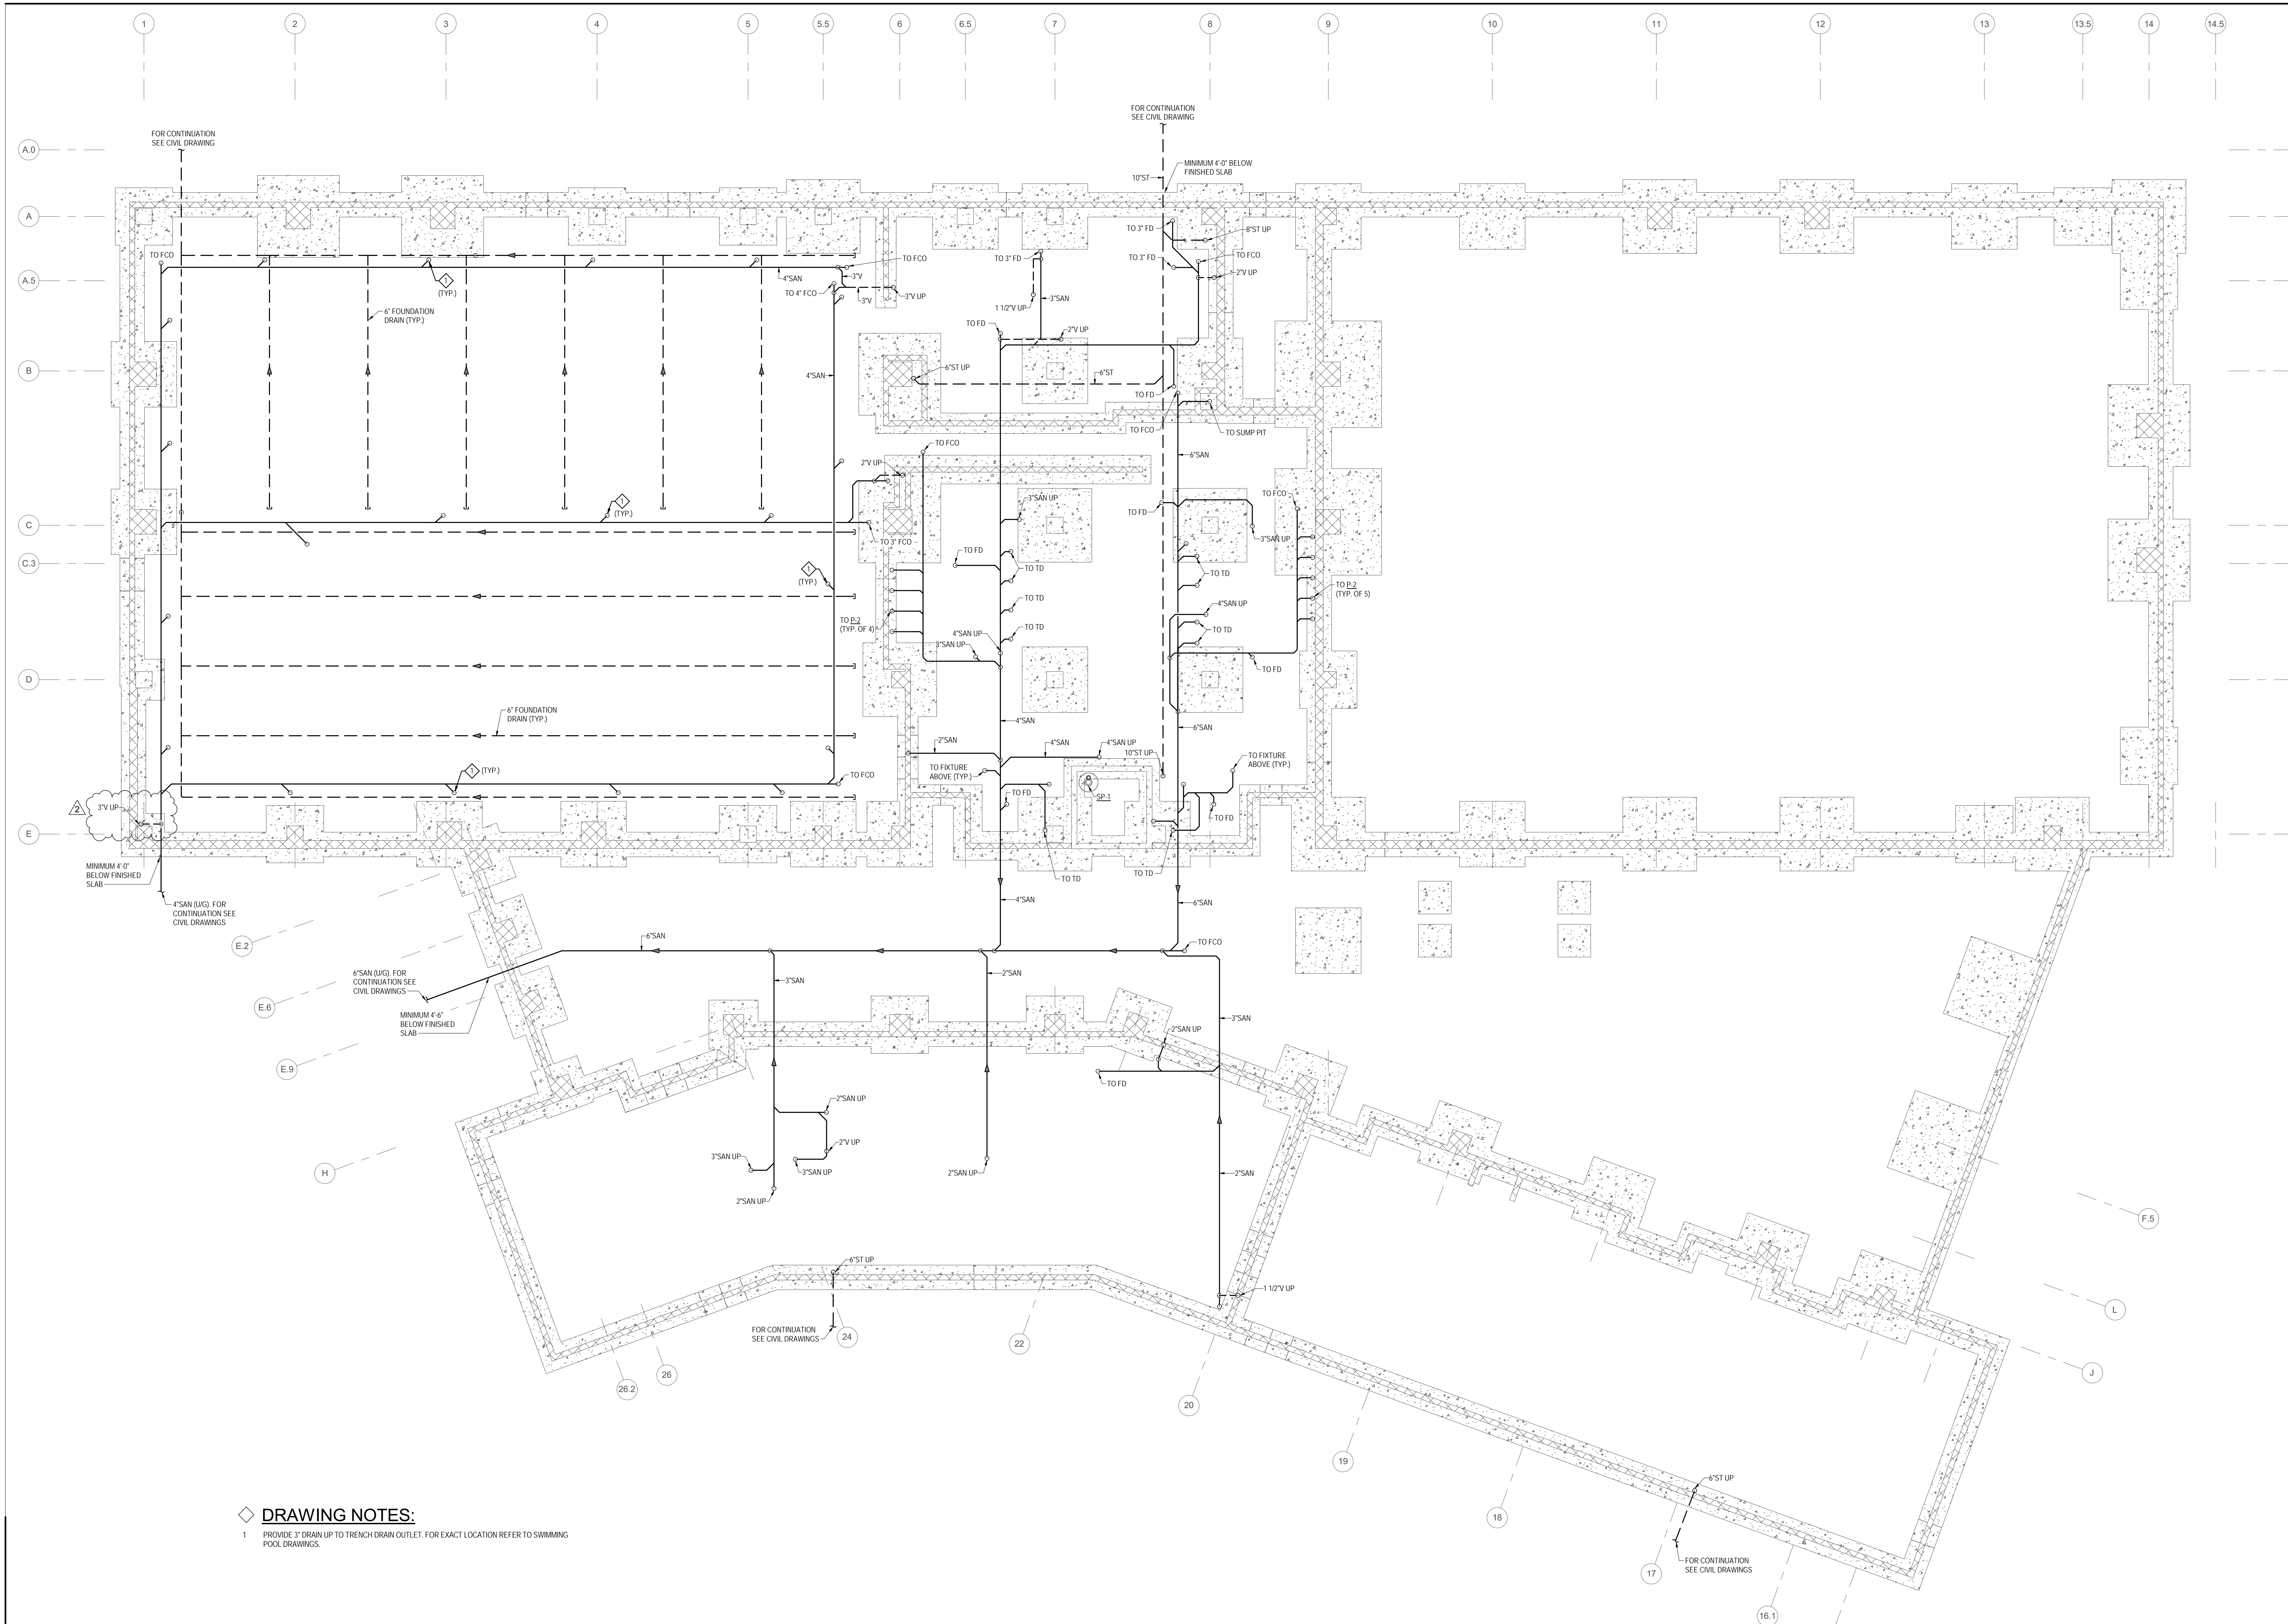

ISSUED FOR BID

- DRAWING NOTES:**
- 1 PROVIDE 3\"/>

1 UNDER SLAB PLAN - SANITARY & VENT
 P1.1 1/8" = 1'-0"

Seal:

MH ENGINEERING, INC.
 10 SUBROCK LN
 Pikesville, Maryland 21081, 410-486-4602

Seal:


G|W|O
 ENGINEERING, INC.
 800 WYMAN PARK DRIVE, SUITE 300
 BALTIMORE, MARYLAND 21211, 410-352-9009

© 2019 GWWO INC.
 I CERTIFY THAT THESE DOCUMENTS WERE PREPARED OR APPROVED BY ME, AND THAT I AM A DAILY LICENSED ENGINEER UNDER THE LAWS OF THE STATE OF MARYLAND. LICENSE NUMBER: XXX-XXXXXX, EXPIRATION DATE XXXX/XXXX/XXXX

Revisions:		
No.	Date	Description
2	01/28/2020	ADDENDUM 2

MIDDLE BRANCH FITNESS & WELLNESS CENTER AT CHERRY HILL			
BALTIMORE CITY RECREATION & PARKS			
Job No.	18010	Author	Drawn
Scale	1/8" = 1'-0"	Checker	Checked
Date	11/29/2019	Approver	Approved
Drawing Title	Drawing Number		
UNDER SLAB PLAN - SANITARY	P1.1r2		
Sheet	Of		


2020-01-27 8:18:33 AM D:\00 Sand Box_L_Rev\18010-MBF-W-Mechanical_mhrevit2.rvt

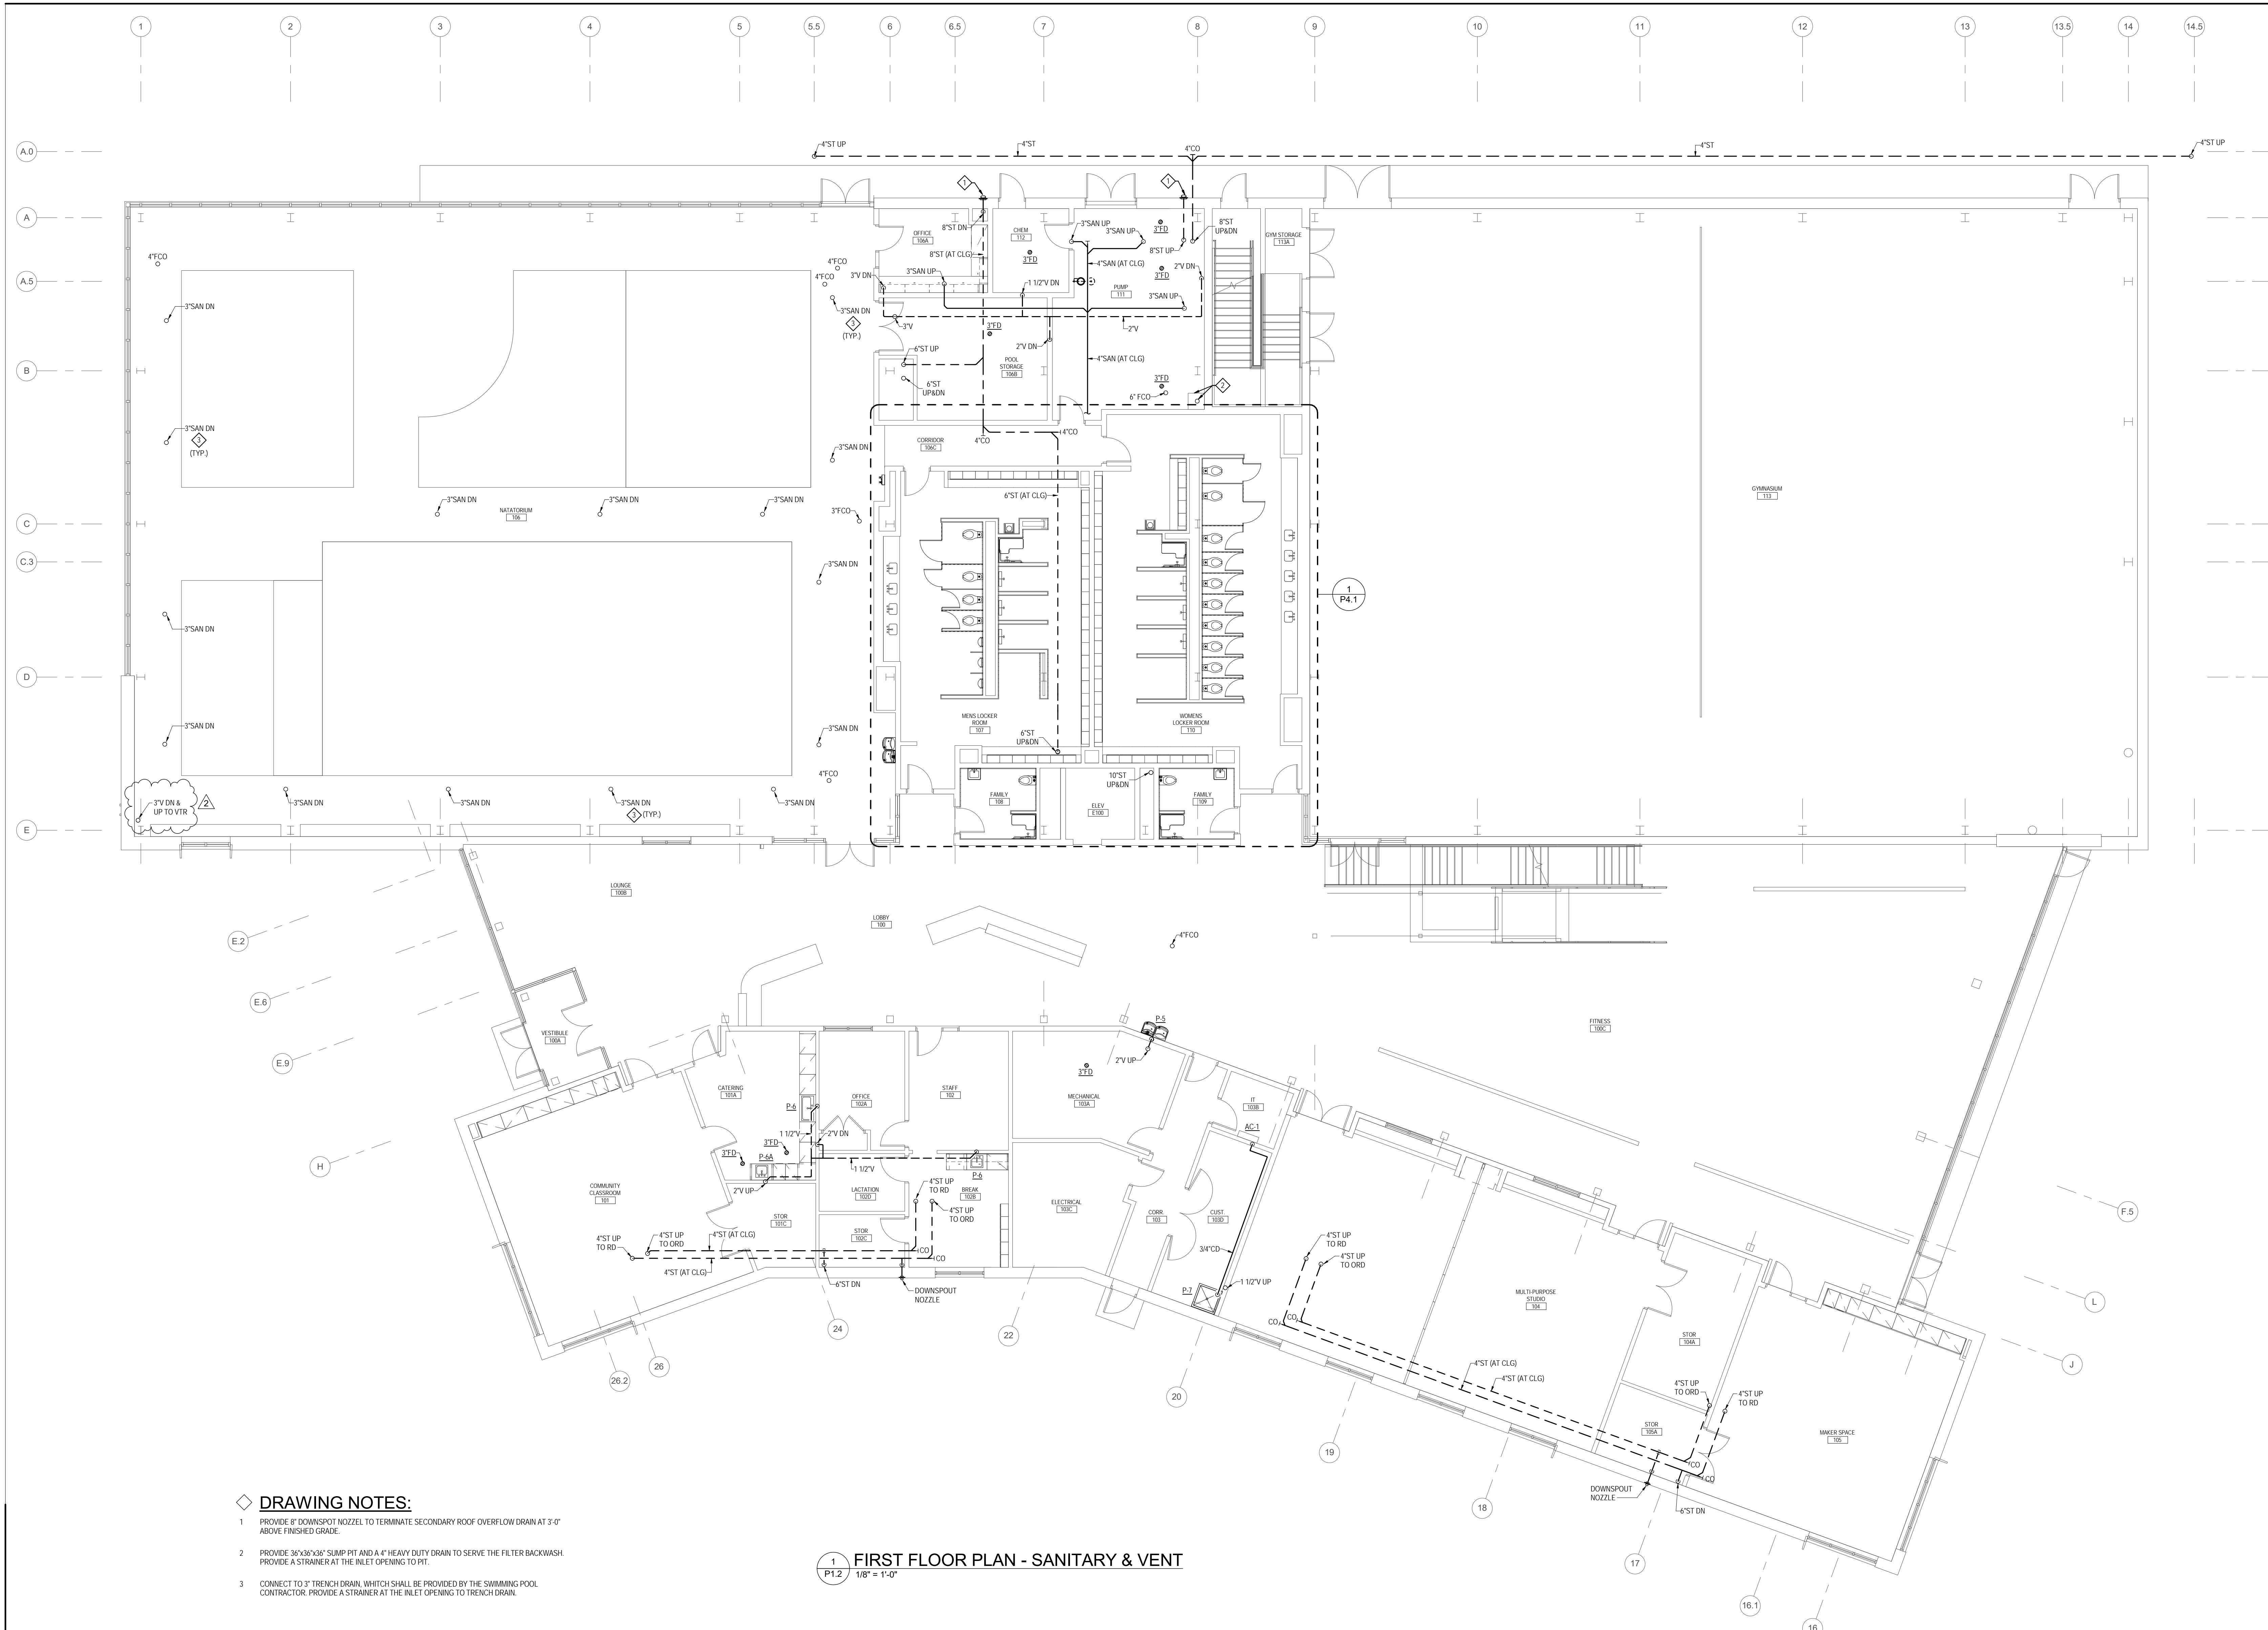

DRAWING NOTES:

1. PROVIDE 8" DOWNSPOUT NOZZEL TO TERMINATE SECONDARY ROOF OVERFLOW DRAIN AT 3'-0" ABOVE FINISHED GRADE.
2. PROVIDE 30"x30"x3" SLUMP PIT AND A 4" HEAVY DUTY DRAIN TO SERVE THE FILTER BACKWASH. PROVIDE A STRAINER AT THE INLET OPENING TO PIT.
3. CONNECT TO 3" TRENCH DRAIN, WHICH SHALL BE PROVIDED BY THE SWIMMING POOL CONTRACTOR. PROVIDE A STRAINER AT THE INLET OPENING TO TRENCH DRAIN.


1 FIRST FLOOR PLAN - SANITARY & VENT
1/8" = 1'-0"

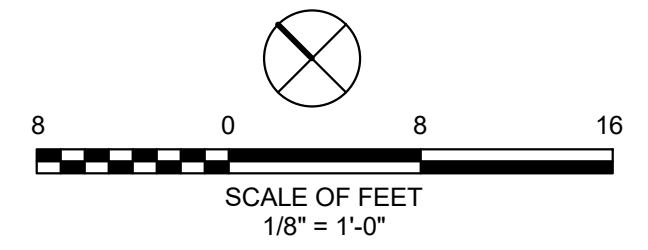

ISSUED FOR BID



MHN ENGINEERING, INC.
10 SUDBROOK LN
Pikesville, Maryland 21086, 410-486-4602

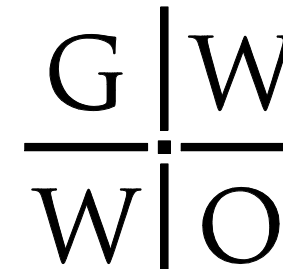

G|W|O ENGINEERING, INC.
800 WYMAN PARK DRIVE, SUITE 300
BALTIMORE, MARYLAND 21211, 410-322-9009

© 2019 G|W|O INC.

I CERTIFY THAT THESE DOCUMENTS WERE PREPARED OR APPROVED BY ME, AND THAT I AM A DULY LICENSED ENGINEER UNDER THE LAWS OF THE STATE OF MARYLAND. LICENSE NUMBER: XXX-XXXXXX, EXPIRATION DATE: XXXXX/XXXXXX

No.	Date	Description
2	01/28/2020	ADDENDUM 2

MIDDLE BRANCH FITNESS & WELLNESS CENTER AT CHERRY HILL

BALTIMORE CITY RECREATION & PARKS



Job No.	18010	GK	Drawn
Scale	1/8" = 1'-0"	BE	Checked
Date	11/29/2019	SM	Approved

Drawing Title Drawing Number


FIRST FLOOR PLAN - SANITARY AND VENT **P1.2r2**

Sheet **OF**

KEY PLAN:

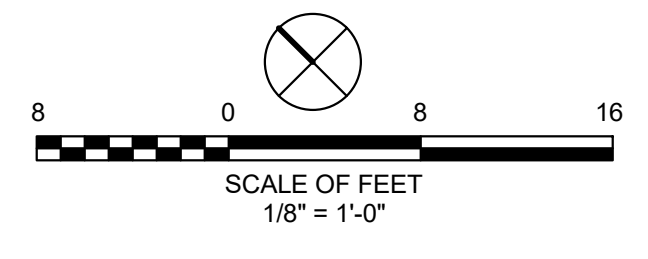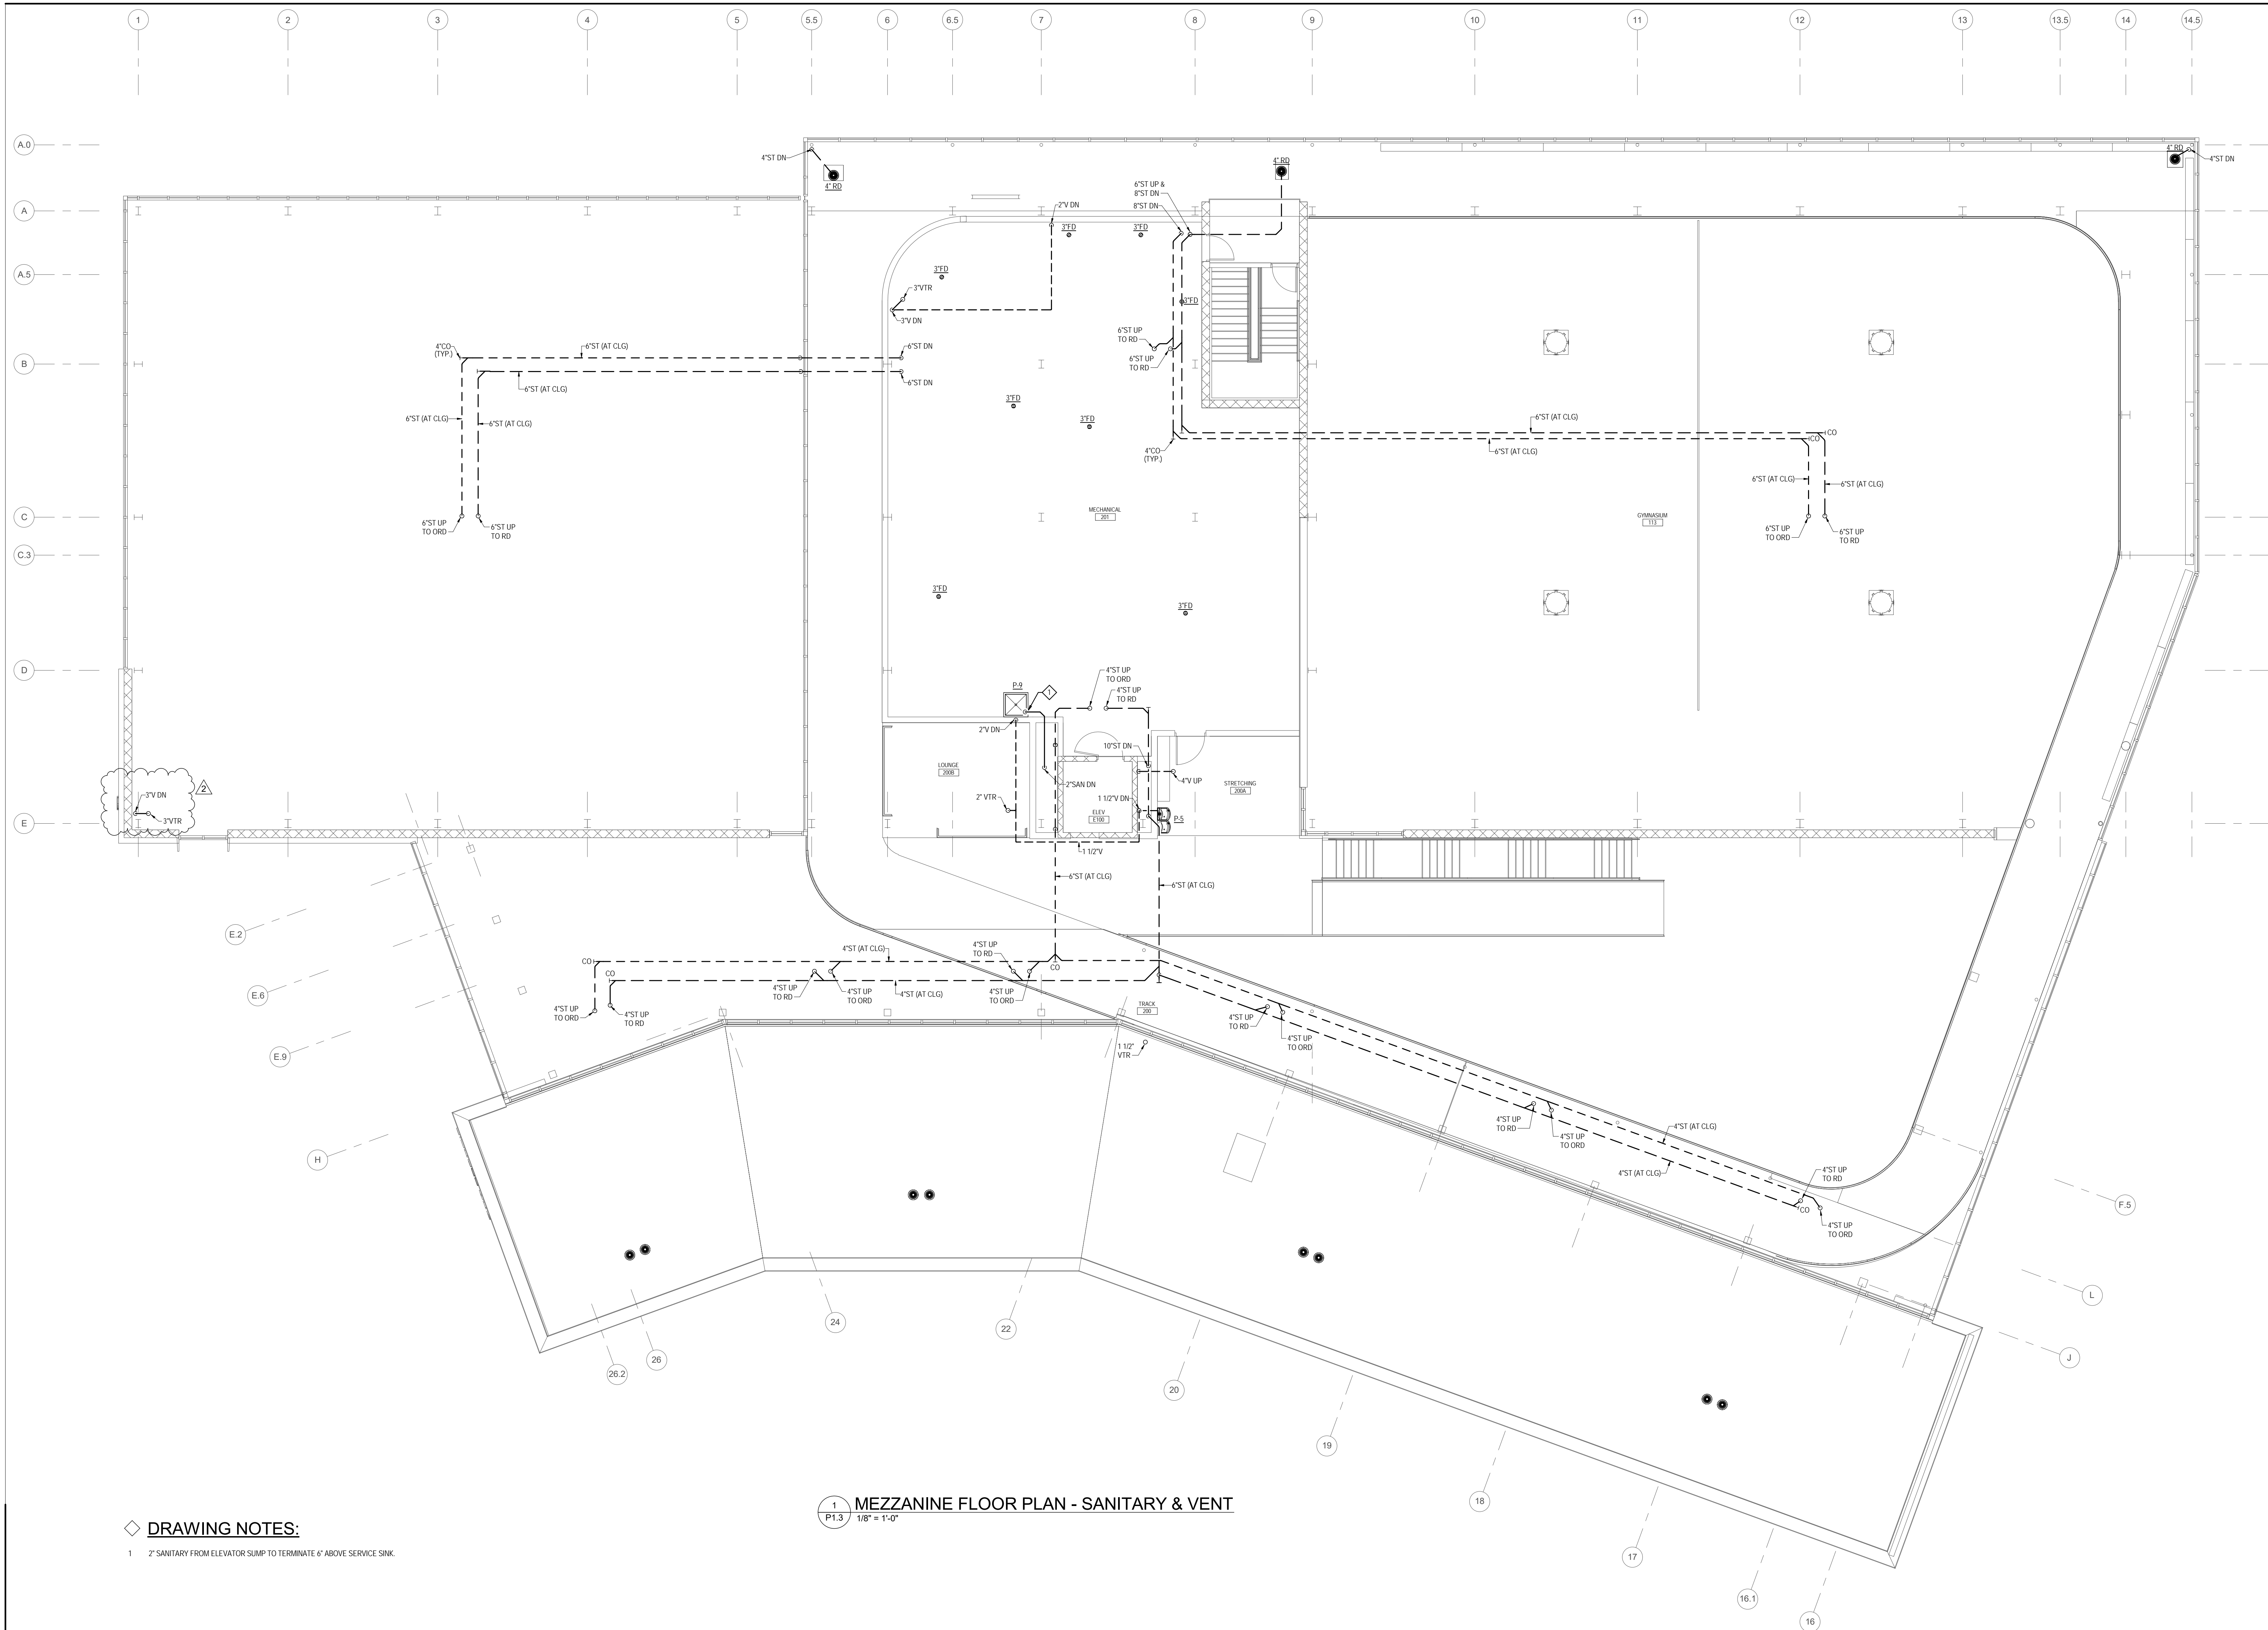

ISSUED FOR BID

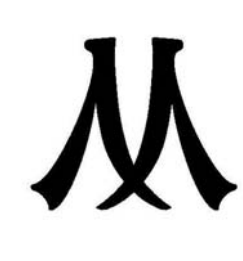

MHN ENGINEERING, INC.
 10 SUDBROOK LN
 Pikesville, Maryland 21086, 410-486-4602



GW/O INC.
 800 WYMAN PARK DRIVE, SUITE 300
 BALTIMORE, MARYLAND 21211, 410-352-9009

© 2019 GW/O INC.

I CERTIFY THAT THESE DOCUMENTS WERE PREPARED OR APPROVED BY ME, AND THAT I AM A DULY LICENSED ENGINEER UNDER THE LAWS OF THE STATE OF MARYLAND. LICENSE NUMBER: XXX-XXXXXX, EXPIRATION DATE: XXXX/XXXX/XXXX

No.	Date	Description
2	01/28/2020	ADDENDUM 2

MIDDLE BRANCH FITNESS & WELLNESS CENTER AT CHERRY HILL
 BALTIMORE CITY RECREATION & PARKS

Job No.	18010	GK	Drawn
Scale	1/8" = 1'-0"	BE	Checked
Date	11/29/2019	SM	Approved

Drawing Title: MEZZANINE FLOOR PLAN - SANITARY AND VENT
 Drawing Number: P1.3r2

Sheet: Of

1 MEZZANINE FLOOR PLAN - SANITARY & VENT
 1/8" = 1'-0"



DRAWING NOTES:

- 1 2" SANITARY FROM ELEVATOR SUMP TO TERMINATE 6" ABOVE SERVICE SINK.

D:\00 Sand Box_L_Rev\18010-MBF-W-Mechanical_mhrevit2.rvt

2020-01-27 9:18:49 AM


KEY PLAN:

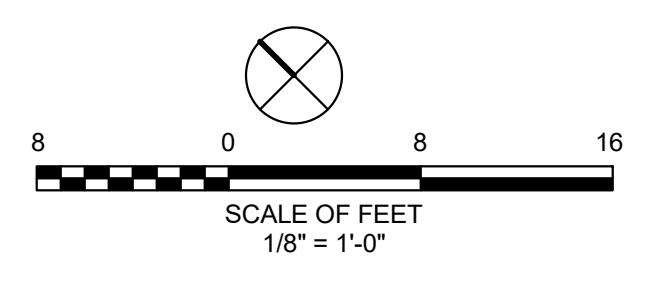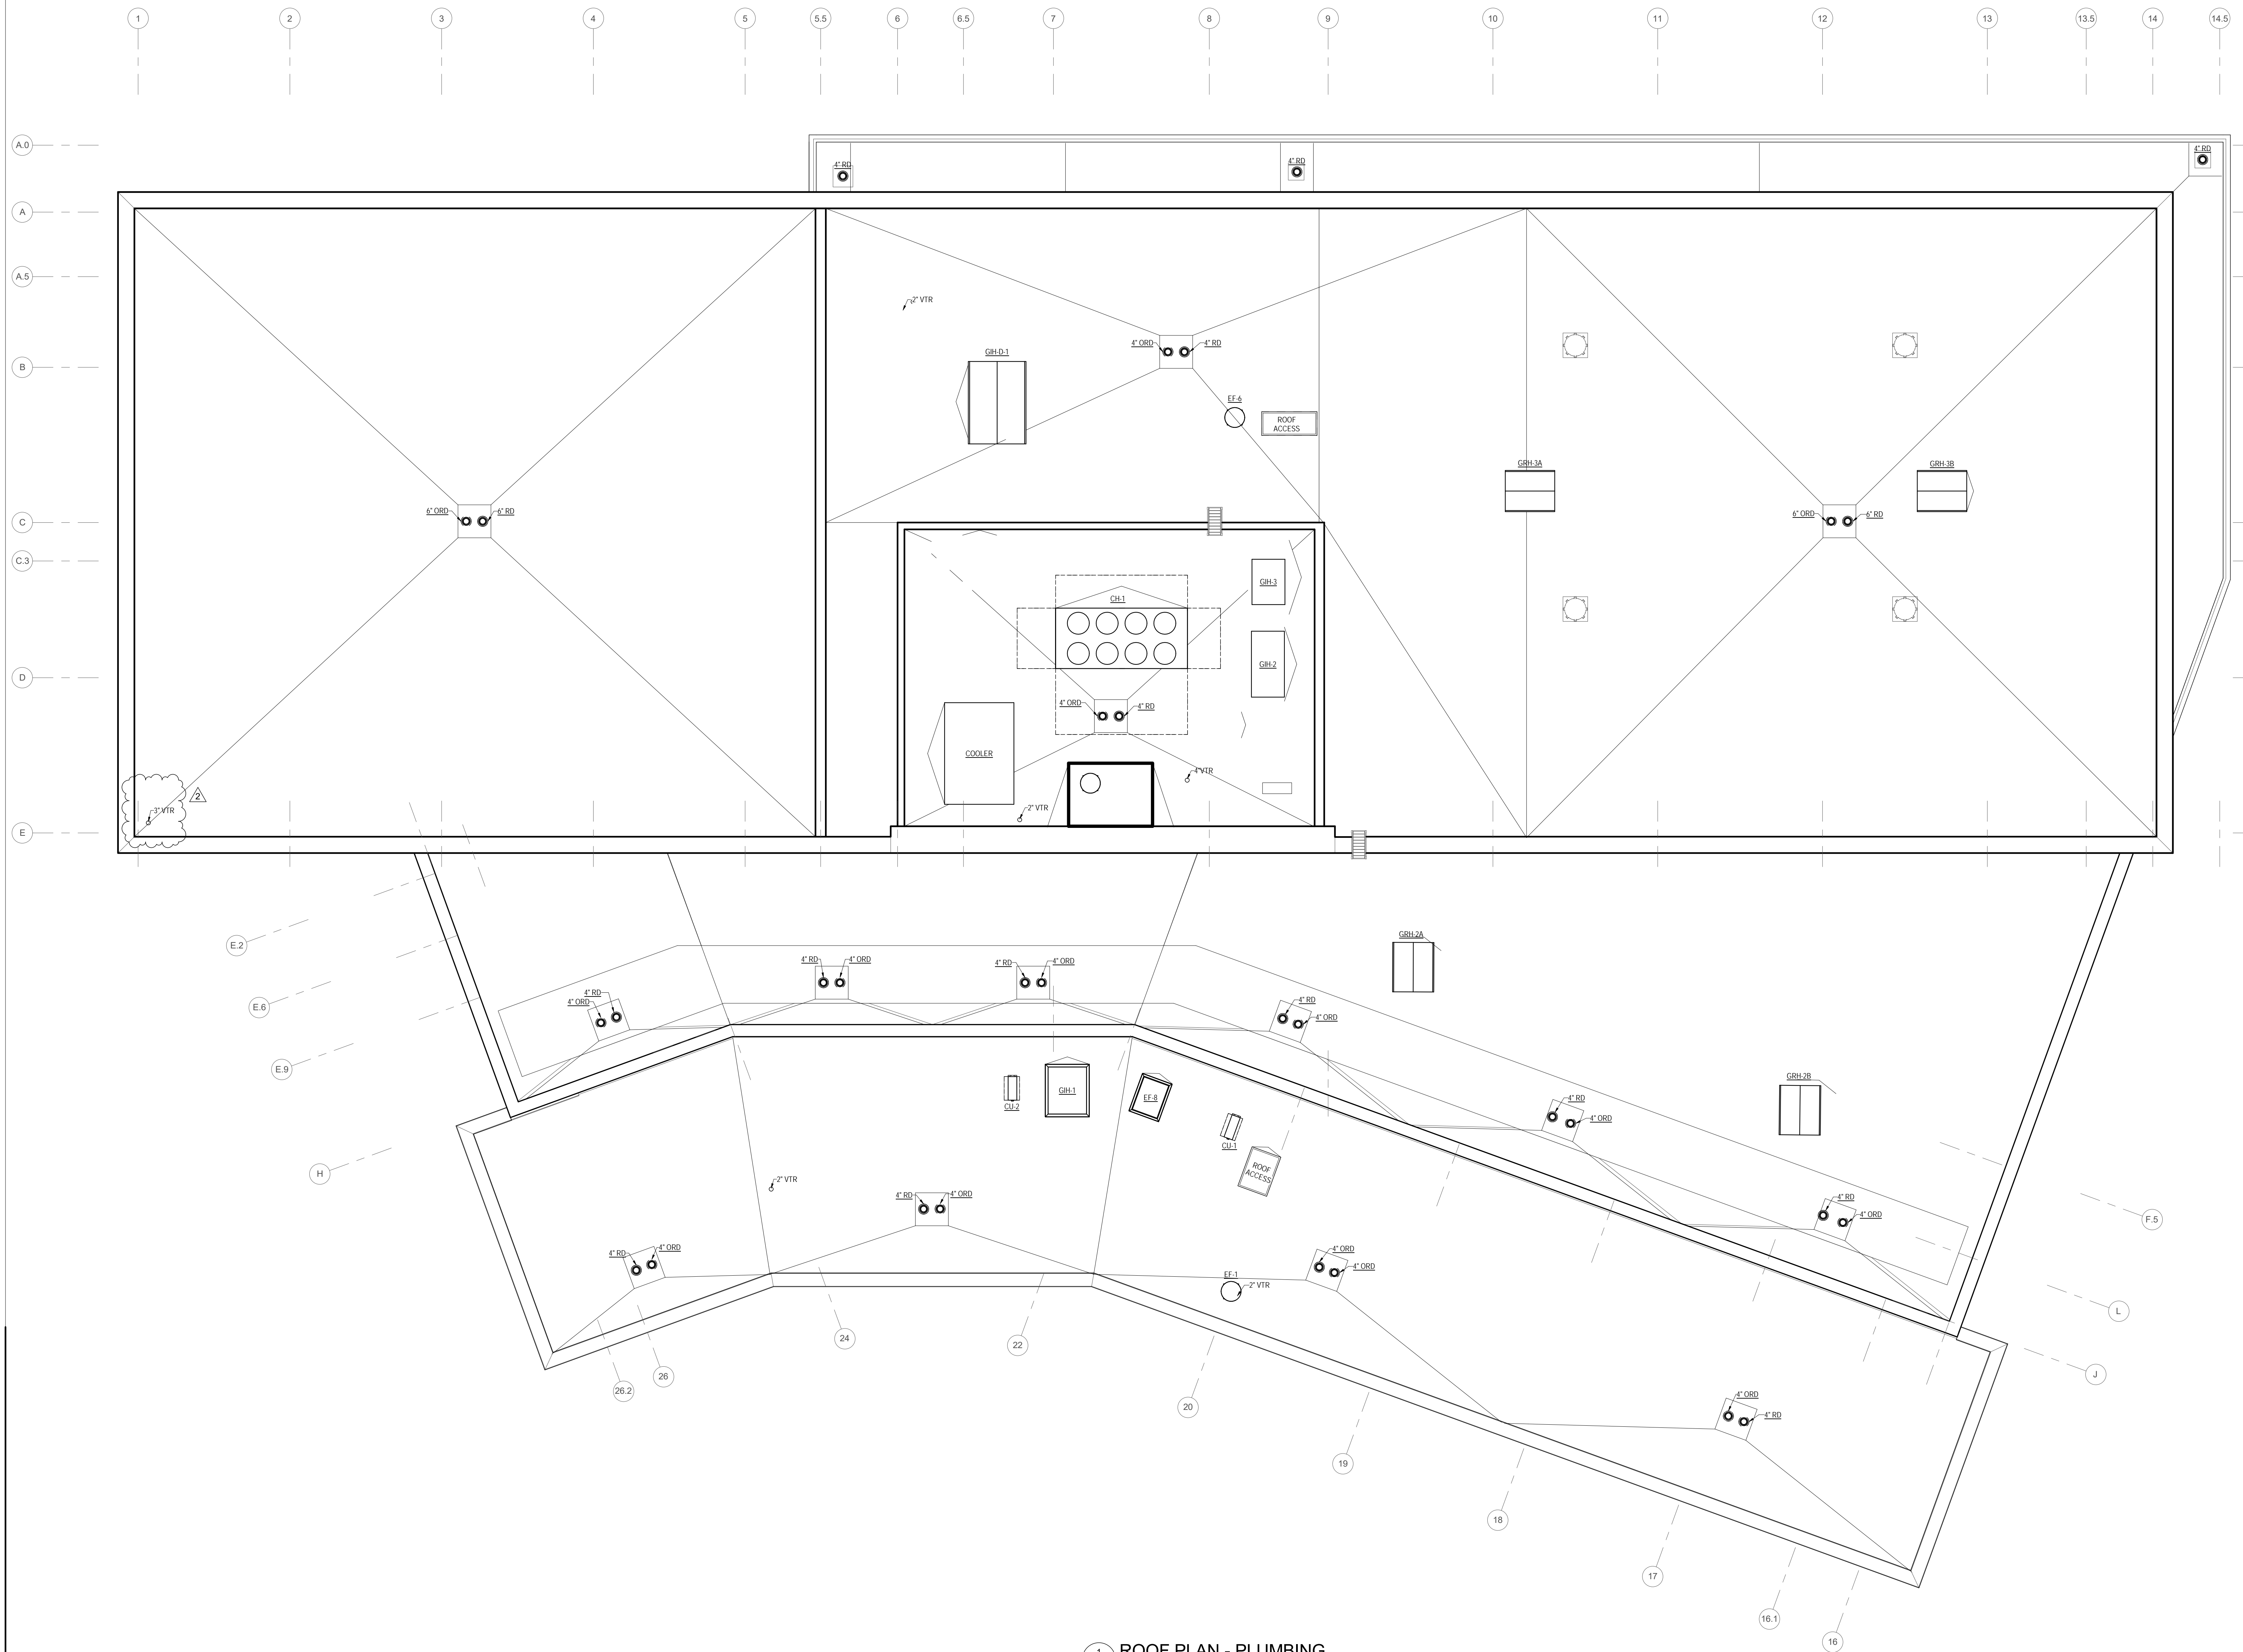

ISSUED FOR BID



M ENGINEERING, INC.
 10 SUBROCK LN
 Pikesville, Maryland 21086-4602

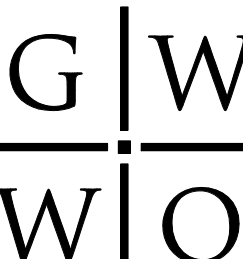

G|W|O ENGINEERING, INC.
 800 WYMAN PARK DRIVE, SUITE 300
 BALTIMORE, MARYLAND 21211, 410-352-9009

© 2019 GWWO INC.
 I CERTIFY THAT THESE DOCUMENTS WERE PREPARED OR APPROVED BY ME, AND THAT I AM A FULLY LICENSED ENGINEER UNDER THE LAWS OF THE STATE OF MARYLAND. LICENSE NUMBER XXX-XXXXXX, EXPIRATION DATE XXXX/XXXXXX

Revisions:		
No.	Date	Description
2	01/28/2020	ADDENDUM 2

MIDDLE BRANCH FITNESS & WELLNESS CENTER AT CHERRY HILL
 BALTIMORE CITY RECREATION & PARKS


Job No.	18010	Author	Drawn
Scale	1/8" = 1'-0"	Checker	Checked
Date	11/29/2019	Approver	Approved
Drawing Title	Drawing Number		

ROOF PLAN - PLUMBING **P1.6r2**


1 ROOF PLAN - PLUMBING
 1/8" = 1'-0"

D:\00 Sand Box_L_Rev\18010-MBF-W-Mechanical_minrevit2.rvt

2020-01-27 9:18:56 AM

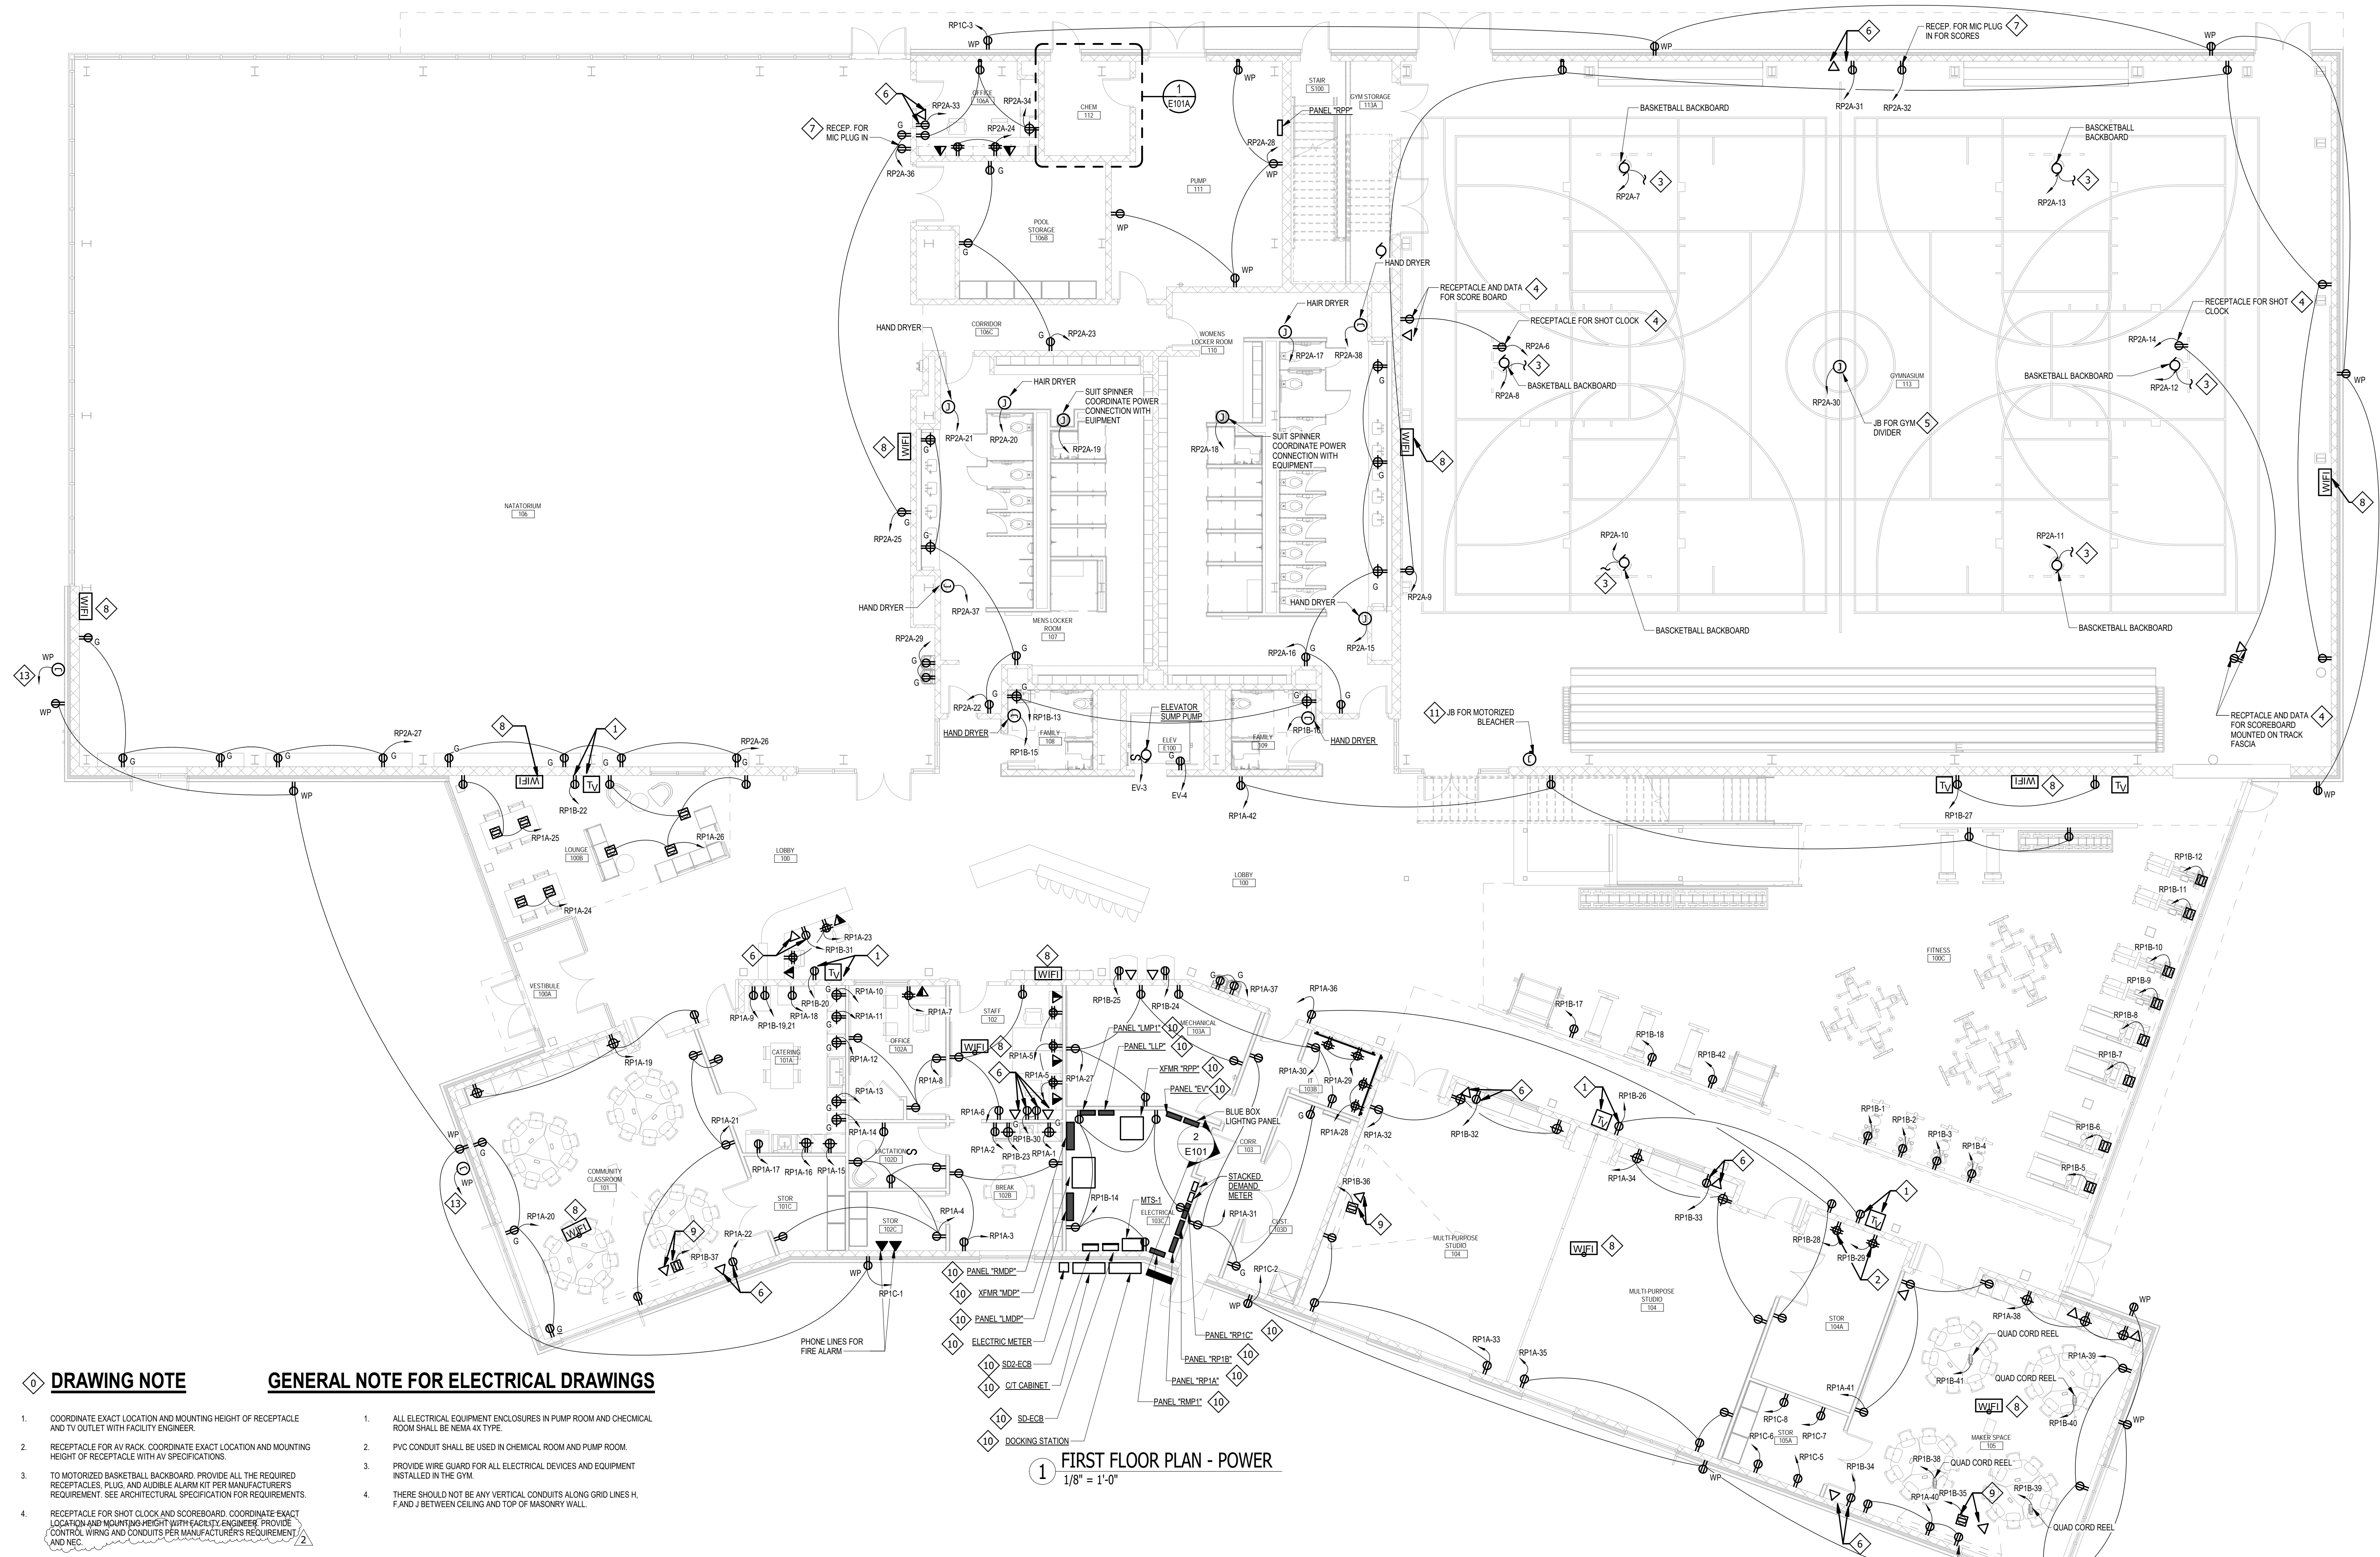

1 FIRST FLOOR PLAN - POWER
1/8" = 1'-0"

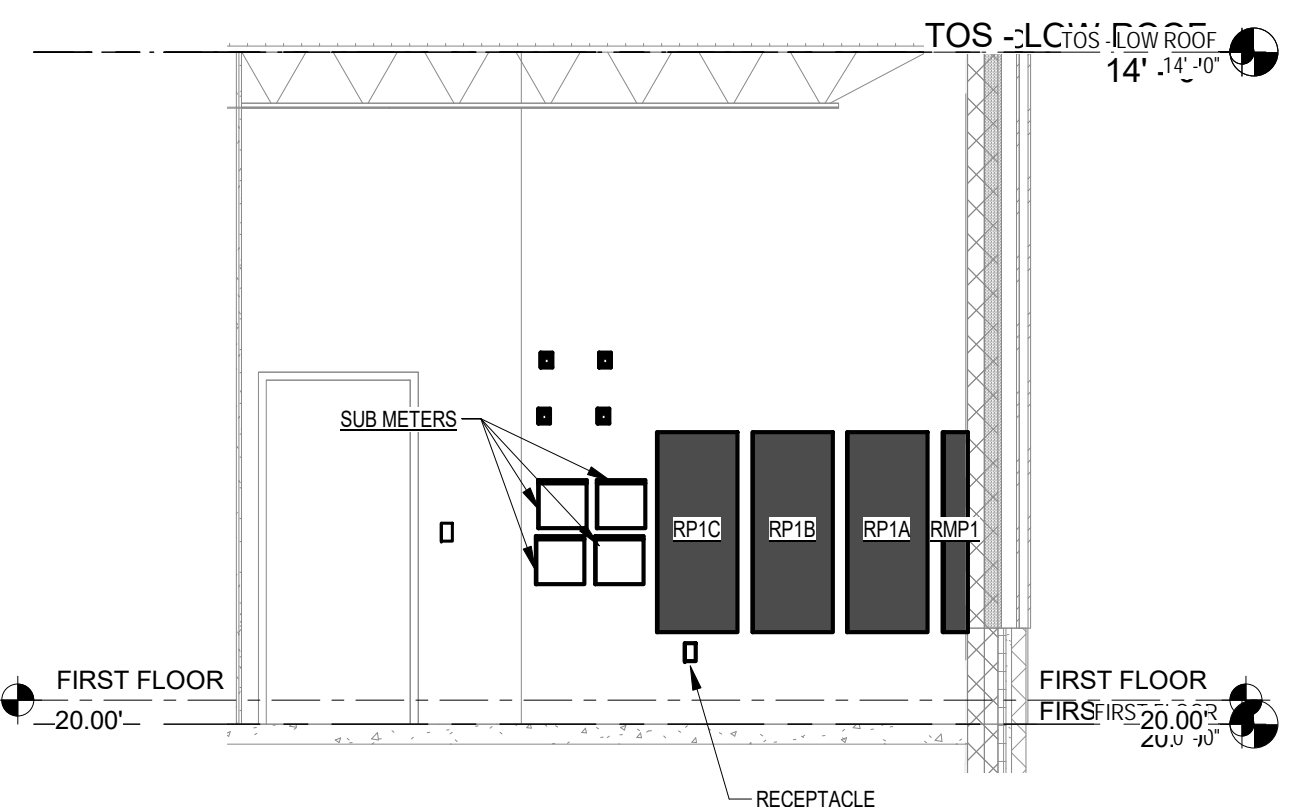

2 ELECTRICAL ROOM SECTION
1/4" = 1'-0"

DRAWING NOTE


- COORDINATE EXACT LOCATION AND MOUNTING HEIGHT OF RECEPTACLE AND TV OUTLET WITH FACILITY ENGINEER.
- RECEPTACLE FOR AV RACK. COORDINATE EXACT LOCATION AND MOUNTING HEIGHT OF RECEPTACLE WITH AV SPECIFICATIONS.
- TO MOTORIZED BASKETBALL BACKBOARD. PROVIDE ALL THE REQUIRED RECEPTABLES, PLUG, AND AUDIBLE ALARM KIT PER MANUFACTURER'S REQUIREMENT. SEE ARCHITECTURAL SPECIFICATION FOR REQUIREMENTS.
- RECEPTACLE FOR SHOT CLOCK AND SCOREBOARD. COORDINATE EXACT LOCATION AND MOUNTING HEIGHT WITH FACILITY ENGINEER. PROVIDE CONTROL WIRING AND CONDUITS PER MANUFACTURER'S REQUIREMENT AND NEC.
- BASE BID. NO GYM DIVIDER. ALTERNATE NO 5. JUNCTION BOX FOR GYM DIVIDER. HOMERUN POWER THROUGH DIVIDER CONTROL UNIT. COORDINATE EXACT LOCATION OF CONTROL UNIT AND POWER CONNECTION WITH SUPPLIER.
- RECEPTACLE AND DATA FOR AV EQUIPMENT. PROVIDE 1" EMPTY CONDUIT WITH PULL WIRE FROM THIS LOCATION TO ACCESSIBLE CEILING SPACE FOR AV EQUIPMENT WIRING. SEE AV SPECIFICATION FOR MORE INFORMATION.
- RECEPTACLE FOR MIC PLUG FOR SCORES. COORDINATE EXACT LOCATION AND MOUNTING HEIGHT OF RECEPTACLE WITH FACILITY ENGINEER.
- WIRELESS ACCESS POINTS. PROVIDE 1" EMPTY CONDUIT WITH PULL WIRE FOR WIRELESS ACCESS POINTS. COORDINATE EXACT LOCATION AND MOUNTING HEIGHT OF WIRELESS ACCESS POINTS WITH AV SPECIFICATIONS/FACILITY ENGINEER.
- RECEPTACLE AND DATA FOR CEILING MOUNTED PROJECTOR.
- SEE POWER ONE-LINE DIAGRAM FOR DETAIL.
- BASE BID. MANUALLY OPERATED BLEACHER. ALTERNATE NO 4. PROVIDE JUNCTION BOX FOR BLEACHER. PROVIDE BLEACHER DISCONNECT CONTROLLER, WIRING, AND CONDUIT PER BLEACHER MANUFACTURER'S REQUIREMENTS AND RECOMMENDATIONS.
- NOT USED.
- HOMERUN THROUGH BLUE BOX LIGHTING CONTROL CIRCUIT LOCATED IN THE ELECTRICAL ROOM.


GENERAL NOTE FOR ELECTRICAL DRAWINGS

- ALL ELECTRICAL EQUIPMENT ENCLOSURES IN PUMP ROOM AND CHEMICAL ROOM SHALL BE NEMA 4X TYPE.
- PVC CONDUIT SHALL BE USED IN CHEMICAL ROOM AND PUMP ROOM.
- PROVIDE WIRE GUARD FOR ALL ELECTRICAL DEVICES AND EQUIPMENT INSTALLED IN THE GYM.
- THERE SHOULD NOT BE ANY VERTICAL CONDUITS ALONG GRID LINES H, F AND J BETWEEN CEILING AND TOP OF MASONRY WALL.

C:\Users\neware\Documents\18010-MBFW-Electrical.rvt 2019_mimewib.rvt 1/24/2020 4:29:57 PM

ISSUED FOR BID


 MH ENGINEERING, INC.
 37 SERRANO LN.
 PRAIRIE, MARYLAND 21086 410-486-4602

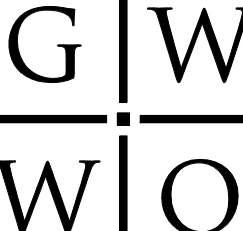
 GWIO
 GWING INC.
 800 WYMAN PARK DRIVE, SUITE 300
 BALTIMORE, MARYLAND 21201, 410-352-9009

© 2019 GWIO INC.
 I CERTIFY THAT THESE DOCUMENTS WERE PREPARED OR APPROVED BY ME, AND THAT I AM A DULY LICENSED ARCHITECT UNDER THE LAWS OF THE STATE OF MARYLAND. LICENSE NUMBER: XXX-XXXXX, EXPIRATION DATE: XXXX/XXXX/XXXX

Revisions:	No.	Date	Description
	2	01/28/2020	ADDENDUM 2

MIDDLE BRANCH FITNESS & WELLNESS CENTER


BALTIMORE CITY RECREATION & PARKS

Job No.	18010	Author	Drawn
Scale	As indicated	Checker	Checked
Date	11/29/2019	Approver	Approved

Drawing Title	First Floor Plan - POWER	Drawing Number	E101r2
Sheet			Of

KEY PLAN:

KEYNOTES LISTED ON THIS SHEET ARE FOR CONVENIENCE ONLY. REFER TO SHEET CS.2 FOR COMPLETE LIST

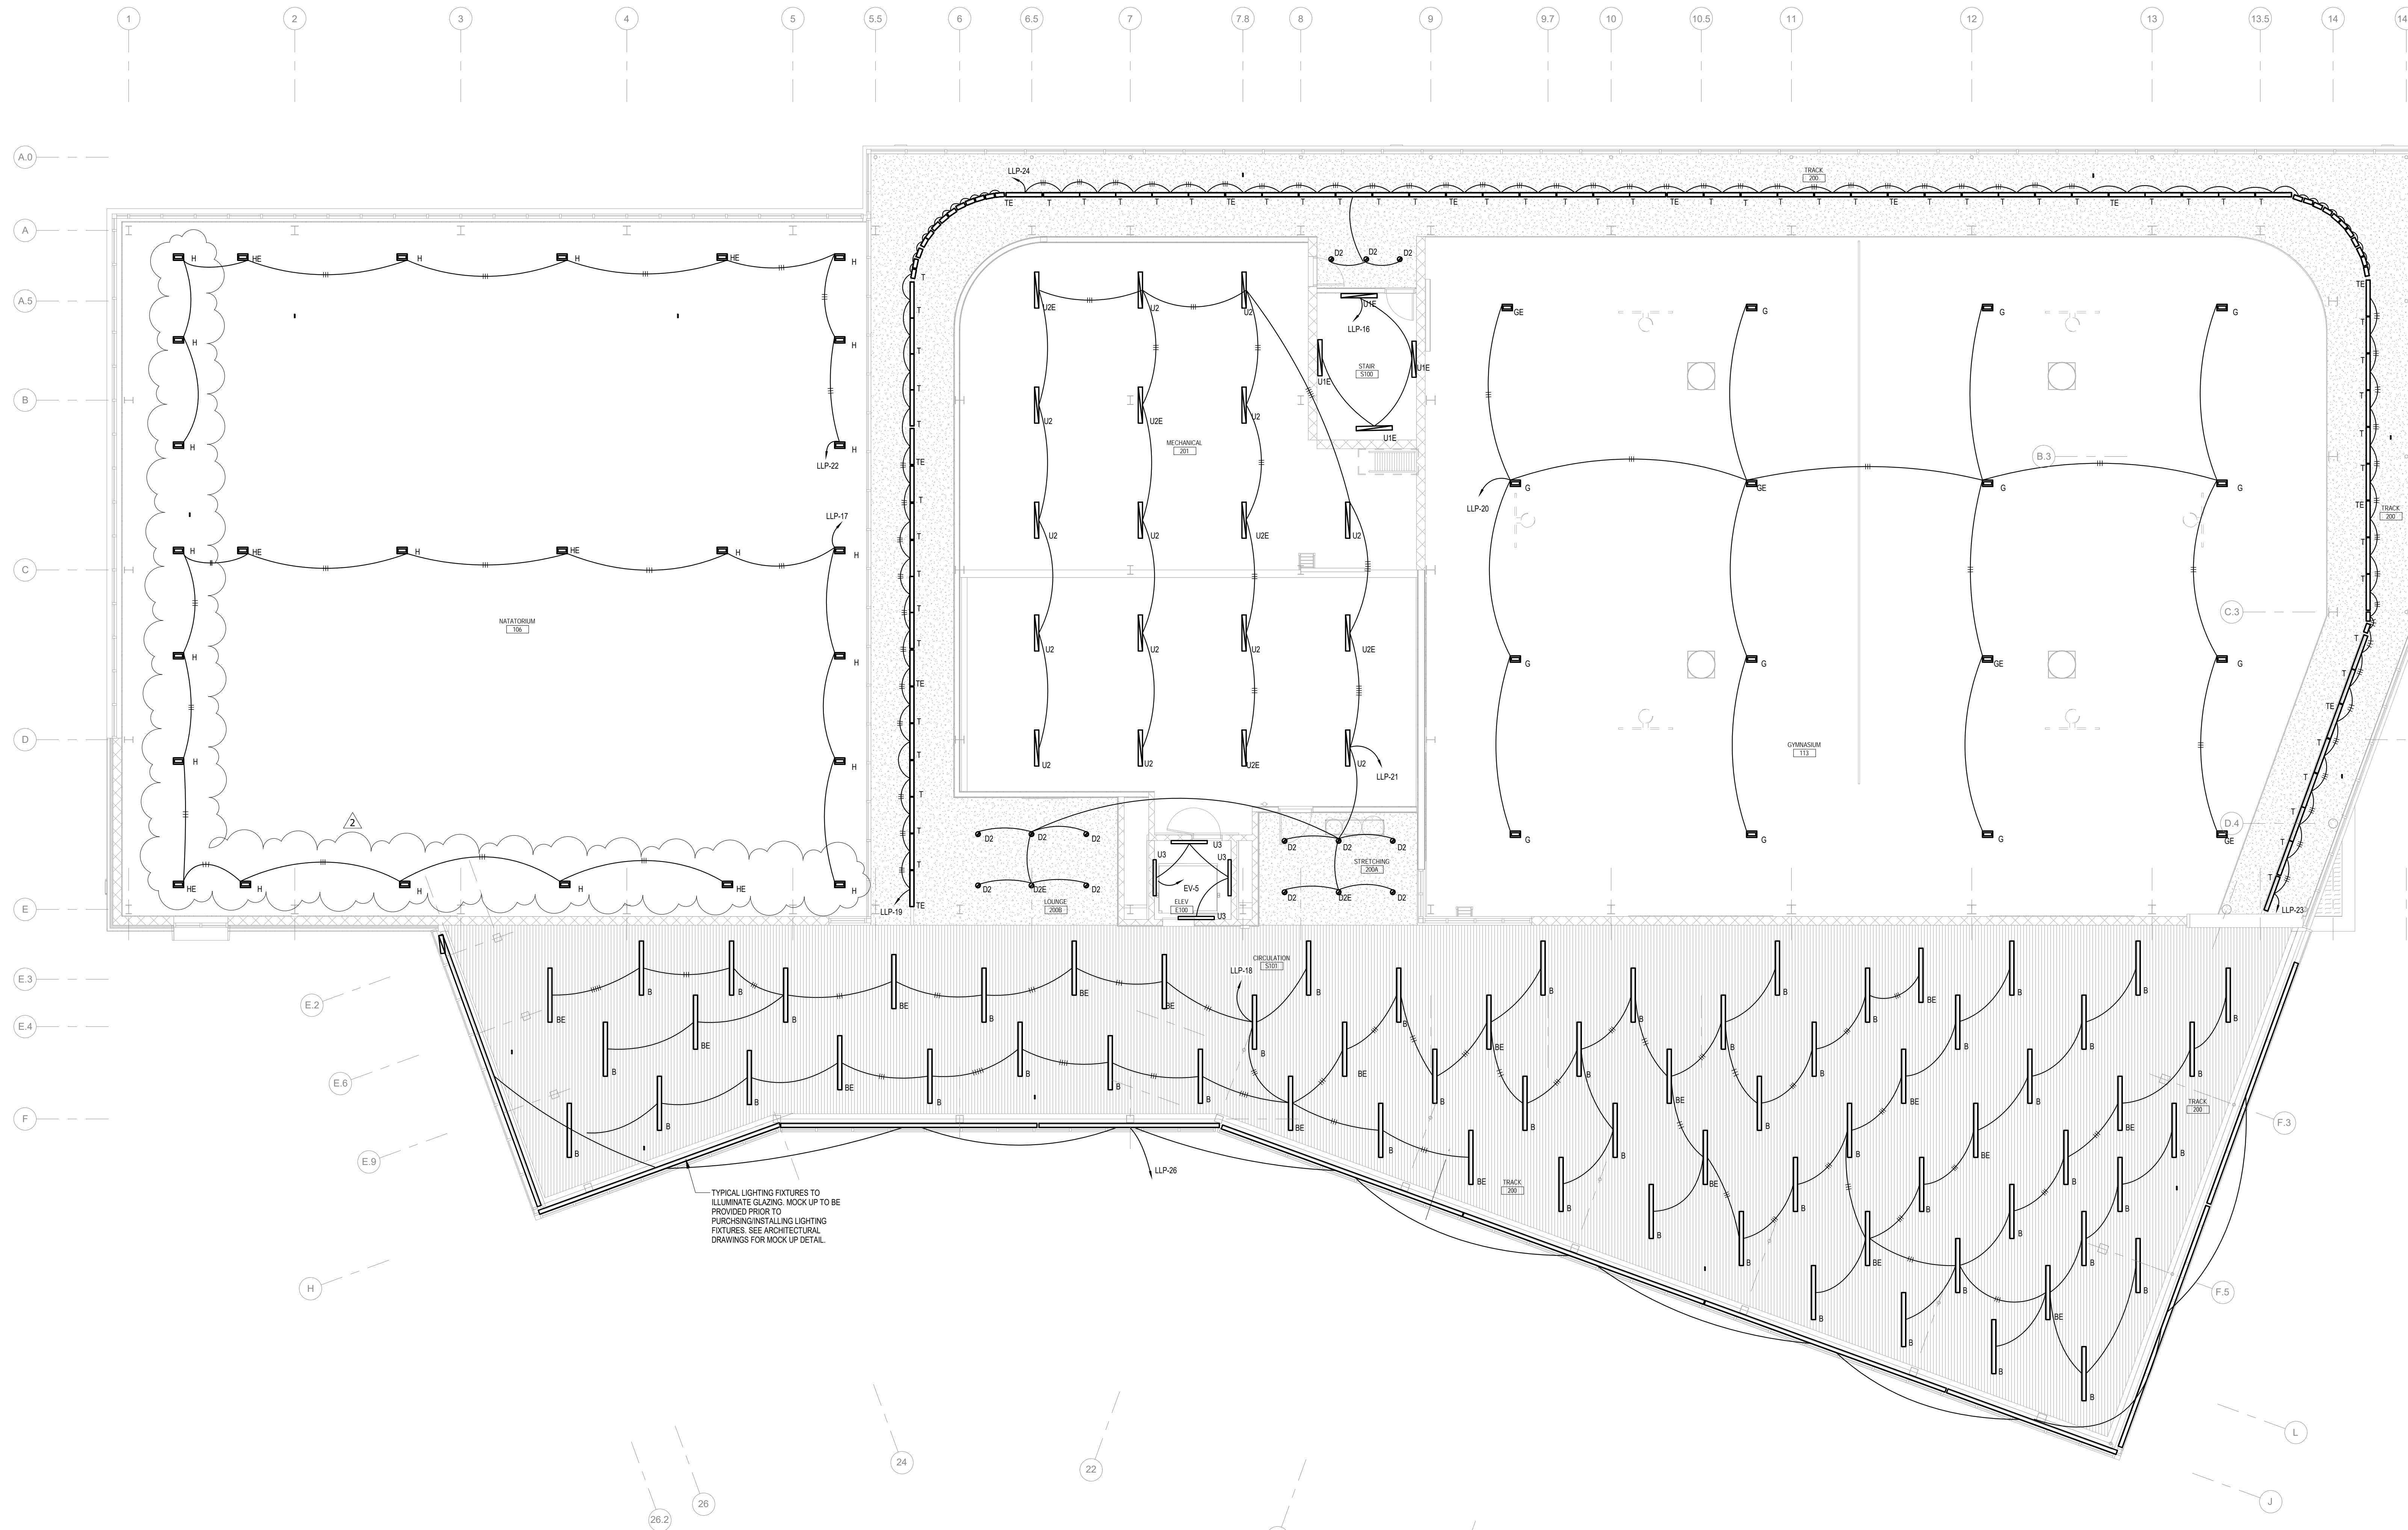

TYPICAL LIGHTING FIXTURES TO ILLUMINATE GLAZING. MOCK UP TO BE PROVIDED PRIOR TO PURCHASING/INSTALLING LIGHTING FIXTURES. SEE ARCHITECTURAL DRAWINGS FOR MOCK UP DETAIL.

1 SECOND FLOOR PLAN - LIGHTING
1/8" = 1'-0"

ISSUED FOR BID



MH ENGINEERING, INC.
37 SERRICK LN
PINEVILLE, MARYLAND 21086 410-486-4602



G|W|O ENGINEERING, INC.
800 WYMAN PARK DRIVE, SUITE 300
BALTIMORE, MARYLAND 21201, 410-352-9009

© 2019 G|W|O INC.

I CERTIFY THAT THESE DOCUMENTS WERE PREPARED OR APPROVED BY ME, AND THAT I AM A DULY LICENSED ARCHITECT UNDER THE LAWS OF THE STATE OF MARYLAND. LICENSE NUMBER: XXX-XXXXX, EXPIRATION DATE XXXX/XXXX/XXXX

Revisions:		
No.	Date	Description
2	01/28/2020	ADDENDUM 2


MIDDLE BRANCH FITNESS & WELLNESS CENTER

BALTIMORE CITY RECREATION & PARKS

Job No.	18010	Author	Drawn
Scale	1/8" = 1'-0"	Checker	Checked
Date	11/29/2019	Approver	Approved
Drawing Title	Drawing Number		

SECOND FLOOR PLAN - LIGHTING
E202r2


Sheet Of

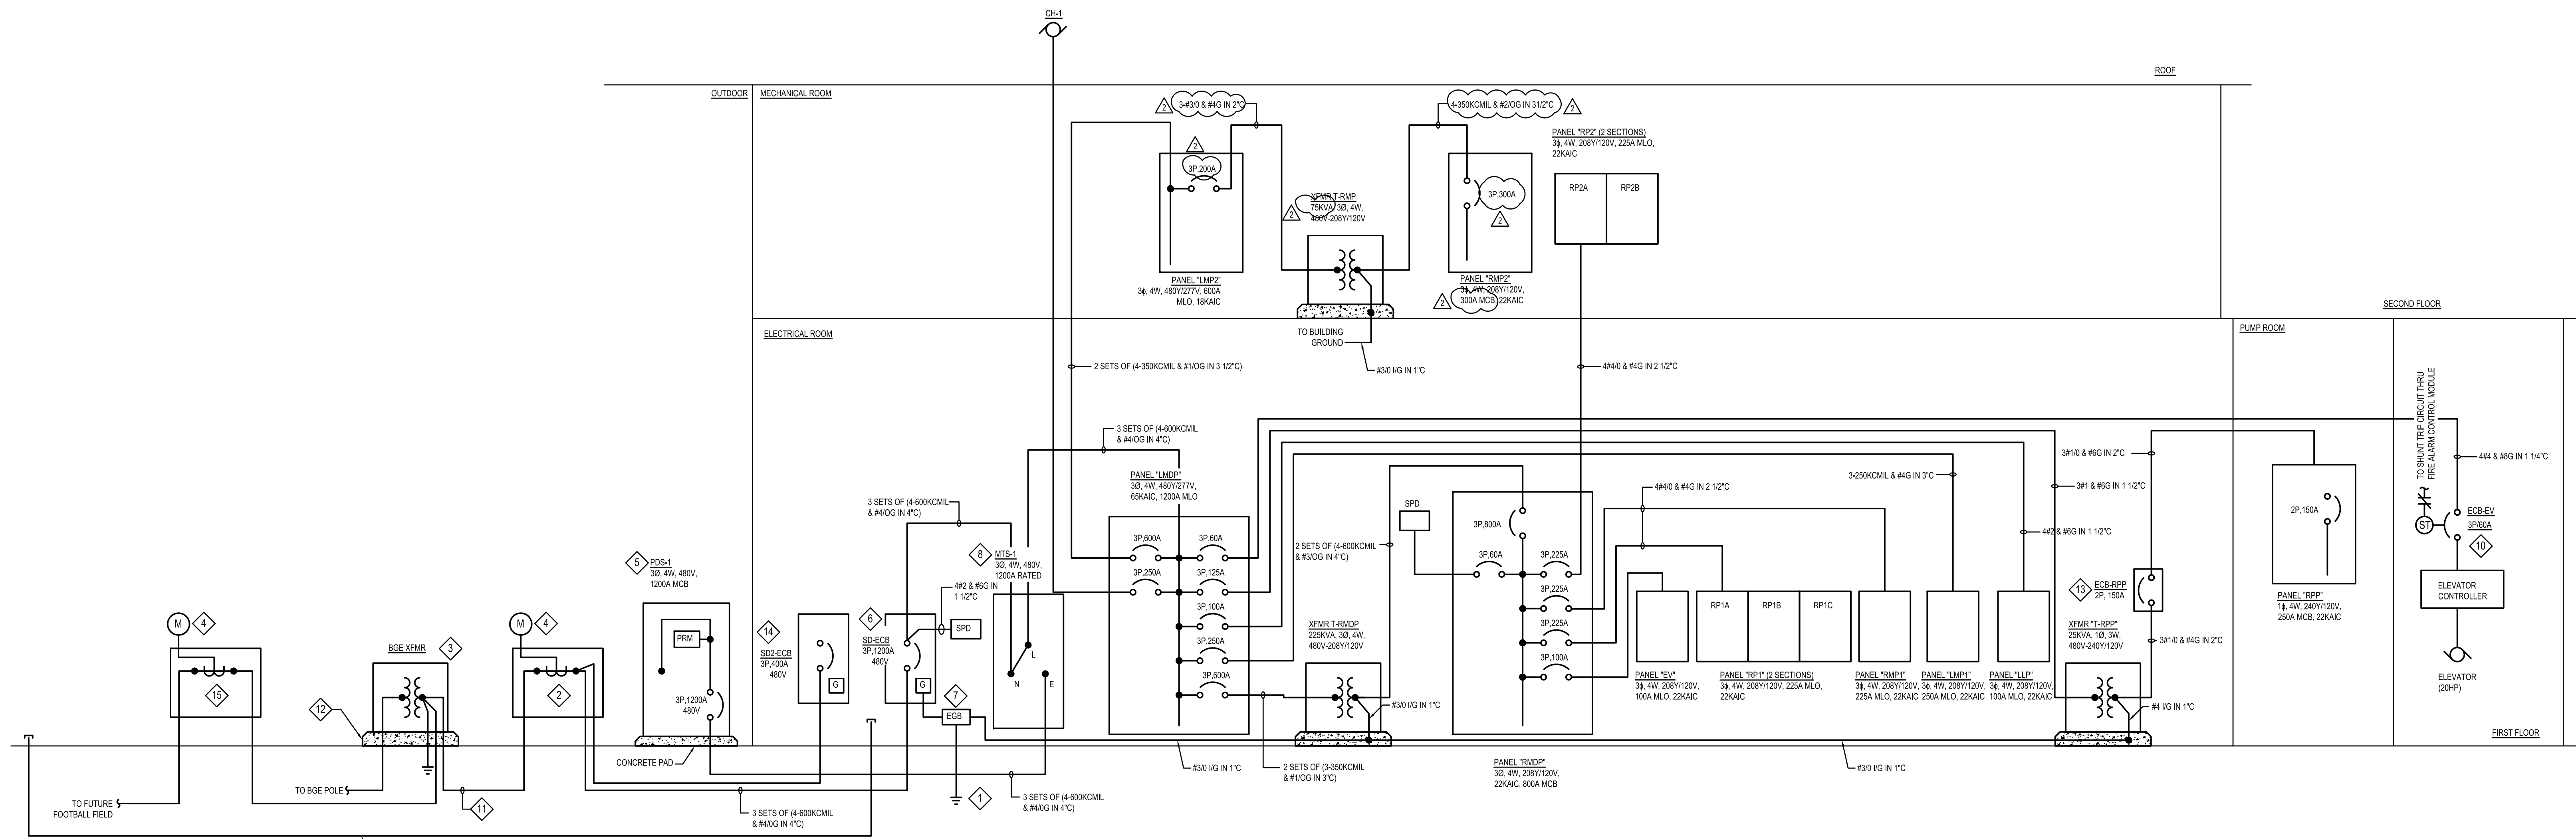

POWER ONE-LINE DIAGRAM
NOT TO SCALE

DRAWING NOTES:

1. PROVIDE GROUNDING SYSTEM PER SERVICE ENTRANCE GROUNDING DETAIL.
2. CT CABINET 480V, 30, 4W, 1800A, BUSS, 65KAC, NEMA 4X STAINLESS STEEL ENCLOSURE PER BGE. SUBMIT CT CABINET SUBMITTAL TO BGE FOR REVIEW AND APPROVAL.
3. COORDINATE THE LOCATION OF UTILITY TRANSFORMER, GROUNDING AND PAD REQUIREMENTS WITH LOCAL UTILITY. PROVIDE GROUNDING AND PAD.
4. UTILITY METER SOCKET, NEMA 3R. COORDINATE LOCATION OF METER WITH LOCAL UTILITY. PROVIDE 1 1/2" FROM CT TO METER SOCKET ENCLOSURE. SUBMIT METER SOCKET SHOP DRAWING TO BGE FOR REVIEW AND APPROVAL.
5. PORTABLE GENERATOR DOCKING STATION:
 - 5.1. NEMA 4X STAINLESS STEEL WITH FREE STANDING ON PAD
 - 5.2. CAN STYLE BENTHOODTOP CONNECTION
 - 5.3. MAIN CIRCUIT BREAKER, 1200A 65KAC
 - 5.4. PHASE ROTATION MONITOR
 - 5.5. 480V, 30, 4W (A, B, C, NEUTRAL, G)
 - 5.6. SIX (6) SETS OF #60 27' CAN STYLE PORTABLE POWER CABLES PER PHASE (TOTAL 30 CABLES; PHASE A: BROWN, PHASE B: ORANGE, PHASE C: YELLOW, NEUTRAL: GRAY, GROUND: GREEN)
 - 5.7. TRYSTAR #GDS-08-S-P-800A-M-A-B-A-K2 OR APPROVAL EQUAL
6. SERVICE DISCONNECT, 3P SOLID NEUTRAL AND GROUND, 480V, 65KAC, 1200A ENCLOSED CIRCUIT BREAKER WITH LOCKABLE NEMA 1 ENCLOSURE AND MICROLOGIC TRIP UNIT AND SUITABLE TO USE FOR SERVICE DISCONNECT. MICROLOGIC SHALL HAVE THE FOLLOWING FEATURES:
 - I. L5IG TRIP CONFIGURATION WITH PROGRAMMABLE GROUND FAULT ALARM
 - II. INCREMENTAL "FINE TUNING" OF L, S, I, AND G PICKUP AND DELAY SETTINGS
 - III. NEUTRAL PROTECTION
 - IV. POWER MEASUREMENT
 - V. LOCAL AND REMOTE SETTING. PROVIDE PROGRAMMING AND TRIP SETTING BASED ON OVERCURRENT PROTECTIVE DEVICE COORDINATION STUDY.
7. SEE DETAIL 7.5E02 AND 5.0E02 FOR SYSTEM GROUNDING DETAILS.
8. MANUAL TRANSFER SWITCH, 480V, 30, 4W, 1200A, 65KAC WITH STAND RATING, NEMA 1 ENCLOSURE.
9. TO BUILDING STEEL SYSTEM GROUNDING.
10. 3P 480V, 65KAC, 1200A ENCLOSED CIRCUIT BREAKER WITH SHUNT TRIP UNIT AND NEMA 1 ENCLOSURE. SEE DETAIL 7.5E02 "ELEVATOR SHUNT TRIP CONTROL DETAIL" FOR SHUNT TRIP WIRING DETAIL. COORDINATE WITH FIRE ALARM CONTROL CONTRACTOR FOR FIRE ALARM CONNECTION.
11. SERVICE ENTRANCE CONDUCTORS TO BE PROVIDED BY LOCAL UTILITY. CONTACT AND COORDINATE HOOKUP WITH LOCAL UTILITY AFTER SERVICE EQUIPMENT INSTALLATION INSPECTION IS PASSED.
12. CONTACT AND COORDINATE WITH LOCAL UTILITY FOR TRANSFORMER SIZE AND ASSOCIATED CONCRETE PAD REQUIREMENTS. PROVIDE PRECAST CONCRETE PAD PER UTILITY REQUIREMENTS.
13. 2 POLE PLUS SOLID NEUTRAL AND GROUND, 240V, 10KAC, 150A ENCLOSED CIRCUIT BREAKER WITH NEMA 1 ENCLOSURE
14. SERVICE DISCONNECT FOR FUTURE DOG PARK AND BASKET BALL FIELD. 3P PLUS SOLID NEUTRAL AND GROUND, 480V, 65KAC, 1200A ENCLOSED CIRCUIT BREAKER WITH LOCKABLE NEMA 1 ENCLOSURE AND MICROLOGIC TRIP UNIT AND SUITABLE TO USE FOR SERVICE DISCONNECT. MICROLOGIC SHALL HAVE THE FOLLOWING FEATURES:
 - I. L5IG TRIP CONFIGURATION WITH PROGRAMMABLE GROUND FAULT ALARM
 - II. INCREMENTAL "FINE TUNING" OF L, S, I, AND G PICKUP AND DELAY SETTINGS
 - III. NEUTRAL PROTECTION
 - IV. POWER MEASUREMENT
 - V. LOCAL AND REMOTE SETTING. PROVIDE PROGRAMMING AND TRIP SETTING BASED ON OVERCURRENT PROTECTIVE DEVICE COORDINATION STUDY. SUBMIT SHOP DRAWINGS TO BGE FOR REVIEW AND APPROVAL. DISCONNECT SHALL BE LOCKED ON THE OFF POSITION.
15. CT CABINET FOR FUTURE FIELD HOUSE AND FOOT BALL FIELD. 480V, 30, 4W, 1800A, BUSS, 65KAC, NEMA 4X STAINLESS STEEL ENCLOSURE PER BGE. SUBMIT CT CABINET SUBMITTAL TO BGE FOR REVIEW AND APPROVAL.

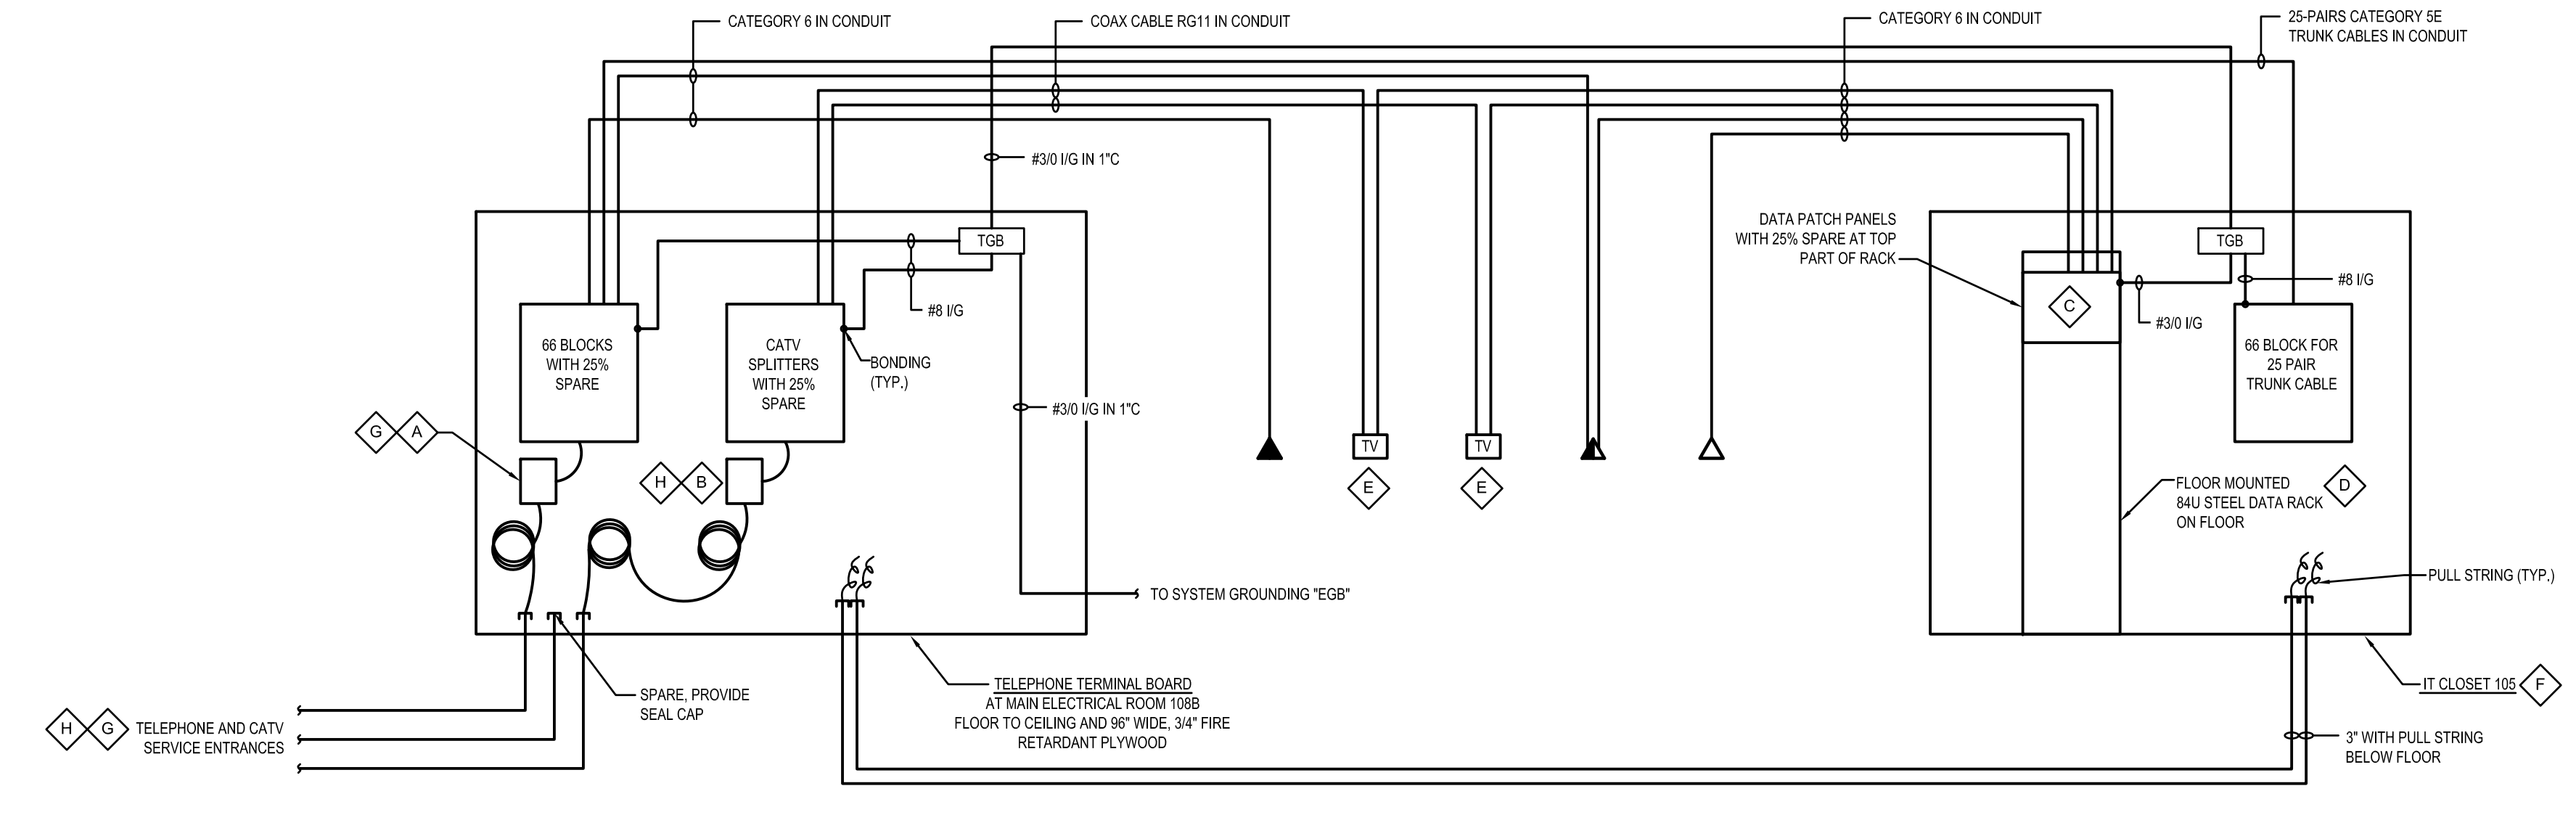

DATA/TELEPHONE/CATV BLOCK DIAGRAM
NOT TO SCALE


DATA/TELEPHONE/CATV BLOCK DIAGRAM NOTES:

1. COORDINATE WIRING REQUIREMENTS WITH THE MANUFACTURER. COMPLY WITH THE REQUIREMENTS OF THE MANUFACTURER AND THE FOLLOWINGS:
 - 1.1. ALL COMMUNICATIONS AND COAXIAL CABLES, AND ALL CLASS 2 POWER LIMITED CIRCUITS SHALL COMPLY WITH ARTICLE 725, ARTICLE 800, ARTICLE 810, ARTICLE 820, ARTICLE 830, AND OTHER APPLICABLE ARTICLES OF THE NATIONAL ELECTRICAL CODE. FLENUM RATED RISER RATED AND GENERAL PURPOSE COMMUNICATIONS AND COAXIAL SHALL BE FURNISHED AND INSTALLED IN ACCORDANCE WITH THE NATIONAL ELECTRICAL CODE. CABLES SHALL BE SUITABLE FOR THEIR INTENDED USE. SECURE AND SUPPORT CABLE AT INTERVALS NOT EXCEEDING 3 FEET, OR AS REQUIRED BY THE MANUFACTURER, WHOEVER IS LESS. CABLE SHALL RUN IN CONDUIT. *TRADE SIZE MINIMUM, UNDER THE FOLLOWING CONDITIONS: WHERE SUBJECT TO PHYSICAL DAMAGE; WHERE INSTALLED OUTDOORS OR WET LOCATIONS; WHERE EXPOSED; WHERE CONCEALED IN CONCRETE OR BLOCK WALLS; AND WHERE REQUIRED BY THE NEC.
 - 1.2. ALL OTHER CABLES AND CIRCUITS SHALL RUN IN CONDUIT. 1" TRADE SIZE MINIMUM.
2. SEE PLAN DRAWINGS FOR QUANTITIES AND LOCATIONS OF TELEPHONE OUTLETS, DATA OUTLETS AND TV OUTLETS.
3. PROVIDE 25% SPARE CAPACITY AT THE 86 PUNCH BLOCKS.
4. PROVIDE GROUNDING IN ACCORDANCE WITH THE NEC.
5. ALL CABLES SHALL BE PLENUM RATED.


DIAGRAM NOTES FOR TELEPHONE/DATA/CATV:

- A. VERIZON SERVICE TERMINATION BOX.
- B. CATV TERMINATION BOX.
- C. CATEGORY 6.
- D. COORDINATE MOUNTING LOCATION WITH OWNER.
- E. COMBO COAX AND DATA OUTLETS.
- F. PROVIDE 3/4" FIRE RETARDANT PLYWOOD FLOOR TO CEILING AND WALL TO WALL FOR ALL WALL SPACES.
- G. CONTACT AND COORDINATE WITH LOCAL TELEPHONE FOR SERVICE ENTRANCE FROM STREET. PROVIDE SERVICE PEDESTAL HANDHOLES FROM STREET TO ELECTRICAL ROOM IN ACCORDANCE WITH LOCAL TELEPHONE REQUIREMENTS. SEE ELECTRICAL SITE PLAN FOR IDEAL PATHS OF TELEPHONE SERVICES AND LOCATIONS OF PEDESTAL HANDHOLES.
- H. CONTACT AND COORDINATE WITH LOCAL CATV FOR SERVICE ENTRANCE FROM STREET TO BUILDING. PROVIDE SERVICE PEDESTAL HANDHOLES FROM STREET TO ELECTRICAL ROOM IN ACCORDANCE WITH LOCAL CATV REQUIREMENTS. SEE ELECTRICAL SITE PLAN FOR IDEAL PATHS OF CATV SERVICES AND LOCATIONS OF PEDESTAL HANDHOLES.

ISSUED FOR BID

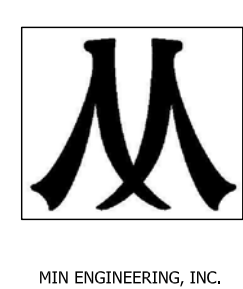

MVA ENGINEERING, INC.
10 SUBURBAN LA
Pikesville, Maryland 21111, 410-486-4092

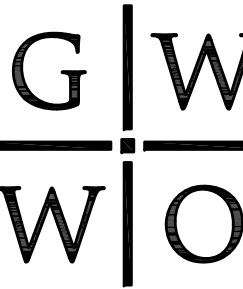

G|W|O GROUP, INC.
800 WYMAN PARK DRIVE, SUITE 300
BALTIMORE, MARYLAND 21211, 410-532-0099

©2018 G|W|O INC.

I CERTIFY THAT THESE DOCUMENTS WERE PREPARED OR APPROVED BY ME, AND THAT I AM A FULLY LICENSED ENGINEER UNDER THE LAWS OF THE STATE OF MARYLAND. LICENSE NUMBER: 38318, EXPIRATION DATE: 01/05/2020

Revisions:	No.	Date	Description
	2	01/28/2020	ADDENDUM 2

MIDDLE BRANCH FITNESS & WELLNESS CENTER

BALTIMORE CITY RECREATION & PARKS

Job No.	18010	MY	Drawn
Scale	AS SHOWN	JY	Checked
Date	11/29/19	JY	Approved

Drawing Title	POWER ONE-LINE AND COMMUNICATION RISER DIAGRAM	Drawing Number	E501 r2
Sheet			OF

